

PROJECT NO. 08-1007

PREPARED FOR
NORMAN S. WIRES


STATE OF OHIO
ATHENS COUNTY
LEE TOWNSHIP
TOWN 10 RANGE 15
SECTION 19

LEGEND

- 5/8" CAPPED REBAR SET
- IRON PIN FOUND
- PIPE FOUND

REFERENCE

DEEDS AS LISTED
LEE TWP MAP 19

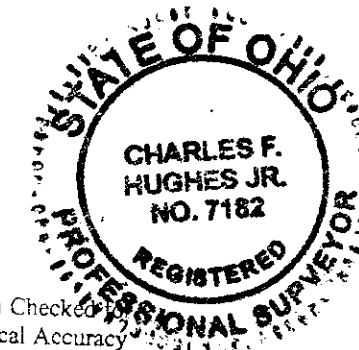

Description Checked
Mathematical Accuracy
Athens County
ENGINEER'S OFFICE



BY: *[Signature]*
DATE: 10/20/08

[Signature] 10-30-2008
CHARLES F. HUGHES, JR.
P.S. 7182 DATE

CHARLES F. HUGHES, JR.
PROFESSIONAL SURVEYOR

P.O. BOX 216, MINERAL WELLS, WV 26150
1-304-489-9640

DATE ASSIGNED:	DWN BY: JLD	FIELD CONTROL: F.H.
DATE COMPLETED:	DWN BY:	SCALE: 1" = 200'

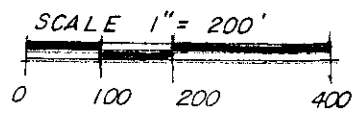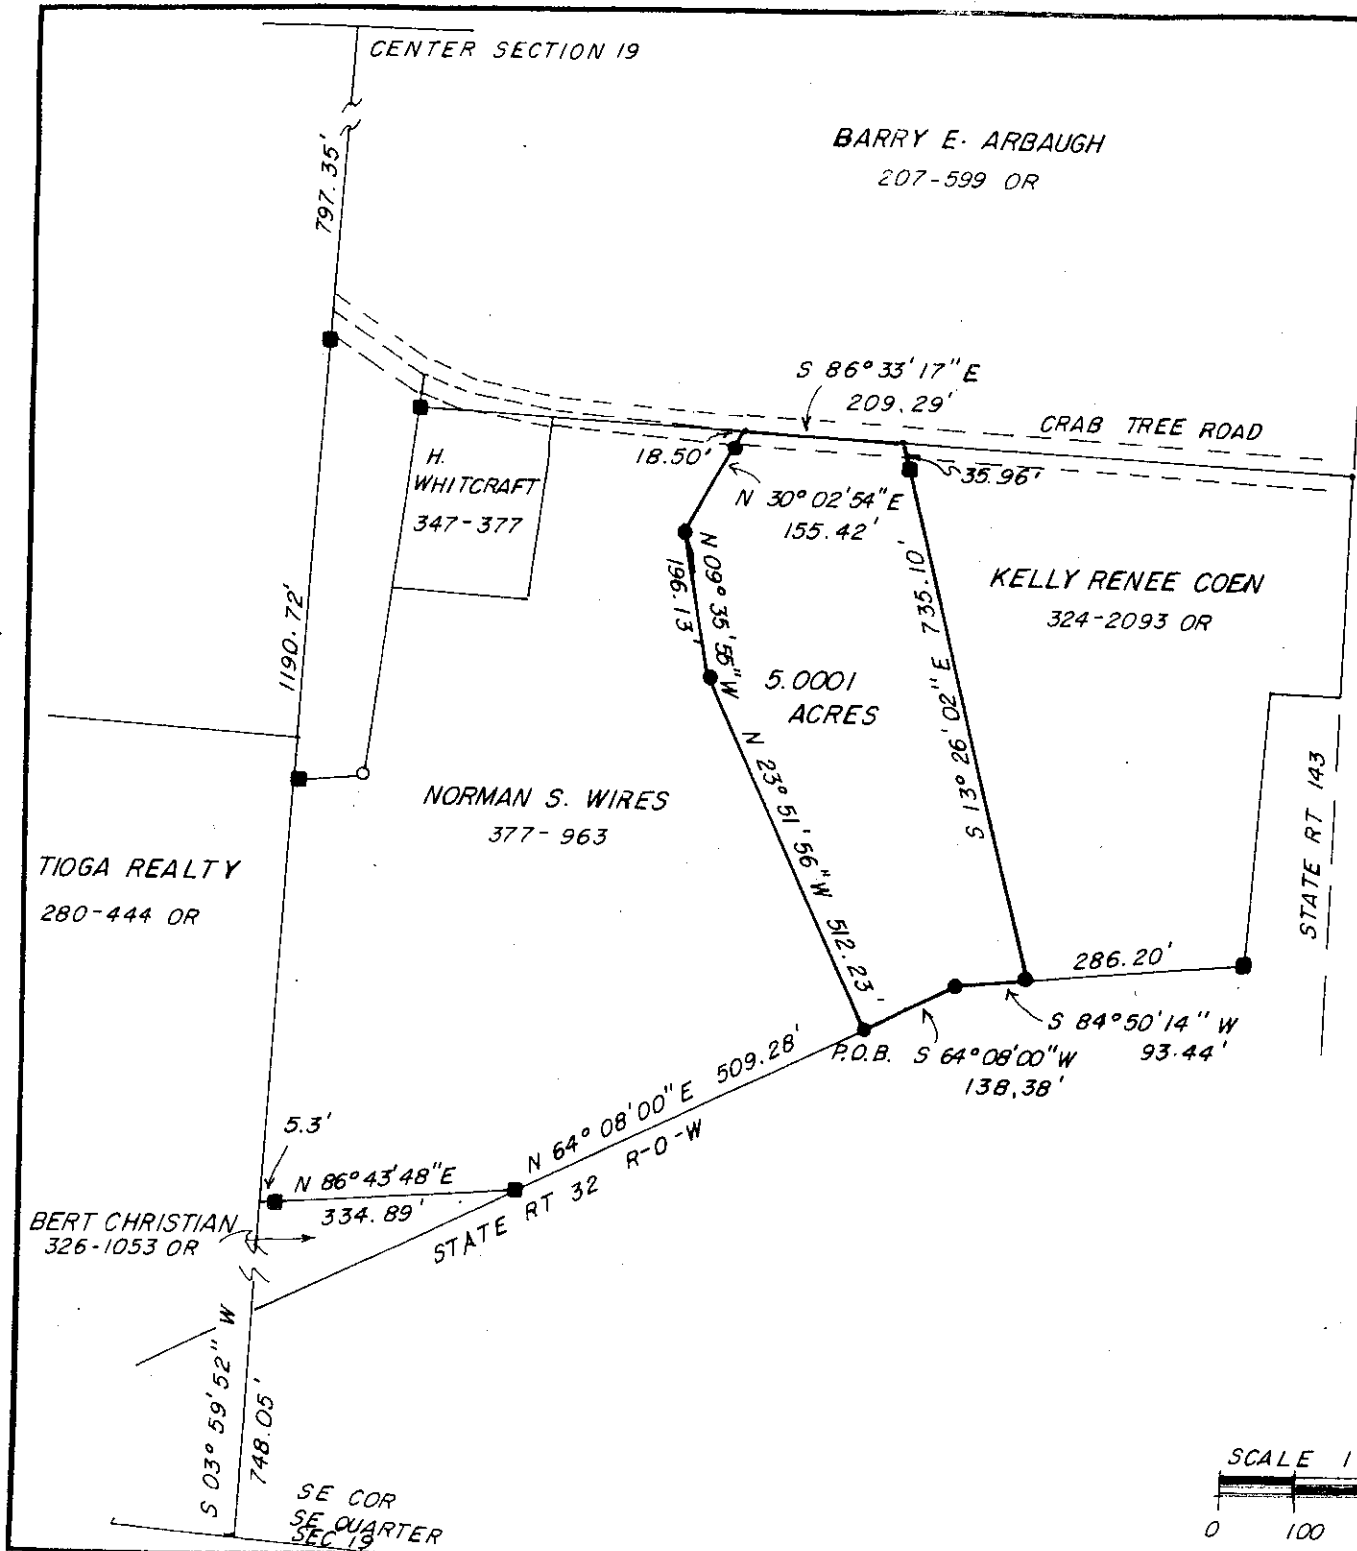

BLUELINE IMAGING 128639