




# SOUTHEASTERN LAND SURVEYS

LEONARD F. SWOYER  
REGISTERED PROFESSIONAL LAND SURVEYOR

3428 Pleasant Hill Road  
Athens, Ohio, 45701  
614/593-8701

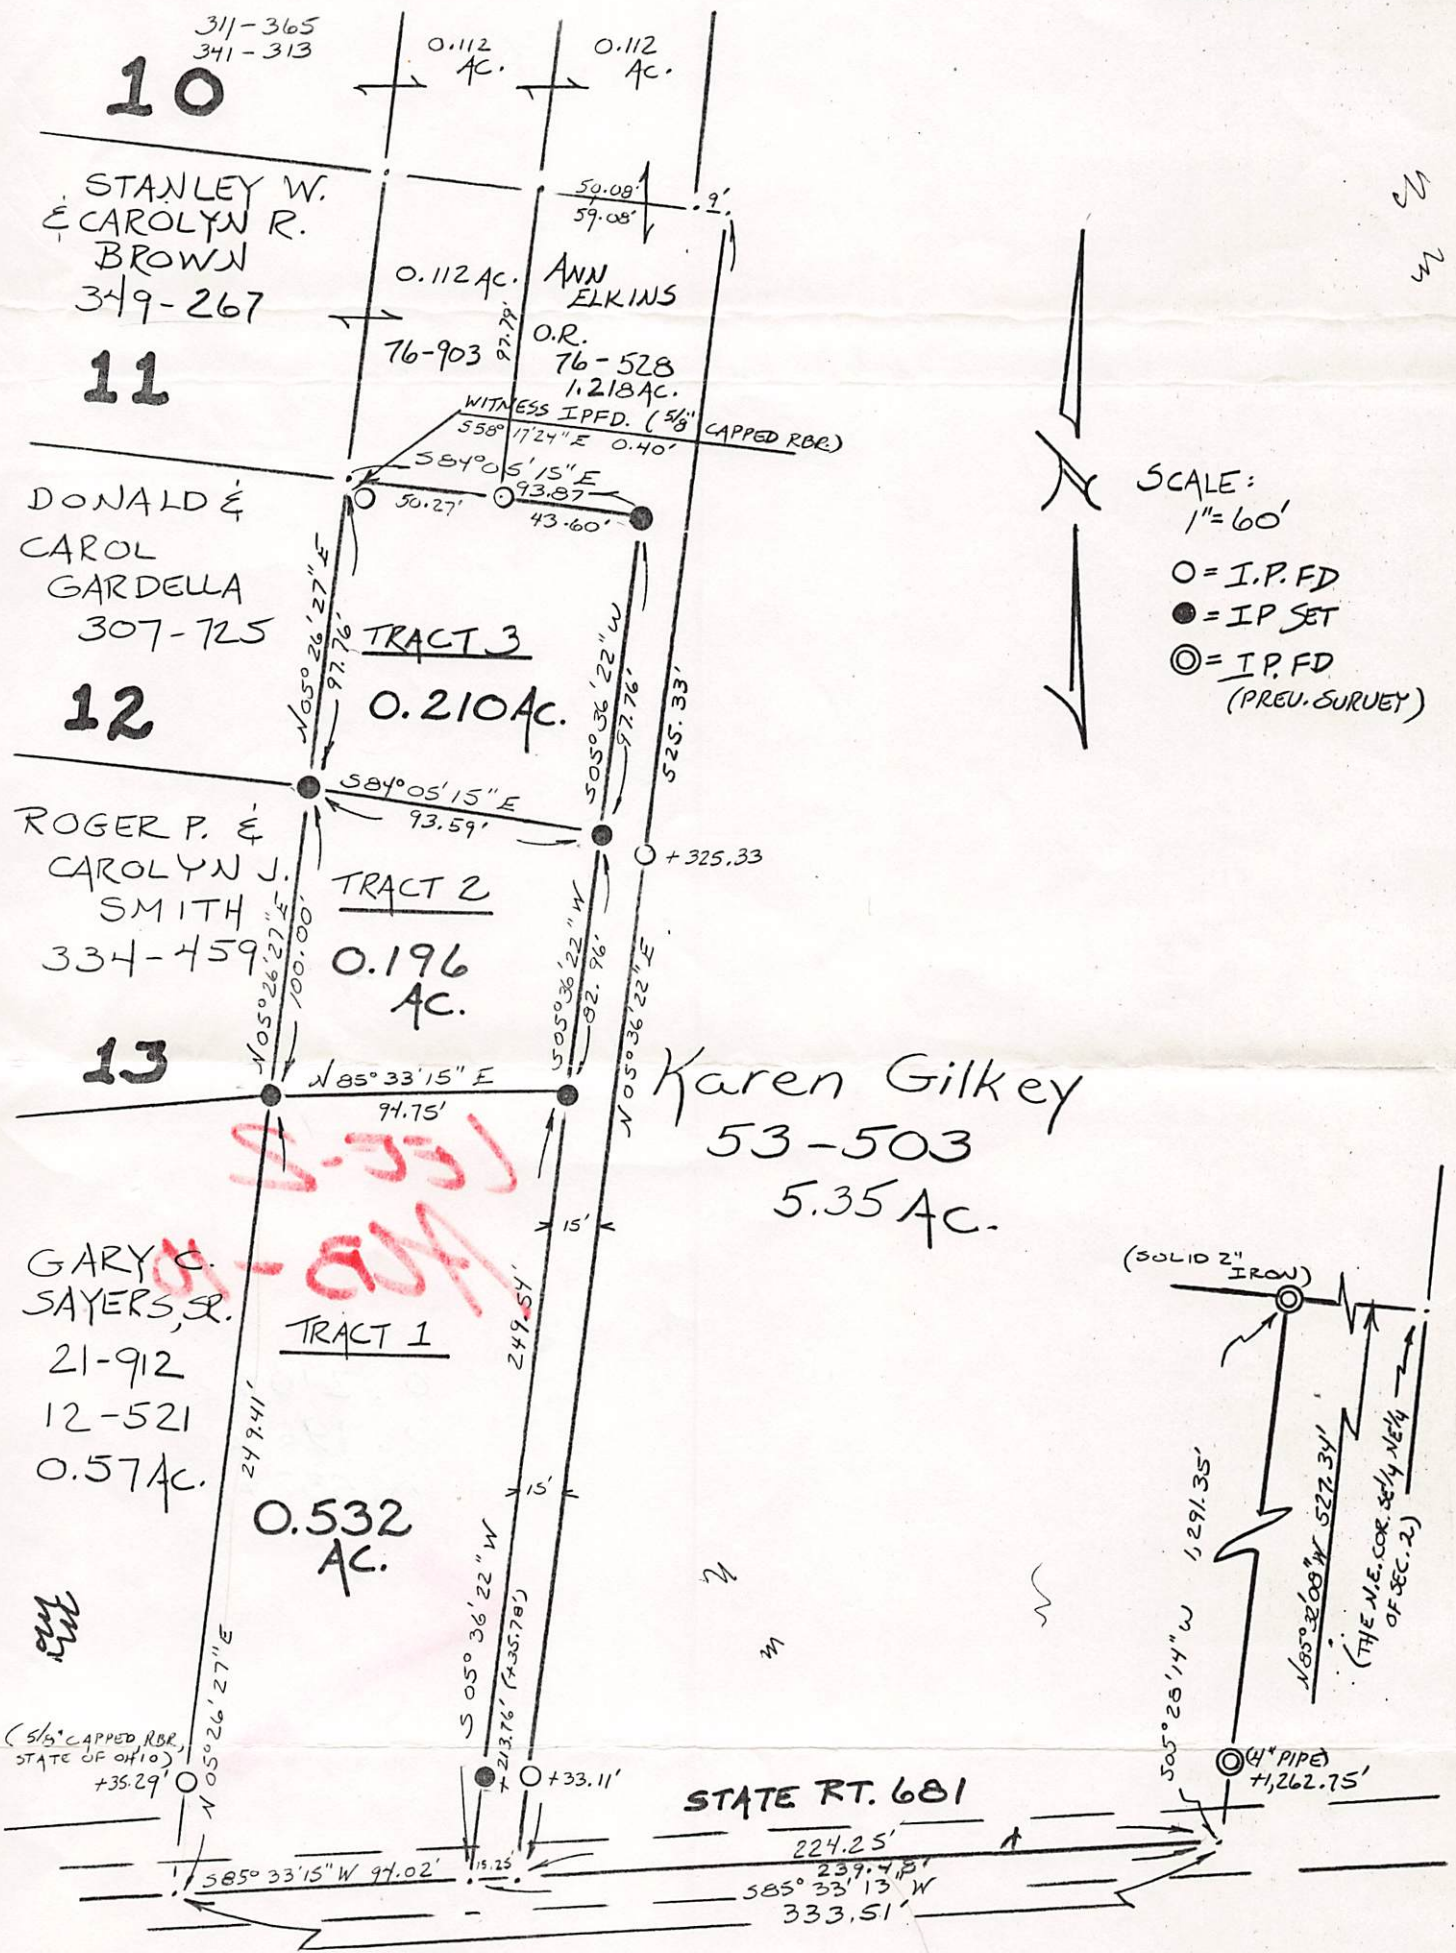

Plat of Tracts 1 through 3 inclusive Scale 1" = 60'

Surveyed for Ann Elkins Date June 25, 1991

Subdivision SE 1/4 OF NE 1/4

Township Lee Section 2 Town 10 Range 15

Corporation Albany County Athens State Oh

*Leonard F. Swoyer Jr.*  
Leonard F. Swoyer Jr. Reg. Prof. Land Surveyor No. 6765

