

Highland Surveying
80 Fayette Street
Nelsonville Ohio 45764

DESCRIPTION OF 1.037 AC. TRACT

situated in Section 19 Lodi Township, Athens County, State of Ohio
and being more particularly described as follows:

Beginning at an iron pin set that is located south 746.15
feet and east 85.90 feet from the northwest corner of the
northeast quarter of section 19

thence North $73^{\circ}11'22''$ East 192.86 feet to a point in the
centerline of state route 33, passing an iron pin set at 162.86
feet

thence along said centerline South $36^{\circ}14'28''$ East 100.22
feet

thence continuing along said centerline South $40^{\circ}04'06''$
East 143.65 feet

thence leaving said centerline South $70^{\circ}31'01''$ West 198.80
feet, passing an iron pin set at 30.00 feet

thence North $36^{\circ}29'36''$ West 250.39 feet to the point
of beginning and containing 1.037 Acres.

Subject to all Easements and Rights of Way



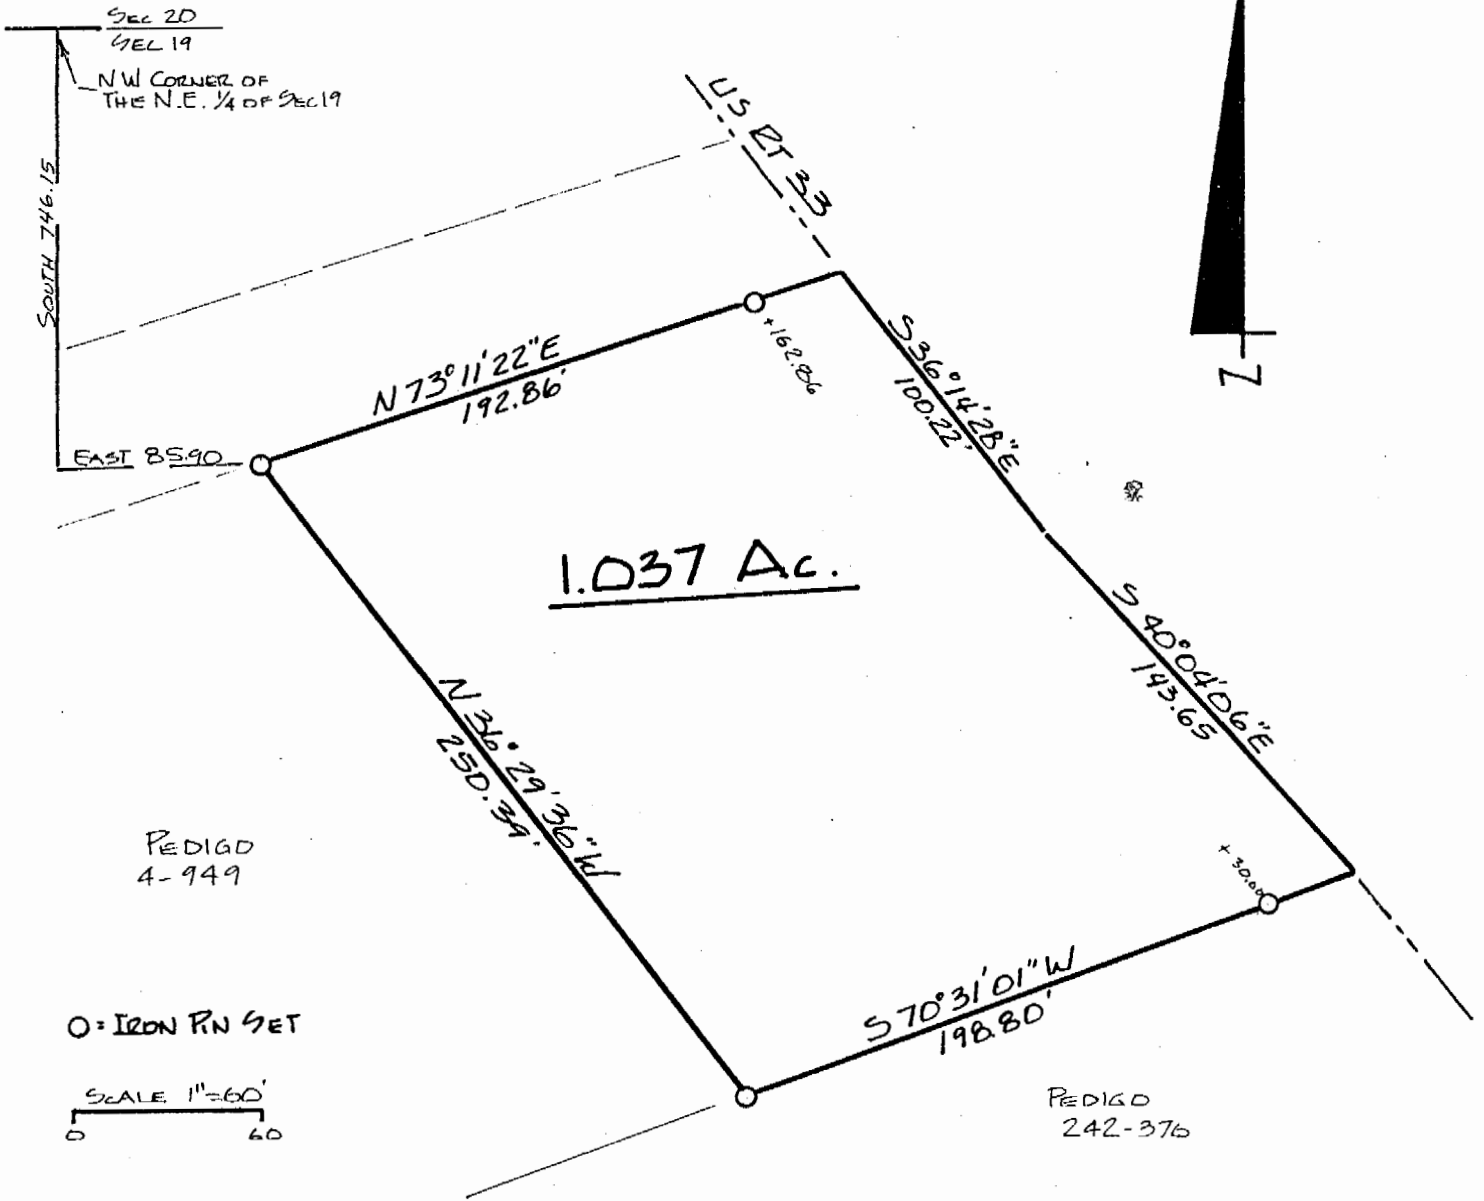

Kenneth E. Highland -7581

Description checked for
Mathematical Accuracy
ATHENS COUNTY
ENGINEERS OFFICE
BY: S. Blausen
DATE: 10-21-94

62


LOD #19

HIGHLAND SURVEYING
 REGISTERED PROFESSIONAL LAND SURVEYOR



PEDIG 4-949

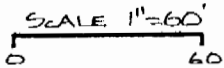O = IRON PIN SET



PEDIG 242-376

PLAT of SURVEY OF 1.037 A.C. TRACT
 SURVEYED for _____
 SUBDIVISION _____
 TOWNSHIP L001 SECTION 19 TOWN 4 RANGE 13
 CORPORATION _____ COUNTY ATHENS STATE OHIO
 SCALE 1" = 60' DATE SEPT 1994



KENNETH E. HIGHLAND
 80 FAYETTE STREET
 NELSONVILLE, OHIO 45764
 614-753-1264

Kenneth E. Highland
 Kenneth E. Highland S-7581

63