

HIGHLAND SURVEYING
80 FAYETTE STREET
NELSONVILLE OHIO 45764
614-753-1264

Description of a 0.115 Acre Tract

Situated in the Village of Glouster, County of Athens, and State of Ohio and being a part of Lots 887, and 888 of the Wassall Fire Clay Company's Addition to the Village of Glouster and being more particularly described as follows:

BEGINNING at an iron pin found at the northeast corner of Lot 887,

THENCE South $0^{\circ}13'58''$ West, 55.15 feet to an iron pin set on the east line of Lot 887,

THENCE leaving said line South $85^{\circ}49'50''$ West, 24.95 feet to an iron pin set,

THENCE South $72^{\circ}55'16''$ West, 57.74 feet to an iron pin set on the west line of Lot 888,

THENCE along said line North $0^{\circ}13'58''$ East, 74.11 feet to an iron pin set at the north west corner of lot 888,

THENCE along the north line of Lots 887, and 888 South $89^{\circ}52'11''$ East, 80.00 feet to the point of beginning and containing 0.1150 acres (5009.37 Square feet) of which 0.0624 acres is out of Lot 888 and 0.0526 acres is out of Lot 887.

Subject to all Easements and Rights of Way of Record

Bearings used are to an assumed meridian and are for angular determination only


 Kenneth E. Highland S-7581




Description checked for
 Mathematical Accuracy
 ATHENS COUNTY
 ENGINEER'S OFFICE
 BY: S. Blouse
 DATE: 7-25-96

TRM #9

42

HIGHLAND SURVEYING

REGISTERED PROFESSIONAL LAND SURVEYOR

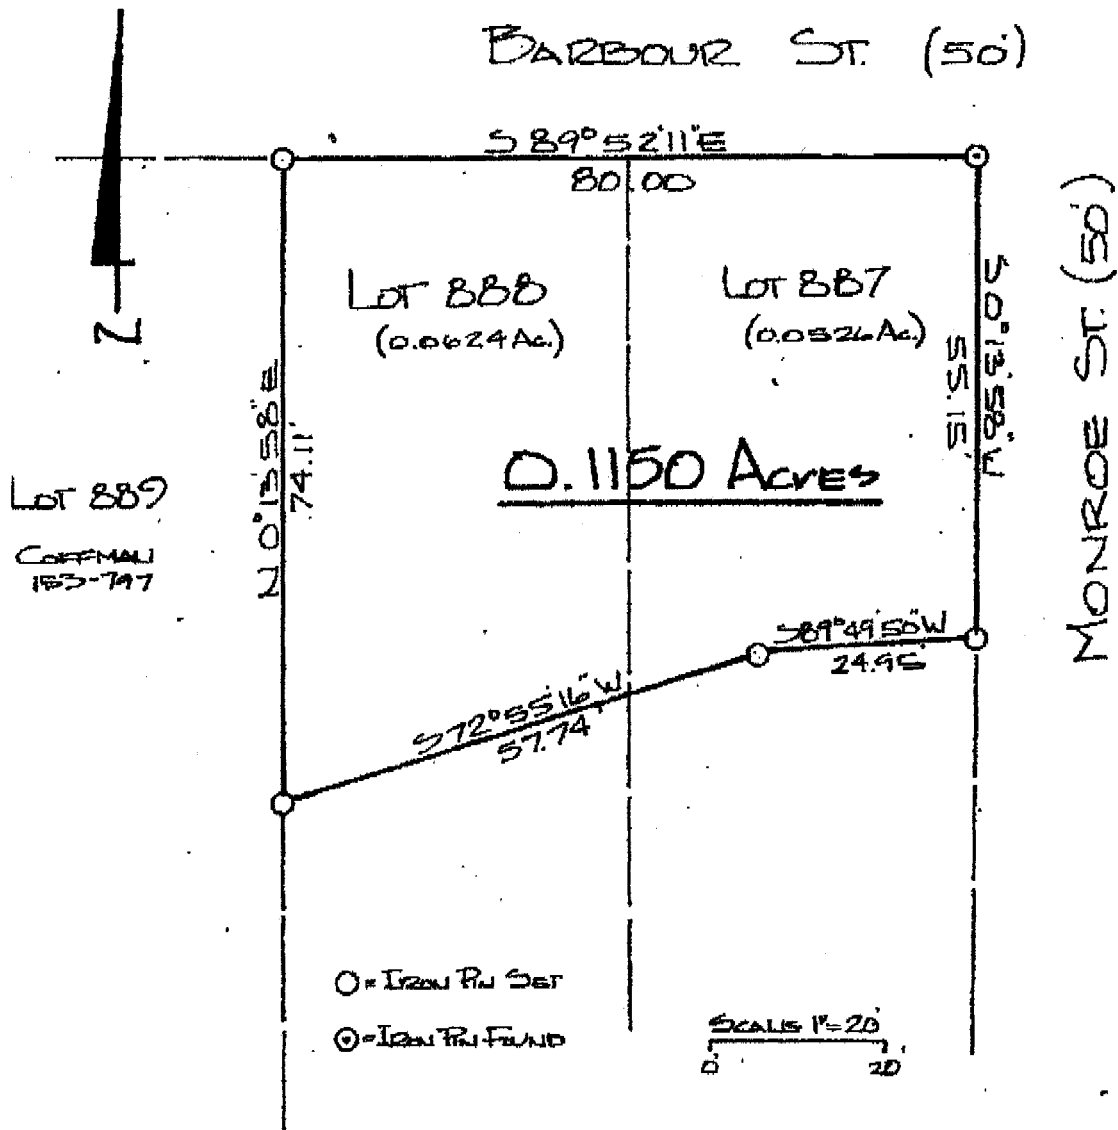

PLAT of SURVEY OF A 0.1150 AC. TRACT
 SURVEYED for BETTY DEKEY
 SUBDIVISION WASSALL FIRE CLAY ADDN to GLOUSTER
 TOWNSHIP TRIMBLE SECTION 9 TOWN 11 RANGE 14
 CORPORATION GLOUSTER COUNTY ATHENS STATE OHIO
 SCALE 1" = 20' DATE JULY 1996



KENNETH E. HIGHLAND
 80 FAYETTE STREET
 NELSONVILLE, OHIO 45764
 614-759-1284

Kenneth E. Highland
 Kenneth E. Highland S-7581