

DESCRIPTION - 1.015 ACRES  
FOR JEAN A. FOUGHT.

Situated in the Township of Troy, County of Athens,  
State of Ohio and being a part of Section 1, Town 5, Range 11,  
more particularly described as follows:

Commencing at an iron pipe found at the northeast  
corner of Lot No. <sup>1212</sup>~~1211~~ of the R. A. Miller Addition to the  
Village of Hockingport recorded in Plat Book 8, Page 59, Athens  
County Plat Records, said iron pipe being in the south right of  
way line of Ohio State Route 124; thence north  $64^{\circ}27'20''$  east  
along said right of way line 73.01 feet to an iron bolt set,  
said bolt being the place of beginning for the tract of land  
herein described; thence continuing along said right of way  
line north  $64^{\circ}27'20''$  east 167.00 feet to an iron pipe found;  
thence leaving the highway right of way, south  $24^{\circ}19'40''$  east  
270.51 feet to an iron pipe found on the bank of the Ohio River  
16 feet from the waters edge; thence south  $55^{\circ}53'20''$  west  
148.56 feet to an iron bolt set; thence north  $28^{\circ}21'10''$  west  
292.93 feet to the place of beginning and containing 1.015  
acres, more or less.

This description is prepared from a survey made by  
me on September 23, 1978.

William M. Watkins  
Registered Surveyor #5216.

ion checked for  
atical Accuracy  
S COUNTY

EEER'S OFFICE

DATE: Oct-4-78


*See 1 page*

17

TROY #1

N

1052

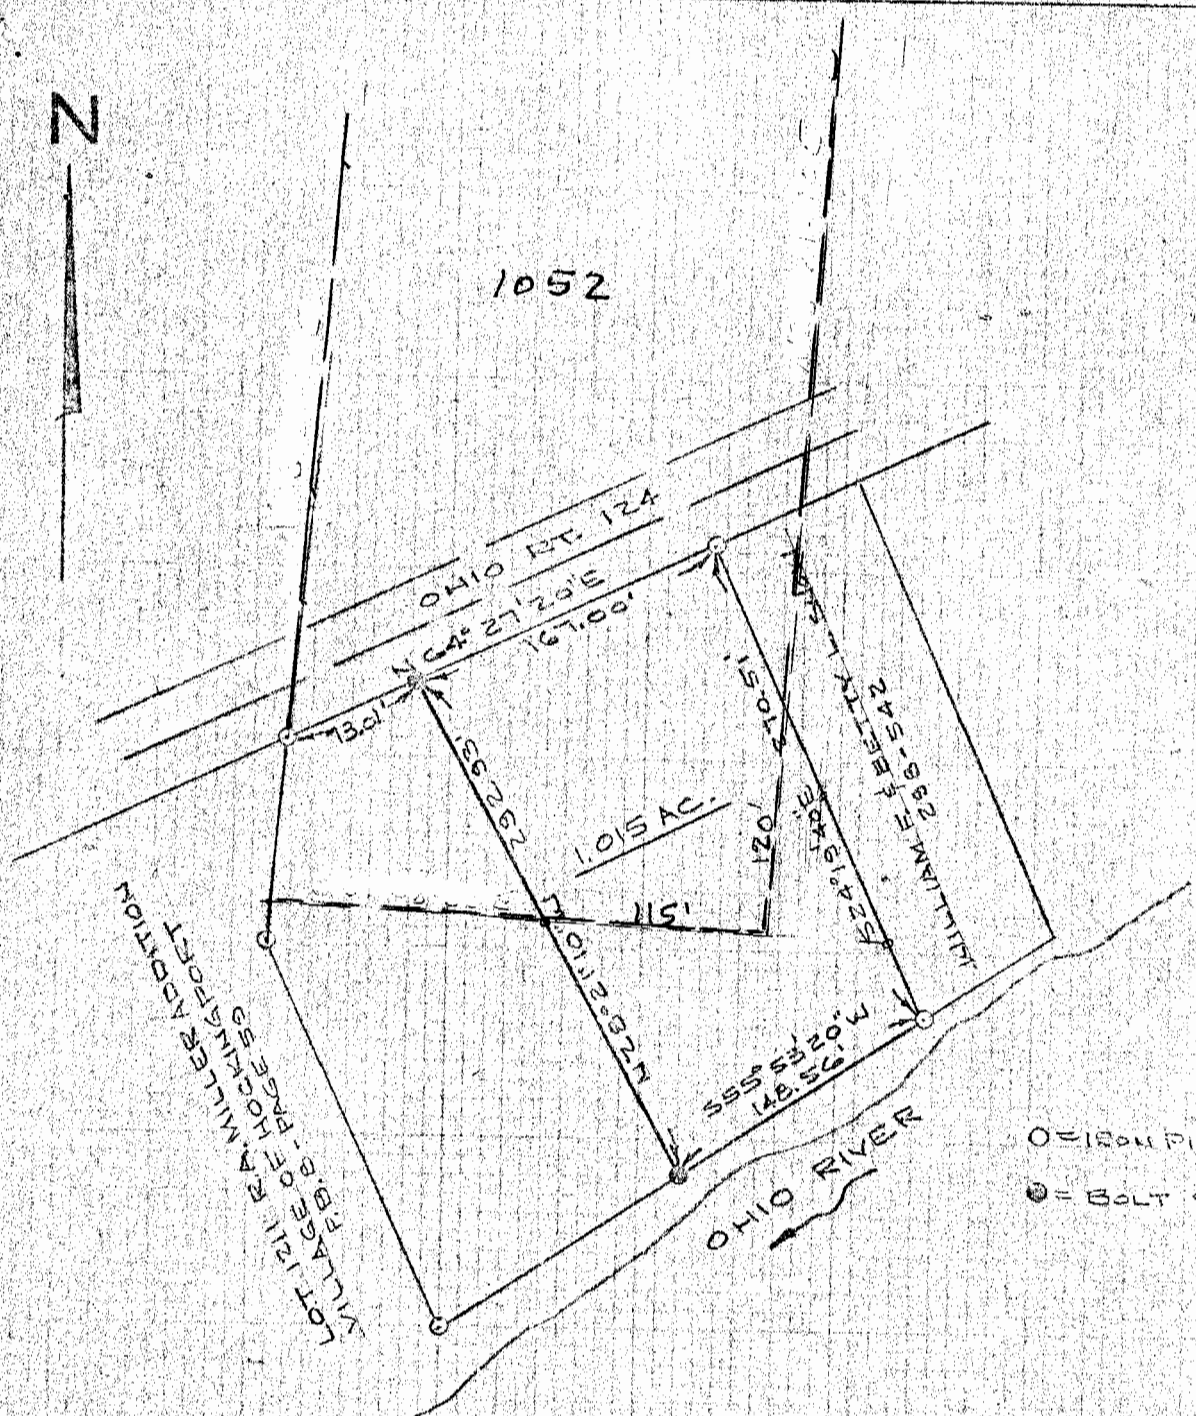

○ = IRON PIPE FOUND  
 ⊙ = BOLT SET

PLAT OF SURVEY - 1.015 ACRES  
 FOR JEAN A. FOUGHT  
 PART OF SECTION 1, TOWNSHIP RANGE 11  
 TROY TWP, ATHENS CO, OHIO  
 SCALE: 1" = 100' SURVEYED - SEPT. 23, 1973


*William M. Watkins*  
 REGISTERED SURVEYOR N° 5216

18



N

1052

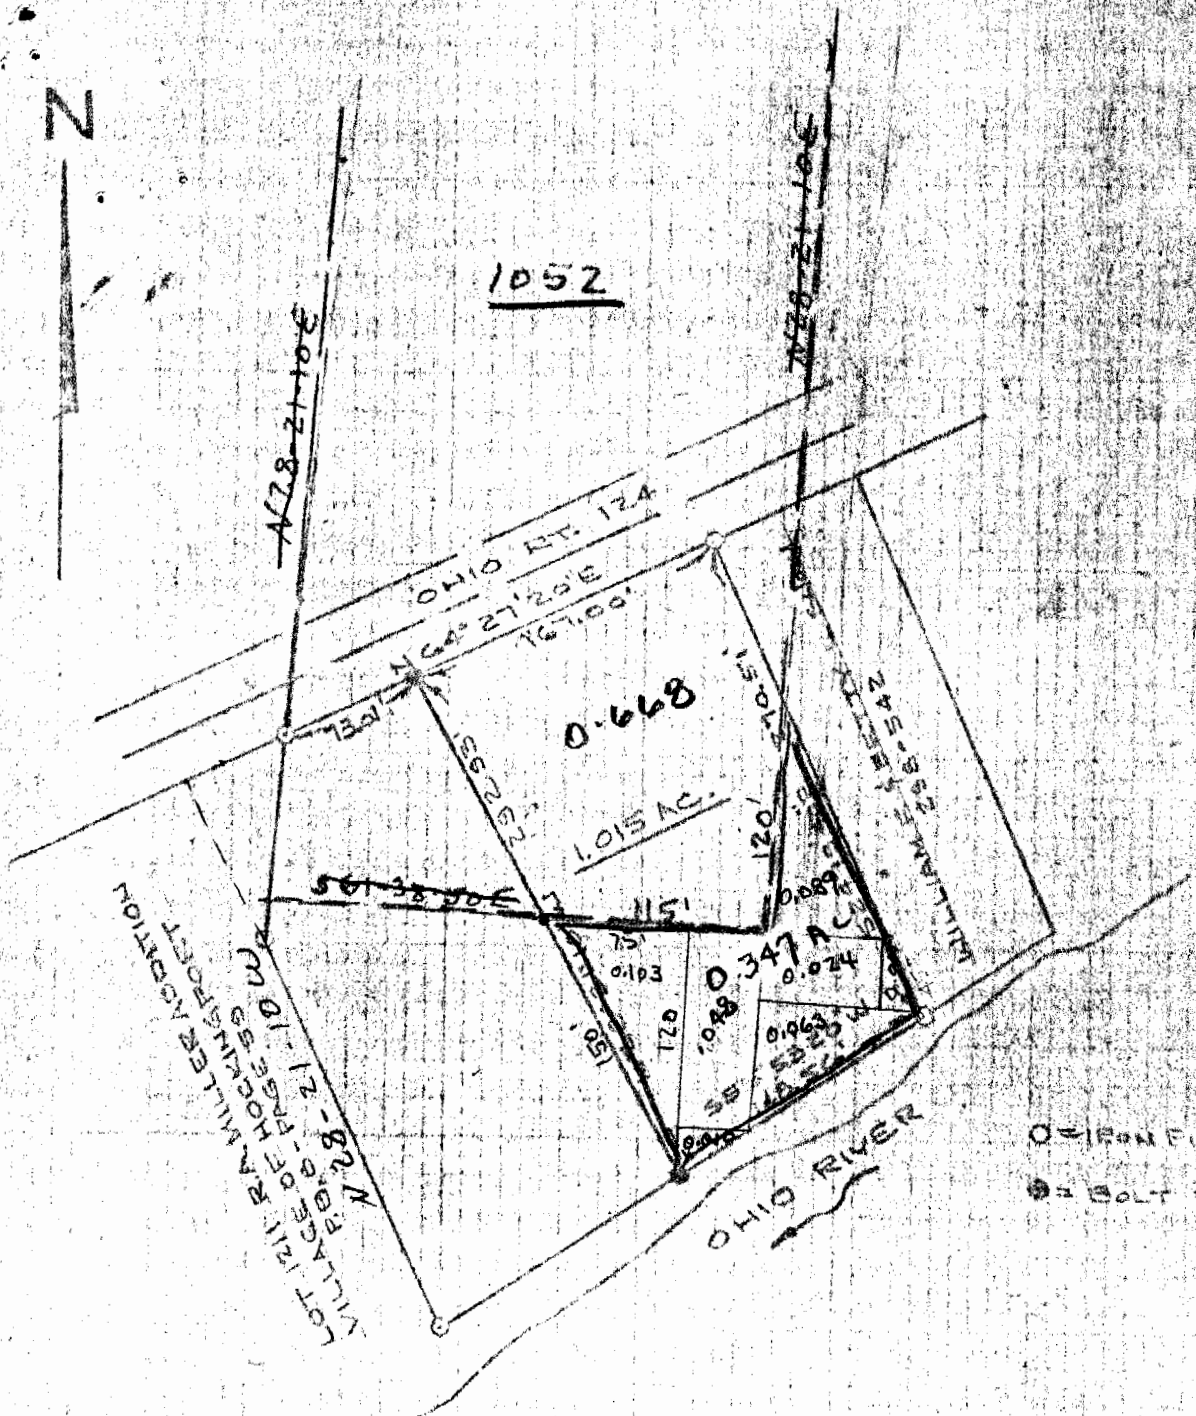

PLAT OF SURVEY - 1.015 ACRES  
 FOR JEAN A. FOUGHT  
 PART OF SECTION 1, TOWNSHIP RANGELI  
 TROY TWP., ATHENS CO., OHIO  
 SCALE: 1" = 100' SURVEYED - SEPT. 25, 1978

*William M. Watkins*  
 REGISTERED SURVEYOR NO. 6216

