

LEGAL DESCRIPTION

SITUATE in the Village of Hockingport, County of Athens, and State of Ohio:

Being a part of Lot No. 43 in Hockingport and further described as follows:
Beginning at the Southeast corner of Lot 43; thence 75 feet running parallel
with Pavillian Street; thence 90 feet running parallel with Grand Street, and
containing .15 acre, more or less.

The following restriction applies: Cannot be used for residential purposes.

This description prepared by Gene C. Bennett.

REFERENCE: Being part of Lot No. 43, Tract I, in Volume 375, Page 785, Deed
Records of Athens County, Ohio.

Description checked for
Mathematical Accuracy
ATHENS COUNTY
ENGINEER'S OFFICE
BY: Bob Eichenberg
DATE: 9/4/07

TROY #7


23

~~Bob, Please call~~
 after 5:00 on
 Thursday regarding
 a proposed lot split
 of Lot 48

Bcb →

Mr. Bennett
 667-6627 HOME

667-6627

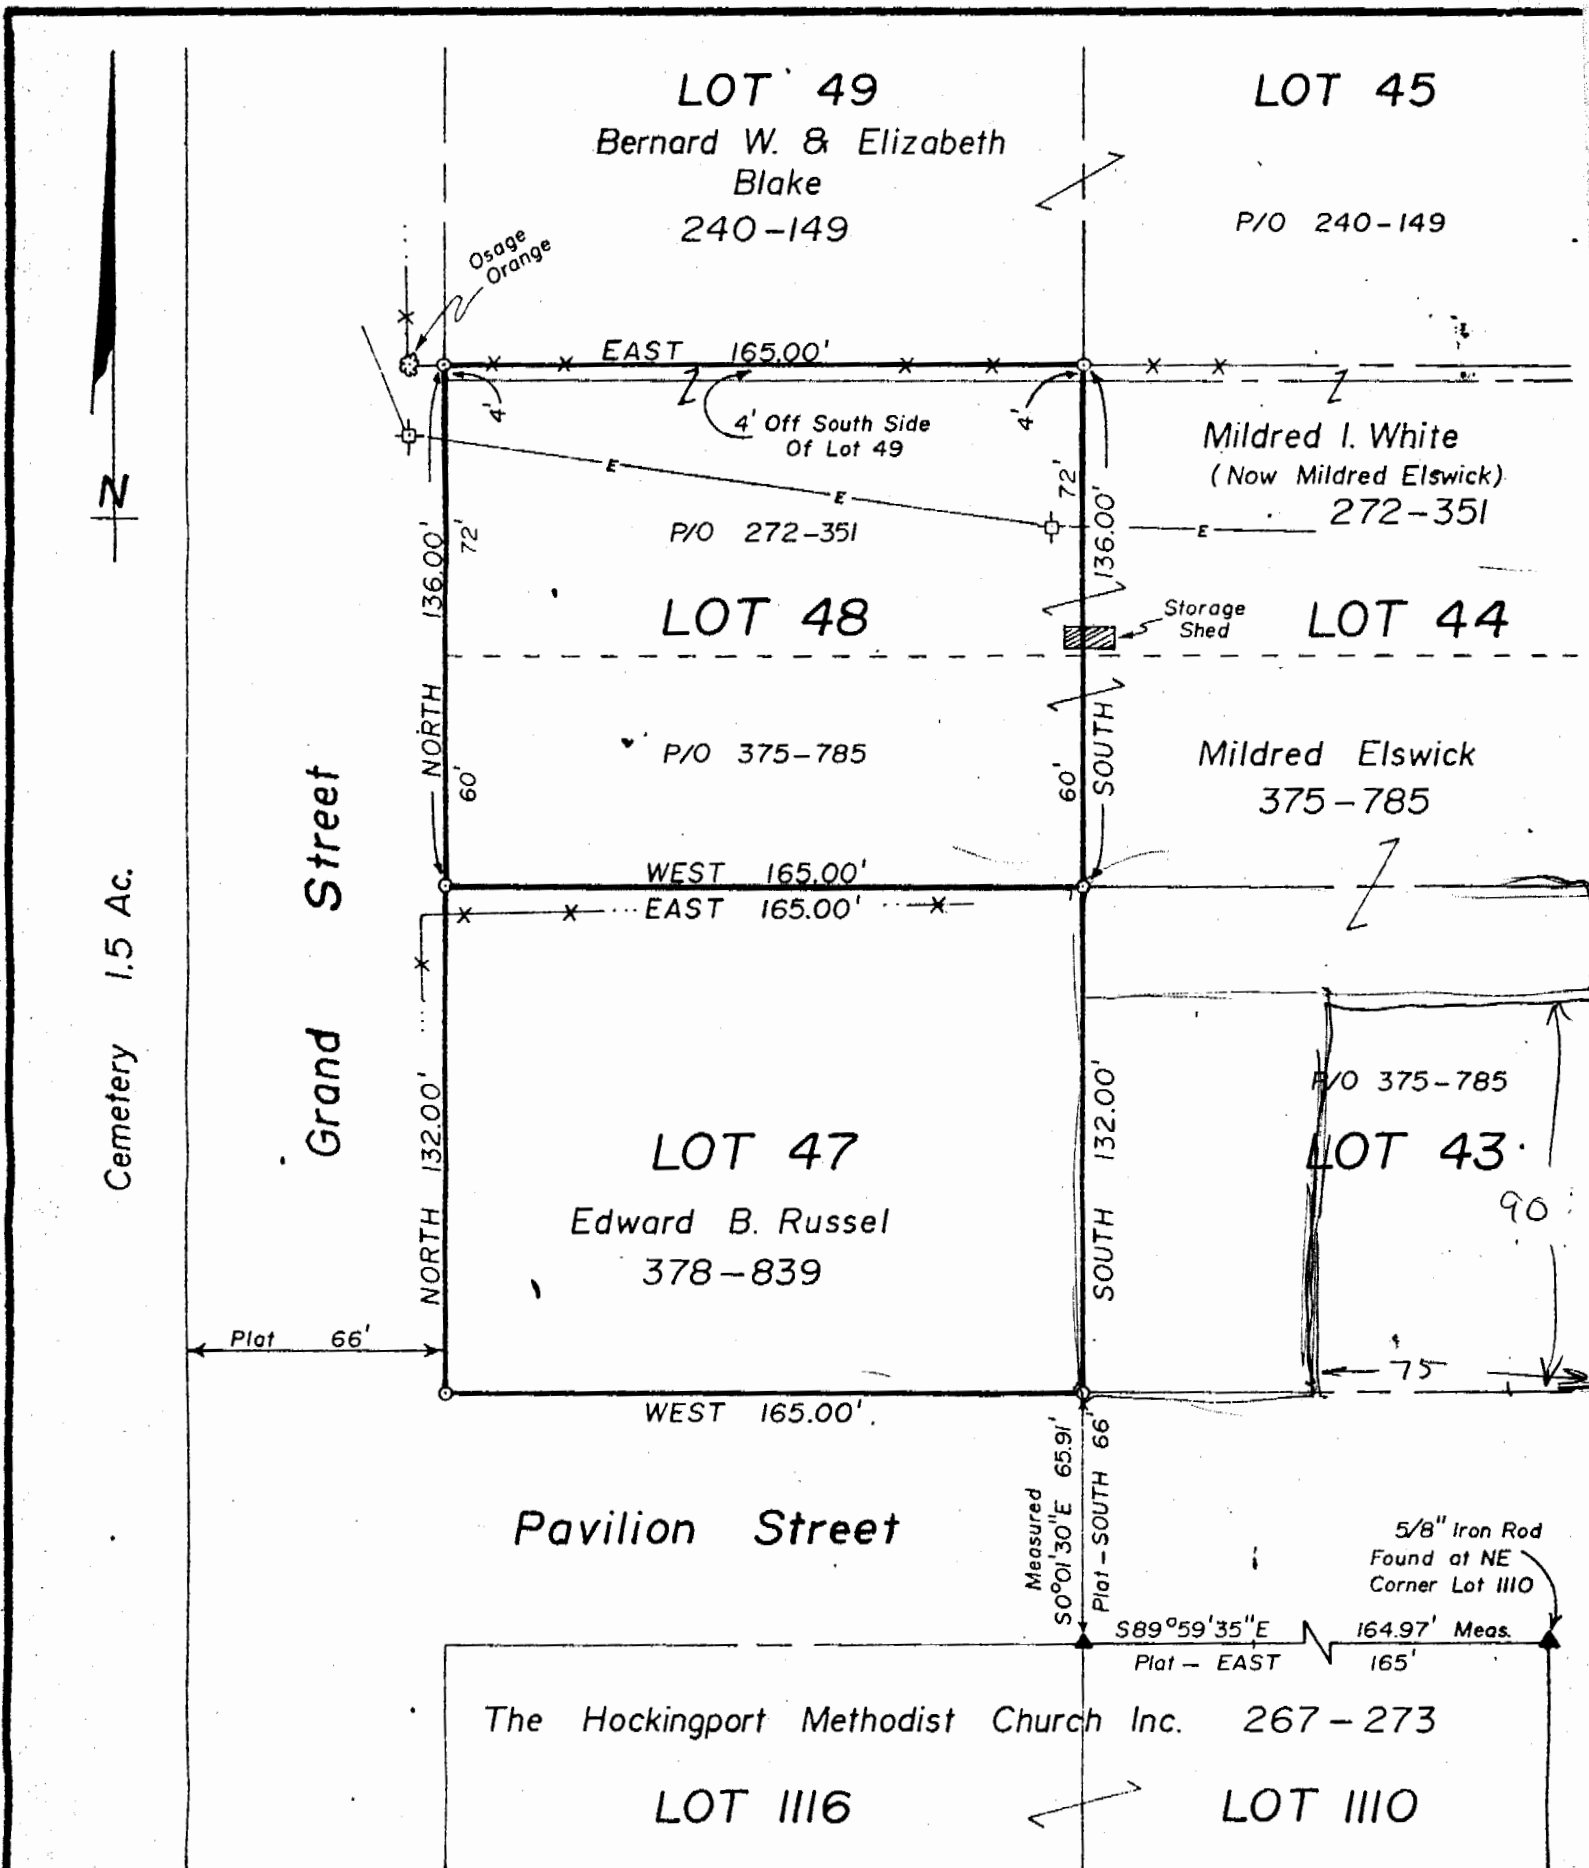

LEGEND

- — 5/8" X 30" Iron Rod Set
- ▲ — 5/8" Iron Rod Found
- ⊕ — Existing Power Pole
- x--- — Existing Fence

SCALE

