


Sec 7  
Troy  
315-217

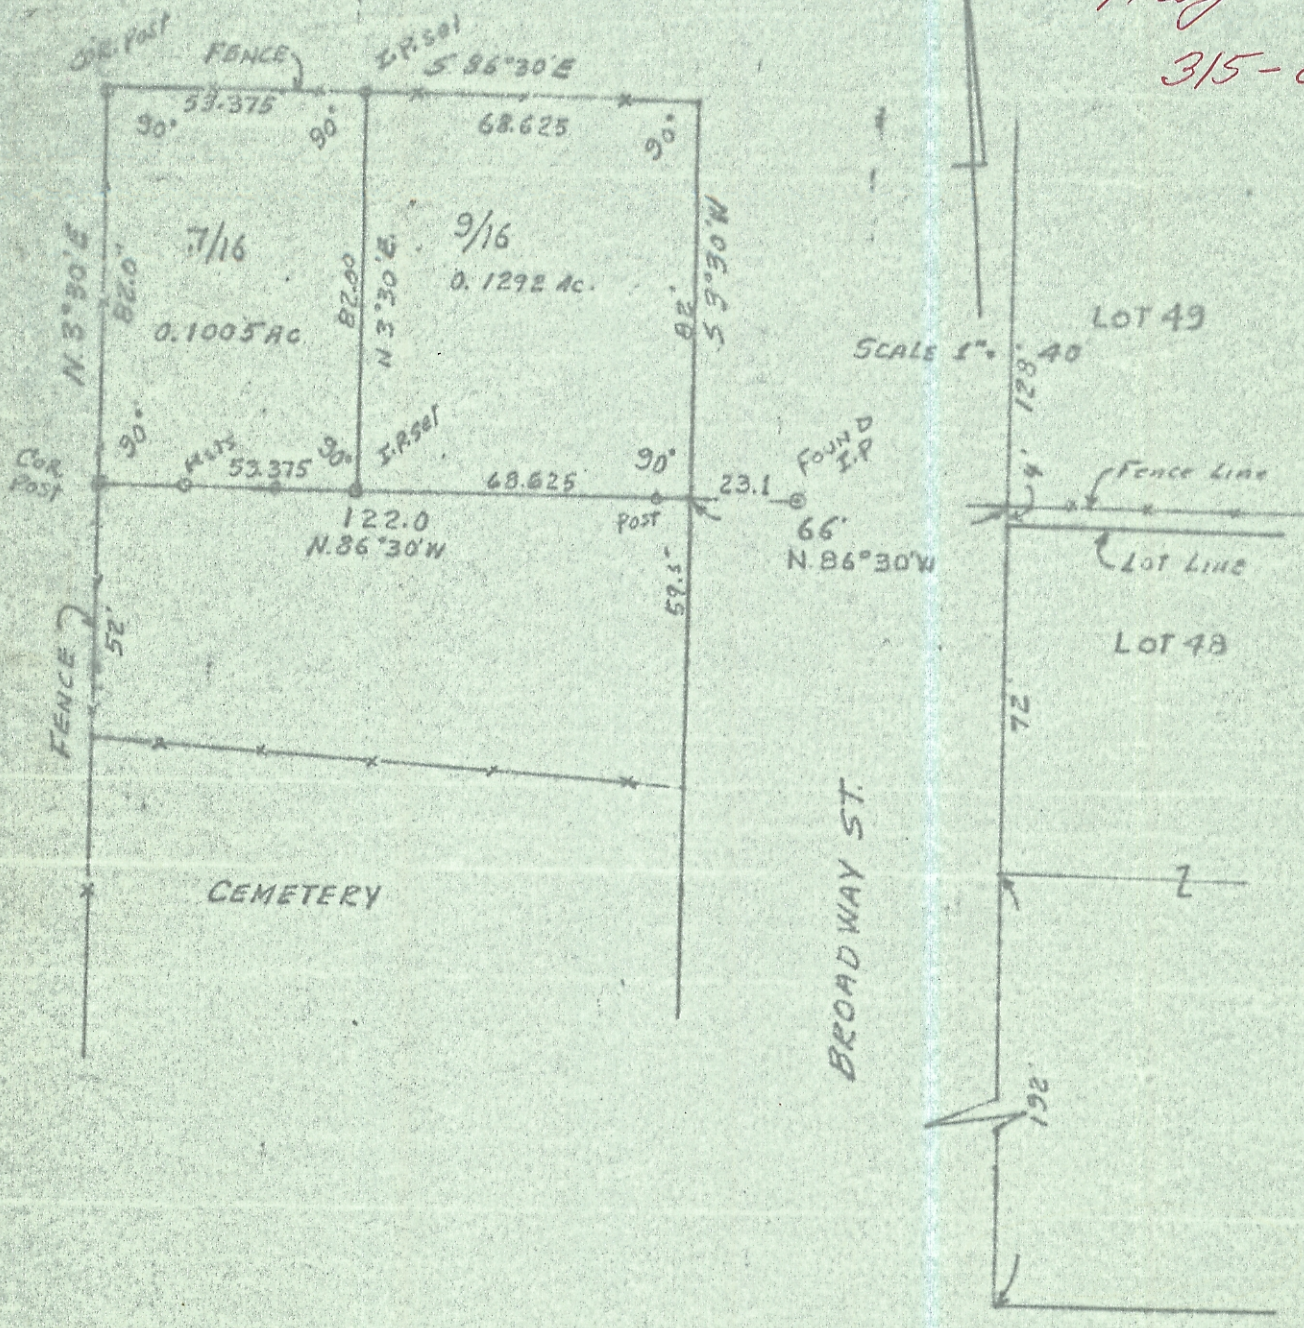

SURVEY & DIVIDING A 0.2297 AC. TRACT  
IN SEC. 7 TROY TWP. ATHENS COUNTY,  
VILLAGE OF HOCKINGPORT, OHIO  
for MARY LEE PARSONS

SURVEYED MAY 22, 1973 by HAROLD D. WHALEY  
Harold D. Whaley  
REG. SURV. NO. 4986