

DESCRIPTION - 1.163 ACRES

PART OF LARRY D. & JUDY G. RADFORD PROPERTY

VOLUME 336, PAGE 625

Situated in the Township of Waterloo, County of Athens,  
State of Ohio and being a part of Fraction 18, Section 22, Town  
11, Range 15, more particularly described as follows:

Commencing at the northeast corner of Fraction 18; thence  
north  $84^{\circ}20'51''$  west 1154.27 feet to a point in Ohio Route 56;  
thence south  $18^{\circ}27'58''$  east along the center line of the State  
Route, 258.12 feet to a point, said point being the place of  
beginning for the tract of land herein described; thence contin-  
uing along the center line of Ohio Route 56, south  $18^{\circ}27'58''$  east  
300.0 feet to a point; thence leaving the center line of the State  
Route, north  $83^{\circ}30'00''$  west 233.33 feet to an iron pin set,  
passing through an iron pin set at 25.0 feet; thence north  $14^{\circ}58'16''$   
west 190.44 feet to an iron pin set; thence north  $68^{\circ}15'44''$  east  
200.24 feet to the place of beginning, passing through an iron  
pin set at 178.2 feet and containing 1.163 acres.

Subject to all legal rights of way and easements of record.

This description was prepared from an actual survey of the  
premises made by me February 24, 1983.

William M. Watkins

Registered Surveyor #S5216

Description checked for  
Mathematical Accuracy  
ATHENS COUNTY  
ENGINEER'S OFFICE

BY: Charles Whitney  
DATE: 2-28-83

22

Waterloo, Sect. 2


FR. 17  
FR. 18

N84° 20' 51" W 1154.27'

N.E. CORNER  
FR. 18

NORTH

LARRY D. & JUDY GAY RADFORD  
336-G25  
25.004 ACRES

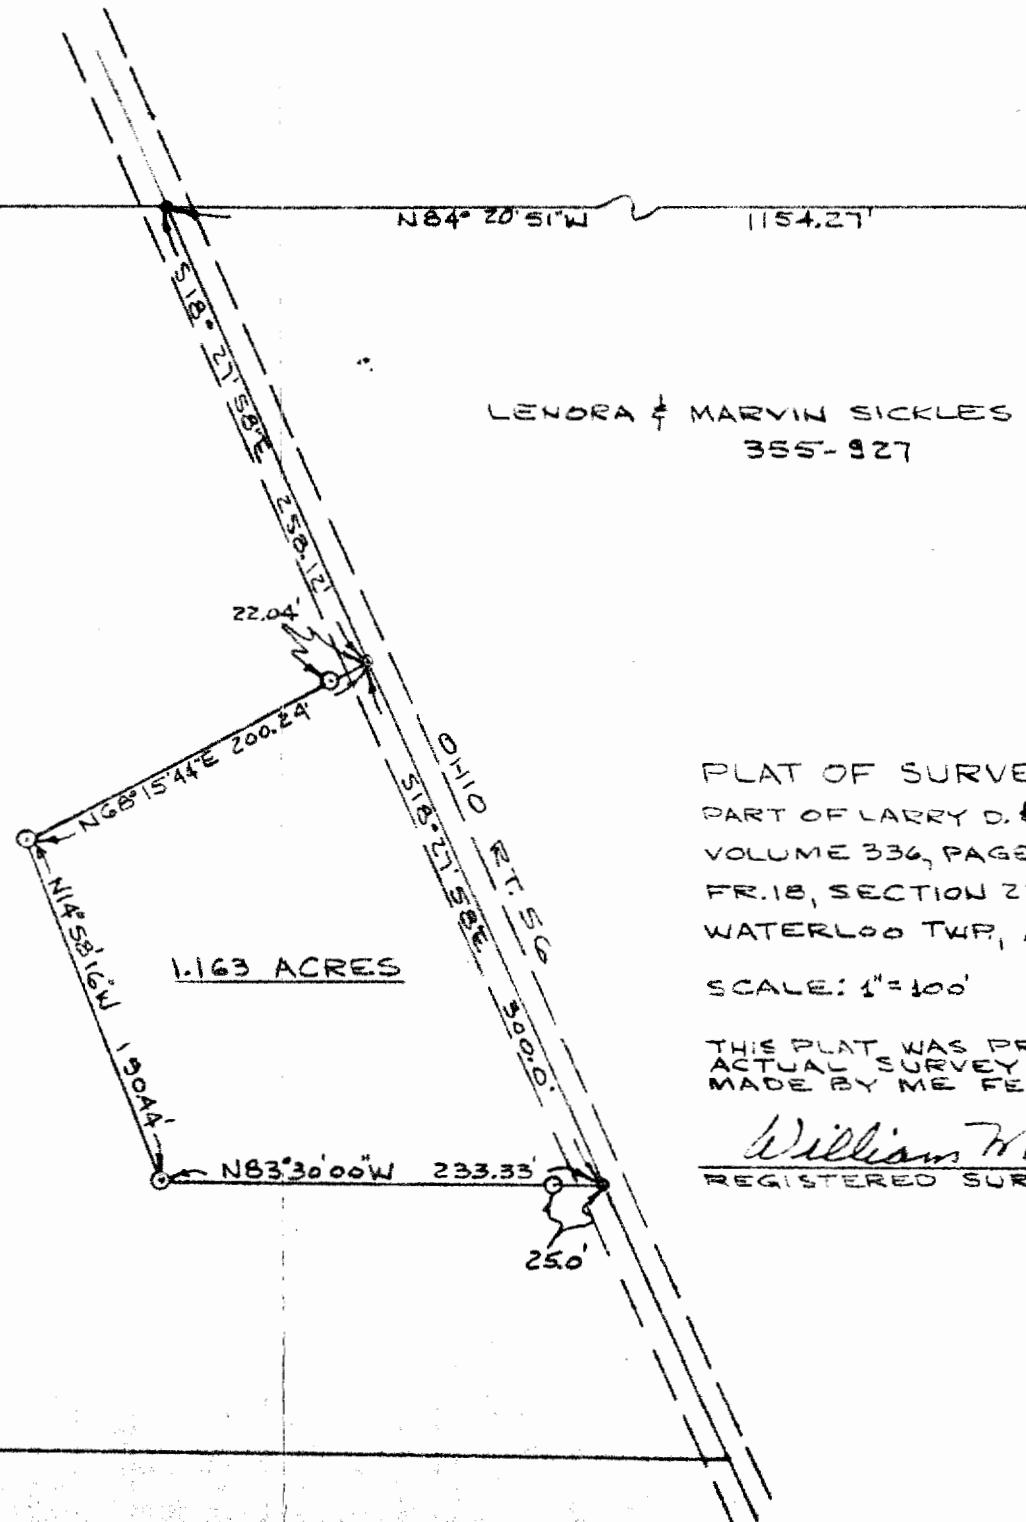


PLAT OF SURVEY - 1.163 ACRES  
PART OF LARRY D. & JUDY G. RADFORD PROPERTY  
VOLUME 336, PAGE 625  
FR. 18, SECTION 22, TOWN 11, RANGE 15,  
WATERLOO TWP., ATHENS CO., OHIO

SCALE: 1" = 100' FEB. 28, 1983

THIS PLAT WAS PREPARED FROM AN  
ACTUAL SURVEY OF THE PREMISES  
MADE BY ME FEB. 24, 1983.

William M. Watkins  
REGISTERED SURVEYOR NO. 5-5216

O = IRON PIN SET

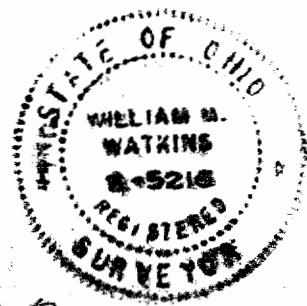

23