

HIGHLAND SURVEYING
80 Fayette Street
Nelsonville Ohio 45764

Description of a 1.014 Acre Tract

Situated in Section 5, Town II, Range 15
Waterloo Township, Athens County Ohio and being
a part of a tract of land described in Volume 83
Page 302 of the official records of Athens County
and being more particularly described as follows:

Commencing at a point in County Road 22,
said point North 1285.67 feet and West 366.96 feet
from the Southeast corner of Section 5

thence along said road North $89^{\circ}00'00''$ East
177.64 feet

thence leaving said road South $14^{\circ}23'59''$ West
383.54 feet to an Iron Pin set, passing an Iron Pin
set at 29.19 feet

thence North $48^{\circ}19'01''$ West 102.92 feet to a
set Iron Pin

thence North $1^{\circ}01'33''$ West 300.00 feet,
passing an Iron Pin found at 270.00 feet to
the point of beginning and containing 1.014 Acres

Subject to all Easements and Rights of Way
of Record


Kenneth E. Highland S-7581

Description checked for
Mathematical Accuracy
ATHENS COUNTY
ENGINEER'S OFFICE
BY: *S. Blausen*
DATE: *7-28-94*



41

WAT# 5

HIGHLAND SURVEYING
80 Fayette Street
Nelsonville Ohio 45764

Description of a 0.688 Acre Tract

Situated in Section 5, Town II, Range 15
Waterloo Township, Athens County Ohio and being
a part of a tract of land described in Volume 83
Page 302 of the official records of Athens County
and being more particularly described as follows:

Commencing at a point in County Road 22,
said point North 1285.67 feet and West 366.96 feet
from the Southeast corner of Section 5

thence South $1^{\circ}01'33''$ East 300.00 feet to an
Iron Pin set passing an Iron Pin found at 30.00 feet
thence South $89^{\circ}00'00''$ West 100.00 feet to an
Iron Pin found

thence North $1^{\circ}01'33''$ West 300.00 feet passing
an Iron Pin found at 270.00 feet to a point in
county road 22

thence along said road North $89^{\circ}00'00''$ East
100.00 feet to the point of beginning and containing
0.688 Acres

Subject to all Easements and Rights of Way
of Record

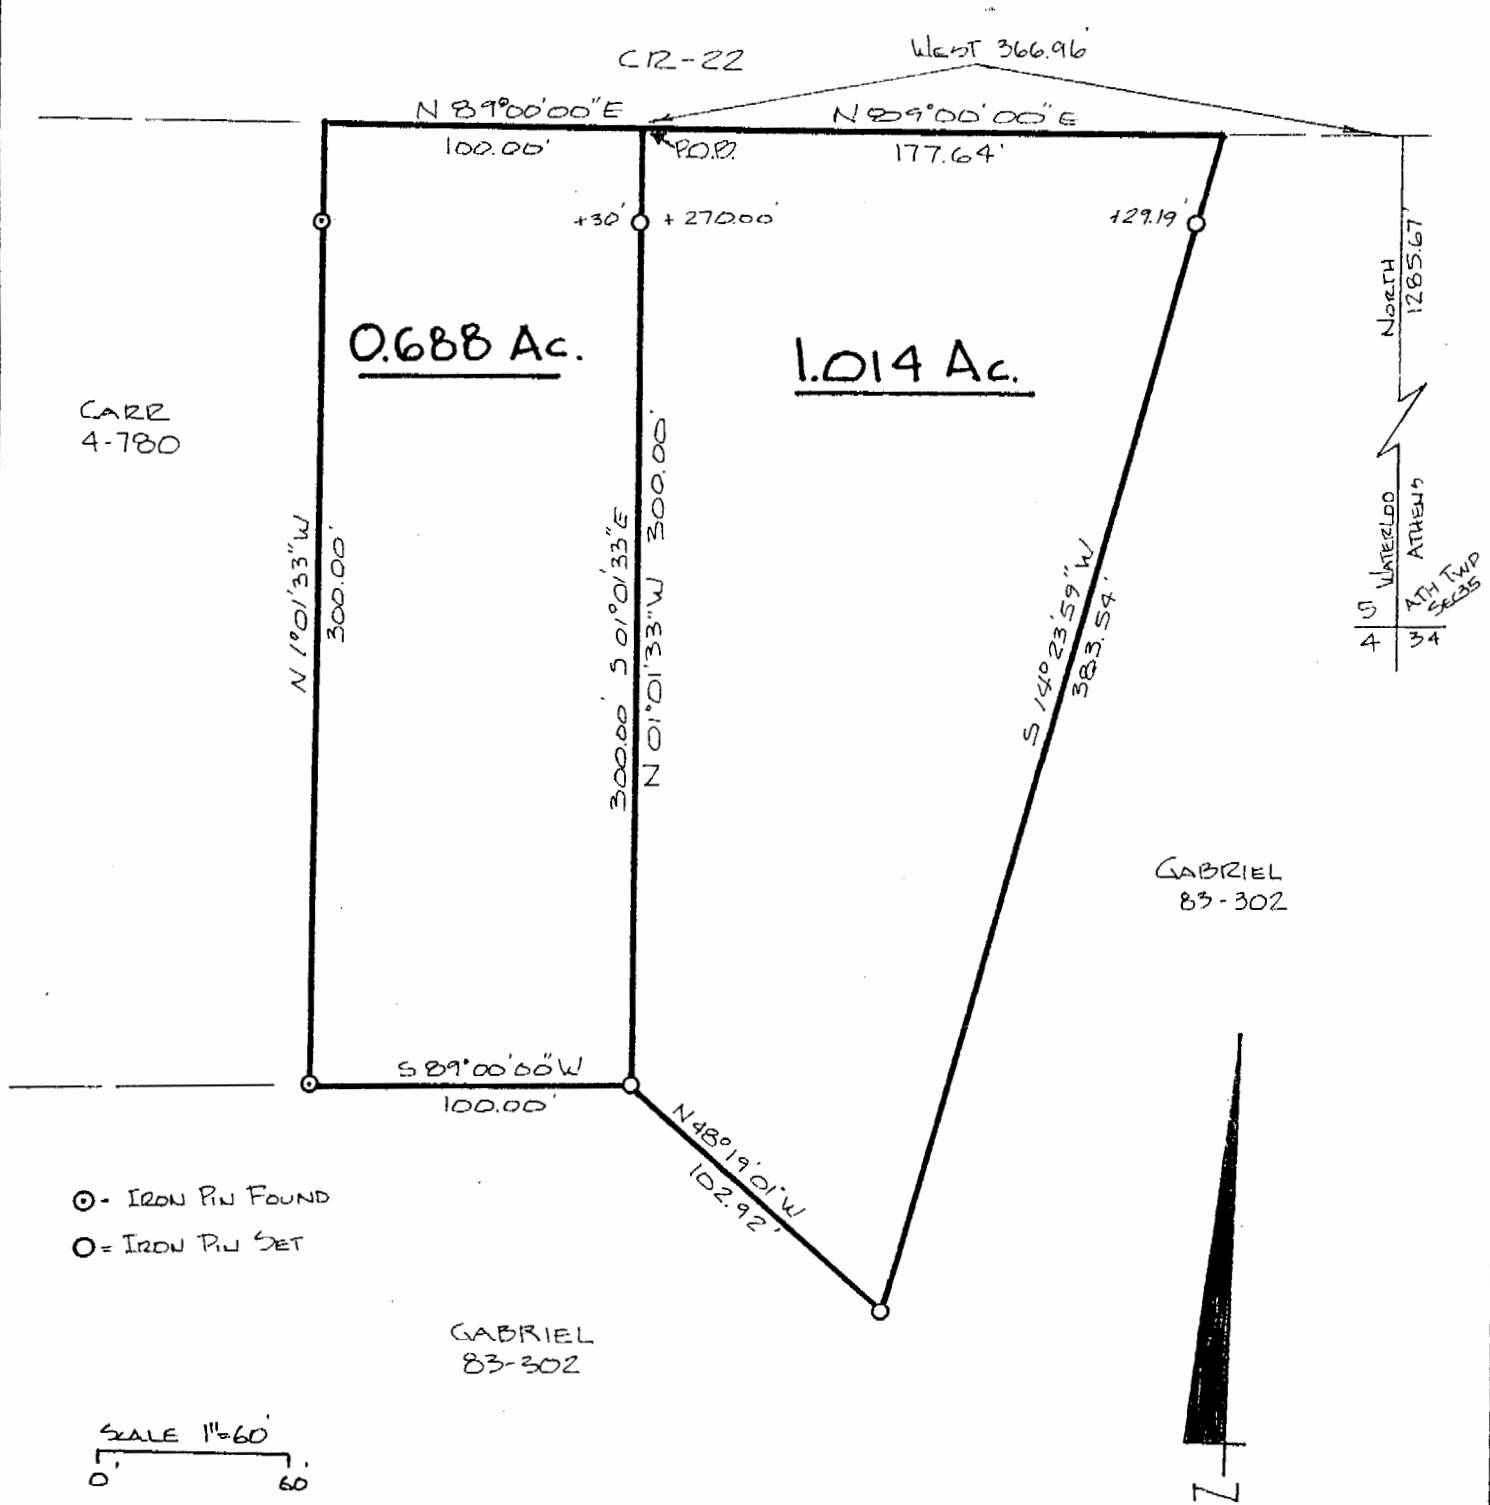

Kenneth E. Highland S-7581

Description checked for
Mathematical Accuracy
ATHENS COUNTY
ENGINEER'S OFFICE
BY: S. Blausen
DATE: 9-28-94

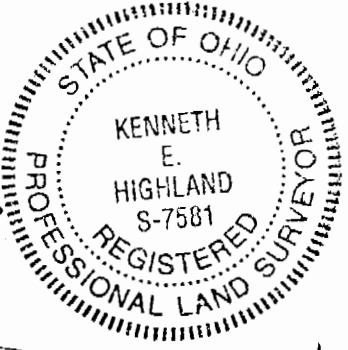


HIGHLAND SURVEYING

REGISTERED PROFESSIONAL LAND SURVEYOR



PLAT of SURVEY OF TWO TRACTS
 SURVEYED for FLOYD GABRIEL
 SUBDIVISION _____
 TOWNSHIP Waterloo SECTION 5 TOWN 11 RANGE 15
 CORPORATION _____ COUNTY ATHENS STATE OHIO
 SCALE 1"= 60' DATE SEPT 1994



KENNETH E. HIGHLAND
 80 FAYETTE STREET
 NELSONVILLE, OHIO 45764
 614-753-1264

Kenneth E. Highland
 Kenneth E. Highland S-7581

45