

1.685 Acre Tract  
William Smith

Situated in the Northwest Quarter of Sec. 6, R. 11, N. 15, Waterloo Twp., Athens County, Ohio, and being more particularly described as follows:

Beginning at the Northwest corner of Sec. 6; Thence along the North line of Sec. 6, and the line between Waterloo and York Townships, S. 84° 45' E., 150.00 feet to a point;

Thence S. 6° 12' W. (passing an iron pin at 25.00 feet) for a total distance of 437.94 feet to an iron pin;

Thence S. 61° 07' W., 183.29 feet to an iron pin on the West line of Sec. 6;

Thence along the West line of Sec. 6, <sup>N. 6° 12' E.</sup> (passing an iron pin at 30.8 feet, an iron pin at 515.80 feet) for a total distance of 540.80 feet to the point of beginning, containing 1.685 acres, and being part of a 5.76 acre tract described in Vol. 181, Page 45 of the Athens County Deed Records.

Surveyed June 19, 1973 by HAROLD D. WHALEY

*Harold D. Whaley*  
Reg. Surveyor No. 4986


Description checked for  
Mathematical Accuracy  
ATHENS COUNTY  
ENGINEER'S OFFICE

BY: *Hub Shields*

DATE: *June 24, 1980*

*See file 13 Jan 200*

*2*

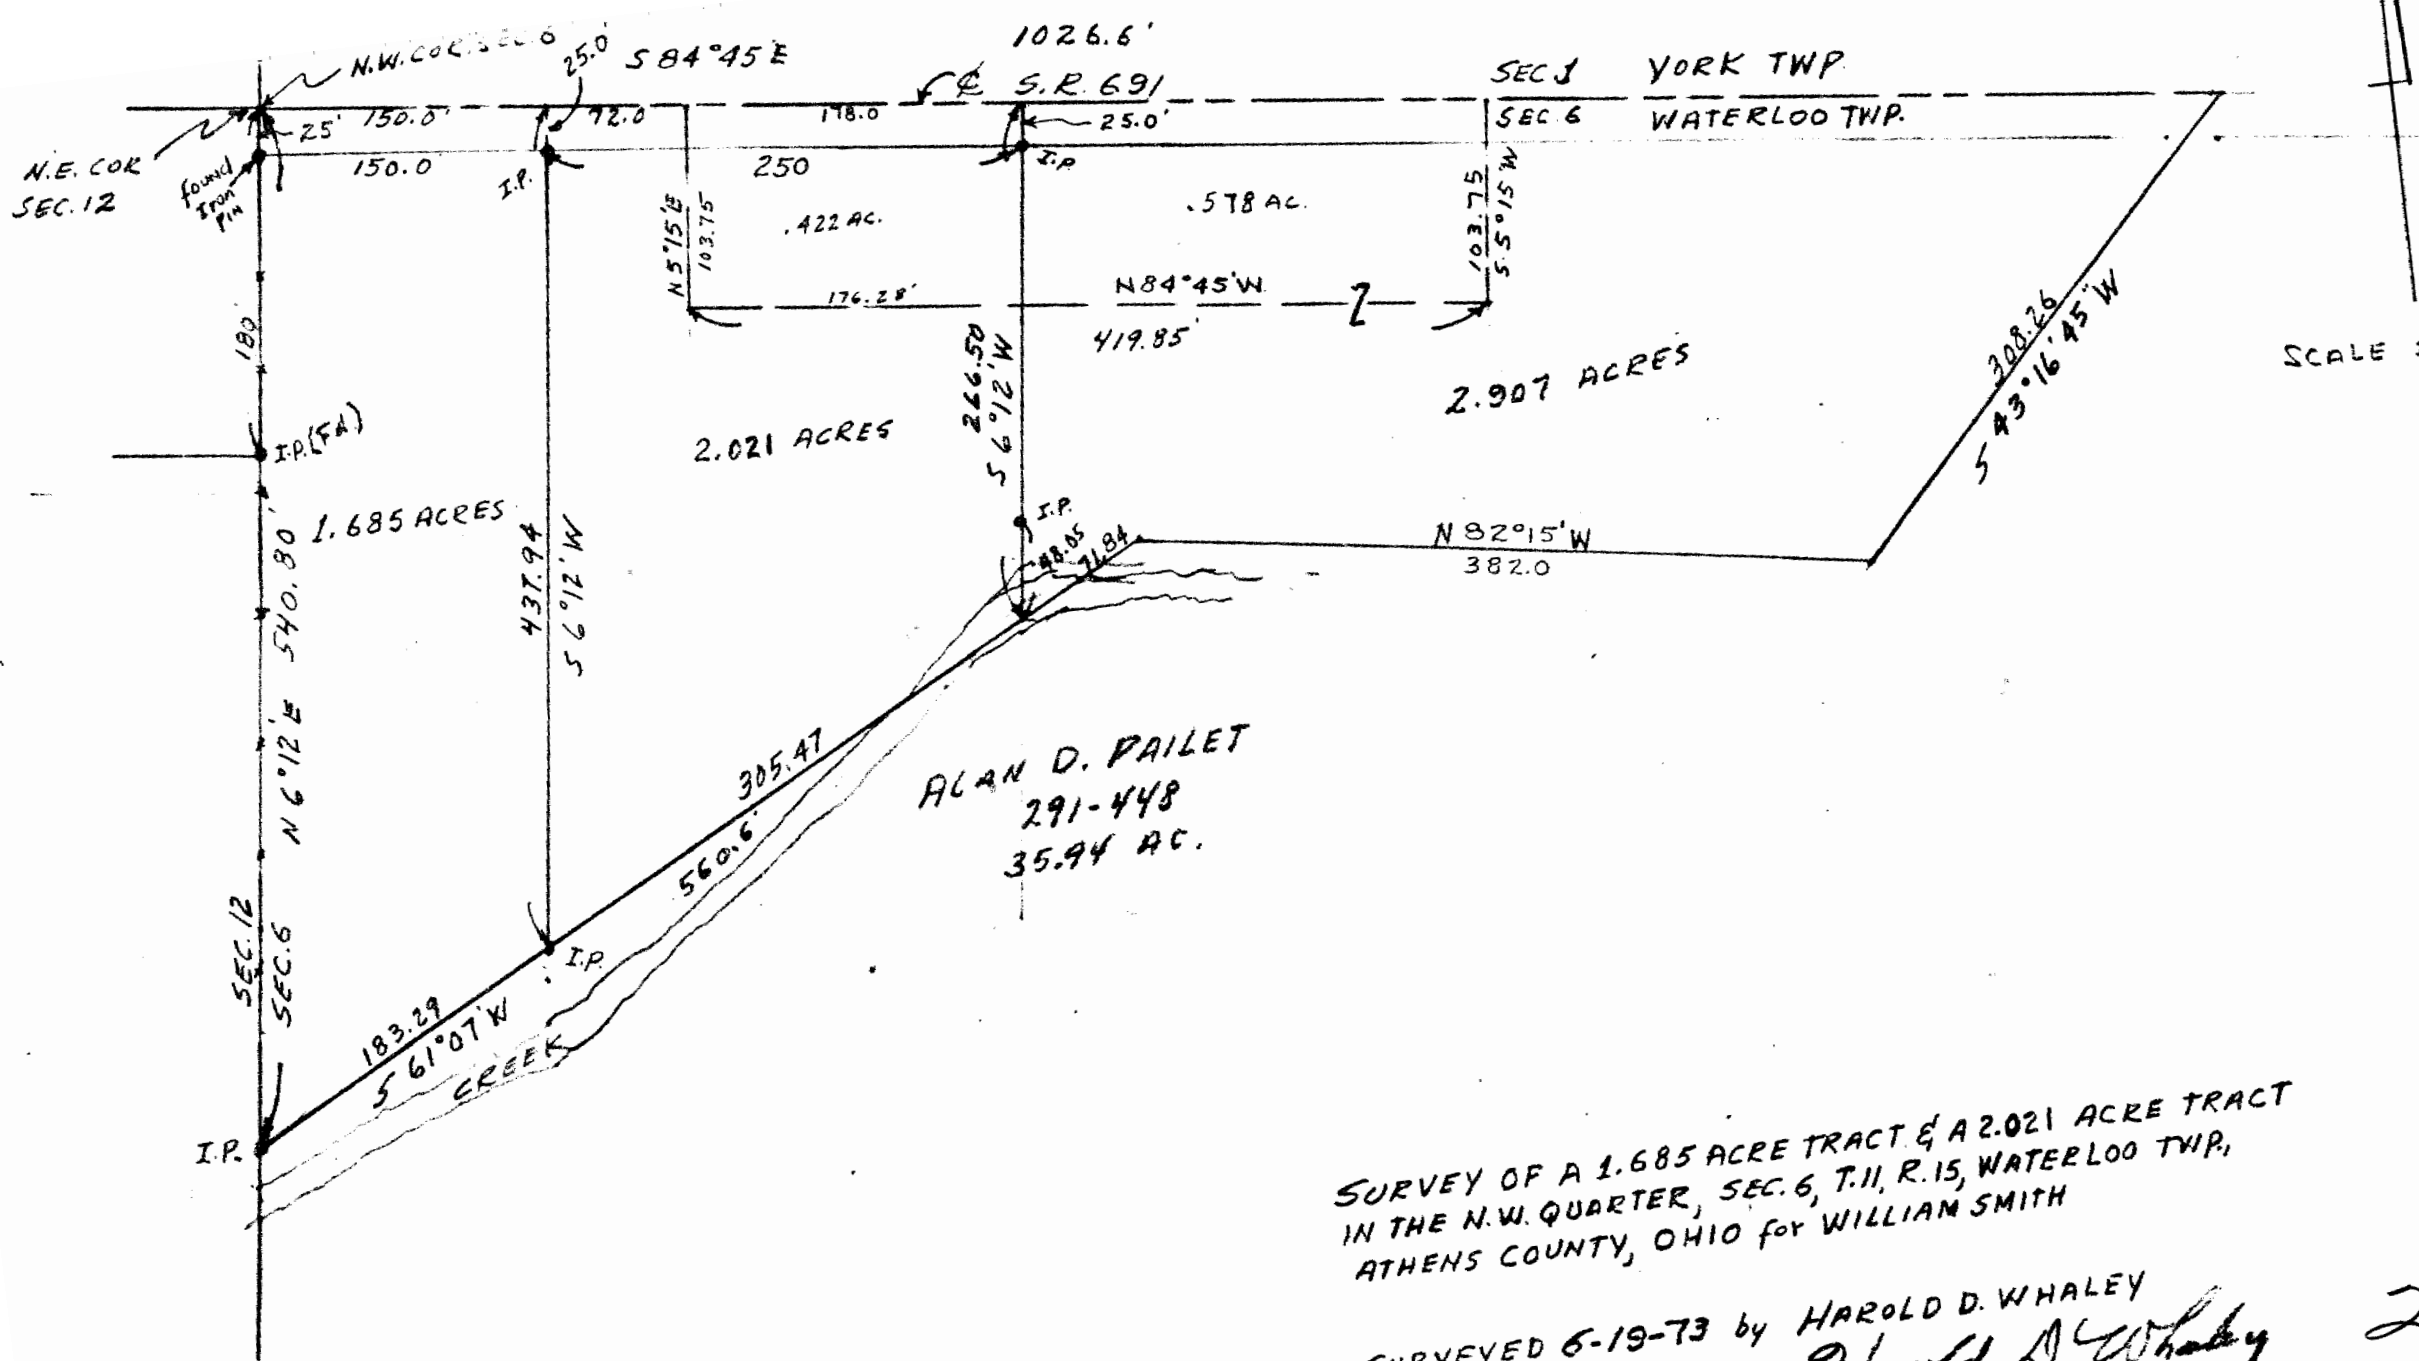

SCALE 1"=100'

ALAN D. PAILET  
291-448  
35.94 AC.

SURVEY OF A 1.685 ACRE TRACT & A 2.021 ACRE TRACT  
IN THE N.W. QUARTER, SEC. 6, T.11, R.15, WATERLOO TWP,  
ATHENS COUNTY, OHIO for WILLIAM SMITH

SURVEYED 6-19-73 by HAROLD D. WHALEY  
*Harold D. Whaley*  
REG. SURVEYOR NO. 4986

3