

FOR : Herman & Anna Lohse
DATE: 18 November 1976

Situate in the East one-half (1/2) of F.R. 5, Section 10, Town 11, Range 15, Waterloo Township, Athens County, State of Ohio and being more particularly described as follows:


Commencing at a point in the Southeast corner of F.R. 5 (Section 10); thence N 83°31'43" W along the South line of said F.R. 5 (Section 10), 599.85 feet to a railroad spike set in the centerline of Athens County Road No. 100, passing through a stone found in the Grantor's Southeasterly corner at 313.50 feet, said railroad spike set also being the real point of beginning of the parcel herein described:

Thence continuing N 83°31'43" W along said South line of F.R. 5 (Section 10) and the Grantor's South line, 347.35 feet to an iron bar set 25.00 feet West of the Northeast corner of a 45.83 acre tract presently owned by the Grantee, passing through another iron bar set at 40.00 feet; thence N 06°28'17" E along a random line, 169.43 feet to a railroad spike set in the centerline of said Athens County Road No. 100, passing through another iron bar set at 139.43 feet; thence S 59°41'38" E along said centerline of Athens County Road No. 100, 172.44 feet to a mine spike set, passing through another mine spike set at 15.37 feet; thence S 55°46'58" E continuing along said Athens County Road No. 100, 214.25 feet to the point of beginning, passing through a mine spike set at 149.38 feet, and containing 0.7044 acre.

Subject to all legal highways and easements of record.

Grantor claims title for the above described parcel by Deed Book 290, Page 42 as recorded in the Athens County Recorder's Office, Athens County, Ohio.

Description for the above described parcel is based on a survey completed on 18 November 1976, by Gerald W. Bayha, Registered Professional Surveyor No. S-6139.

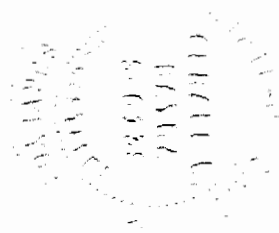


Description checked for
Mathematical Accuracy
ATHENS COUNTY
ENGINEER'S OFFICE

BY: *Gerald W. Bayha*
DATE: *Nov 22-76*

*Set # 10
Waterloo*

14 WPT # 10

SCALE: 1" = 40'

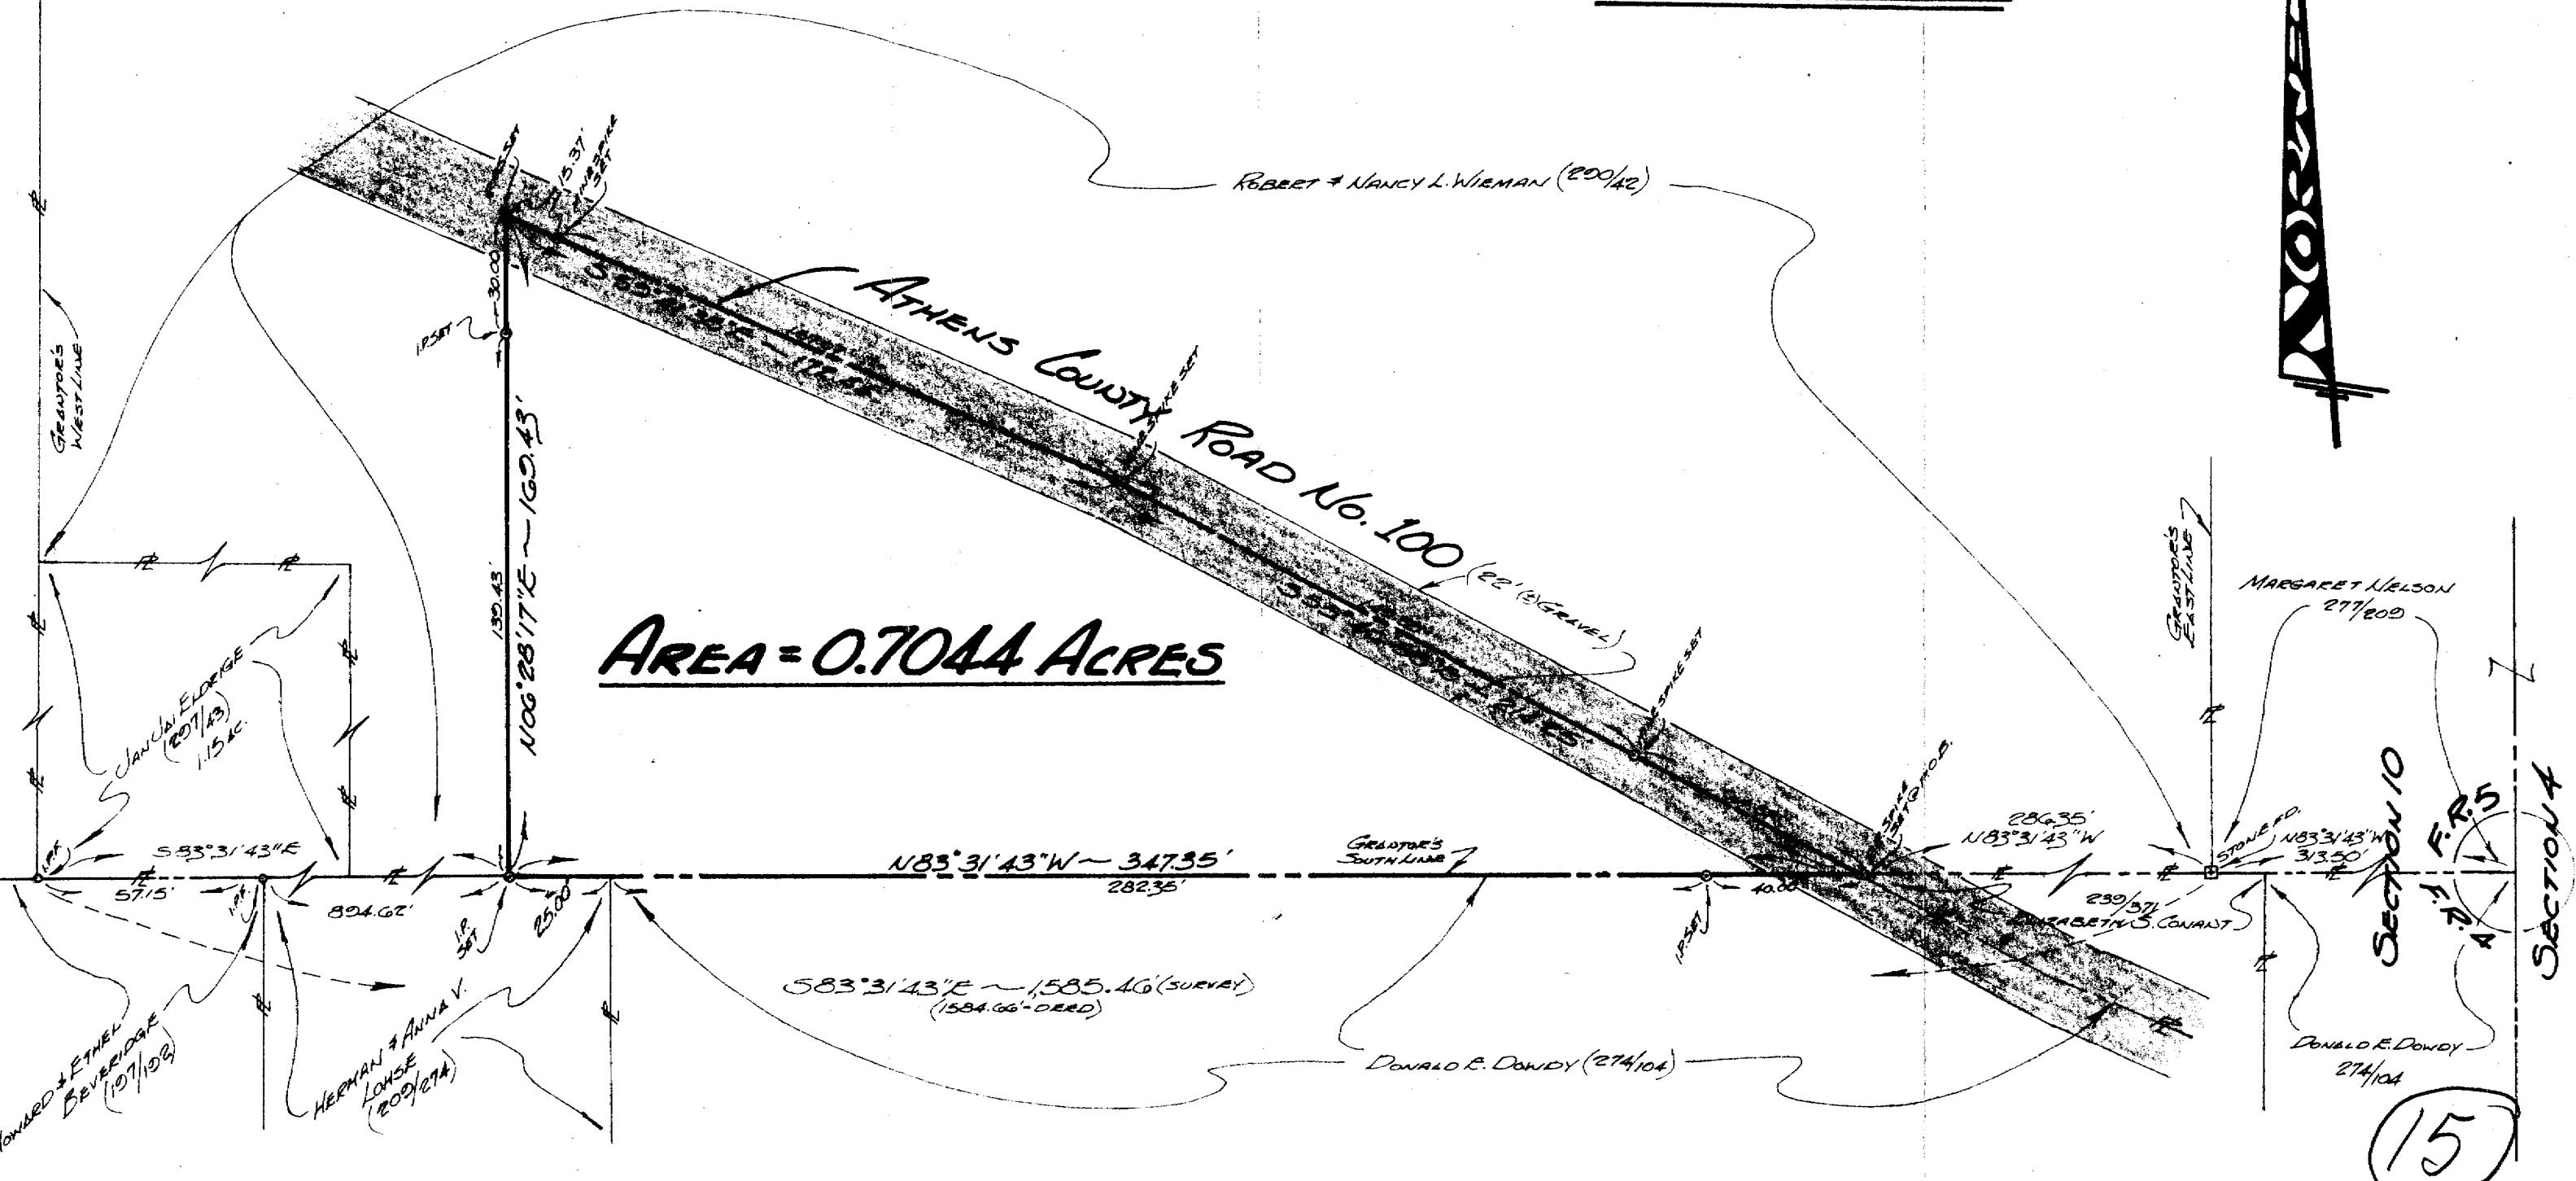

FOR: **HERMAN & ANNA V. LOHSE**
 17 JACOBS AVENUE
 CHAUNCEY, OHIO 45719

BY: **GERALD W. BAYHA, P.S.**
 REGISTERED PROFESSIONAL SURVEYOR No. S-6139
 ROUTE No. 5 ~ BOX No. 204
 (PLEASANT HILL) ATHENS, OHIO ~ 45701 ~ (614) 592-4398

PLAT OF SURVEY

OF A _____ ACRE PARCEL SITUATE IN THE E. 1/2
 OFF F.R. 5 ~ SECTION 10 ~ TOWN 11 ~ RANGE 15 ~ WATER-
 LOO TOWNSHIP ~ ATHENS COUNTY ~ OHIO ~ U.S.A.

DRAWN	CHECKED	REVISIONS	DATE	JOB No.
GB	GB		13 Nov. 1976	#1176-01

1
1