

Legal Description Pre-Approval
APPROVED
All transfers are subject to
Athens County Conveyance Standards

Description Checked for
Mathematical Accuracy
Athens County
ENGINEER'S OFFICE
BY: *Percey Williams*
DATE: 7/5/16

JUL 07 2016

Jill Thompson
Athens County Auditor

COUNTRYTYME LAND, LLC (GRANTOR)
6.988 ACRES

Situate in the Township of Waterloo, County of Athens, State of Ohio, being part of the Northeast Quarter of the Southeast Quarter of Section 6, Township 11 North, Range 15 West, Ohio Company Lands, and also being part of an original 34.753 acre tract conveyed to Countrytyme Land, LLC as recorded in O. R. Volume 519, Page 2544, Athens County Official Records, and being bounded and described as follows:

Beginning at a 3 inch by 3 inch by 3 inch high stone (found) at the northwest corner of the Northeast Quarter of the Southeast Quarter of said Section 6, Township 11 North, Range 15 West, said stone being in the east line of an original 118.80 acre tract conveyed to Alan Pailet (O. R. Volume 285, Page 759, Tract Fourteen, A.C.O.R.), thence with a new division line through the original 34.753 acre tract of which this is a part, S.84Deg.43'01"E., passing a 5/8 inch diameter by 30 inch long iron rebar (set) at 670.78 feet, a total distance of 689.49 feet to a 1/4 inch diameter by 2 inch long iron spike (set) in the centerline of Poston-Salem Road (T-1266);

thence with the centerline of said Poston-Salem Road for the next six (6) calls:

- 1.) S.15Deg.44'58"W. 86.56 feet to a point;
- 2.) thence S.20Deg.40'36"W. 151.15 feet to a point;
- 3.) thence S.24Deg.37'54"W. 81.28 feet to a point;
- 4.) thence S.25Deg.36'12"W. 62.28 feet to a point;
- 5.) thence S.22Deg.30'43"W. 68.55 feet to a point;
- 6.) thence S.20Deg.26'20"W. 68.67 feet to a 1/4 inch diameter by 2 inch long iron spike (set);

thence leaving said Poston-Salem Road and with another new division line through the original 34.753 acre tract of which this is a part, N.83Deg.31'54"W., passing a 5/8 inch diameter by 30 inch long iron rebar (set) at 14.43 feet, a total distance of 536.05 feet to a 5/8 inch diameter by 30 inch long iron rebar (set) in the east line of said original 118.80 acre tract conveyed to said Alan Paillet, said rebar also being in the west line of said Northeast Quarter of the Southeast Quarter of said Section 6, Township11North, Range15West;

thence with the east line of said original 118.80 acre tract conveyed to said Alan Paillet and also being with the west line of said Northeast Quarter of the Southeast Quarter of said Section 6, Township11North, Range15West, N.04Deg.00'03"E. 486.73 feet to the place of beginning containing 6.988 acres and being part of Auditor's Parcel Number N020020001200, and being subject to all legal rights-of-way and easements of record.

Bearings are based on the S.87Deg.04'29"E. line as recorded in O. R. Volume 519, Page 2544, A.C.O.R. The above legal description in based on an actual field survey performed by or under the direct supervision of Gerald Hart Wallingford, Registered Land Surveyor Number 6658, on May 26, 2016.




Gerald Hart Wallingford
Registered Land Surveyor Number 6658



LINE	BEARING	DISTANCE
L1	S 02°05'10" W	197.28'
L2	S 03°33'04" W	27.83'
L3	S 03°33'04" W	84.60'
L4	S 03°53'51" W	84.62'
L5	S 06°08'18" W	200.55'
L6	S 05°37'32" W	75.15'
L7	S 01°20'13" W	99.82'
L8	S 06°04'48" W	73.55'
L9	S 08°05'48" W	179.96'
L10	S 07°51'14" W	73.19'
L11	S 06°58'20" W	159.57'
L12	S 10°09'38" W	114.95'
L13	S 15°44'58" W	86.56'
L14	S 20°40'36" W	151.15'
L15	S 24°37'54" W	81.28'
L16	S 25°36'12" W	62.28'
L17	S 22°30'43" W	68.55'
L18	S 20°26'20" W	68.67'
L19	S 15°56'21" W	88.36'
L20	S 05°02'58" W	100.65'
L21	S 82°33'18" W	34.42'
L22	S 55°01'58" W	45.85'
L23	S 44°40'15" W	411.82'
L24	S 49°04'34" W	61.15'
L25	S 56°51'45" W	47.07'
L26	S 68°15'07" W	38.20'
L27	S 85°48'54" W	63.09'

Ohio Franklin Realty, LLC
O.R. 503 Pg. 2282
63.61 Ac.

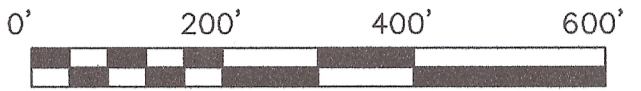

Scale: 1" = 200'


Bearings are based on the S 87°04'29" E line as recorded in O.R. Vol. 519, Pg. 2544, A.C.O.R.

Alan Paillet
O.R. Vol. 285 Pg. 759
Tract Fourteen - Orig. 118.80 Ac.


P.O.B.
3" x 3" x 3" Stone (found) at the northwest corner of the Northeast Quarter of the Southeast Quarter of Section 6, Township 11N., Range 15W., Ohio Company Lands

S.W. 1/4 of the N.E. 1/4 Sect. 6, Twp. 11N., R. 15W.
N.W. 1/4 of the S.E. 1/4 Sect. 6, Twp. 11N., R. 15W.

S.E. 1/4 of the N.E. 1/4 Sect. 6, Twp. 11N., R. 15W.
N.E. 1/4 of the S.E. 1/4 Sect. 6, Twp. 11N., R. 15W.

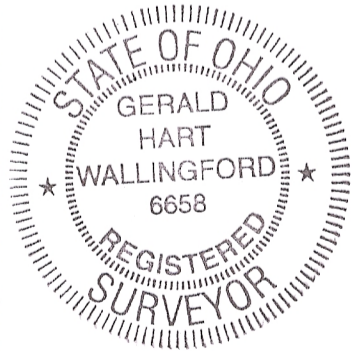

G.H. Wallingford Co.
47 North Main Street
Peebles, Ohio 45660
(937)587-3428

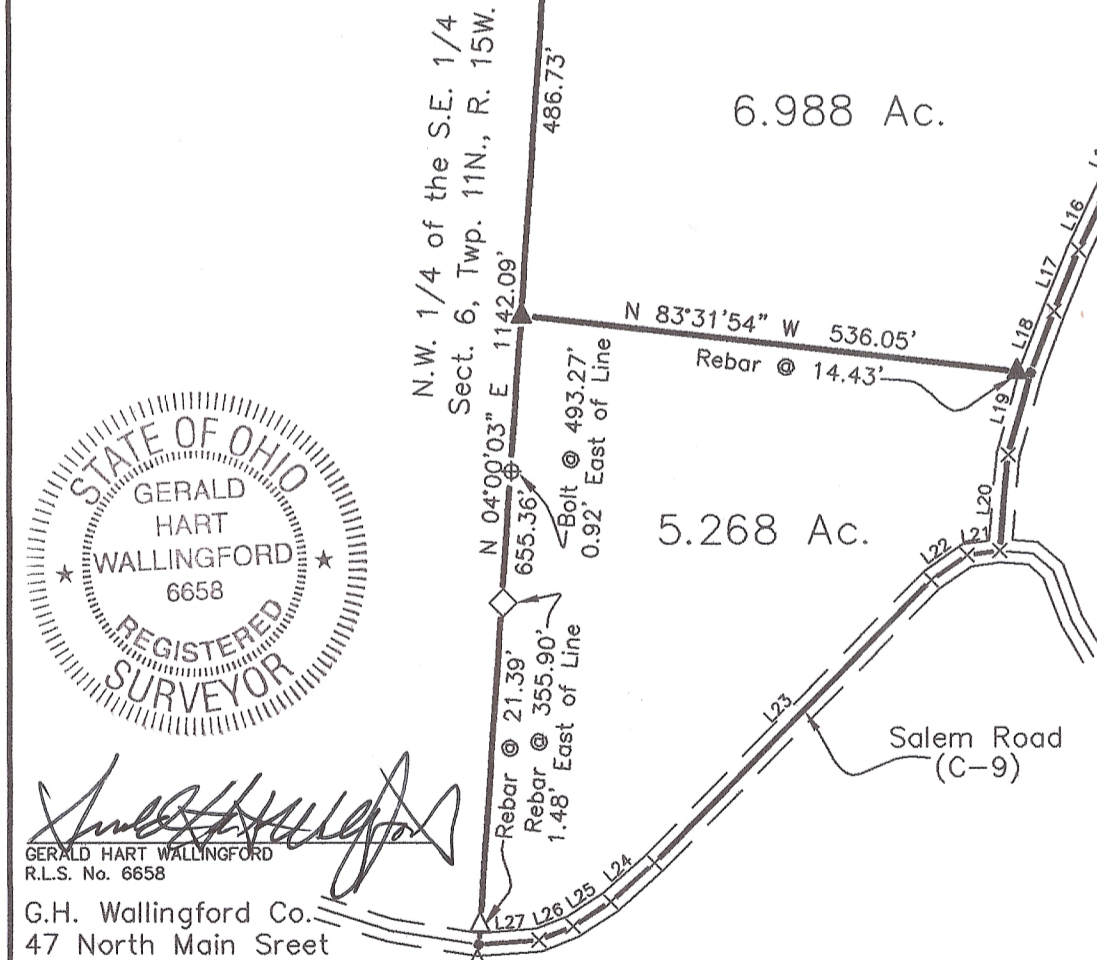

Legend:

- ◇ 1/2" Iron Rebar (Found)
- △ 5/8" Iron Rebar (Found)
- ⊕ Large Bolt (Found)
- 4" x 6" x 8" Stone (Found)
- × Point (No Monument Set)
- 1/4"x2" Long Iron Spike (Set)
- ▲ 5/8"x30" Long Iron Rebar (Set)

ALL MONUMENTS FOUND OR SET ARE IN GOOD CONDITION.

NO EVIDENCE OF OCCUPATION EXISTS ALONG PROPERTY LINES INDICATED BY SOLID LINES.

THE ABOVE LISTED DEED REFERENCES WERE USED AS A BASIS FOR CARRYING OUT THE WORK.

COUNTRYTYME LAND, LLC

Waterloo Township - Athens County - Ohio
Part of the N.E. 1/4 of the S.E. 1/4 & part of the S.E. 1/4 of the N.E. 1/4, Section 6, Township 11N., Range 15W.
Ohio Company Lands
O.R. Vol. 519 Pg. 2544
Orig. 34.753 Ac.
Aud. Parc. No. N020020001200
Scale: 1" = 200'
May 26, 2016

Legal Description Pre-Approval
APPROVED
All transfers are subject to
Athens County Conveyance Standards

Description Checked for
Mathematical Accuracy
Athens County
ENGINEER'S OFFICE

BY: *Brenda Cullinan*
DATE: 7/6/16

JUL 07 2016

Jill Thompson
Athens County Auditor