



C. Thomas Smith

Ohio Professional Surveyor No. 6844

P.O. Box 393



Racine, Ohio 45771

740-949-2524

Being a part of Section 12, Township-11-North, Range-15-West, Waterloo Township, Athens County, State of Ohio.

Note: Bearings are assumed and are for the determination of angles only.

All iron pins set are 5/8"X30" rebar with plastic ID cap stamped "CTS-6844".

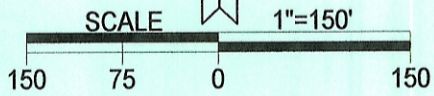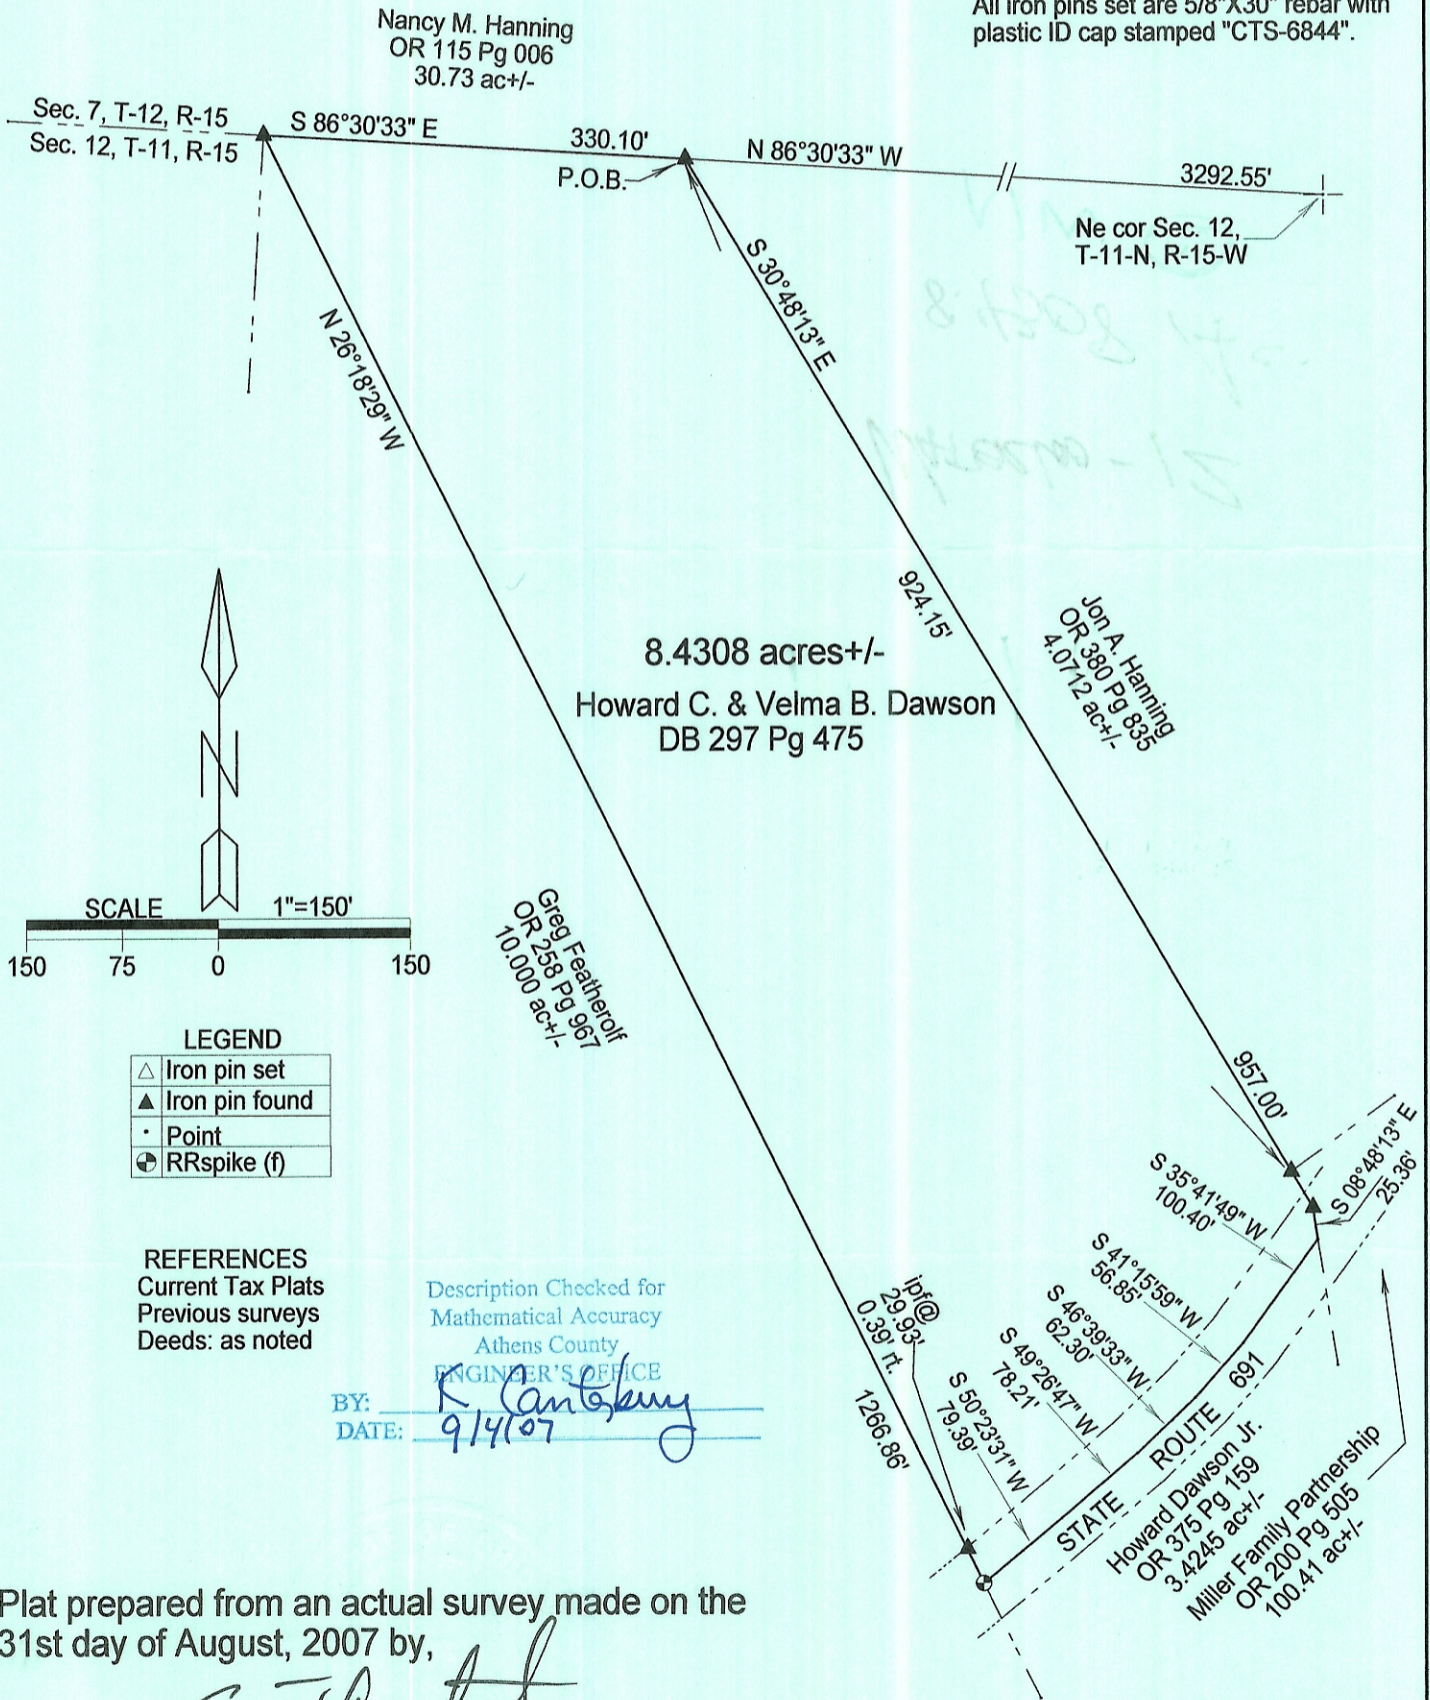

**LEGEND**

△	Iron pin set
▲	Iron pin found
•	Point
⊕	RRspike (f)

**REFERENCES**  
 Current Tax Plats  
 Previous surveys  
 Deeds: as noted

Description Checked for  
 Mathematical Accuracy  
 Athens County  
**ENGINEER'S OFFICE**  
 BY: K. Cantelero  
 DATE: 9/14/07

Plat prepared from an actual survey made on the 31st day of August, 2007 by,