

IDA PAILET
115.80 AC
235-657

Iron pin
Set

Stone
found

ETHEL M. & CHRISTOPHER C.
BROOKS
11.95 Acres
221-393

S. 86° 30' E.

705.35'

3.208 ACRES

632.24'
N. 86° 30' W.

Stake

I.P. Set

15.0'

57.89'

I.P. Set

N 17° 00' E
205.68'

N 35'

200.44'
S 7° 15' W.

Spike
25.0'

I.P. Set

61.47'

I.P. Set

61.449'

N 86° 30' W

N 86° 30' W.

648.8'
S. 86° 30' E.


3.089 ACRES

696.82'

209.30'

I.P. Set

303.03'

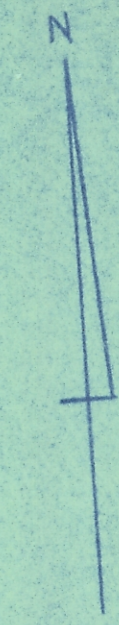

SCALE 1"=100'

S.E. COR. OF
THE N.E. QUARTER
Stone found

N.E. COR. OF
THE S.E. QUARTER

WATERLOO TWP.
ATHENS TWP.

200.00'
S. 3° 30' W

I.P. Set

SURVEY OF A 3.208 ACRE TRACT & A 3.089 ACRE TRACT
IN SEC. 6, T. 11, R. 15, WATERLOO TWP., ATHENS CO., OHIO
for BERGIE E. SIX

SURVEYED NOV. 1970 by HAROLD D. WHALEY
Harold D. Whaley
REG. SURV. NO. 4986