


Sec. 24

Description of 0.0043 Acres

Situated in and being a part of Inlot 145 in the City of Nelsonville, Yord Township, Athens County, Ohio and being more particularly described as follows;


Commencing at the Southwest corner of said Inlot 145; thence EAST along the North line of Columbus Street 39.63 feet to the point of beginning of the tract herein described; thence leaving Columbus Street N 0°18'30" W 92.69 feet; thence EAST 2.00 feet to an iron pin set; thence S 0°18'30" E 92.69 feet to an iron pin set on the north line of Columbus Street; thence along said north line WEST 2.00 feet to the point of beginning containing 185.4 square feet or 0.0043 acres.

Prior deed reference Vol. 347, Page 109.

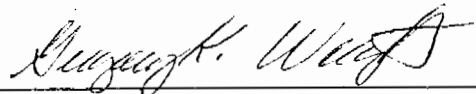

Gregory K. Wright S-6535
Evans, Mechwart, Hambleton, & Tilton, Inc.

180

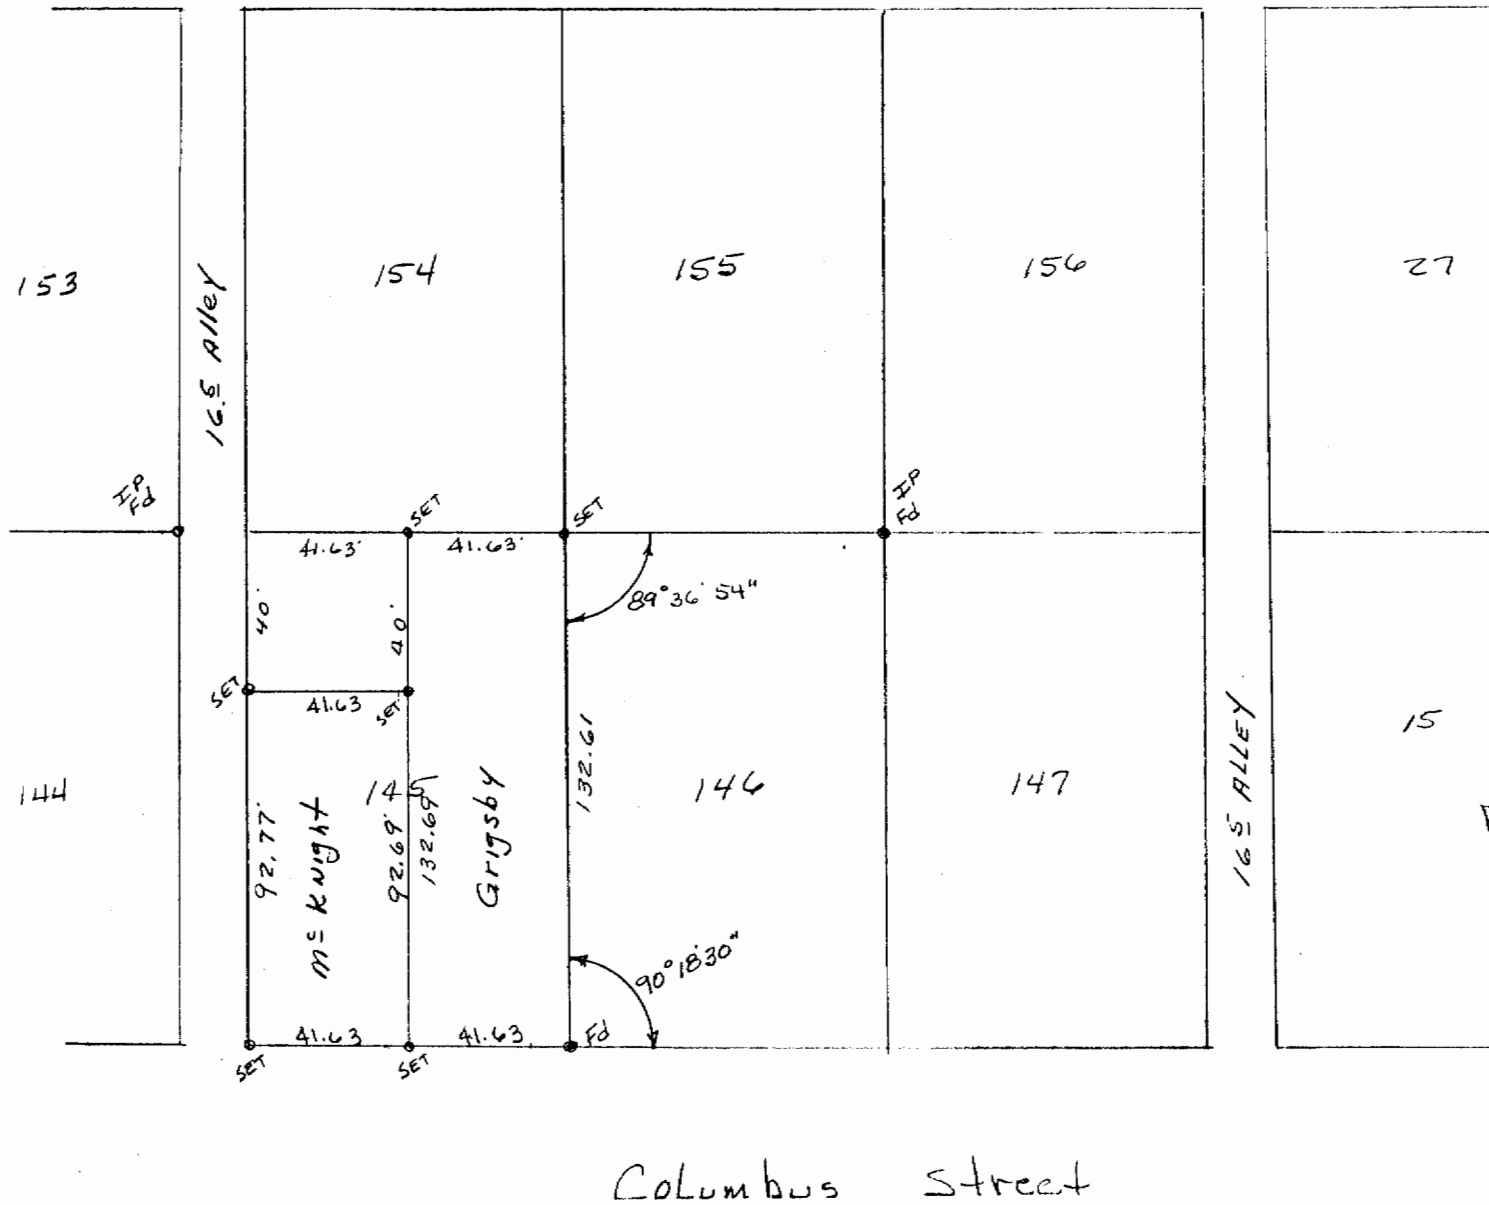

1" = 40'

Survey Parts of Lot 145
 City of Nelsonville
 Athens County, Ohio.
 For: Dave Grigsby & Raymond McKnight
 October 1, 1984
 Prepared by
 Evans, Mechwart, Hambleton, & Tilton, Inc.
 8 North Court Street Athens, Ohio

Gregory K. Wright
 Registered Surveyor # 6535

AO-1524
 AO-1525

YRK # 24