


Sec. 11 York Twp.
322-383



SHEET NO. OF
JOB NO.

SUBJECT

DATE
DATE

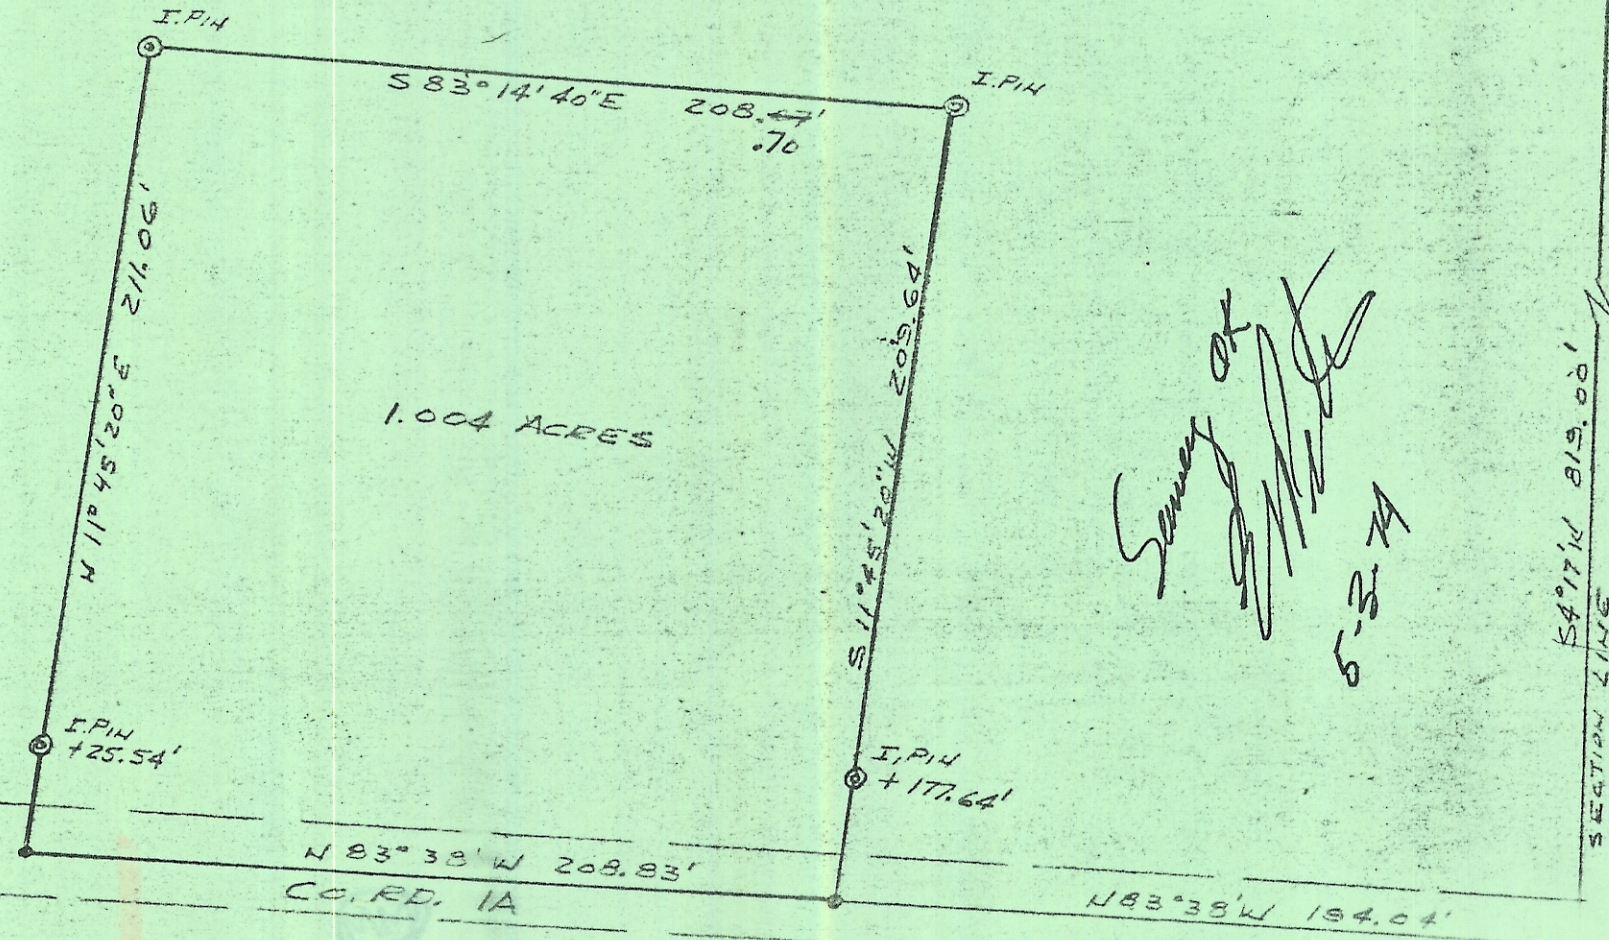

Survey of
[Signature]
5-2-74

PLAT OF SURVEY
1.004 ACRES
N.E. 1/4 SEC. 11, T12, R15, YORK TOWNSHIP
ATHENS CO., OHIO

1700 York Twp. 11/12/74