

LAVELLE AND YANITY

ATTORNEYS AT LAW
THE SECURITY BUILDING
POST OFFICE BOX 661

ATHENS, OHIO 45701

May 23, 1974

TELEPHONE 592-6684
AREA CODE 614

WILLIAM A. LAVELLE
JOSEPH B. YANITY, JR.
L. ALAN GOLDSBERRY
CHARLES DAVID FREY
RONALD E. DEVEAU
RONALD J. WEISENBERGER
THOMAS S. HODSON

Honorable Gerald Hann
County Engineer
East State Street
Athens, Ohio 45701


Re: Howard Keyes, Rt. #3, Athens, Ohio 45701

Dear Gerry:

I am enclosing herewith a copy of a plat and real estate description for a parcel of real estate in Ames Township, Athens County, Ohio, for which I will be preparing a deed. I would appreciate it if you would examine the plat and description and advise me as to your approval.

Thank you.


Very truly yours,

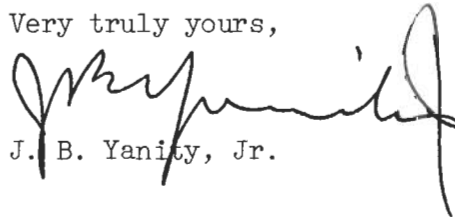

J. B. Yanity, Jr.

/mec
Enc.

See 27 Ans

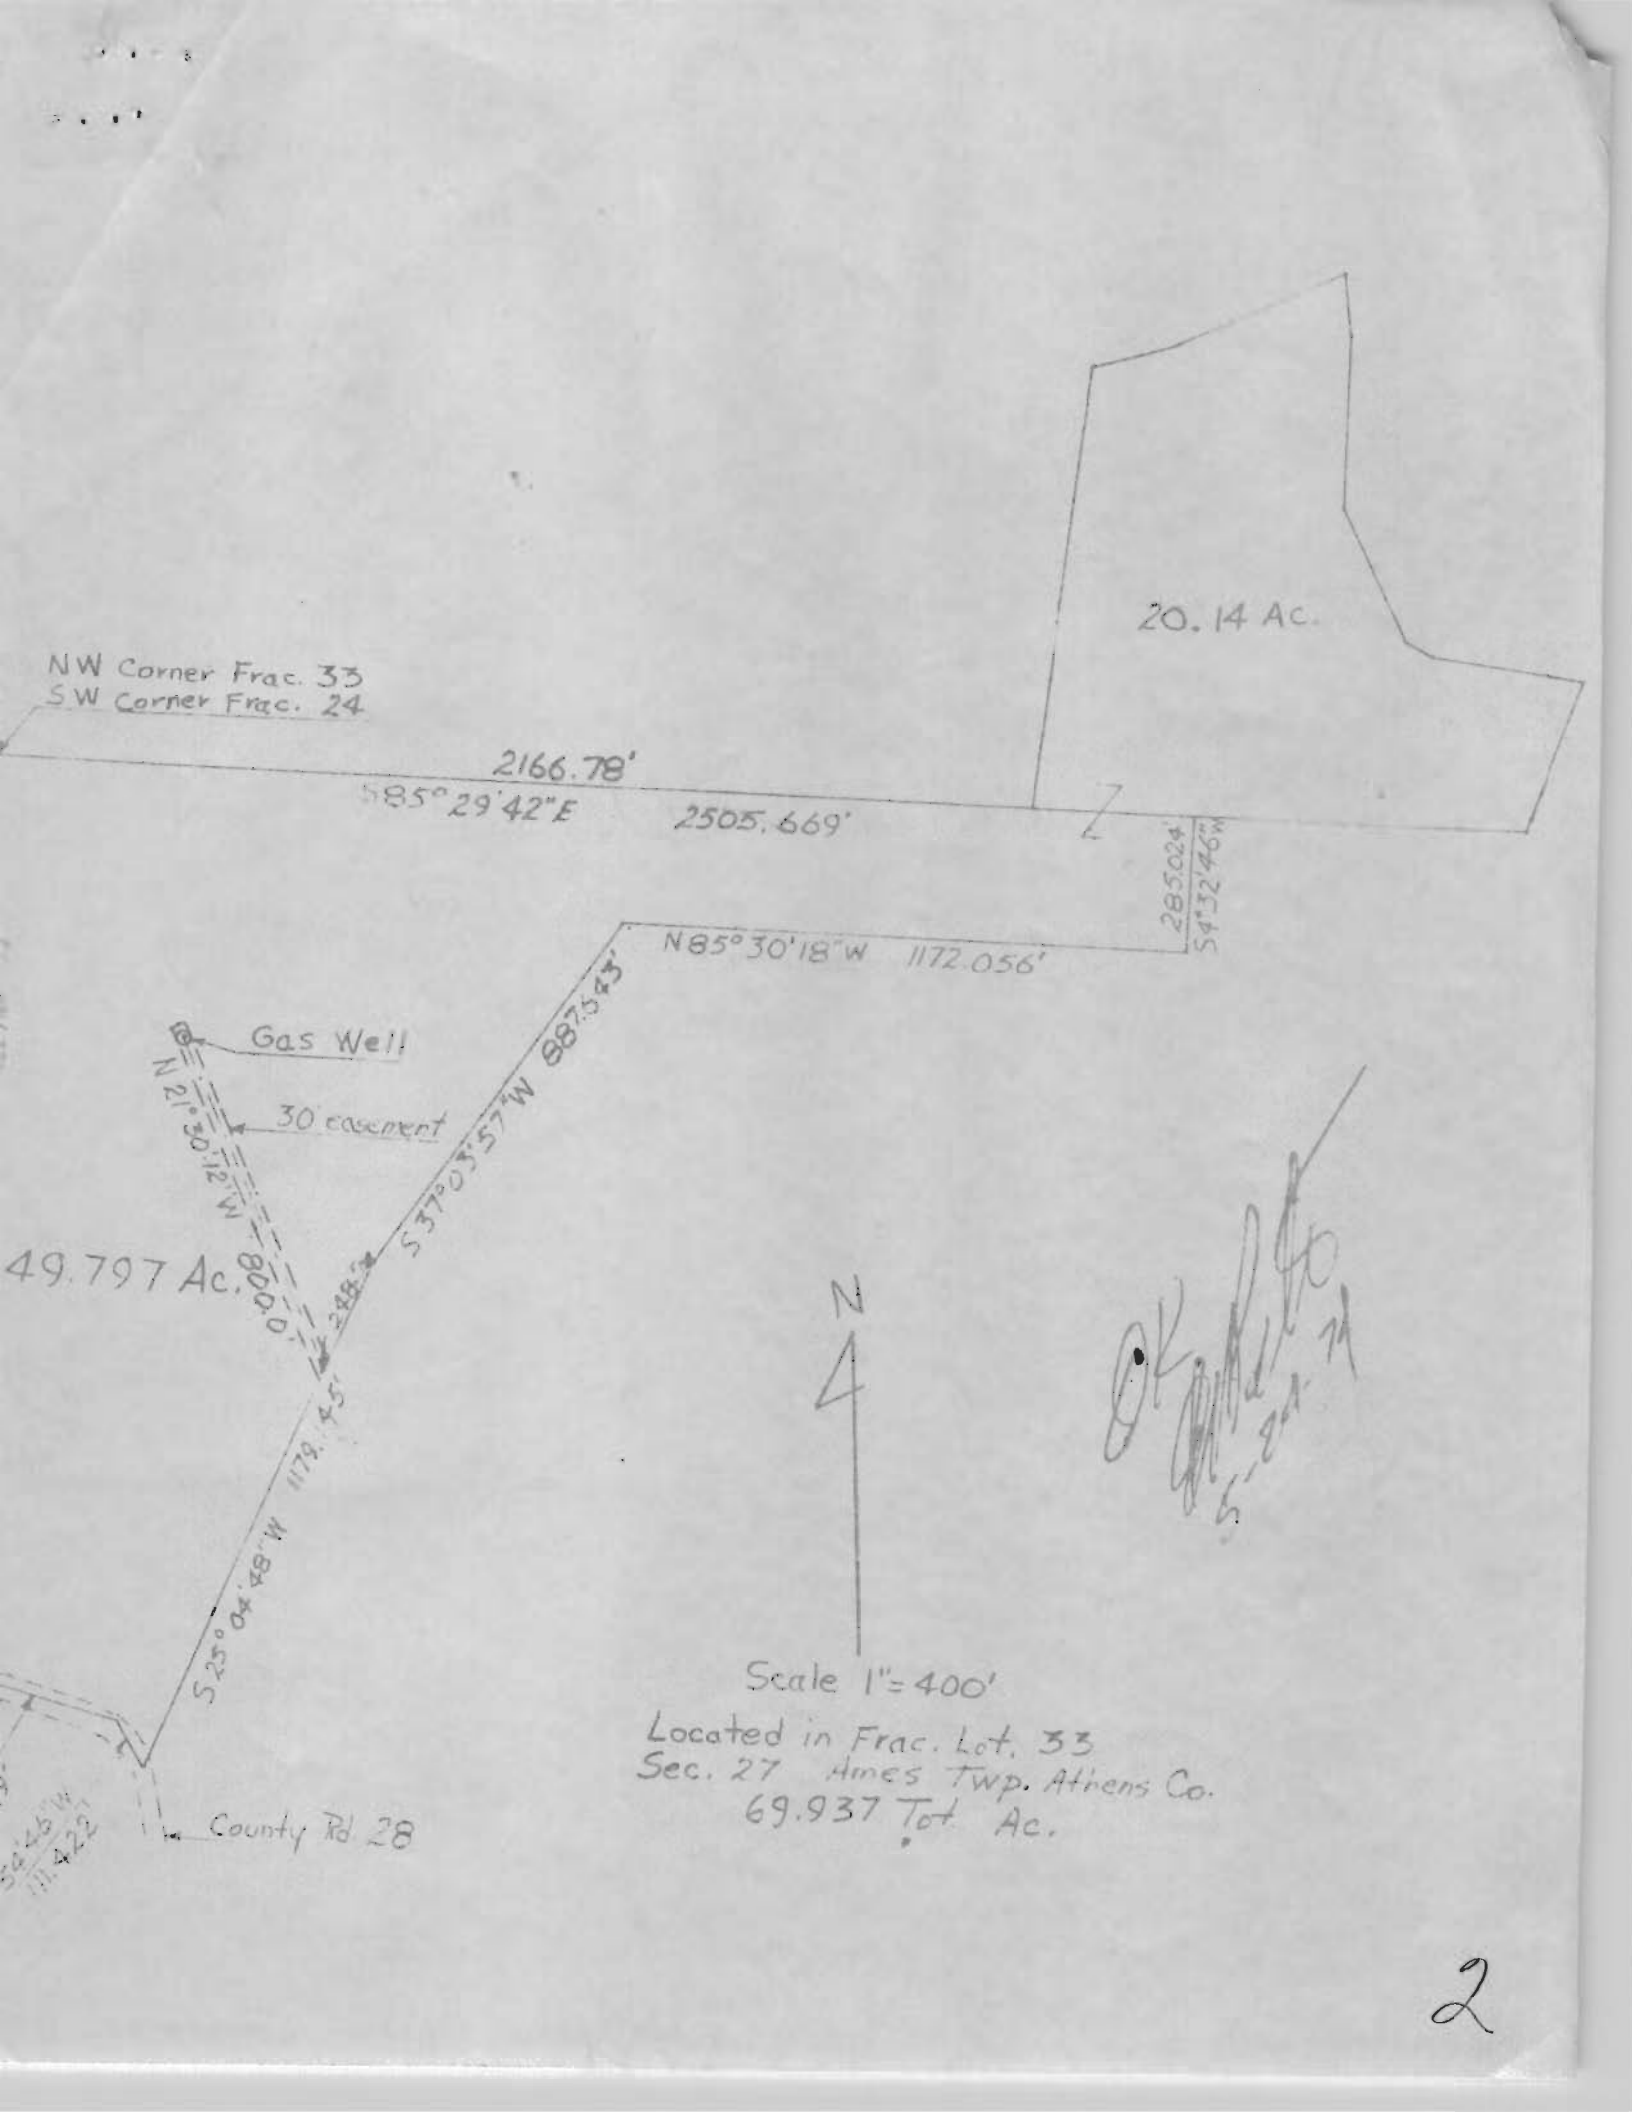

NW Corner Frac. 33
 SW Corner Frac. 24

20.14 Ac.

2166.78'
 S85°29'42"E 2505.669'

285.024
 S4°32'46"W


N85°30'18"W 1172.056'

Gas Well

30' easement

49.797 Ac.

N 21°30'12"W 600.0'
 S 37°03'57"W 987.543'
 S 25°04'48"W 1179.45'

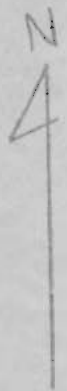

Handwritten signature and date: 5-20-74

Scale 1" = 400'

Located in Frac. Lot. 33
 Sec. 27 Ames Twp. Athens Co.
 69.937 Tot. Ac.

County Rd 28

S 21°45'W
 111.422'