
EXHIBIT "A"

OHIO UNIVERSITY THE RIDGES CONDOMINIUM

SITUATED IN AND BEING PART OF LEASE LOT 59 AND LEASE LOT 61, IN SECTION 15, TOWNSHIP 9 NORTH, RANGE 14 WEST, IN THE CITY OF ATHENS, ATHENS TOWNSHIP, ATHENS COUNTY, AND STATE OF OHIO

Envelope 588 A

202600004079
FILED FOR RECORD IN
ATHENS COUNTY, OHIO
JESSICA HAWKINS, RECORDER
09/10/2026 02:10:12 PM
OR BOOK: 639 PAGE: 262

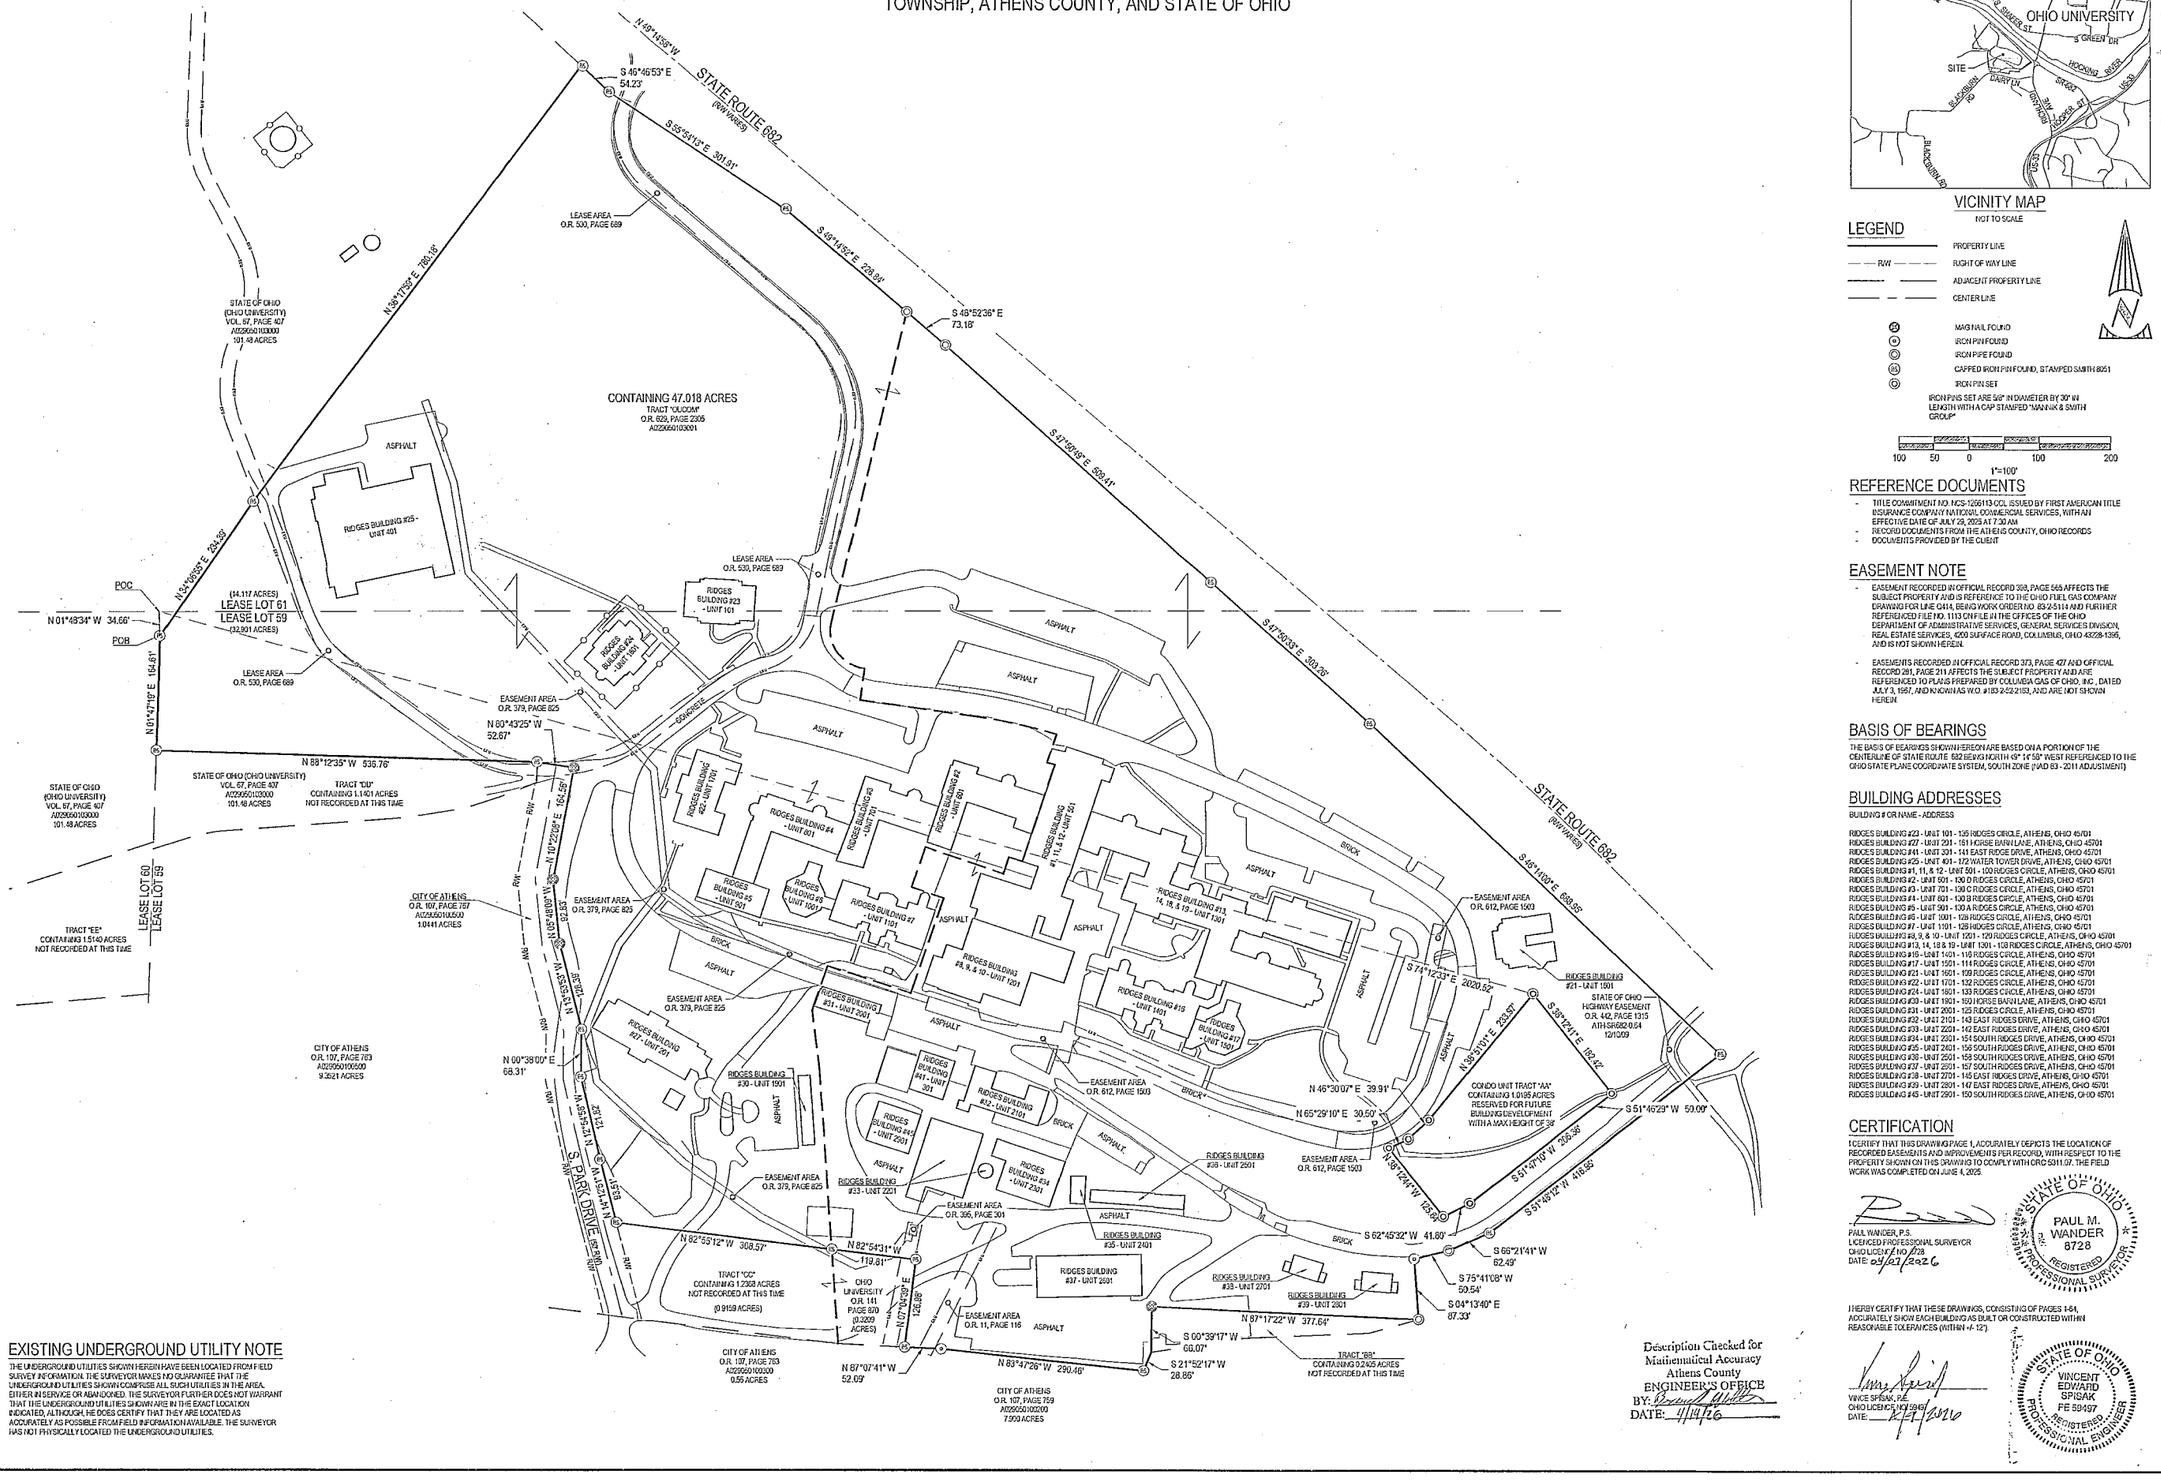

VICINITY MAP
NOT TO SCALE

LEGEND

- PROPERTY LINE
- RW — RIGHT OF WAY LINE
- ADJACENT PROPERTY LINE
- CENTER LINE
- MAG NAIL FOUND
- IRON PIN FOUND
- IRON PIPE FOUND
- CAPPED IRON PIN FOUND, STAMPED SMITH 8051
- IRON PIN SET

IRON PINS SET ARE 5/8" IN DIAMETER BY 30" IN LENGTH WITH A CAP STAMPED "MANNIK & SMITH GROUP"

100 50 0 100 200
1"=100'

REFERENCE DOCUMENTS

- TITLE COMMITMENT NO. NCS-1256113-COL ISSUED BY FIRST AMERICAN TITLE INSURANCE COMPANY NATIONAL COMMERCIAL SERVICES, WITH AN EFFECTIVE DATE OF JULY 29, 2025 AT 7:30 AM
- RECORD DOCUMENTS FROM THE ATHENS COUNTY, OHIO RECORDS
- DOCUMENTS PROVIDED BY THE CLIENT

EASEMENT NOTE

- EASEMENT RECORDED IN OFFICIAL RECORD 368, PAGE 565 AFFECTS THE SUBJECT PROPERTY AND IS REFERENCE TO THE OHIO FUEL GAS COMPANY DRAWING FOR LINE 0414, BEING WORK ORDER NO. 83-25114 AND FURTHER REFERENCED FILE NO. 1113 ON FILE IN THE OFFICES OF THE OHIO DEPARTMENT OF ADMINISTRATIVE SERVICES, GENERAL SERVICES DIVISION, REAL ESTATE SERVICES, 4200 SURFACE ROAD, COLUMBUS, OHIO 43228-1395, AND IS NOT SHOWN HEREIN.
- EASEMENTS RECORDED IN OFFICIAL RECORD 373, PAGE 427 AND OFFICIAL RECORD 281, PAGE 211 AFFECTS THE SUBJECT PROPERTY AND ARE REFERENCED TO PLATS PREPARED BY COLUMBIA GAS OF OHIO, INC., DATED JULY 3, 1957, AND KNOWN AS W.O. #183-2-52-2183, AND ARE NOT SHOWN HEREIN.

BASIS OF BEARINGS

THE BASIS OF BEARINGS SHOWN HEREON ARE BASED ON A PORTION OF THE CENTERLINE OF STATE ROUTE 682 BEING NORTH 48° 14' 59" WEST REFERENCED TO THE OHIO STATE PLANE COORDINATE SYSTEM, SOUTH ZONE (NAD 83 - 2011 ADJUSTMENT)

BUILDING ADDRESSES

BUILDING # OR NAME - ADDRESS

RIDGES BUILDING #23 - UNIT 101 - 125 RIDGES CIRCLE, ATHENS, OHIO 45701
RIDGES BUILDING #27 - UNIT 201 - 151 HORSE BARN LANE, ATHENS, OHIO 45701
RIDGES BUILDING #41 - UNIT 301 - 141 EAST RIDGE DRIVE, ATHENS, OHIO 45701
RIDGES BUILDING #25 - UNIT 401 - 172 WATER TOWER DRIVE, ATHENS, OHIO 45701
RIDGES BUILDING #1, 11, & 12 - UNIT 501 - 100 RIDGES CIRCLE, ATHENS, OHIO 45701
RIDGES BUILDING #2 - UNIT 501 - 130 D RIDGES CIRCLE, ATHENS, OHIO 45701
RIDGES BUILDING #3 - UNIT 701 - 130 C RIDGES CIRCLE, ATHENS, OHIO 45701
RIDGES BUILDING #4 - UNIT 601 - 130 B RIDGES CIRCLE, ATHENS, OHIO 45701
RIDGES BUILDING #5 - UNIT 901 - 130 A RIDGES CIRCLE, ATHENS, OHIO 45701
RIDGES BUILDING #6 - UNIT 1001 - 126 RIDGES CIRCLE, ATHENS, OHIO 45701
RIDGES BUILDING #7 - UNIT 1101 - 128 RIDGES CIRCLE, ATHENS, OHIO 45701
RIDGES BUILDING #8, 9, & 10 - UNIT 1201 - 129 RIDGES CIRCLE, ATHENS, OHIO 45701
RIDGES BUILDING #13, 14, 15 & 19 - UNIT 1301 - 108 RIDGES CIRCLE, ATHENS, OHIO 45701
RIDGES BUILDING #15 - UNIT 1401 - 116 RIDGES CIRCLE, ATHENS, OHIO 45701
RIDGES BUILDING #17 - UNIT 1501 - 114 RIDGES CIRCLE, ATHENS, OHIO 45701
RIDGES BUILDING #21 - UNIT 1501 - 109 RIDGES CIRCLE, ATHENS, OHIO 45701
RIDGES BUILDING #22 - UNIT 1701 - 132 RIDGES CIRCLE, ATHENS, OHIO 45701
RIDGES BUILDING #24 - UNIT 1801 - 133 RIDGES CIRCLE, ATHENS, OHIO 45701
RIDGES BUILDING #29 - UNIT 1901 - 150 HORSE BARN LANE, ATHENS, OHIO 45701
RIDGES BUILDING #31 - UNIT 2001 - 125 RIDGES CIRCLE, ATHENS, OHIO 45701
RIDGES BUILDING #32 - UNIT 2101 - 143 EAST RIDGES ERIVE, ATHENS, OHIO 45701
RIDGES BUILDING #33 - UNIT 2201 - 142 EAST RIDGES DRIVE, ATHENS, OHIO 45701
RIDGES BUILDING #34 - UNIT 2301 - 154 SOUTH RIDGES DRIVE, ATHENS, OHIO 45701
RIDGES BUILDING #35 - UNIT 2401 - 156 SOUTH RIDGES DRIVE, ATHENS, OHIO 45701
RIDGES BUILDING #36 - UNIT 2501 - 158 SOUTH RIDGES DRIVE, ATHENS, OHIO 45701
RIDGES BUILDING #37 - UNIT 2501 - 157 SOUTH RIDGES DRIVE, ATHENS, OHIO 45701
RIDGES BUILDING #38 - UNIT 2701 - 145 EAST RIDGES DRIVE, ATHENS, OHIO 45701
RIDGES BUILDING #39 - UNIT 2801 - 147 EAST RIDGES DRIVE, ATHENS, OHIO 45701
RIDGES BUILDING #45 - UNIT 2901 - 150 SOUTH RIDGES DRIVE, ATHENS, OHIO 45701

CERTIFICATION

I CERTIFY THAT THIS DRAWING/PAGE 1 ACCURATELY DEPICTS THE LOCATION OF RECORDED EASEMENTS AND IMPROVEMENTS PER RECORD, WITH RESPECT TO THE PROPERTY SHOWN ON THIS DRAWING TO COMPLY WITH ORC 5301.07. THE FIELD WORK WAS COMPLETED ON JUNE 4, 2025.

PAUL WANDER, P.S.
LICENCED PROFESSIONAL SURVEYOR
OHIO LICENSE NO. 8728
DATE: 09/01/2026

STATE OF OHIO
PAUL M. WANDER
8728
REGISTERED
PROFESSIONAL SURVEYOR

I HEREBY CERTIFY THAT THESE DRAWINGS, CONSISTING OF PAGES 1-64, ACCURATELY SHOW EACH BUILDING AS BUILT OR CONSTRUCTED WITHIN REASONABLE TOLERANCES (WITHIN +/- 0.2').

VINCE SPISAK, P.E.
OHIO LICENCE NO. 99497
DATE: 09/01/2026

STATE OF OHIO
VINCENT EDWARD SPISAK
PE 99497
REGISTERED
PROFESSIONAL ENGINEER

Description Checked for Mathematical Accuracy
Athens County
ENGINEER'S OFFICE
BY:
DATE: 11/19/26

EXISTING UNDERGROUND UTILITY NOTE

THE UNDERGROUND UTILITIES SHOWN HEREIN HAVE BEEN LOCATED FROM FIELD SURVEY INFORMATION. THE SURVEYOR MAKES NO GUARANTEE THAT THE UNDERGROUND UTILITIES SHOWN COMPRISE ALL SUCH UTILITIES IN THE AREA, EITHER IN SERVICE OR ABANDONED. THE SURVEYOR FURTHER DOES NOT WARRANT THAT THE UNDERGROUND UTILITIES SHOWN ARE IN THE EXACT LOCATION INDICATED, ALTHOUGH, HE DOES CERTIFY THAT THEY ARE LOCATED AS ACCURATELY AS POSSIBLE FROM FIELD INFORMATION AVAILABLE. THE SURVEYOR HAS NOT PHYSICALLY LOCATED THE UNDERGROUND UTILITIES.

NO.	DATE	BY	DESCRIPTION
1	07/16/2026	PW	REVISED PER COUNTY ENG COMMENTS
2	08/25/2026	LKS	REVISED PER COUNTY ENG COMMENTS
3	09/08/2026	LKS	REVISED PER COUNTY ENG COMMENTS

257 NORTH MAIN STREET
ATHENS, OHIO 45701
TEL: 517.263.4515
FAX: 517.263.4535

PROJECT DATE: 09/12/2025
PROJECT NO.: 2506082
DRAWN BY: CDH
CHECKED BY: PW

TECHNICAL SKILL. GUARANTEED QUALITY.

Mannik Smith Group
www.MannikSmithGroup.com

PREPARED FOR:
OHIO UNIVERSITY


OHIO UNIVERSITY
RIDGES SURVEY
118 RIDGES CIRCLE,
ATHENS, OHIO 45701

PLAT

1 / 64


\\msgfilesrv\MSGData\Projects\2025\6000-7999\2506082\CAD\SURV\2506082_BNDY.dwg - Last printed 4/6/2026 2:20 PM

202600004080
FILED FOR RECORD IN
ATHENS COUNTY, OHIO
JESSICA MARKINS, RECORDER
09/10/2026 02:30:13 PM
OR BOOK: 639 PAGE: 263
Envelope 588 B

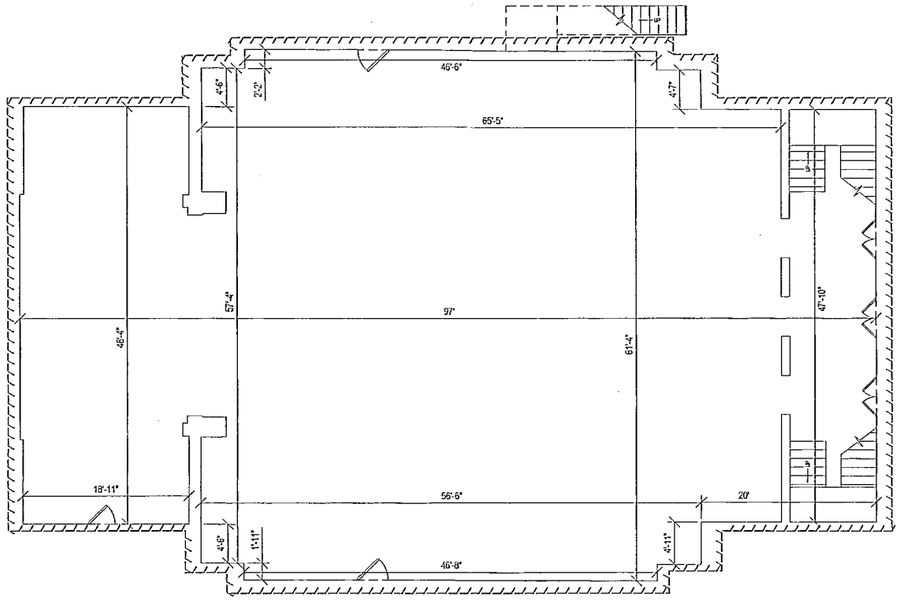


SCALE: $\frac{1}{8}$" = 1' 0"

FIRST FLOOR PLAN - RIDGES BUILDING #23 - UNIT 101

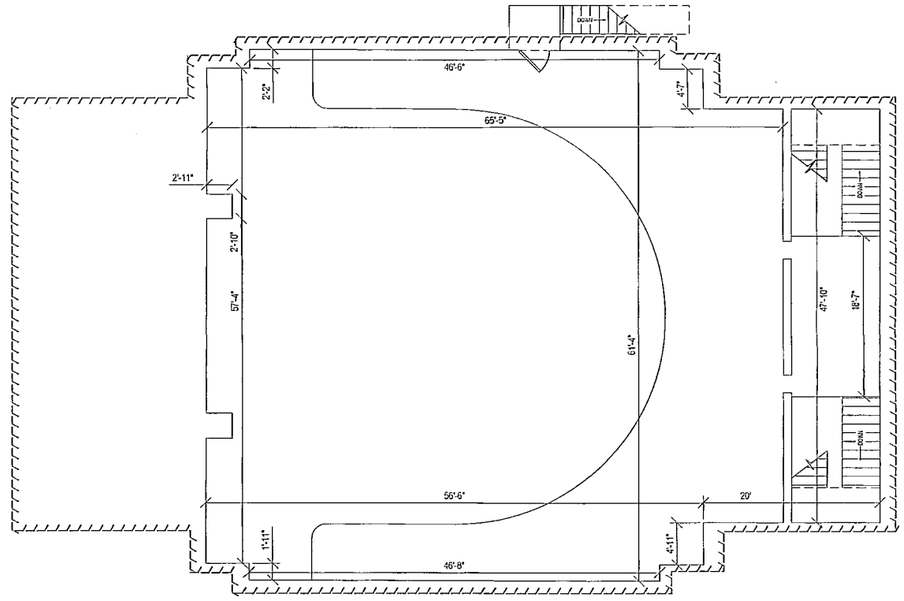


SCALE: $\frac{1}{8}$" = 1' 0"

SECOND FLOOR PLAN - RIDGES BUILDING #23 - UNIT 101

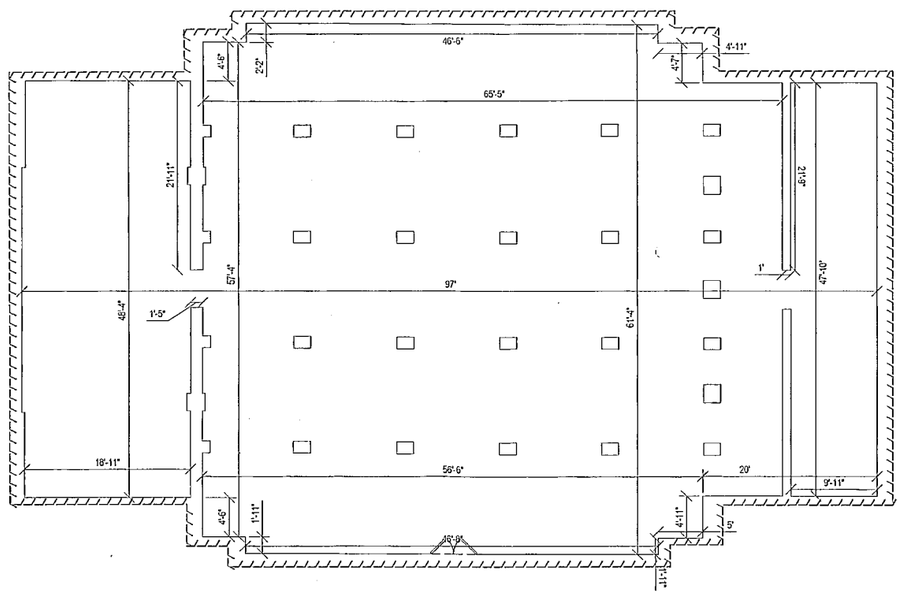

SCALE: $\frac{1}{8}$" = 1' 0"

BASEMENT FLOOR PLAN - RIDGES BUILDING #23 - UNIT 101

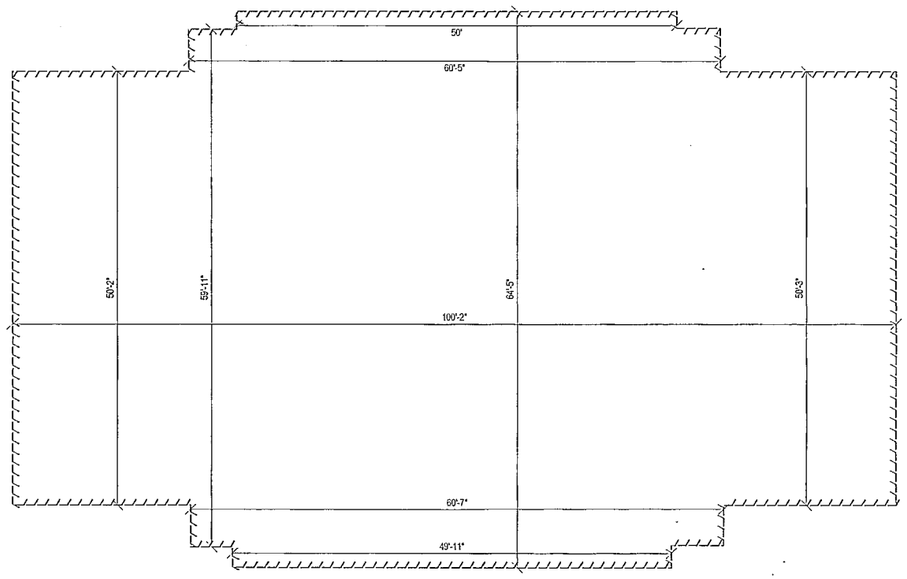

SCALE: $\frac{1}{8}$" = 1' 0"

BUILDING DIMENSIONS - RIDGES BUILDING #23 - UNIT 101

NO.	DATE	BY	DESCRIPTION

237 NORTH MAIN STREET
ATHENS, OHIO 45701
TEL: 740.593.4545
FAX: 517.263.4535

PROJECT DATE: 08/12/2025
PROJECT NO.: 2500682
DRAWN BY: CDH
CHECKED BY: PW


Mannik Smith Group
www.MannikSmithGroup.com

PREPARED FOR:
OHIO UNIVERSITY
ATHENS, OHIO 45701

OHIO UNIVERSITY
RIDGES SURVEY
118 RIDGES CIRCLE,
ATHENS, OHIO 45701


RIDGES BUILDING #23
FLOOR PLAN & BUILDING
DIMENSIONS

2 / 64


\\MSGFILESRV\MSGData\Projects\2025\600-799\2500682\CAD\SURV\2500682_BLDG.dwg - Last printed 4/6/2026 2:20 PM

202600004091
FILED FOR RECORD IN
ATHENS COUNTY, OHIO
JESSICA WARKINS, RECORDER
09/10/2026 02:30:14 PM
OR BOOK: 639 PAGE: 264
LARGE PLAT $6.40 PG: 1


Envelope
589 A

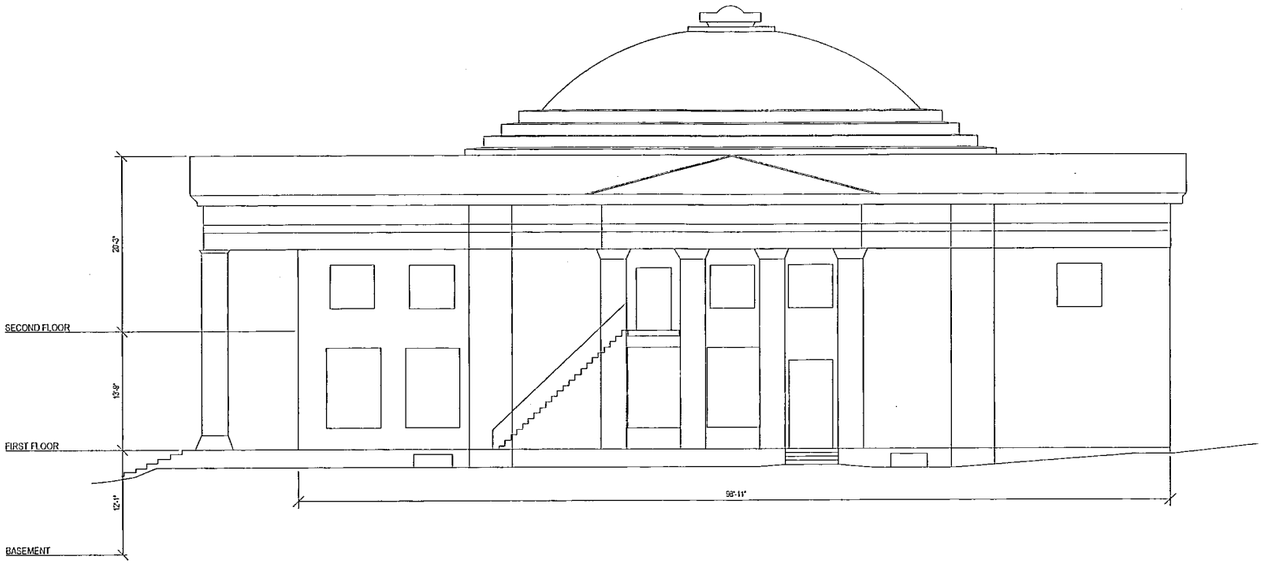


SCALE: $\frac{1}{8}$" = 1' 0" NORTH ELEVATION - RIDGES BUILDING #23 - UNIT 101

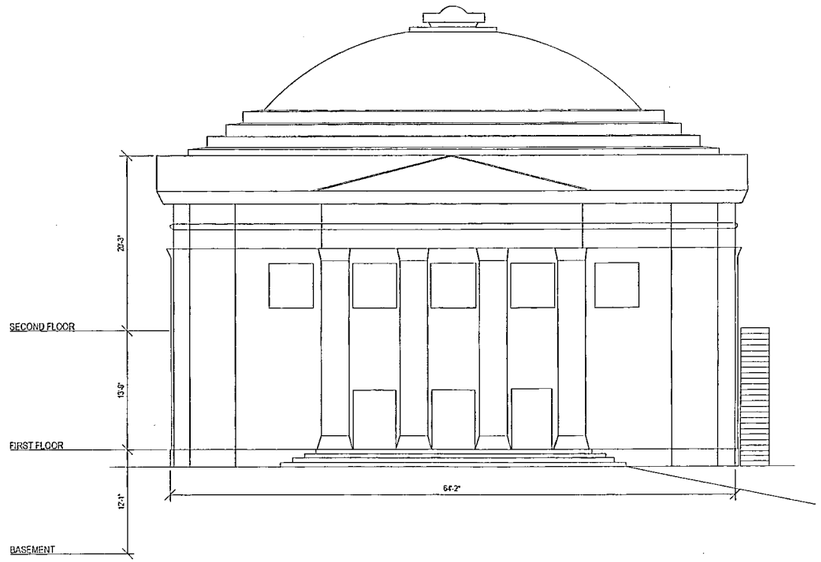

SCALE: $\frac{1}{8}$" = 1' 0" EAST ELEVATION - RIDGES BUILDING #23 - UNIT 101

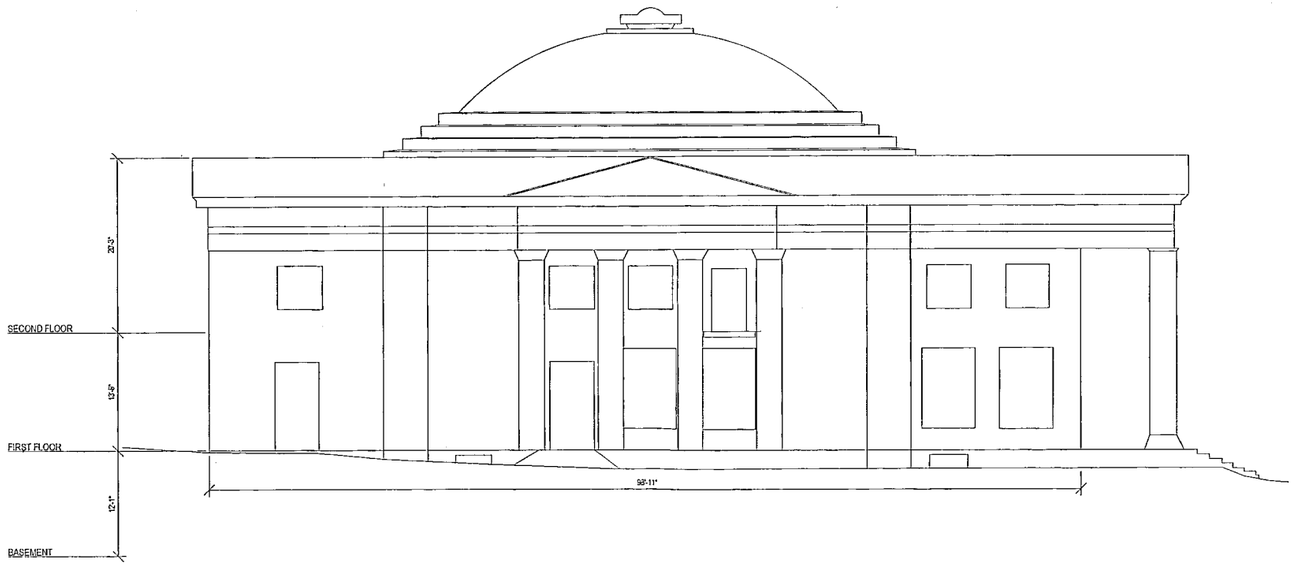

SCALE: $\frac{1}{8}$" = 1' 0" SOUTH ELEVATION - RIDGES BUILDING #23 - UNIT 101

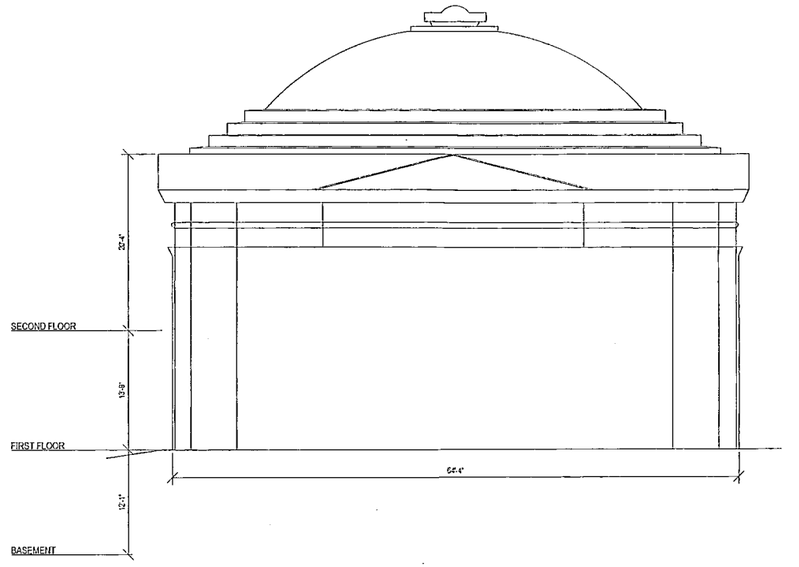

SCALE: $\frac{1}{8}$" = 1' 0" WEST ELEVATION - RIDGES BUILDING #23 - UNIT 101

237 NORTH MAIN STREET
ADRIAN, MI 49221
TEL: 517.263.4155
FAX: 517.263.4535

NO.	DATE	BY	DESCRIPTION

PROJECT DATE: 09/12/2025
PROJECT NO.: 2500682
DRAWN BY: CDH
CHECKED BY: PW

TECHNICAL SKILL + CREATIVE SPIRIT.

Mannik Smith Group

www.MannikSmithGroup.com

PREPARED FOR:
OHIO UNIVERSITY
ATHENS, OHIO 45701


OHIO UNIVERSITY
RIDGES SURVEY
118 RIDGES CIRCLE,
ATHENS, OHIO 45701

RIDGES BUILDING #23
ELEVATIONS

3 / 64


\\MSGFILESRV\MSGData\Projects\2025\600-799\2500682\CAD\SURV\2500682_ELEV.dwg - Last printed 4/6/2026 2:20 PM

202600004082
FILED FOR RECORD IN
ATHENS COUNTY, OHIO
JESSICA HARKINS, RECORDER
09/10/2026 02:30:15 PM
OR BOOK: 639 PAGE: 265
LARGE PLAT 24.00 PG: 1
Envelope
589 B

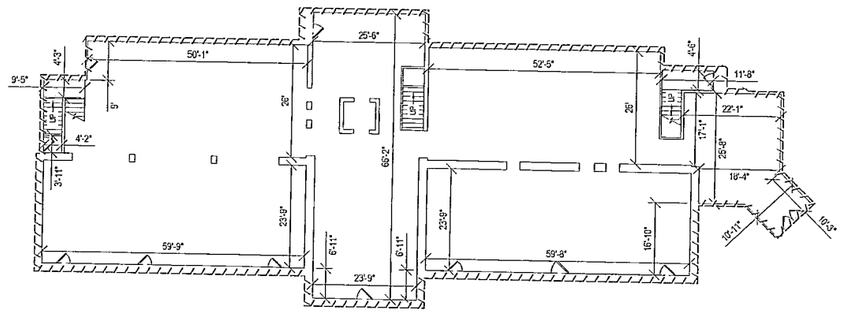


SCALE: $\frac{1}{16}$" = 1' 0"

FIRST FLOOR PLAN - RIDGES BUILDING #27 - UNIT 201

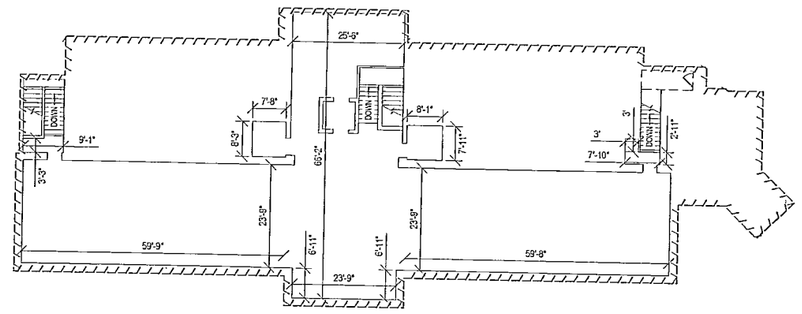

SCALE: $\frac{1}{16}$" = 1' 0"

SECOND FLOOR PLAN - RIDGES BUILDING #27 - UNIT 201

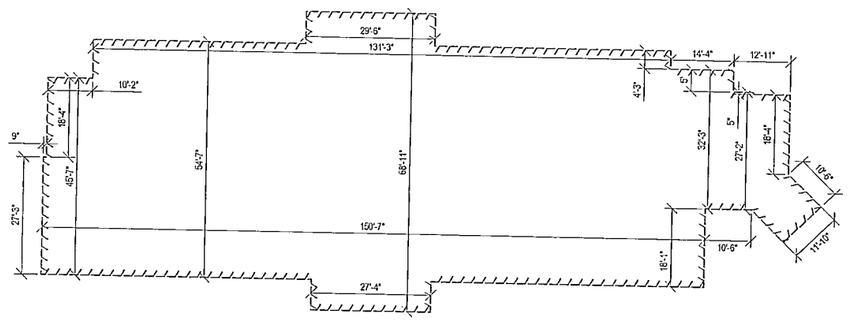

SCALE: $\frac{1}{16}$" = 1' 0"

BUILDING DIMENSIONS - RIDGES BUILDING #27 - UNIT 201

\\MSGFILESRV\MSGData\Projects\2025\600-799\2500682\CAD\SURV\2500682_BLDG.dwg - Last printed 4/6/2026 2:20 PM

NO.	DATE	BY	DESCRIPTION

237 NORTH MAIN STREET
ADRIAN, MI 49221
TEL: 517.263.4516
FAX: 517.263.4536

PROJECT DATE: 09/15/2025
PROJECT NO.: 2500682
DRAWN BY: CDH
CHECKED BY: PW

TECHNICAL SKILL. CREATIVE SERVICE.

Mannik Smith Group

www.MannikSmithGroup.com


PREPARED FOR:
OHIO UNIVERSITY
ATHENS, OHIO 45701

OHIO UNIVERSITY
RIDGES SURVEY
118 RIDGES CIRCLE,
ATHENS, OHIO 45701

RIDGES BUILDING #27
FLOOR PLAN &
BUILDING DIMENSIONS


202600004083
FILED FOR RECORD IN
ATHENS COUNTY, OHIO
JESSICA HARKINS, RECORDER
09/10/2026 02:20:16 PM
OR BOOK: 639 PAGE: 266

Exempt
510 A

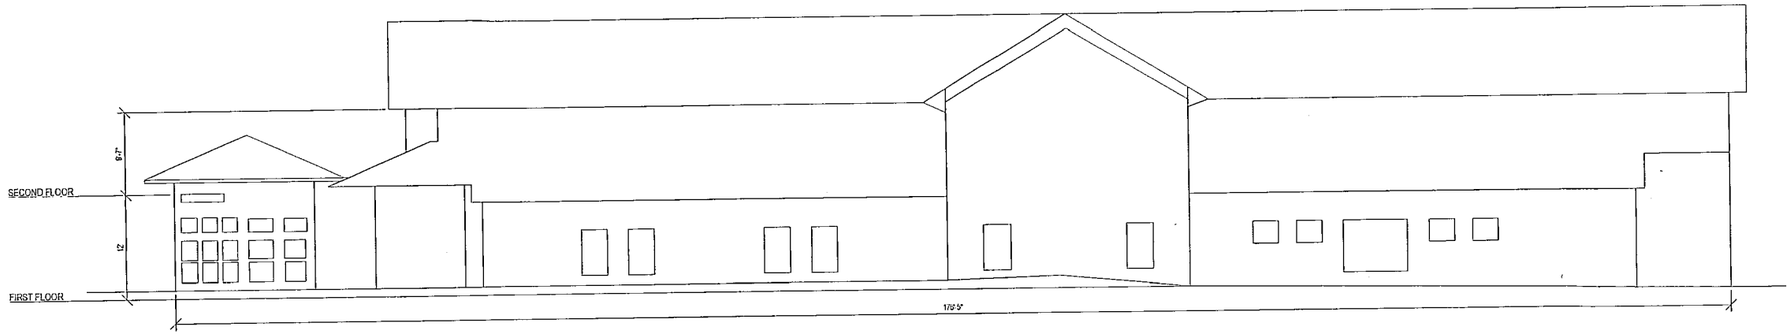


NORTH ELEVATION - RIDGES BUILDING #27 - UNIT 201

SCALE: 1/8" = 1' 0"

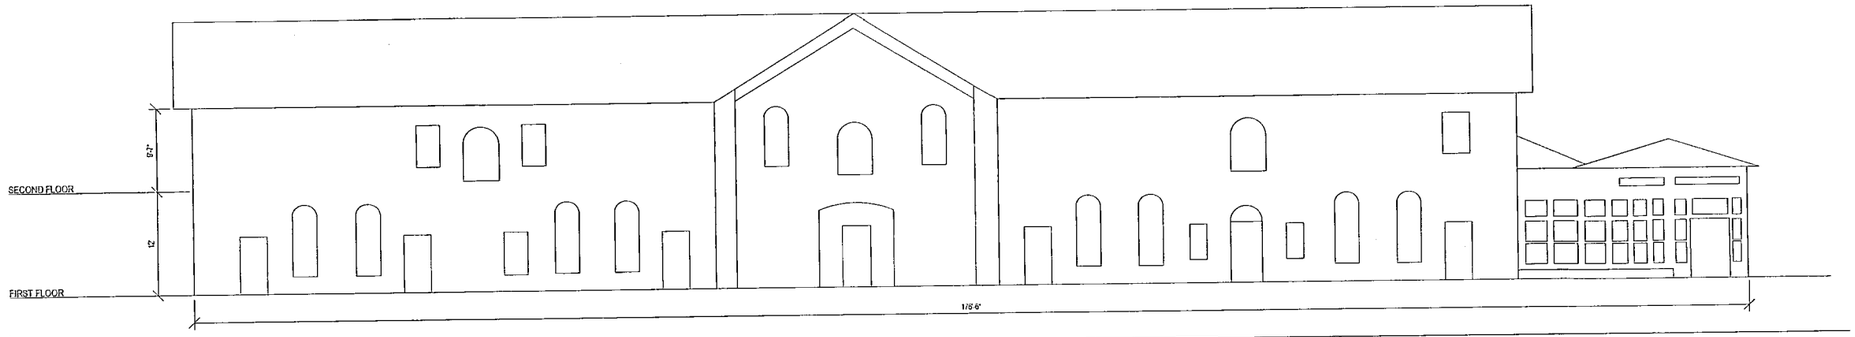


SOUTH ELEVATION - RIDGES BUILDING #27 - UNIT 201

SCALE: 1/8" = 1' 0"

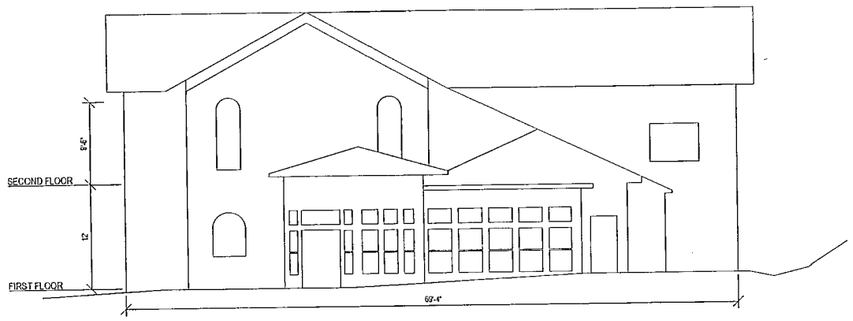

EAST ELEVATION - RIDGES BUILDING #27 - UNIT 201

SCALE: 1/8" = 1' 0"

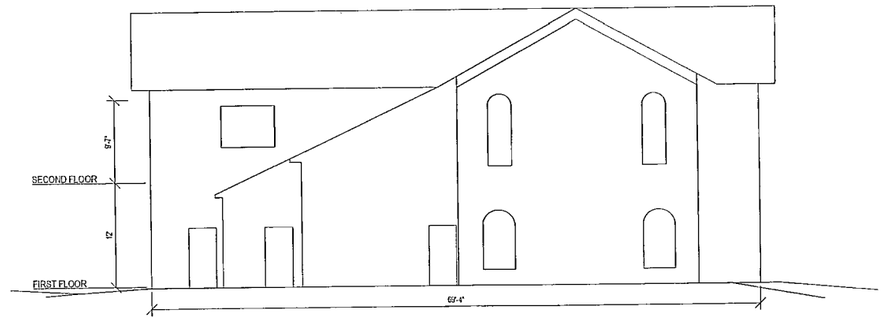

WEST ELEVATION - RIDGES BUILDING #27 - UNIT 201

SCALE: 1/8" = 1' 0"

237 NORTH MAIN STREET
ADRIAN, MI 49221
TEL: 517.265.4515
FAX: 517.265.4535

NO.	DATE	BY	DESCRIPTION

PROJECT DATE: 08/12/2025
PROJECT NO.: 2500682
DRAWN BY: CDH
CHECKED BY: PW

TECHNICAL SKILL. CREATIVE SPIRIT.

Mannik Smith Group

www.MannikSmithGroup.com

PREPARED FOR:
OHIO UNIVERSITY
ATHENS, OHIO 45701

OHIO UNIVERSITY
RIDGES SURVEY
118 RIDGES CIRCLE,
ATHENS, OHIO 45701


RIDGES BUILDING #27
ELEVATIONS

5 / 64

\\MSGFILESRV\MSGData\Projects\2025\600-799\2500682\CAD\SURV\2500682_ELEV.dwg - Last printed 4/6/2026 2:20 PM


202600004084
FILED FOR RECORD IN
ATHENS COUNTY, OHIO
JESSICA MARKINS, RECORDER
09/10/2026 02:39:17 PM
OR BOOK: 639 PAGE: 267

Envelope
590B

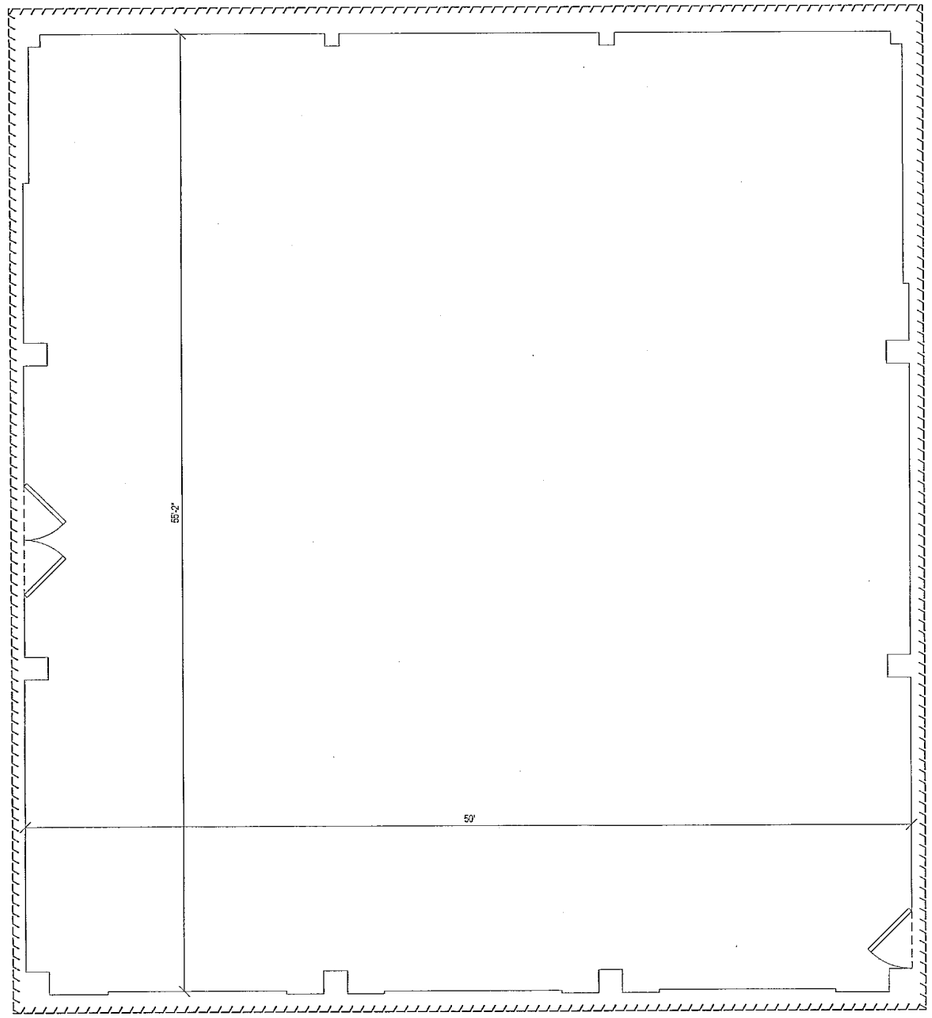

SCALE: $\frac{1}{4}$" = 1' 0"

FIRST FLOOR PLAN - RIDGES BUILDING #41 - UNIT 301

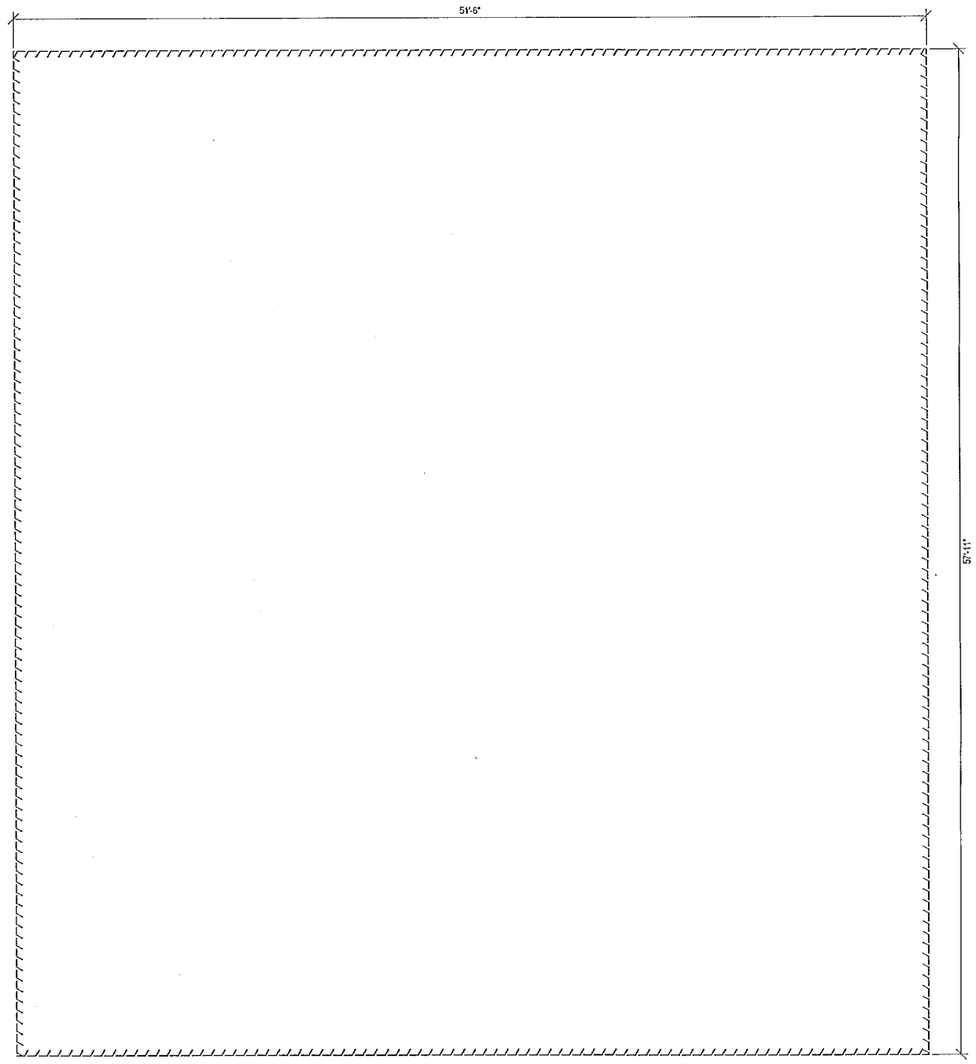

SCALE: $\frac{1}{4}$" = 1' 0"

BUILDING DIMENSIONS - RIDGES BUILDING #41 - UNIT 301

\\MSGFILESRV\MSGData\Projects\2025\600-799\25006821\CADISURV\25006821_BLDG.dwg - Last printed 4/6/2026 2:20 PM

NO.	DATE	BY	DESCRIPTION

237 NORTH MAIN STREET
ADRIAN, MI 49221
TEL: 517.263.4515
FAX: 517.263.4595

PROJECT DATE: 09/12/2025
PROJECT NO.: 25006821
DRAWN BY: CDH
CHECKED BY: PW

Mannik Smith Group
TECHNICAL SKILL. CREATIVE SPIRIT.
www.MannikSmithGroup.com

PREPARED FOR:
OHIO UNIVERSITY
ATHENS, OHIO 45701


OHIO UNIVERSITY
RIDGES SURVEY
118 RIDGES CIRCLE,
ATHENS, OHIO 45701

RIDGES BUILDING #41
FLOOR PLAN &
BUILDING DIMENSIONS

6 / 64


202600004085
FILED FOR RECORD IN
ATHENS COUNTY, OHIO
JESSICA MARKINS, RECORDER
09/10/2026 02:30:18 PM
OR BOOK: 639 PAGE: 268

Envelope 591A

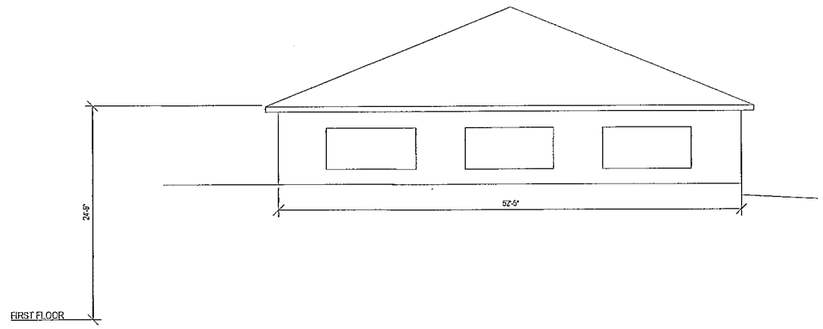


SCALE: $\frac{1}{8}$" = 1' 0"

NORTH ELEVATION - RIDGES BUILDING #41 - UNIT 301

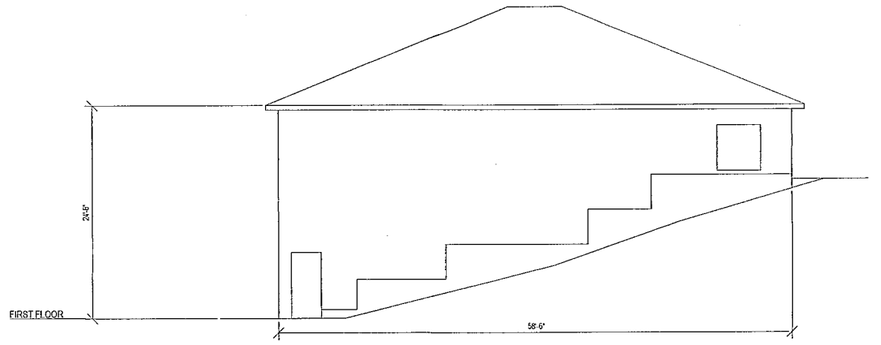


SCALE: $\frac{1}{8}$" = 1' 0"

EAST ELEVATION - RIDGES BUILDING #41 - UNIT 301

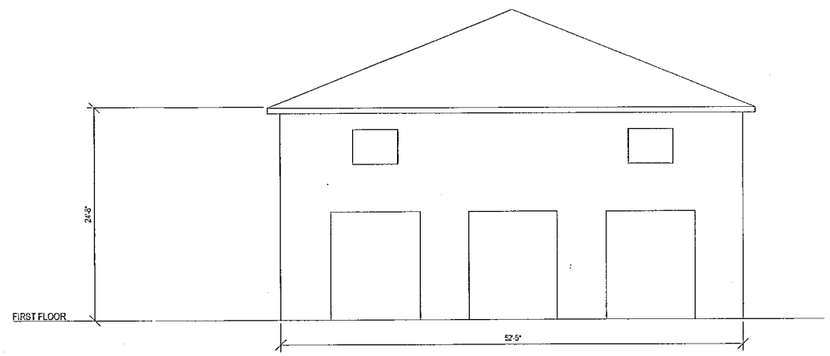

SCALE: $\frac{1}{8}$" = 1' 0"

SOUTH ELEVATION - RIDGES BUILDING #41 - UNIT 301

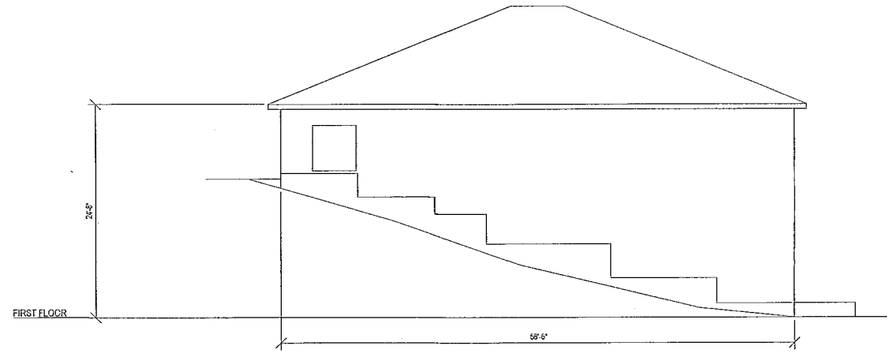

SCALE: $\frac{1}{8}$" = 1' 0"

WEST ELEVATION - RIDGES BUILDING #41 - UNIT 301

237 NORTH MAIN STREET
ADRIAN, MI 49221
TEL: 517.263.4535
FAX: 517.263.4535

NO.	DATE	BY	DESCRIPTION

PROJECT DATE: 09/12/2025
PROJECT NO.: 2500682
DRAWN BY: CDH
CHECKED BY: PW

Mannik Smith Group
TECHNICAL SKILL. CREATIVE SPIRIT.
www.MannikSmithGroup.com


PREPARED FOR:
OHIO UNIVERSITY
ATHENS, OHIO 45701

OHIO UNIVERSITY
RIDGES SURVEY
118 RIDGES CIRCLE,
ATHENS, OHIO 45701


RIDGES BUILDING #41
ELEVATIONS

7 / 64


\\MSGFILESRV\MSGData\Projects\2025\600-799\2500682\CAD\SURV2500682_ELEV.dwg - Last printed 4/6/2026 2:20 PM

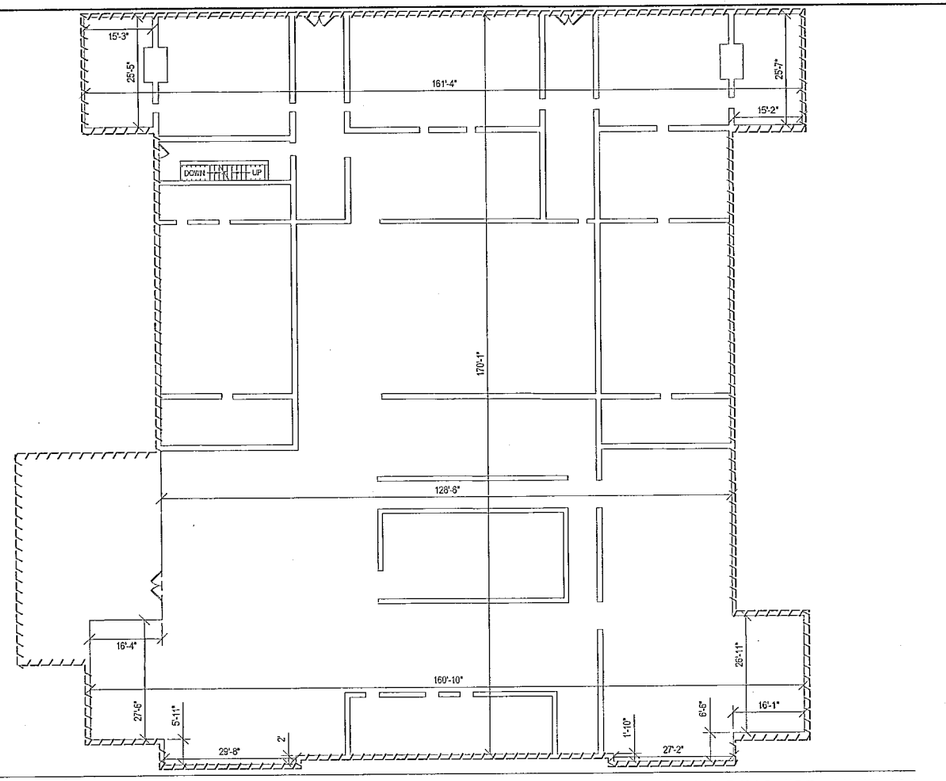


SCALE: $\frac{1}{16}$" = 1' 0" FIRST FLOOR PLAN - RIDGES BUILDING #25 - UNIT 401

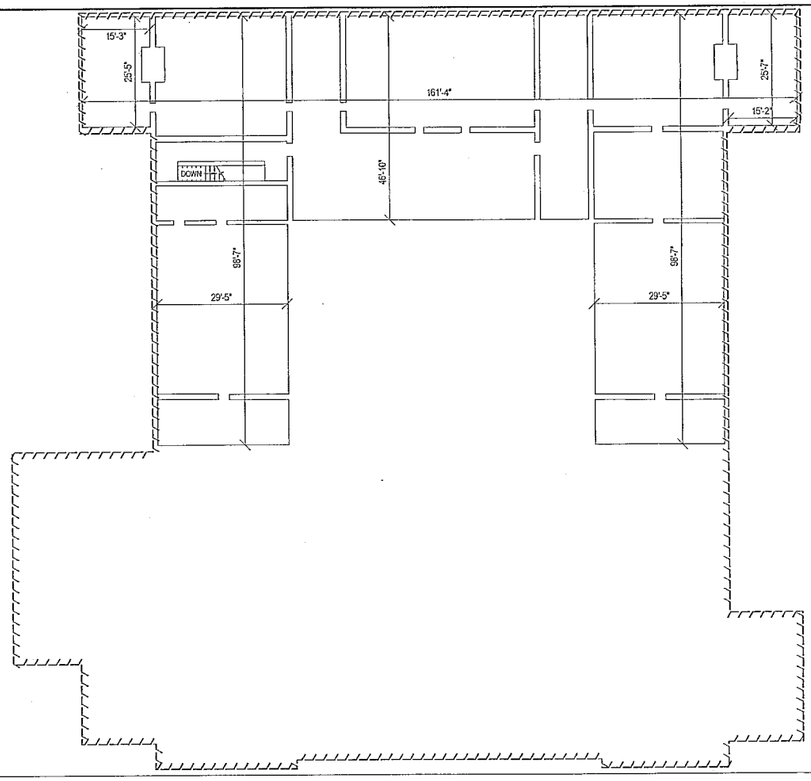

SCALE: $\frac{1}{16}$" = 1' 0" SECOND FLOOR PLAN - RIDGES BUILDING #25 - UNIT 401

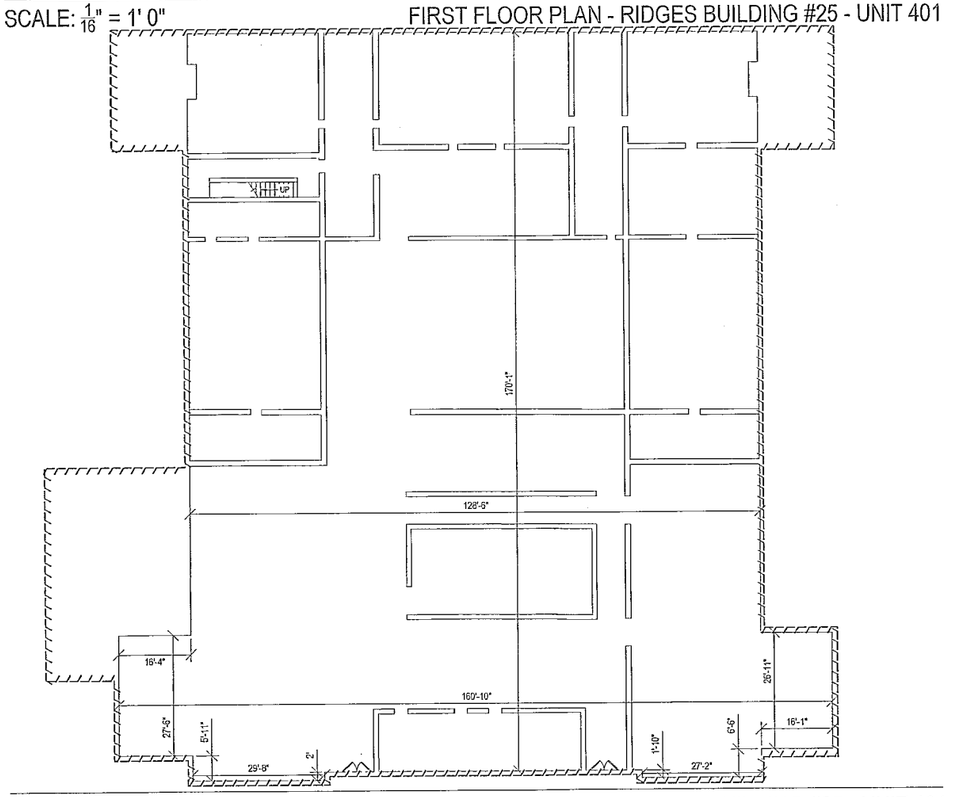

SCALE: $\frac{1}{16}$" = 1' 0" BASEMENT FLOOR PLAN - RIDGES BUILDING #25 - UNIT 401

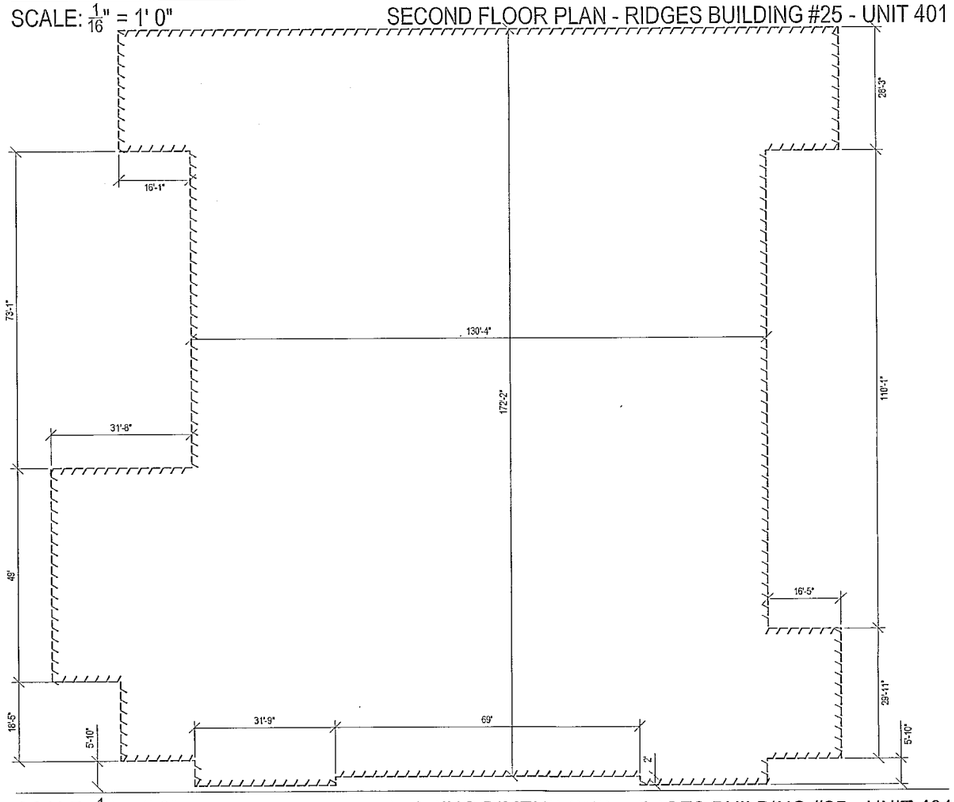

SCALE: $\frac{1}{16}$" = 1' 0" BUILDING DIMENSIONS - RIDGES BUILDING #25 - UNIT 401

2026000004066
EASEMENT RECORDED IN
FEE & EXEMPT
ATHENS COUNTY, OH10
RECORDED BY: JESSICA MARKINS, RECORDER
09/10/2026 02:20:19 PM
OR BOOK: 639 PAGE: 269
SEQUENCE #: 2026000004066 PG: 1

NO.	DATE	BY	DESCRIPTION

237 NORTH MAIN STREET
ADRIAN, MI 49221
TEL: 517.265.4515
FAX: 517.263.4535

PROJECT DATE: 09/12/2025
PROJECT NO.: 2500682
DRAWN BY: CDH
CHECKED BY: PW

Mannik Smith Group
www.MannikSmithGroup.com

PREPARED FOR:
OHIO UNIVERSITY
ATHENS, OHIO 45701

OHIO UNIVERSITY
RIDGES SURVEY
118 RIDGES CIRCLE,
ATHENS, OHIO 45701


RIDGES BUILDING #25
FLOOR PLAN &
BUILDING DIMENSIONS

8 / 64

\\MSGFILESRVM\MSGData\Projects\2025\600-799\2500682\CAD\SURV\2500682_BLDG.dwg - Last printed 4/6/2026 2:20 PM


202600004097
FILED FOR RECORD IN
ATHENS COUNTY, OHIO
JESSICA MARKINS, RECORDER
09/10/2026 02:30:20 PM
GR BOOK: 639 PAGE: 270
LARGE FLAT 86.40 PG: 1

Owner
592 A

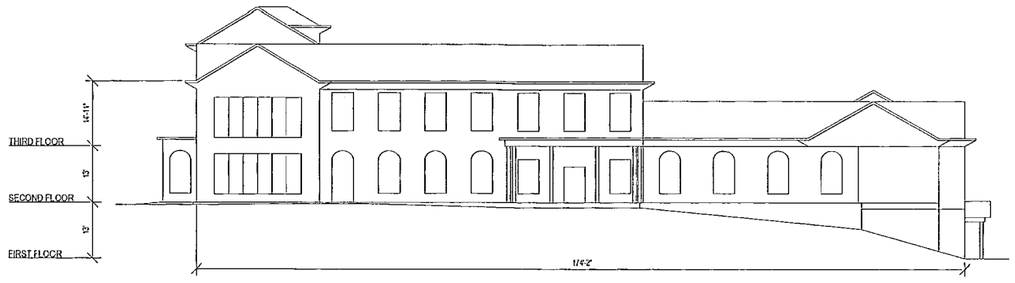


SCALE: $\frac{1}{16}$ = 1' 0"

NORTH ELEVATION - RIDGES BUILDING #25 - UNIT 401

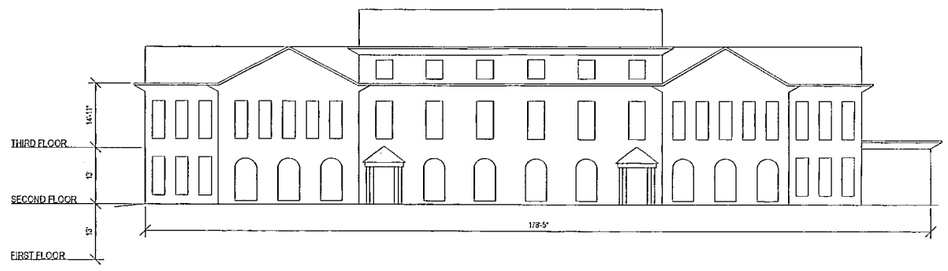


SCALE: $\frac{1}{16}$ = 1' 0"

EAST ELEVATION - RIDGES BUILDING #25 - UNIT 401

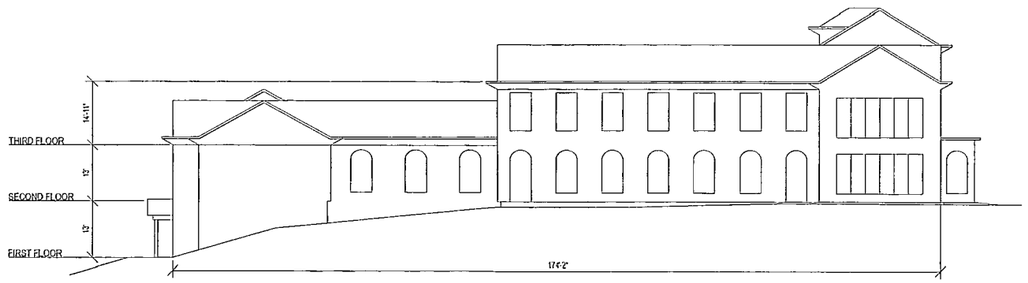

SCALE: $\frac{1}{16}$ = 1' 0"

SOUTH ELEVATION - RIDGES BUILDING #25 - UNIT 401

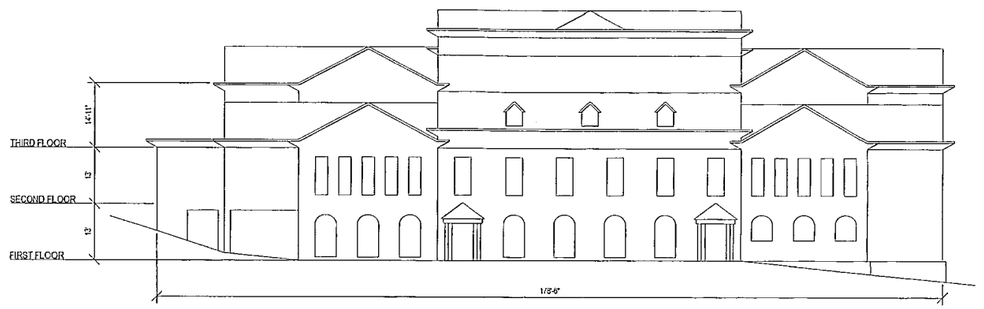

SCALE: $\frac{1}{16}$ = 1' 0"

WEST ELEVATION - RIDGES BUILDING #25 - UNIT 401

NO.	DATE	BY	DESCRIPTION

237 NORTH MAIN STREET

PROJECT DATE: 08/12/2025
PROJECT NO.: 2500682
DRAWN BY: CDH
CHECKED BY: PW

Mannik Smith Group
TECHNICAL SKILL. CREATIVE DESIGN.
www.MannikSmithGroup.com

PREPARED FOR:
OHIO UNIVERSITY
ATHENS, OHIO 45701

OHIO UNIVERSITY
RIDGES SURVEY
118 RIDGES CIRCLE,
ATHENS, OHIO 45701


RIDGES BUILDING #25
ELEVATIONS

9 / 64


\\MSGFILESRV\MSGData\Projects\2025\600-799\2500682\CAD\SURV\2500682_ELEV.dwg - Last printed 4/6/2026 2:21 PM

202600004088
FILED FOR RECORD IN
ATHENS COUNTY, OHIO
JESSICA MARKINS, RECORDER
03/10/2026 02:30:21 PM
OR BOOK: 639 PAGE: 271
LARGE PLAT ... 26.40 ... PG: 1...


Envelope 392 B

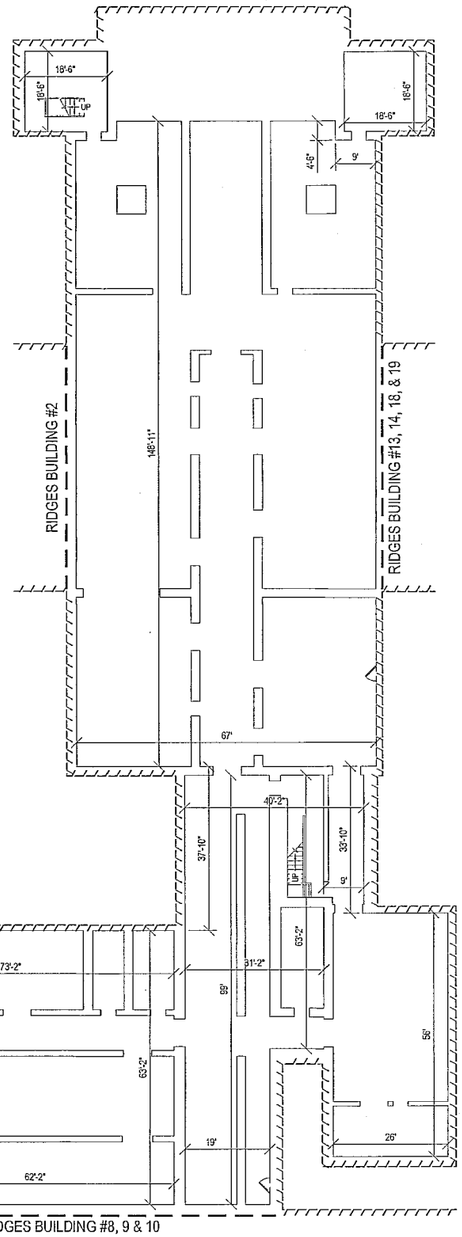

SCALE: $\frac{1}{16}$" = 1' 0" FIRST FLOOR PLAN - RIDGES BUILDING #1, 11 & 12 - UNIT 501

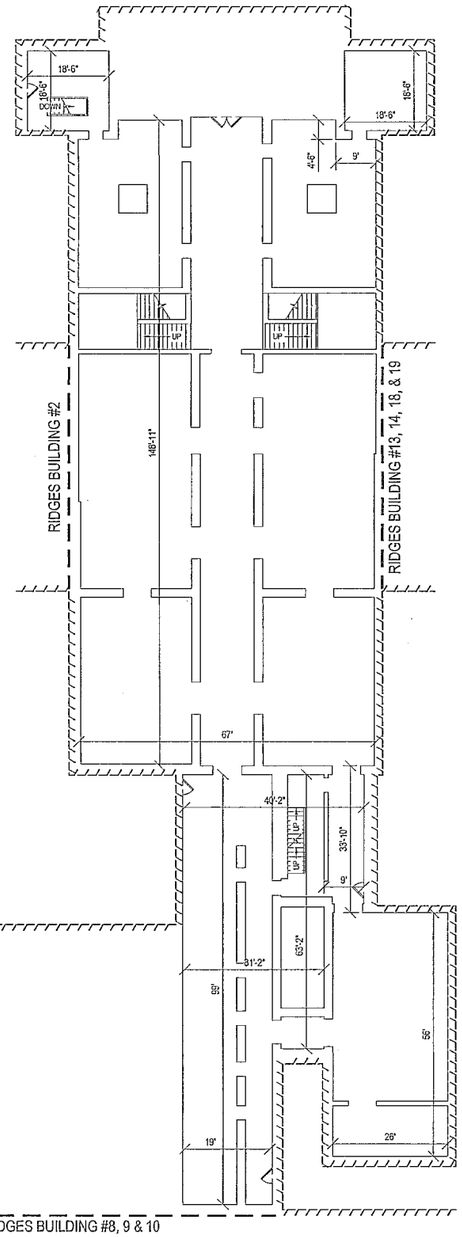

SCALE: $\frac{1}{16}$" = 1' 0" SECOND FLOOR PLAN - RIDGES BUILDING #1, 11 & 12 - UNIT 501

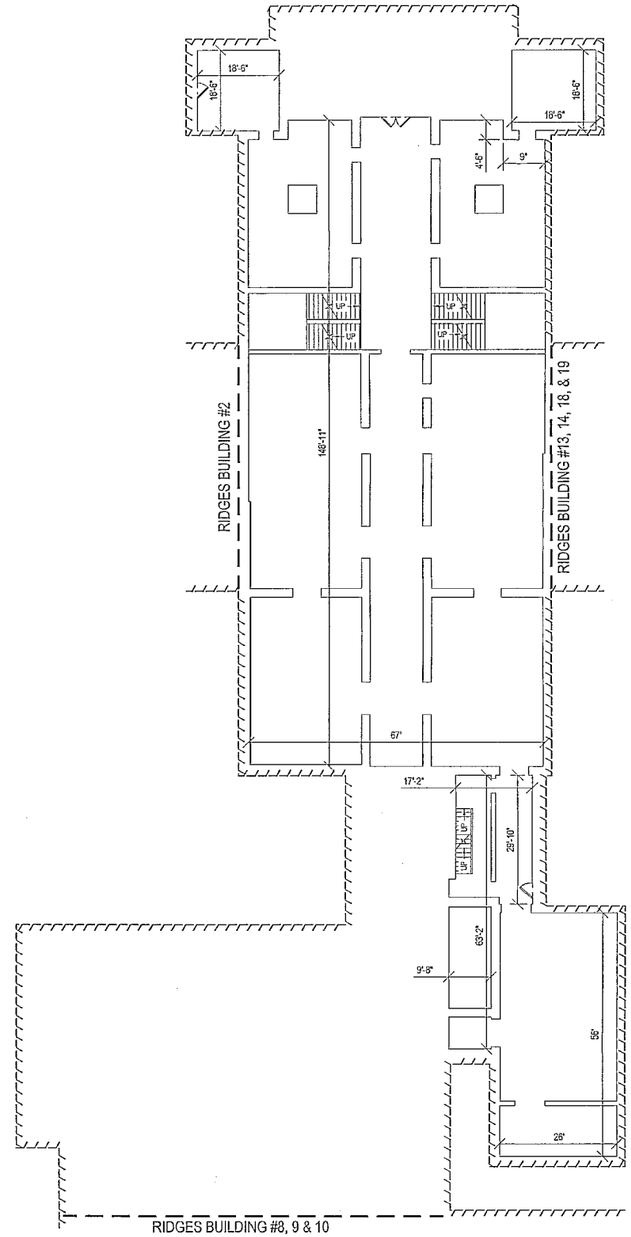

SCALE: $\frac{1}{16}$" = 1' 0" THIRD FLOOR PLAN - RIDGES BUILDING #1, 11 & 12 - UNIT 501

NO.	DATE	BY	DESCRIPTION

237 NORTH MAIN STREET
ADRIAN, MI 49221
TEL: 517.263.4515
FAX: 517.263.4535

TECHNICAL EXCELLENCE. CREATIVE DESIGN.

Mannik Smith Group

www.MannikSmithGroup.com

PROJECT DATE:	03/17/2025
PROJECT NO.:	2500682
DRAWN BY:	CDH
CHECKED BY:	PW

PREPARED FOR:

OHIO UNIVERSITY

ATHENS, OHIO 45701

OHIO UNIVERSITY
RIDGES SURVEY
118 RIDGES CIRCLE,
ATHENS, OHIO 45701


RIDGES BUILDING #1,
11, & 12 FLOOR PLAN

10 / 64


\\MSGFILESRV\MSGData\Projects\2025\600-799\2500682\CAD\SURV\2500682_BLDG.dwg - Last printed 4/6/2026 2:21 PM

Envelope
593 A


202600004082
FILED FOR RECORD IN
ATHENS COUNTY, OHIO
JESSICA MARKINS, RECORDER
09/10/2026 02:30:22 PM
OR BOOK: 639 PAGE: 272
LARGE PLAT. 86.40 FEE: 1

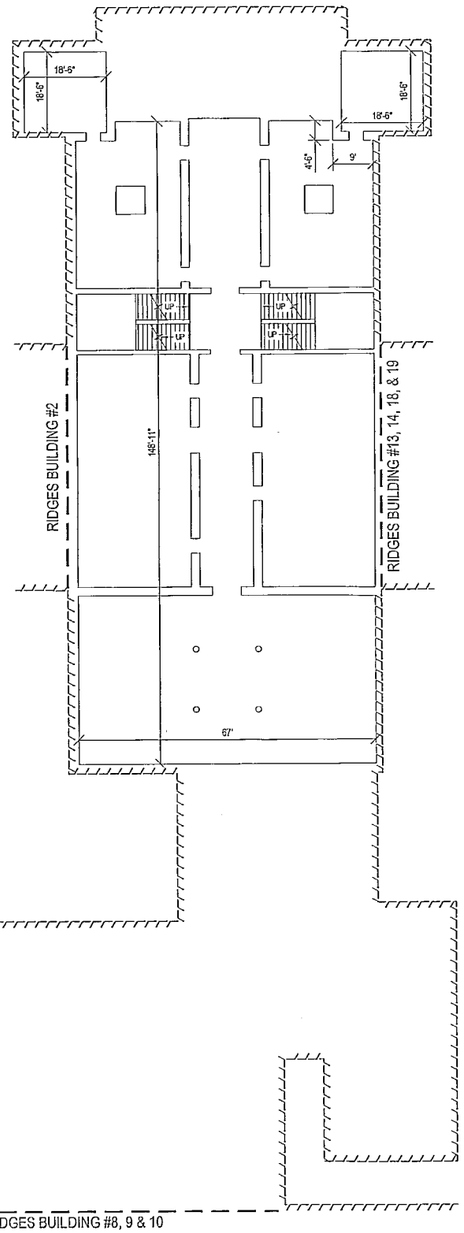

SCALE: $\frac{1}{16}$" = 1' 0" FOURTH FLOOR PLAN - RIDGES BUILDING #1, 11 & 12 - UNIT 501

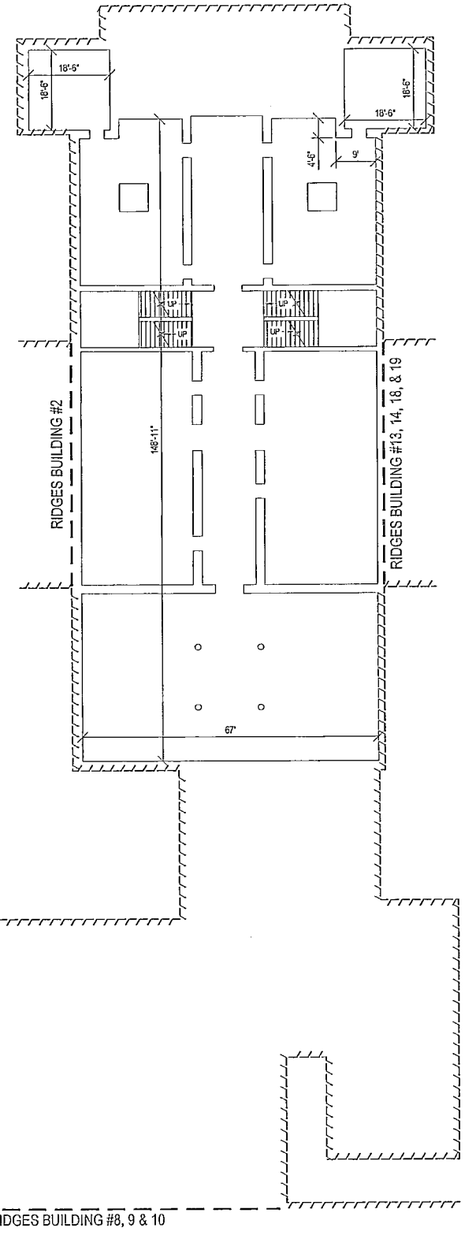

SCALE: $\frac{1}{16}$" = 1' 0" FIFTH FLOOR PLAN - RIDGES BUILDING #1, 11 & 12 - UNIT 501

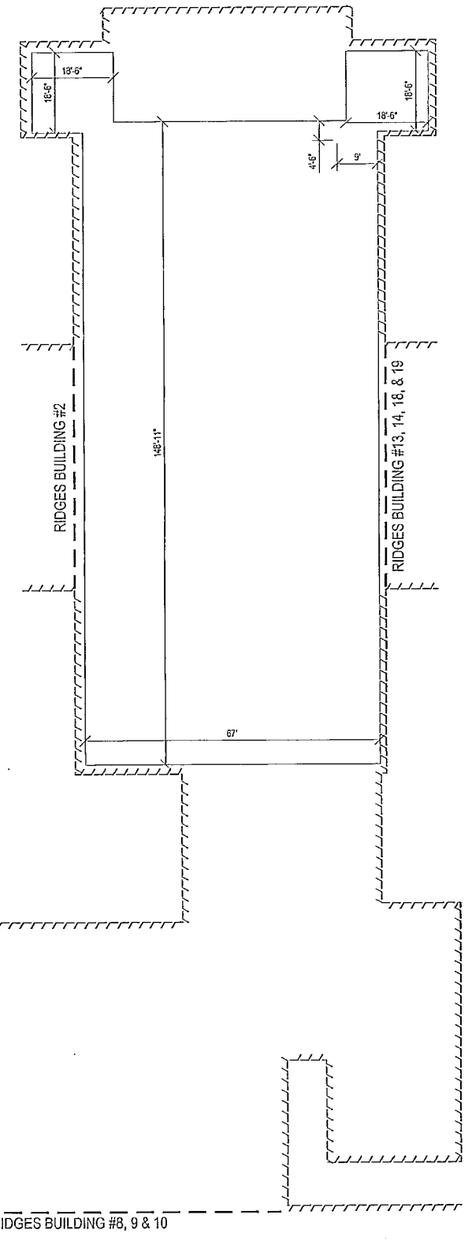

SCALE: $\frac{1}{16}$" = 1' 0" ATTIC FLOOR PLAN - RIDGES BUILDING #1, 11 & 12 - UNIT 501

NO.	DATE	BY	DESCRIPTION

257 NORTH MAIN STREET
ADRIAN, MI 49221
TEL: 517.263.4515
FAX: 517.263.4535

PROJECT DATE: 09/12/2025
PROJECT NO.: 2500682
DRAWN BY: CDH
CHECKED BY: PW

Mannik Smith Group
TECHNICAL SKILL. CREATIVE SPIRIT.
www.MannikSmithGroup.com

PREPARED FOR:
OHIO UNIVERSITY
ATHENS, OHIO 45701

OHIO UNIVERSITY
RIDGES SURVEY
118 RIDGES CIRCLE,
ATHENS, OHIO 45701


RIDGES BUILDING #1, 11, & 12 FLOOR PLAN

11 / 64

\\MSGFILESRV\MSGData\Projects\2025\600-799\2500682\CAD\SURV\2500682_BLDG.dwg - Last printed 4/6/2026 2:21 PM

202600004090
FILED FOR RECORD IN
ATHENS COUNTY, OHIO
JESSICA HAWKINS, RECORDER
09/10/2026 02:39:23 PM
OR BOOK: 639 PAGE: 273
LARGE PLAT 86.40 PG: 1

Envelope 5938

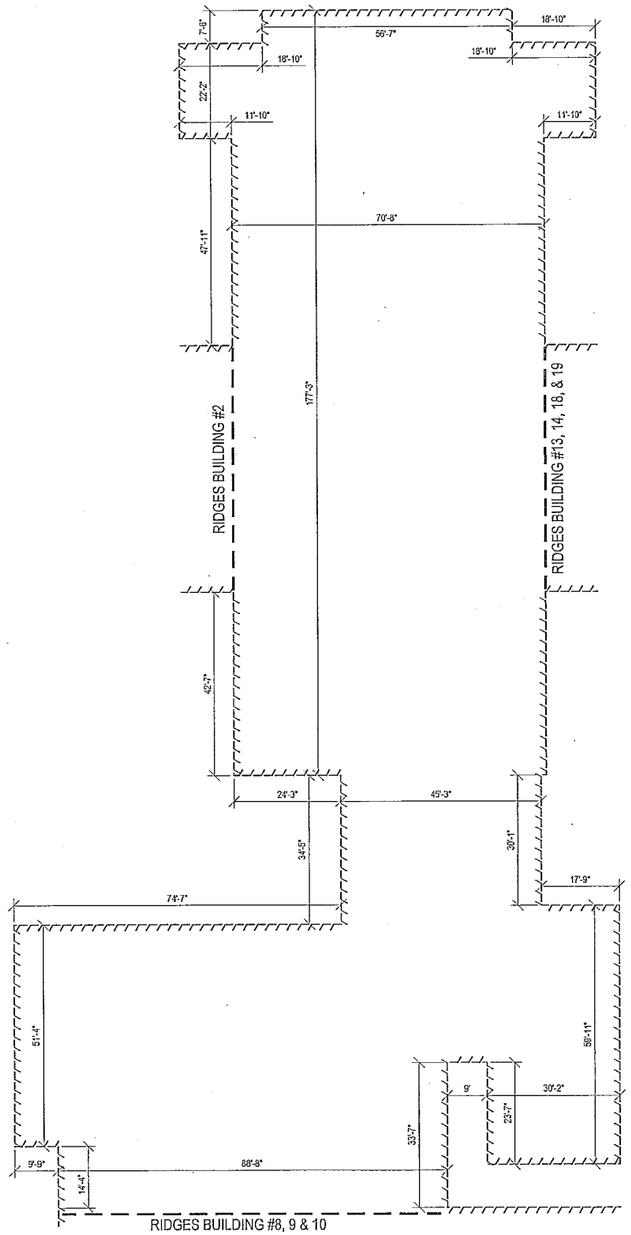

SCALE: $\frac{1}{16}$" = 1' 0" BUILDING DIMENSIONS - RIDGES BUILDING #1, 11 & 12 - UNIT 501

257 NORTH MAIN STREET
FAX: 517.263.4535

NO.	DATE	BY	DESCRIPTION

PROJECT DATE: 09/12/2025
PROJECT NO.: 2500682
DRAWN BY: CDH
CHECKED BY: PW

Mannik Smith Group
TECHNICAL SKILL, CREATIVE SPIRIT.
www.MannikSmithGroup.com

PREPARED FOR:
OHIO UNIVERSITY
ATHENS, OHIO 45701

OHIO UNIVERSITY
RIDGES SURVEY
118 RIDGES CIRCLE,
ATHENS, OHIO 45701


RIDGES BUILDING #1, 11, & 12 BUILDING DIMENSIONS

12 / 64


\\MSGFILESRV\MSGData\Projects\2025\600-799\2500682\CAD\SURV\2500682_BLDG.dwg - Last printed 4/6/2026 2:21 PM

202600004091
FILED FOR RECORD IN
ATHENS COUNTY, OHIO
JESSICA MARKINS, RECORDER
09/10/2026 02:30:24 PM
OR BOOK: 639 PAGE: 274

Envelope 394A

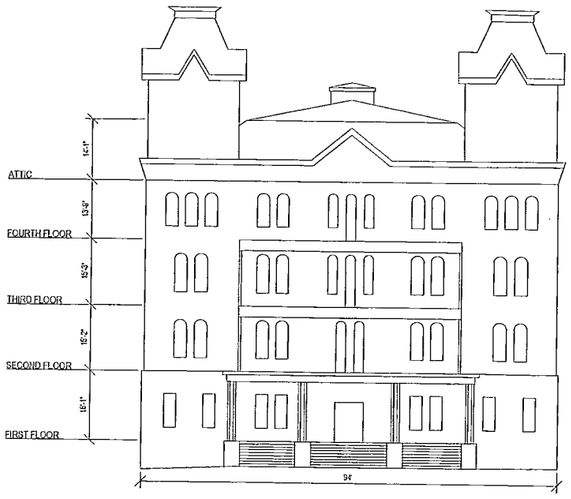


SCALE: $\frac{1}{16}$ = 1' 0" NORTH ELEVATION - RIDGES BUILDING #1, 11, & 12 - UNIT 501

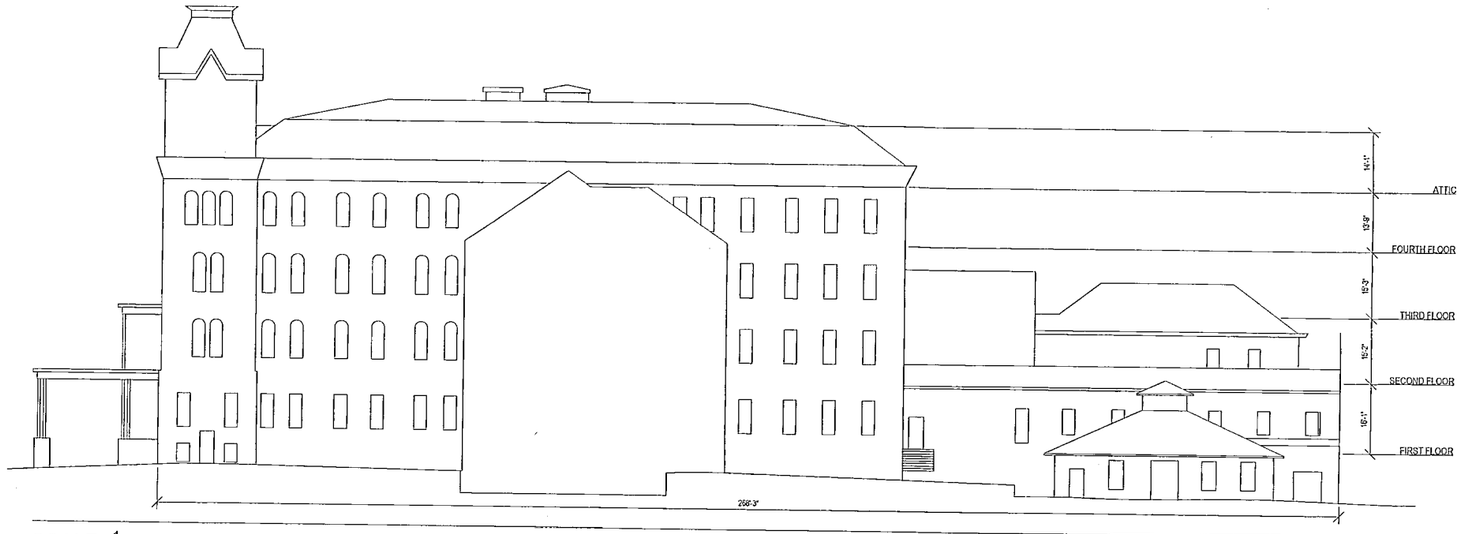


SCALE: $\frac{1}{16}$ = 1' 0"

EAST ELEVATION - RIDGES BUILDING #1, 11, & 12 - UNIT 501

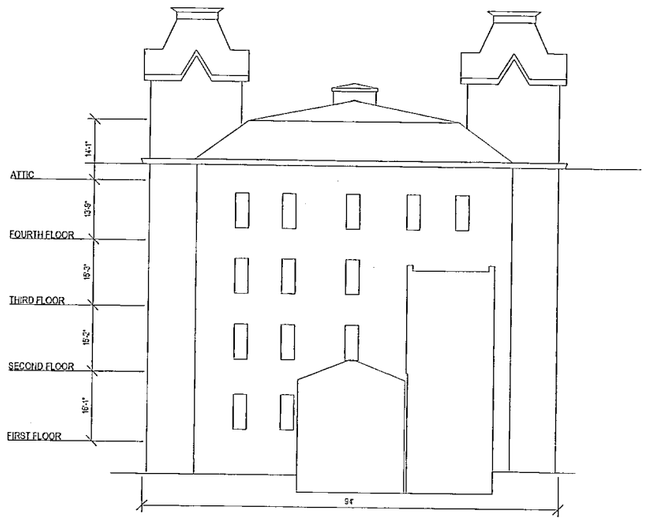

SCALE: $\frac{1}{16}$ = 1' 0" SOUTH ELEVATION - RIDGES BUILDING #1, 11, & 12 - UNIT 501

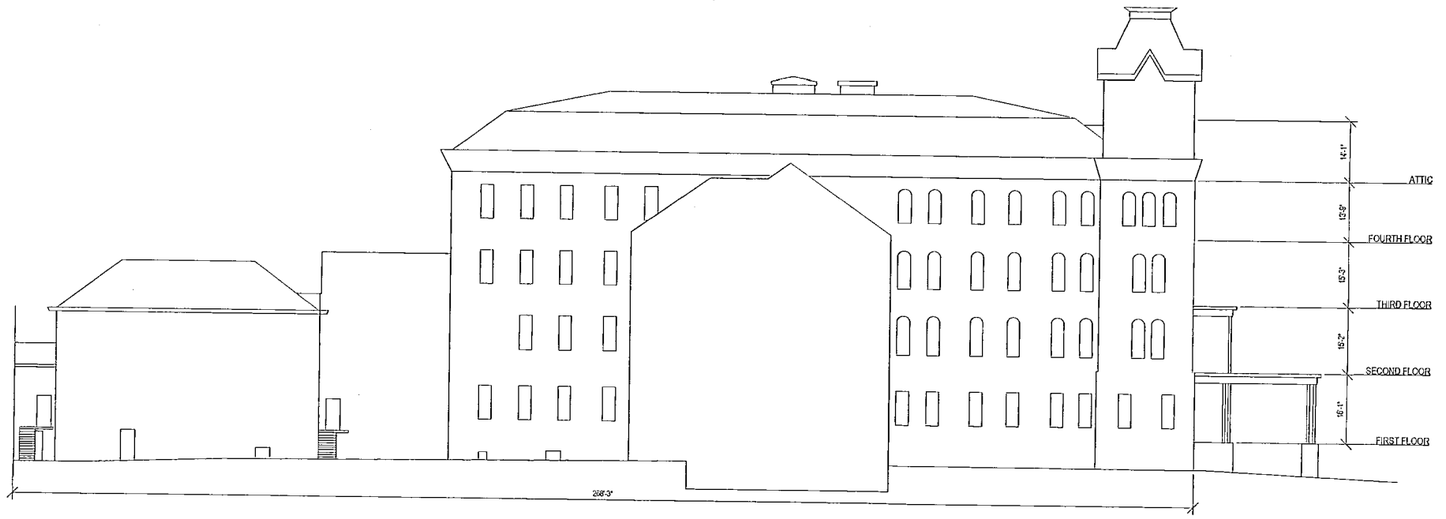

SCALE: $\frac{1}{16}$ = 1' 0"


NO.	DATE	BY	DESCRIPTION

237 NORTH MAIN STREET
ADRIAN, MI 49221
TEL: 517.263.4515
FAX: 517.263.4535

PROJECT DATE: 09/12/2025
PROJECT NO.: 2500682
DRAWN BY: CDH
CHECKED BY: PW

TRANSMITAL STATEMENT: THIS DRAWING AND DESIGN IS THE PROPERTY OF MANNIK & SMITH GROUP AND IS NOT TO BE USED IN WHOLE OR IN PART FOR ANY OTHER PROJECT WITHOUT THE WRITTEN AUTHORIZATION OF MANNIK & SMITH GROUP.

Mannik Smith Group
www.MannikSmithGroup.com

PREPARED FOR:
OHIO UNIVERSITY
ATHENS, OHIO 45701


OHIO UNIVERSITY
RIDGES SURVEY
118 RIDGES CIRCLE,
ATHENS, OHIO 45701

RIDGES BUILDING
#1, 11, & 12
ELEVATIONS


I:\MSGFILESRV1\MSGData\Projects\2025\1600-7999\2500682\CAD\SURV\2500682_ELEV.dwg - Last printed 4/6/2026 2:21 PM

202600004092
FILED FOR RECORD IN
ATHENS COUNTY, OHIO
JESSICA MARKINS, RECORDER
09/10/2026 02:30:25 PM
OR BOOK: 639 PAGE: 275


Envelope 5948

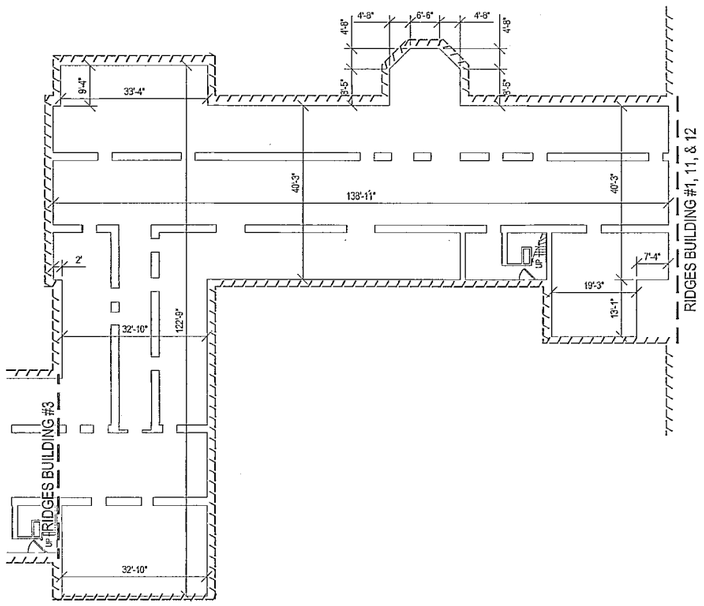


SCALE: $\frac{1}{16}$" = 1' 0" BASEMENT FLOOR PLAN - RIDGES BUILDING #2 - UNIT 601

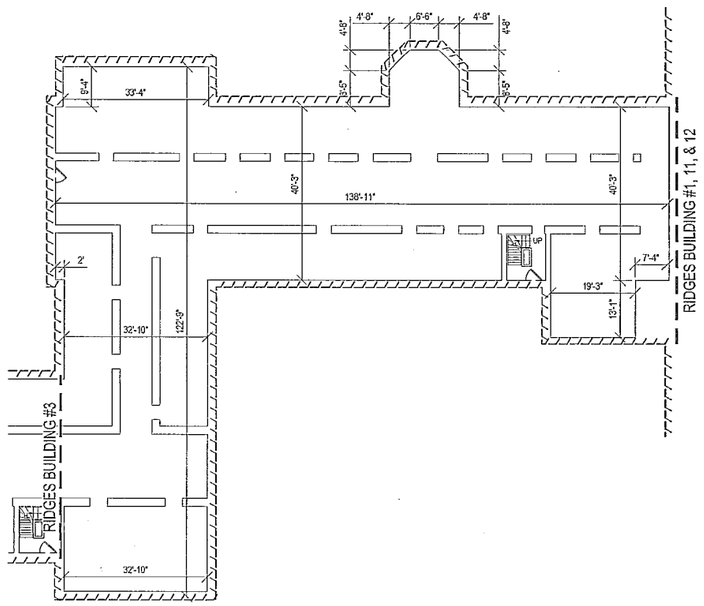


SCALE: $\frac{1}{16}$" = 1' 0" FIRST FLOOR PLAN - RIDGES BUILDING #2 - UNIT 601

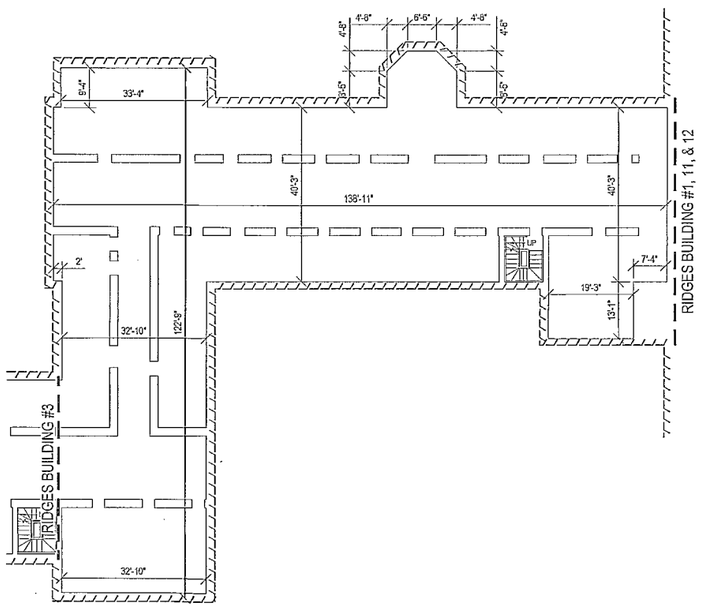

SCALE: $\frac{1}{16}$" = 1' 0" SECOND FLOOR PLAN - RIDGES BUILDING #2 - UNIT 601

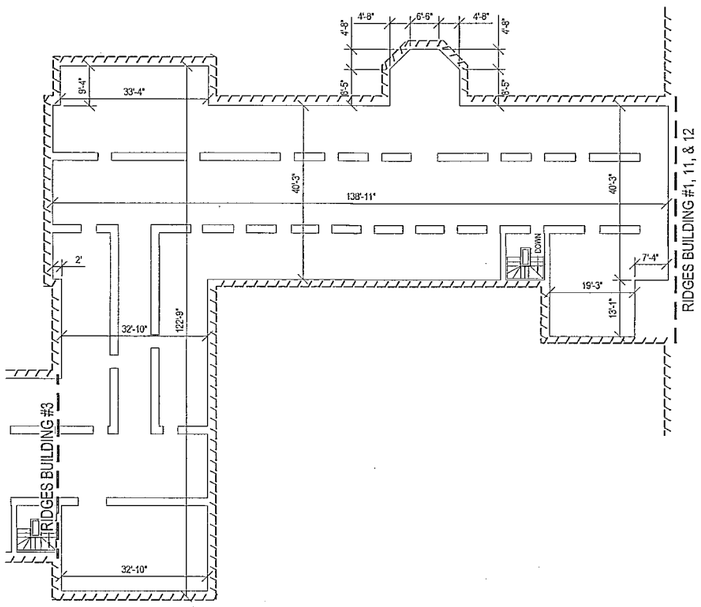

SCALE: $\frac{1}{16}$" = 1' 0" THIRD FLOOR PLAN - RIDGES BUILDING #2 - UNIT 601

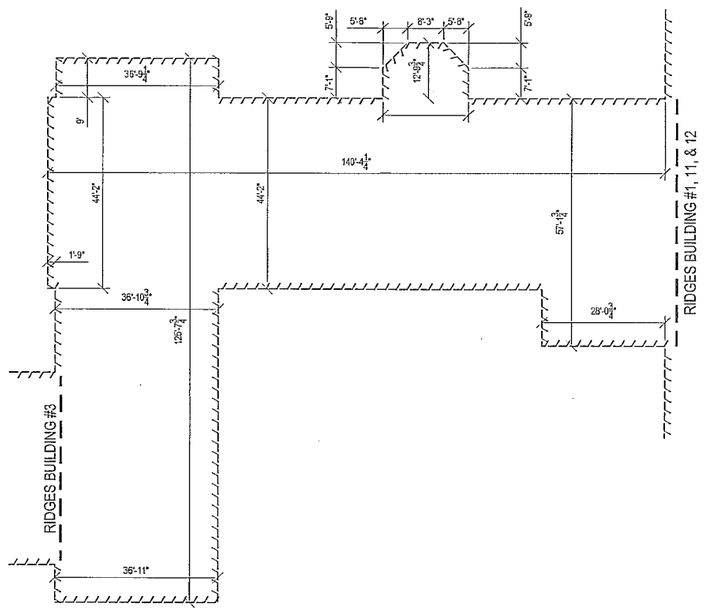

SCALE: $\frac{1}{16}$" = 1' 0" BUILDING DIMENSIONS - RIDGES BUILDING #2 - UNIT 601

NO.	DATE	BY	DESCRIPTION

237 NORTH MAIN STREET
TEL: 517.263.4515
FAX: 517.263.4535

PROJECT DATE: 09/12/2025
PROJECT NO.: 2500682
DRAWN BY: CDH
CHECKED BY: PW

TECHNICAL SKILL. CREATIVE SPIRIT.

Manik Smith Group
www.ManikSmithGroup.com

PREPARED FOR:
OHIO UNIVERSITY
ATHENS, OHIO 45701


OHIO UNIVERSITY
RIDGES SURVEY
118 RIDGES CIRCLE,
ATHENS, OHIO 45701

RIDGES BUILDING #2
FLOOR PLAN &
BUILDING DIMENSIONS


14 / 64

\\MSGFILESRV\MSGData\Projects\2025\6000-7999\2500682\CAD\SURV\2500682_BLDG.dwg - Last printed 4/6/2026 2:21 PM


FILED FOR RECORD IN
ATHENS COUNTY, OHIO
JESSICA HARKINS, RECORDER
09/10/2026 02:30:26 PM
OR BOOK: 639 PAGE: 276
LARGE PLAT 86.40 PG: 1

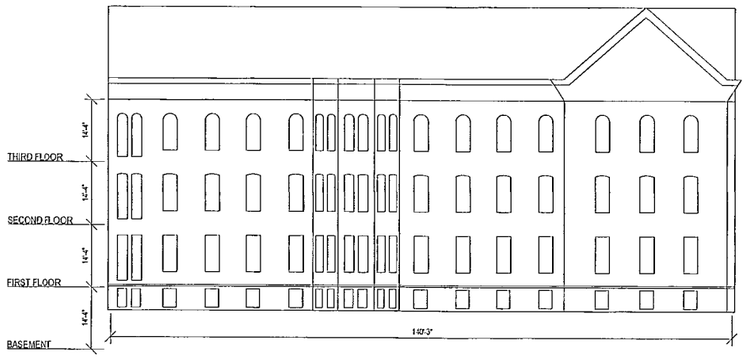


SCALE: $\frac{1}{16}$ = 1' 0" NORTH ELEVATION - RIDGES BUILDING #2 - UNIT 601

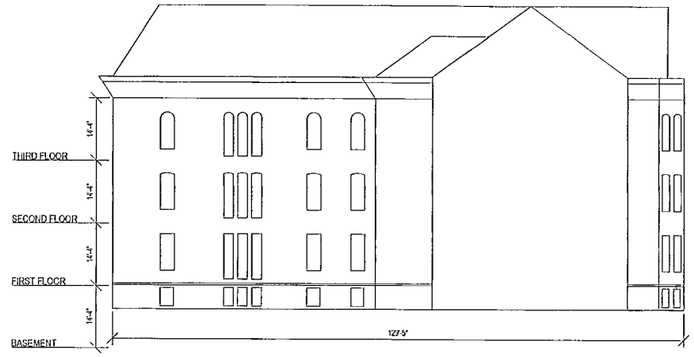

SCALE: $\frac{1}{16}$ = 1' 0" EAST ELEVATION - RIDGES BUILDING #2 - UNIT 601

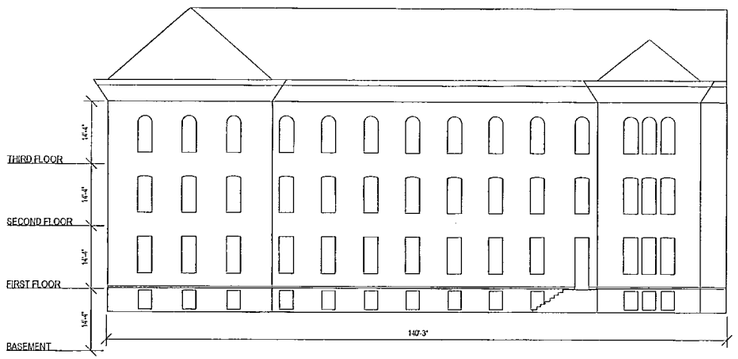

SCALE: $\frac{1}{16}$ = 1' 0" SOUTH ELEVATION - RIDGES BUILDING #2 - UNIT 601

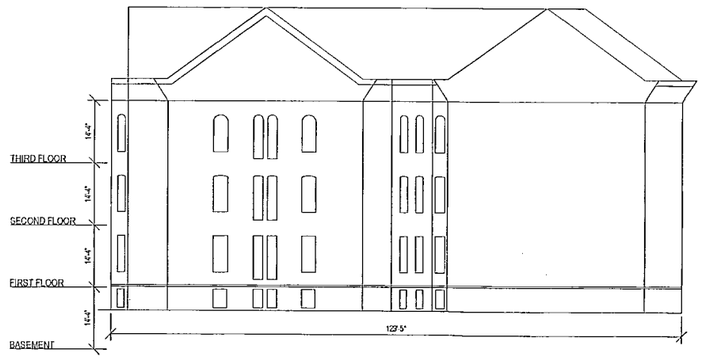

SCALE: $\frac{1}{16}$ = 1' 0" WEST ELEVATION - RIDGES BUILDING #2 - UNIT 601

237 NORTH MAIN STREET
ADRIAN, MI 49221
TEL: 517.263.4516
FAX: 517.263.4535

NO.	DATE	BY	DESCRIPTION

PROJECT DATE: 08/12/2025
PROJECT NO.: 2500682
DRAWN BY: CDH
CHECKED BY: PW

TECHNICAL SKILL. CREATIVE SPIRIT.

Mannik Smith Group
www.MannikSmithGroup.com

PREPARED FOR:
OHIO UNIVERSITY
ATHENS, OHIO 45701

OHIO UNIVERSITY
RIDGES SURVEY
118 RIDGES CIRCLE,
ATHENS, OHIO 45701



15 / 64


\\MSGFILESRV\MSGData\Projects\2025\600-799\2500682\CAD\SURV\2500682_ELEV.dwg - Last printed 4/6/2026 2:21 PM

202600004094
FILED FOR RECORD IN
ATHENS COUNTY, OHIO
JESSICA HARKINS, RECORDER
09/10/2026 02:30:27 PM
OR BOOK: 639 PAGE: 277


Envelope
595 B

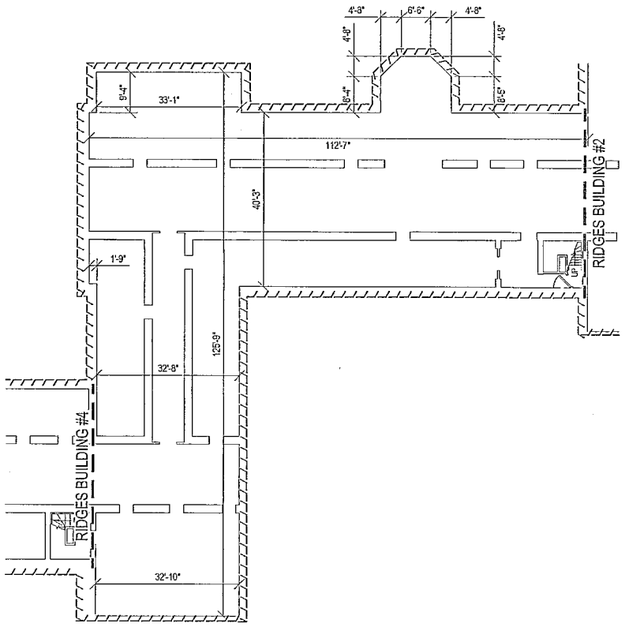


SCALE: $\frac{1}{16}$" = 1' 0" BASEMENT FLOOR PLAN - RIDGES BUILDING #3 - UNIT 701

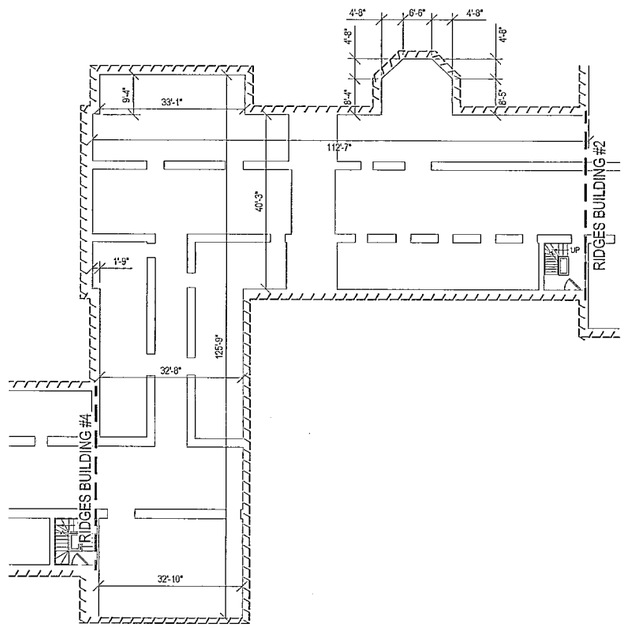


SCALE: $\frac{1}{16}$" = 1' 0" FIRST FLOOR PLAN - RIDGES BUILDING #3 - UNIT 701

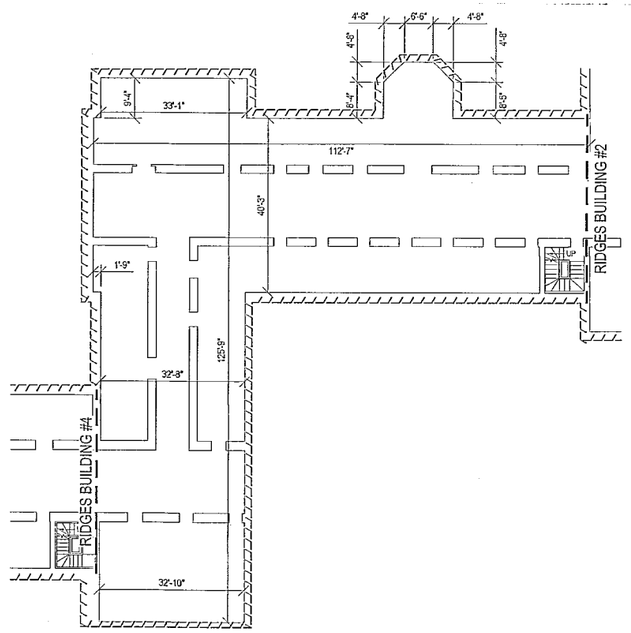

SCALE: $\frac{1}{16}$" = 1' 0" SECOND FLOOR PLAN - RIDGES BUILDING #3 - UNIT 701

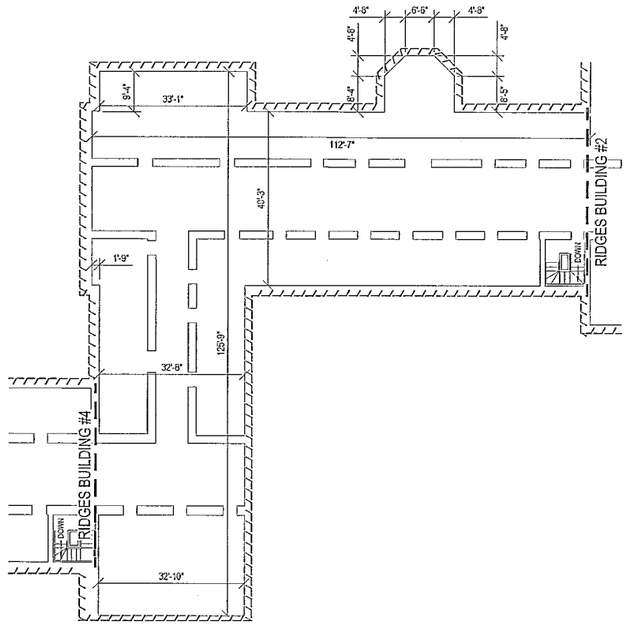

SCALE: $\frac{1}{16}$" = 1' 0" THIRD FLOOR PLAN - RIDGES BUILDING #3 - UNIT 701

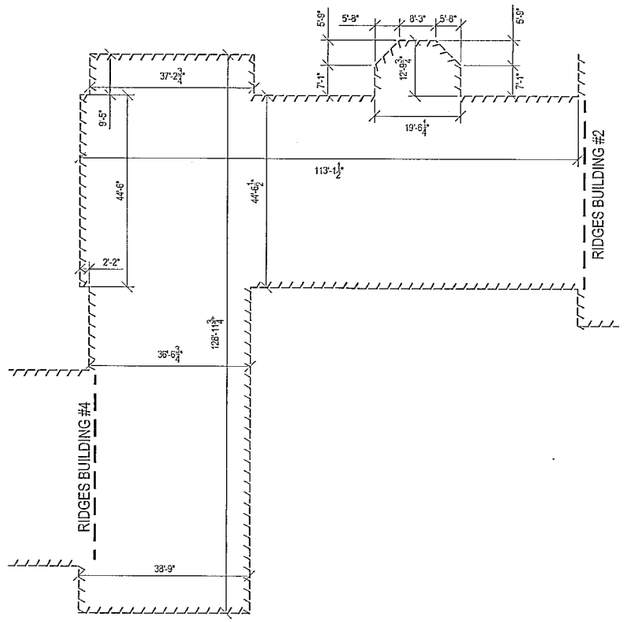

SCALE: $\frac{1}{16}$" = 1' 0" BUILDING DIMENSIONS - RIDGES BUILDING #3 - UNIT 701

237 NORTH MAIN STREET
TEL: 517.265.4515
FAX: 517.265.4535

NO.	DATE	BY	DESCRIPTION

PROJECT DATE: 09/12/2025
PROJECT NO.: 2500682
DRAWN BY: CDH
CHECKED BY: PW

TECHNICAL SKILL. CREATIVE SPIRIT.
Manik Smith Group
www.ManikSmithGroup.com

PREPARED FOR:
OHIO UNIVERSITY
ATHENS, OHIO 45701

OHIO UNIVERSITY
RIDGES SURVEY
118 RIDGES CIRCLE,
ATHENS, OHIO 45701


RIDGES BUILDING #3
FLOOR PLAN &
BUILDING DIMENSIONS

16 / 64


\\MSGFILESRV\MSGData\Projects\2025\600-799\2500682\CAD\SURV\2500682_BLDG.dwg - Last printed 4/6/2026 2:21 PM

202600004095
FILED FOR RECORD IN
ATHENS COUNTY, OHIO
JESSICA HARKINS, RECORDER
09/10/2026 02:30:28 PM
OR BOOK: 639 PAGE: 278


Envelope
39 A

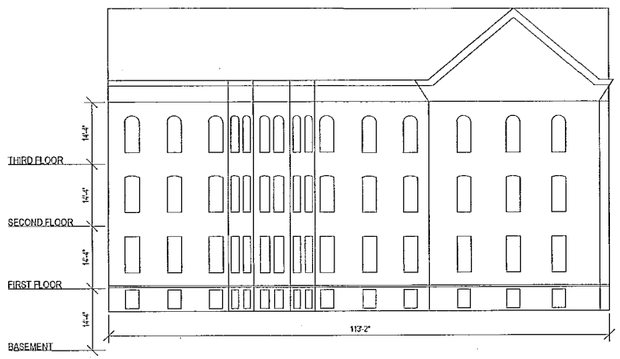


SCALE: $\frac{1}{16}$ = 1' 0" NORTH ELEVATION - RIDGES BUILDING #3 - UNIT 701

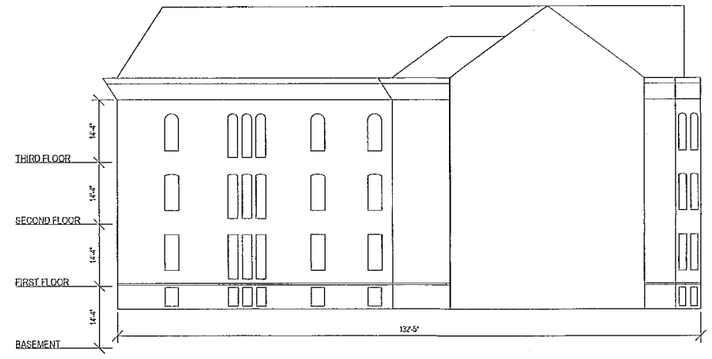

SCALE: $\frac{1}{16}$ = 1' 0" EAST ELEVATION - RIDGES BUILDING #3 - UNIT 701

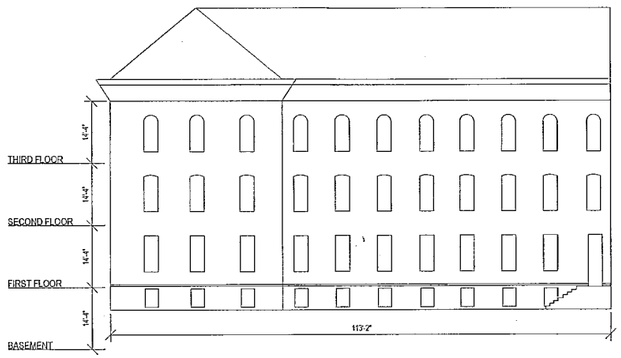

SCALE: $\frac{1}{16}$ = 1' 0" SOUTH ELEVATION - RIDGES BUILDING #3 - UNIT 701

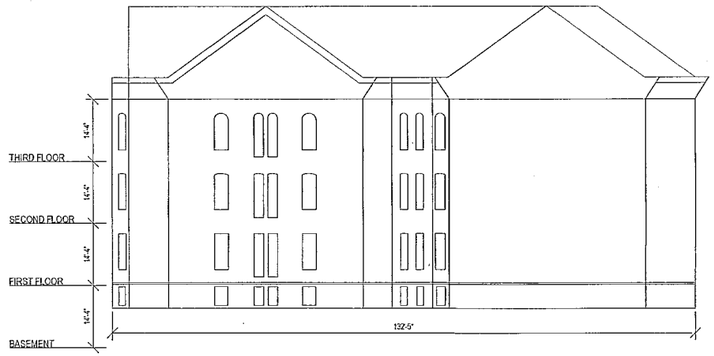

SCALE: $\frac{1}{16}$ = 1' 0" WEST ELEVATION - RIDGES BUILDING #3 - UNIT 701

NO.	DATE	BY	DESCRIPTION

237 NORTH MAIN STREET
ADRIAN, MI 49221
TEL: 517.263.4515
FAX: 517.263.4535

PROJECT DATE: 09/12/2025
PROJECT NO.: 2500682.
DRAWN BY: CDH
CHECKED BY: PW

Mannik Smith Group
www.MannikSmithGroup.com

PREPARED FOR:
OHIO UNIVERSITY
ATHENS, OHIO 45701


OHIO UNIVERSITY
RIDGES SURVEY
118 RIDGES CIRCLE,
ATHENS, OHIO 45701

RIDGES BUILDING
#3 ELEVATIONS


17 / 64

\\MSGFILESRV\MSGData\Projects\2025\600-799\2500682\CAD\SURV\2500682_ELEV.dwg - Last printed 4/6/2026 2:21 PM


202600001076
FILED FOR RECORD IN
ATHENS COUNTY, OHIO
JESSICA WARKINS, RECORDER
09/10/2026 02:30:29 PM
OR BOOK: 639 PAGE: 279
LABEL PLAT . 86.40 PG: 1
Envelope
596 B

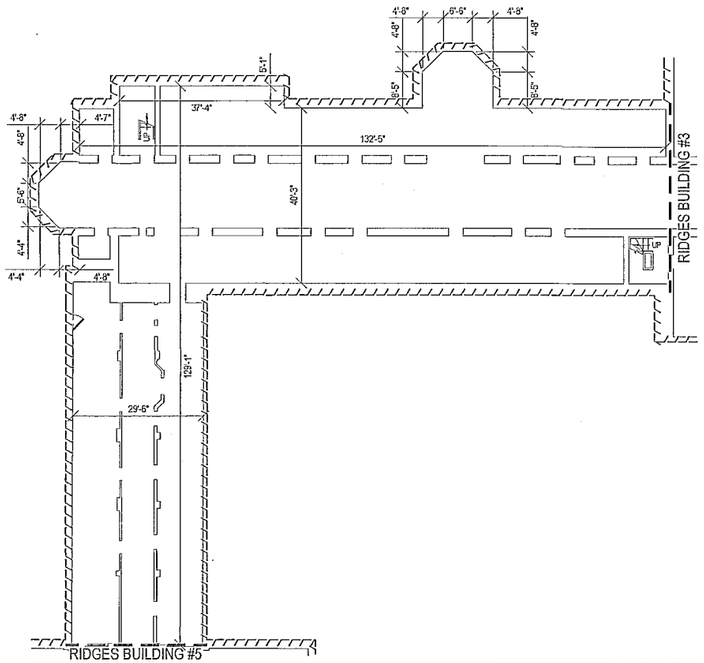


SCALE: $\frac{1}{16}$" = 1' 0" BASEMENT FLOOR PLAN - RIDGES BUILDING #4 - UNIT 801

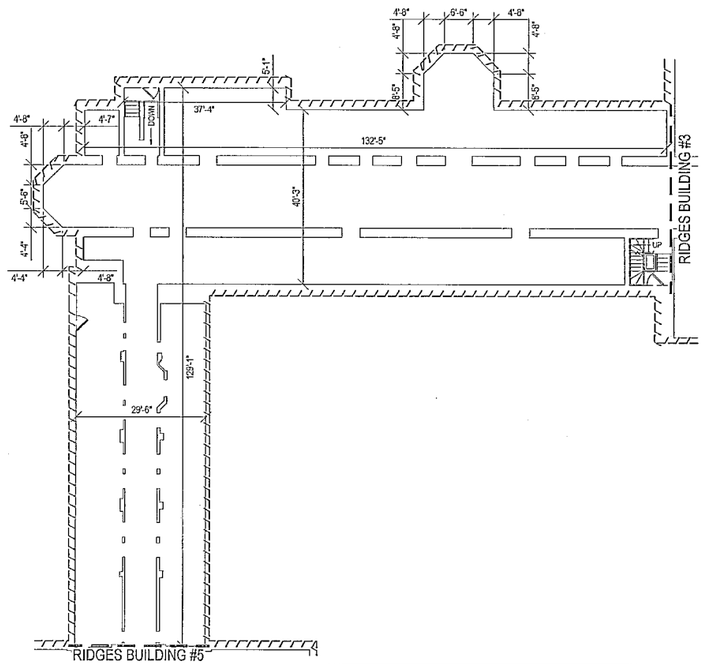


SCALE: $\frac{1}{16}$" = 1' 0" FIRST FLOOR PLAN - RIDGES BUILDING #4 - UNIT 801

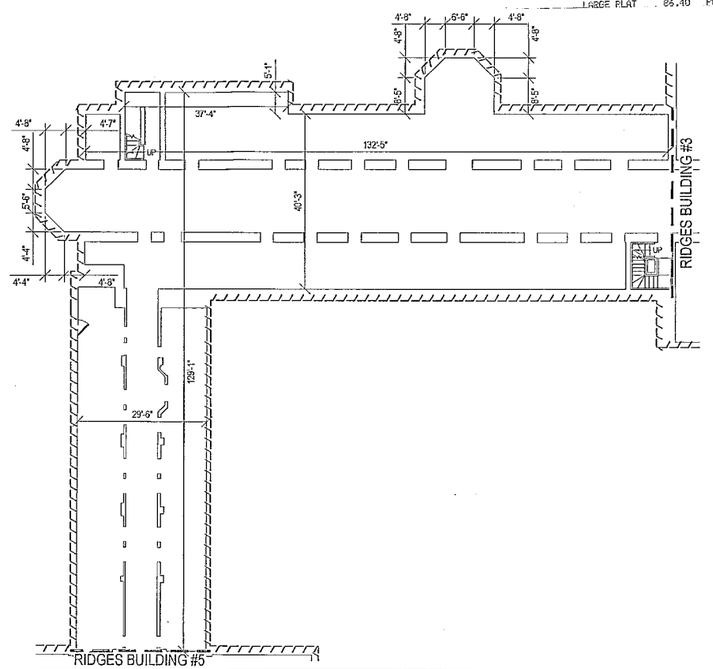


SCALE: $\frac{1}{16}$" = 1' 0" SECOND FLOOR PLAN - RIDGES BUILDING #4 - UNIT 801

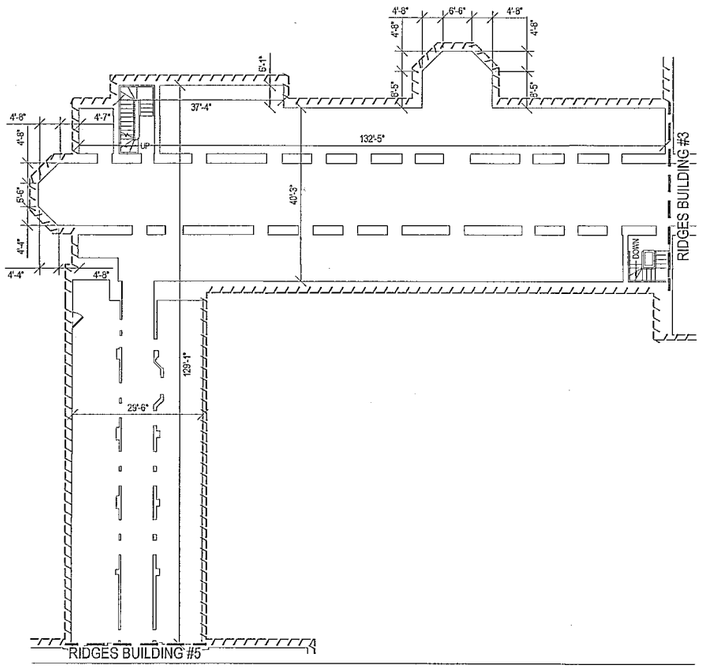

SCALE: $\frac{1}{16}$" = 1' 0" THIRD FLOOR PLAN - RIDGES BUILDING #4 - UNIT 801

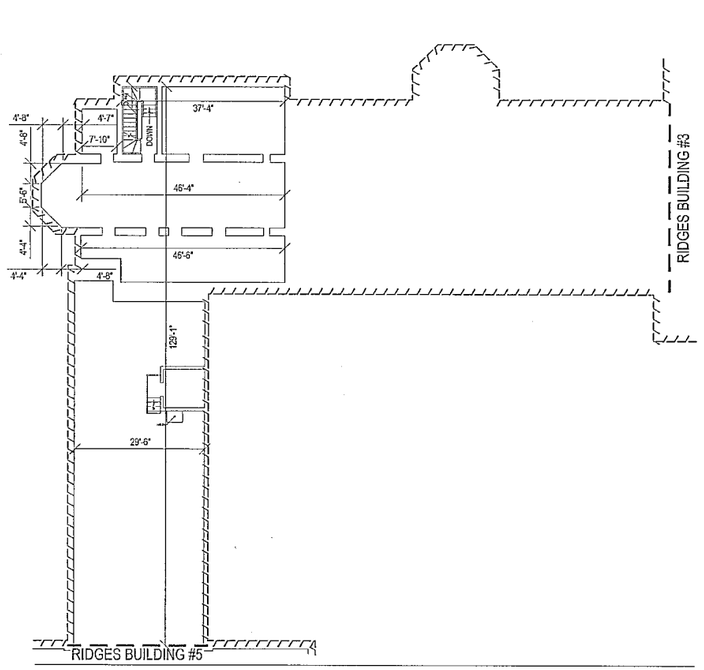

SCALE: $\frac{1}{16}$" = 1' 0" FOURTH FLOOR PLAN - RIDGES BUILDING #4 - UNIT 801

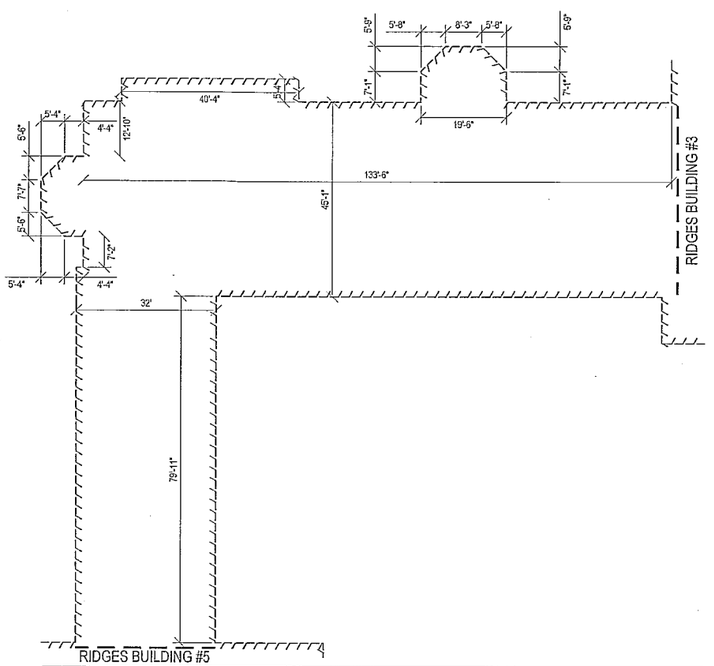

SCALE: $\frac{1}{16}$" = 1' 0" BUILDING DIMENSIONS - RIDGES BUILDING #4 - UNIT 801

Mannik Smith Group
www.MannikSmithGroup.com

NO.	DATE	BY	DESCRIPTION

PROJECT DATE: 09/12/2025
PROJECT NO.: 2500682
DRAWN BY: CDH
CHECKED BY: PW

PREPARED FOR:
OHIO UNIVERSITY
ATHENS, OHIO 45701

OHIO UNIVERSITY
RIDGES SURVEY
118 RIDGES CIRCLE,
ATHENS, OHIO 45701

RIDGES BUILDING #4
FLOOR PLAN &
BUILDING DIMENSIONS

18 / 64


\\MSGFILESRV\MSGData\Projects\2025\9600-7999\2500682\CAD\SURV\2500682_BLDG.dwg - Last printed 4/6/2026 2:21 PM

2026000004097
FILED FOR RECORD IN
ATHENS COUNTY, OHIO
JESSICA MARKINS, RECORDER
09/10/2026 02:30:30 PM
OR BOOK: 639 PAGE: 280
LARGE PLAT 86.40 FEE:


Envelope 597 A




SCALE: $\frac{1}{16}$ = 1' 0" NORTH ELEVATION - RIDGES BUILDING #4 - UNIT 801

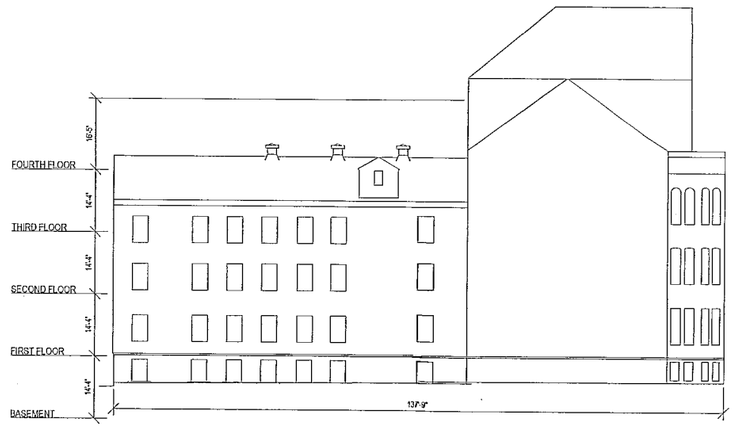

SCALE: $\frac{1}{16}$ = 1' 0" EAST ELEVATION - RIDGES BUILDING #4 - UNIT 801

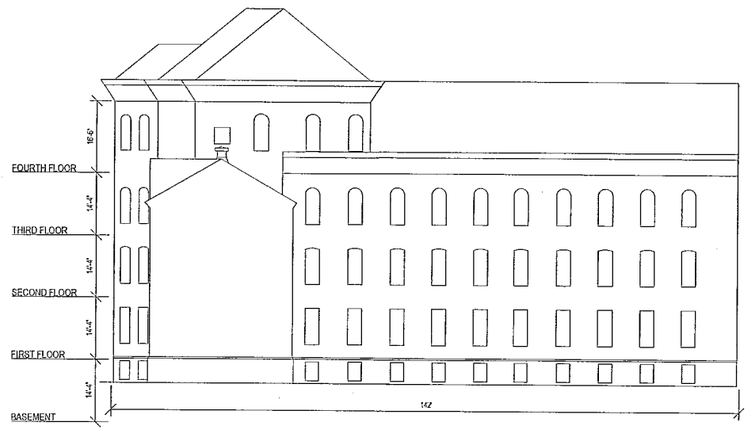

SCALE: $\frac{1}{16}$ = 1' 0" SOUTH ELEVATION - RIDGES BUILDING #4 - UNIT 801

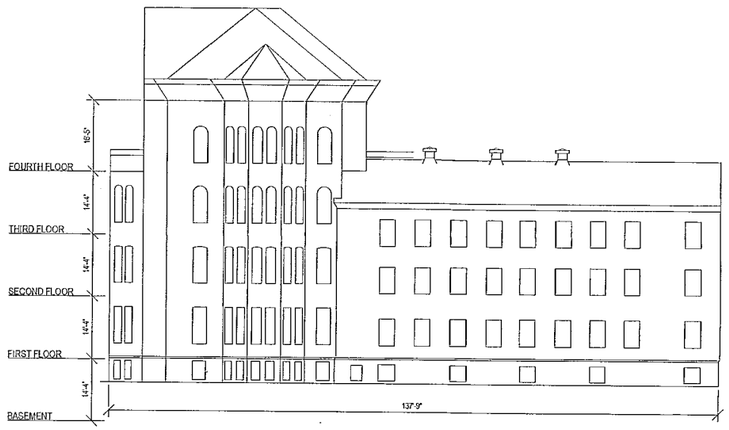

SCALE: $\frac{1}{16}$ = 1' 0" WEST ELEVATION - RIDGES BUILDING #4 - UNIT 801

237 NORTH MAIN STREET
ADRIAN, MI 49221
TEL: 517.263.4515
FAX: 517.263.4535

NO.	DESCRIPTION	DATE	BY

PROJECT DATE: 08/12/2025
PROJECT NO.: 2500682
DRAWN BY: CDH
CHECKED BY: PW

Mannik Smith Group
TECHNICAL SKILL. CREATIVE SPIRIT.
www.MannikSmithGroup.com

PREPARED FOR:
OHIO UNIVERSITY
ATHENS, OHIO 45701

OHIO UNIVERSITY
RIDGES SURVEY
118 RIDGES CIRCLE,
ATHENS, OHIO 45701


RIDGES BUILDING #4
ELEVATIONS

19 / 64


W:\SGFILESRV1\MSGData\Projects\2025\0600-7999\2500682\CAD\SURV\2500682_ELEV.dwg - Last printed 4/6/2026 2:21 PM

Envelope 537 B


202600004098
FILED FOR RECORD IN
ATHENS COUNTY, OHIO
JESSICA MARKINS, RECORDER
09/10/2026 02:30:31 PM
OR BOOK: 639 PAGE: 281

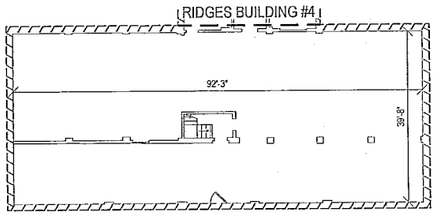


SCALE: $\frac{1}{16}$" = 1' 0" FIRST FLOOR PLAN - RIDGES BUILDING #5 - UNIT 901

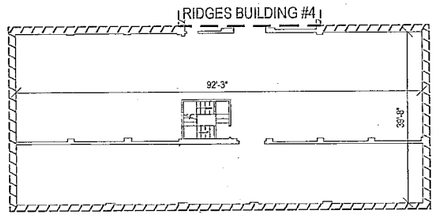


SCALE: $\frac{1}{16}$" = 1' 0" SECOND FLOOR PLAN - RIDGES BUILDING #5 - UNIT 901

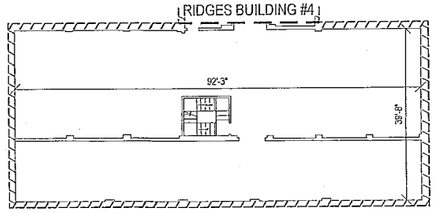


SCALE: $\frac{1}{16}$" = 1' 0" THIRD FLOOR PLAN - RIDGES BUILDING #5 - UNIT 901

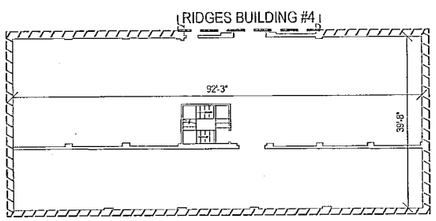

SCALE: $\frac{1}{16}$" = 1' 0" FOURTH FLOOR PLAN - RIDGES BUILDING #5 - UNIT 901

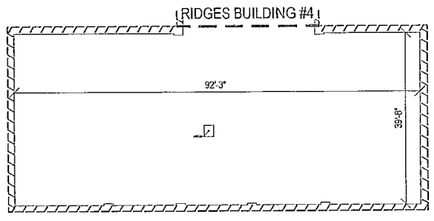

SCALE: $\frac{1}{16}$" = 1' 0" ATTIC FLOOR PLAN - RIDGES BUILDING #5 - UNIT 901

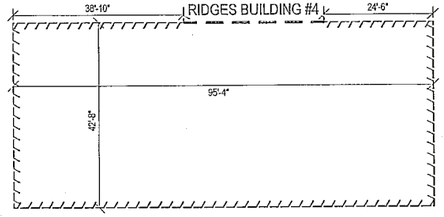

SCALE: $\frac{1}{16}$" = 1' 0" BUILDING DIMENSIONS - RIDGES BUILDING #5 - UNIT 901

\\MSGFILESRV\MSGData\Projects\2025\600-7992500682\CAD\SURV\2500682_BLDG.dwg - Last printed 4/6/2026 2:21 PM

NO. | DESCRIPTION | DATE | BY

237 NORTH MAIN STREET
ADRIAN, MI 49221
TEL: 517.263.4215
FAX: 517.263.4535

PROJECT DATE: 09/10/2025
PROJECT NO.: 2500682
DRAWN BY: CDH
CHECKED BY: PW

TECHNICAL SKILL. CREATIVE SPIRIT.

Manik smith group
www.ManikSmithGroup.com

PREPARED FOR:
OHIO UNIVERSITY
ATHENS, OHIO 45701


OHIO UNIVERSITY
RIDGES SURVEY
118 RIDGES CIRCLE,
ATHENS, OHIO 45701

RIDGES BUILDING #5
FLOOR PLAN &
BUILDING DIMENSIONS


20 / 64

202600004092
FILED FOR RECORD IN
ATHENS COUNTY, OHIO
JESSICA HARKINS, RECORDER
09/10/2026 02:30:32 PM
OR BOOK: 639 PAGE: 282
LARGE PLAT ...86.40 . PG: 1


Envelope 598 A

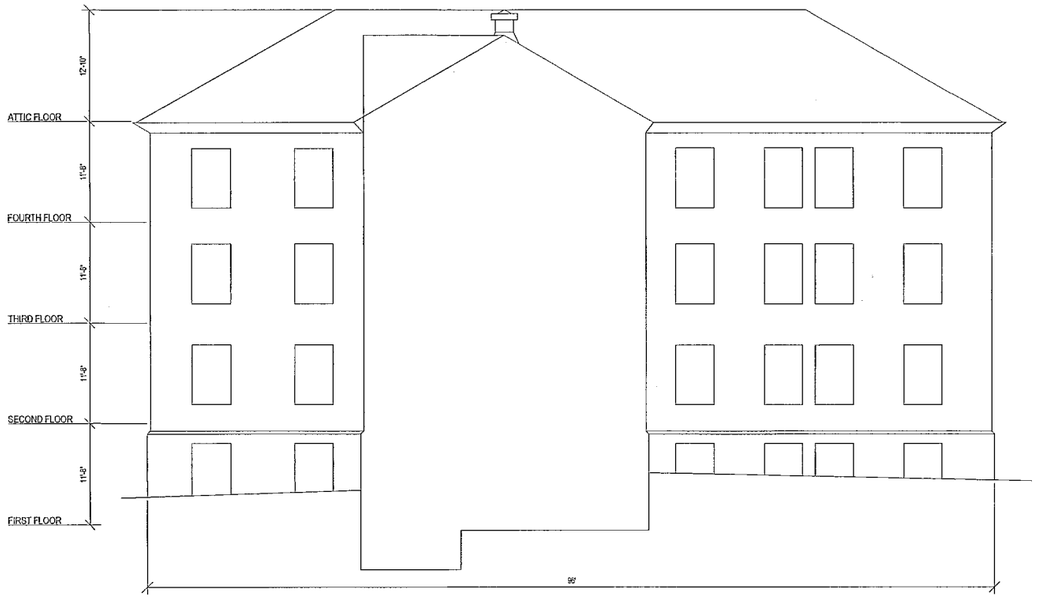


SCALE: $\frac{1}{8}$" = 1' 0" NORTH ELEVATION - RIDGES BUILDING #5 - UNIT 901

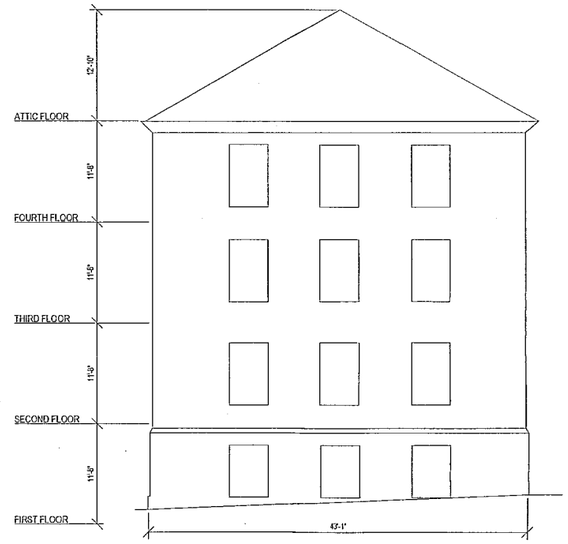

SCALE: $\frac{1}{8}$" = 1' 0" EAST ELEVATION - RIDGES BUILDING #5 - UNIT 901

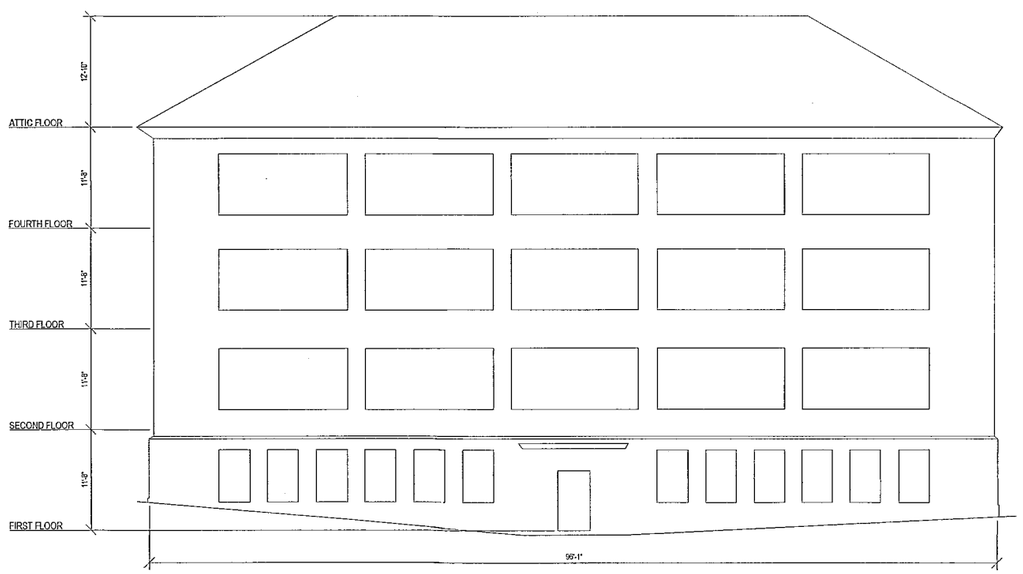

SCALE: $\frac{1}{8}$" = 1' 0" SOUTH ELEVATION - RIDGES BUILDING #5 - UNIT 901

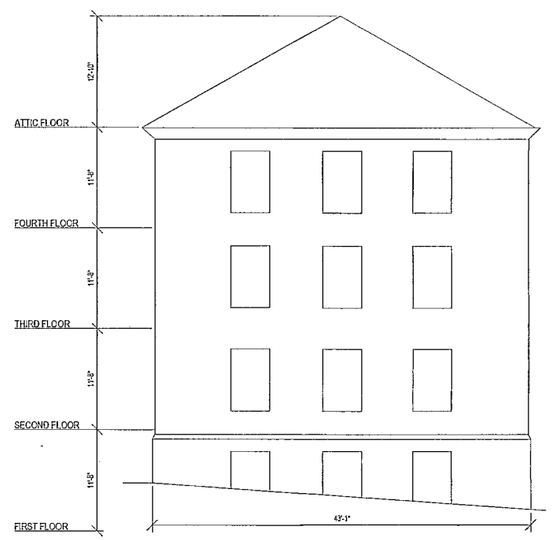

SCALE: $\frac{1}{8}$" = 1' 0" WEST ELEVATION - RIDGES BUILDING #5 - UNIT 901

NO.	DATE	BY	DESCRIPTION

237 NORTH MAIN STREET
FAX: 517.263.4535

PROJECT DATE: 08/12/2025
PROJECT NO.: 2500682
DRAWN BY: CDH
CHECKED BY: PW


Mannik Smith Group
www.MannikSmithGroup.com

PREPARED FOR:
OHIO UNIVERSITY
ATHENS, OHIO 45701

OHIO UNIVERSITY
RIDGES SURVEY
118 RIDGES CIRCLE,
ATHENS, OHIO 45701


RIDGES BUILDING
#5 ELEVATIONS

21 / 64

\\MSGFILESRV\MSGData\Projects\2025\600-799\2500682\CAD\SURV\2500682_ELEV.dwg - Last printed 4/6/2026 2:21 PM


202600004100
FILED FOR RECORD IN
ATHENS COUNTY, OHIO
JESSICA HARKINS, RECORDER
09/10/2026 02:30:33 PM
OR BOOK: 639 PAGE: 283

Envelope
5988

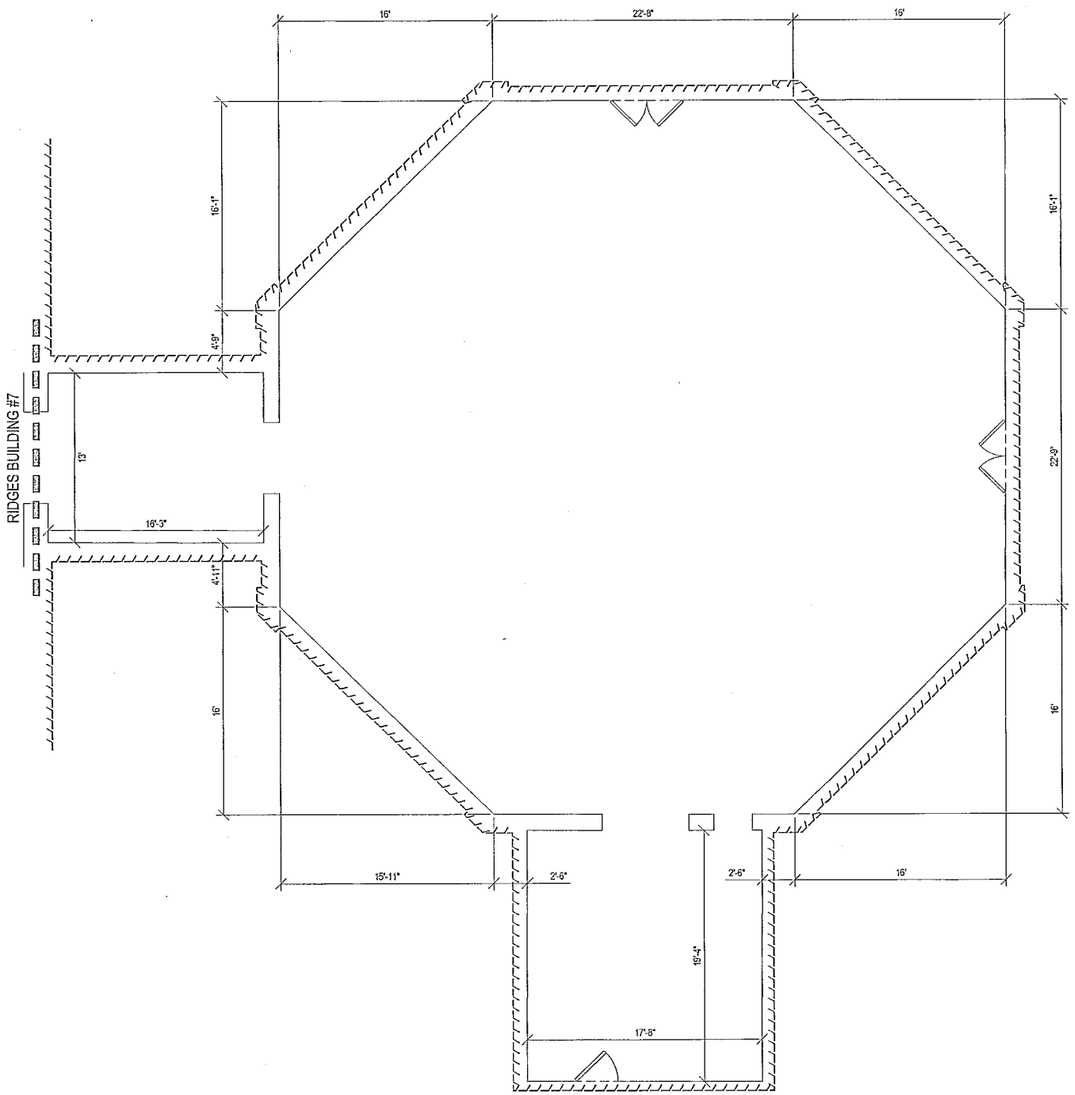

SCALE: $\frac{3}{16}$" = 1' 0"

FLOOR PLAN - RIDGES BUILDING #6 - UNIT 1001

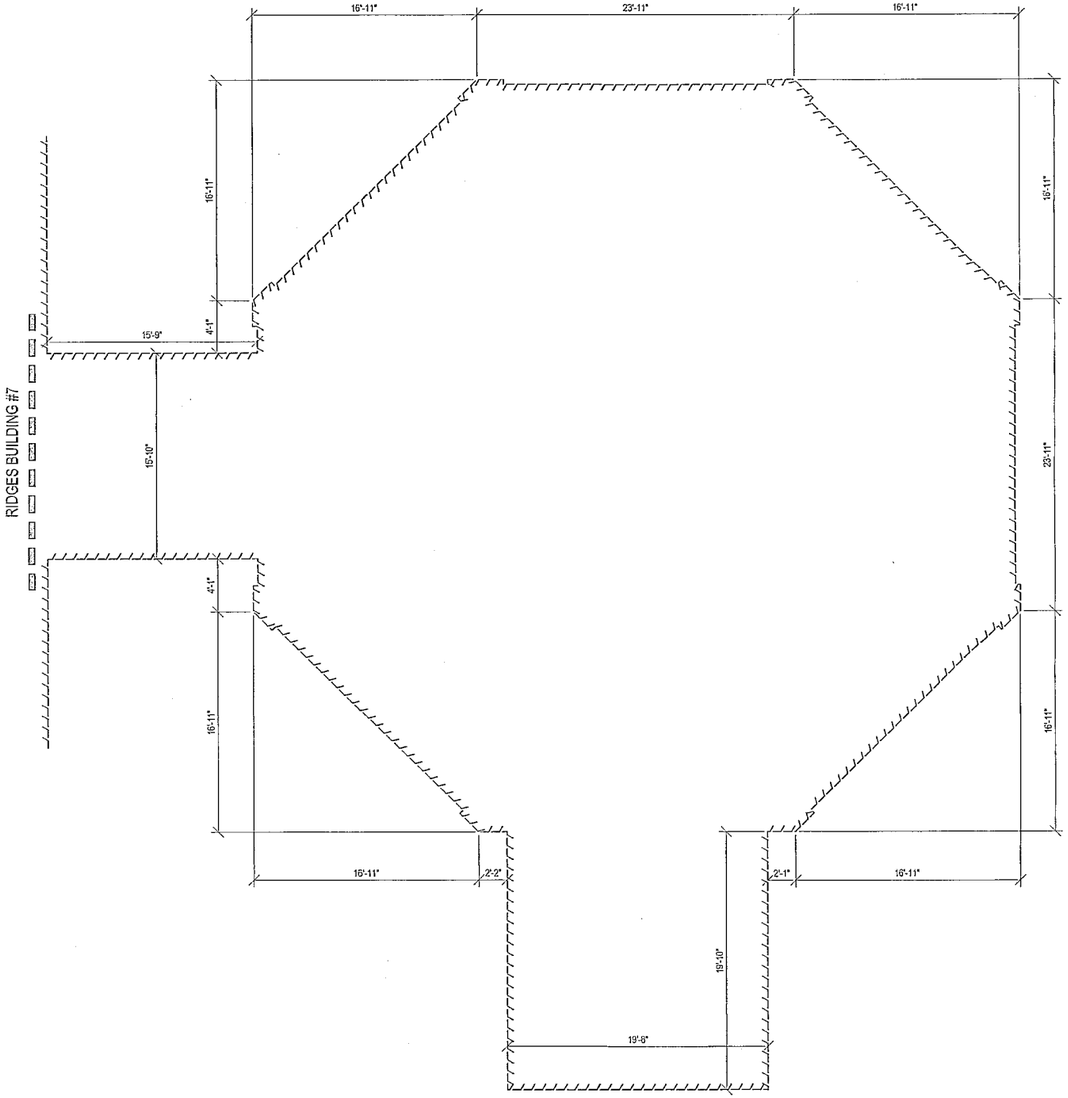

SCALE: $\frac{3}{16}$" = 1' 0"

BUILDING DIMENSIONS - RIDGES BUILDING #6 - UNIT 1001

\\MSGFILESRV\MSGDataProjects\2025\600-799\25000682\CAD\SURV\25000682_BLDG.dwg - Last printed 4/6/2026 2:21 PM

NO.	DATE	BY	DESCRIPTION

237 NORTH MAIN STREET
ADRIAN, MI 49221
TEL: 517.263.4515
FAX: 517.263.4535

PROJECT DATE: 09/12/2025
PROJECT NO.: 25000682
DRAWN BY: CDH
CHECKED BY: PW

Mannik Smith Group
TECHNICAL SKILL. CREATIVE SPIRIT.
www.MannikSmithGroup.com

PREPARED FOR:
OHIO UNIVERSITY
ATHENS, OHIO 45701


OHIO UNIVERSITY
RIDGES SURVEY
118 RIDGES CIRCLE,
ATHENS, OHIO 45701

RIDGES BUILDING #6
FLOOR PLAN &
BUILDING DIMENSIONS

22 / 64


202600004101
FILED FOR RECORD IN
ATHENS COUNTY, OHIO
JESSICA MARKING, RECORDER
09/10/2026 02:30:34 PM
OR BOOK: 639 PAGE: 284
LARGE PLAT PG: 1

599 A

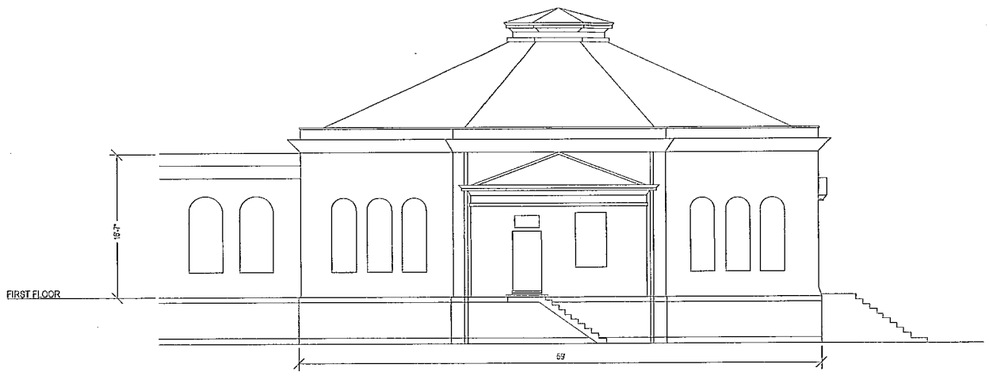


SCALE: $\frac{1}{8}$" = 1' 0"

NORTH ELEVATION - RIDGES BUILDING #6 - UNIT 1001

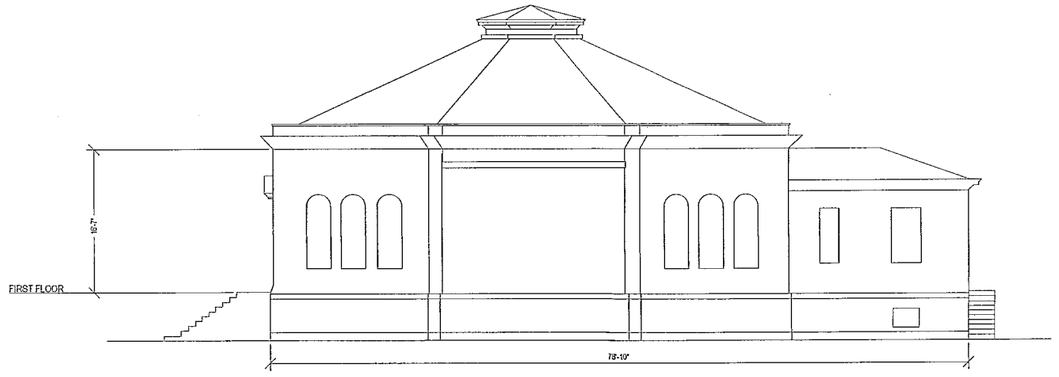


SCALE: $\frac{1}{8}$" = 1' 0"

EAST ELEVATION - RIDGES BUILDING #6 - UNIT 1001

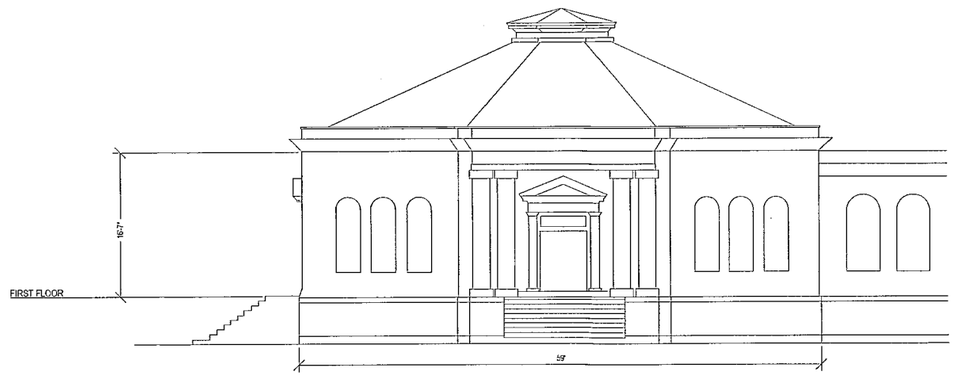

SCALE: $\frac{1}{8}$" = 1' 0"

SOUTH ELEVATION - RIDGES BUILDING #6 - UNIT 1001

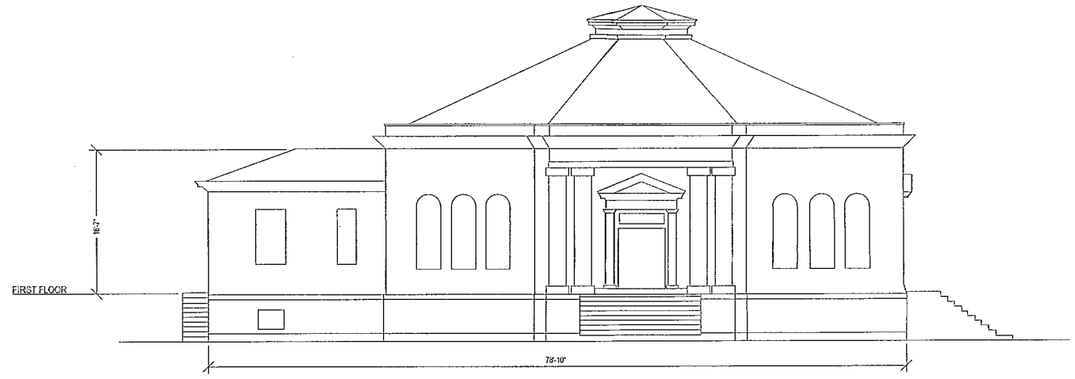

SCALE: $\frac{1}{8}$" = 1' 0"

WEST ELEVATION - RIDGES BUILDING #6 - UNIT 1001

NO.	DATE	BY	DESCRIPTION

237 NORTH MAIN STREET
TEL: 517.263.4515
FAX: 517.263.4535

PROJECT DATE: 09/12/2025
PROJECT NO.: 2500682
DRAWN BY: CDH
CHECKED BY: PW

TECHNICAL SKILL. CREATIVE SPIRIT.

Mannik Smith Group

www.MannikSmithGroup.com

PREPARED FOR:
OHIO UNIVERSITY
ATHENS, OHIO 45701


OHIO UNIVERSITY
RIDGES SURVEY
118 RIDGES CIRCLE,
ATHENS, OHIO 45701

RIDGES BUILDING
#6 ELEVATIONS


23 / 64

\\MSGFILESRV\MSGData\Projects\2025\600-799\2500682\CAD\SURV\2500682_ELEV.dwg - Last printed 4/6/2026 2:21 PM


202600004102
FILED FOR RECORD IN
ATHENS COUNTY, OHIO
JESSICA WARKINS, RECORDER
09/10/2026 02:10:35 PM
OR BOOK: 639 PAGE: 285
LARGE PLAT 24-40 PG-1
Envelope 5996

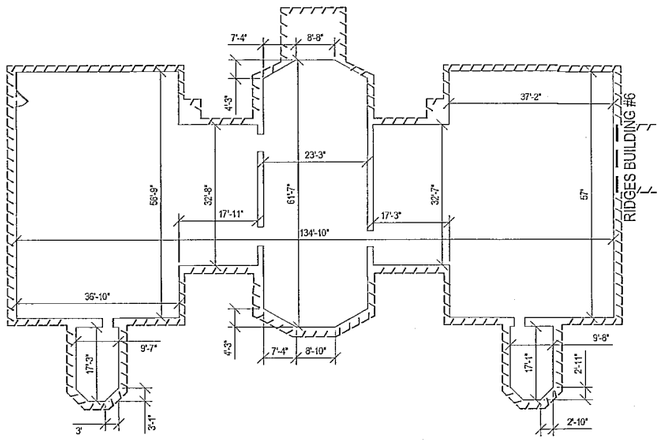


SCALE: $\frac{1}{16}$" = 1' 0" GROUND FLOOR PLAN - RIDGES BUILDING #7 - UNIT 1101

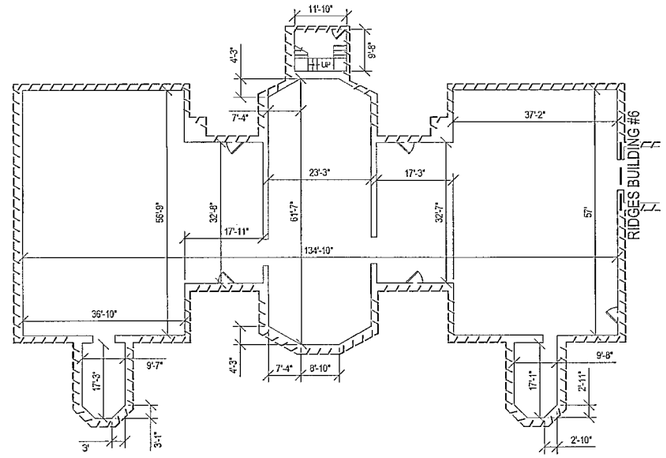


SCALE: $\frac{1}{16}$" = 1' 0" FIRST FLOOR PLAN - RIDGES BUILDING #7 - UNIT 1101

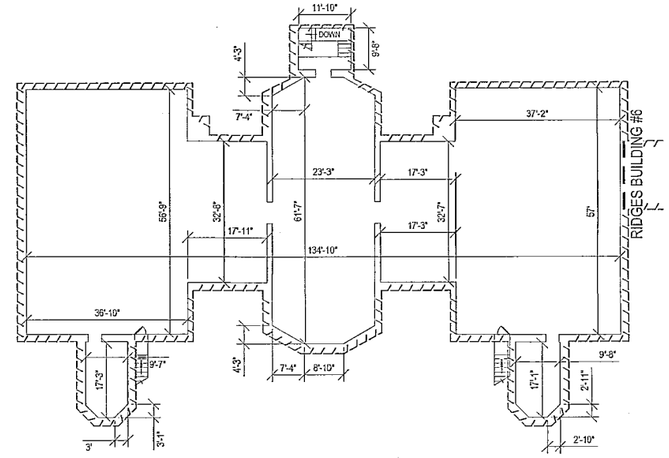

SCALE: $\frac{1}{16}$" = 1' 0" SECOND FLOOR PLAN - RIDGES BUILDING #7 - UNIT 1101

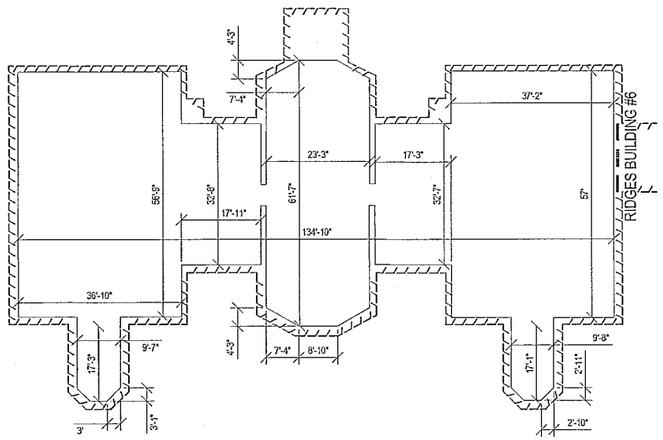

SCALE: $\frac{1}{16}$" = 1' 0" ATTIC FLOOR PLAN - RIDGES BUILDING #7 - UNIT 1101

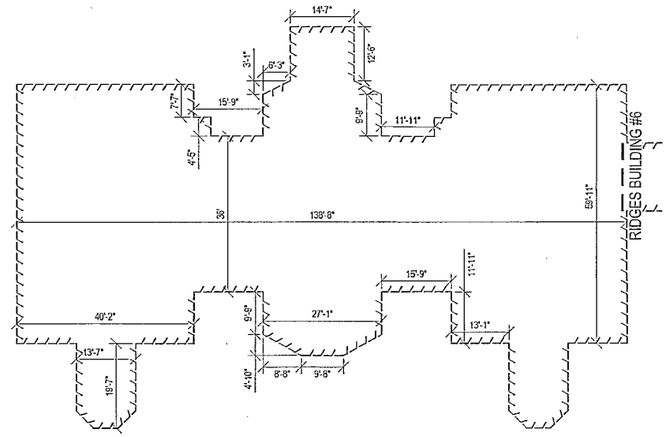

SCALE: $\frac{1}{16}$" = 1' 0" BUILDING DIMENSIONS - RIDGES BUILDING #7 - UNIT 1101

237 NORTH MAIN STREET

NO.	DESCRIPTION	DATE	BY

PROJECT DATE: 09/12/2025
PROJECT NO.: 2500682
DRAWN BY: CDH
CHECKED BY: PW

Mannik Smith Group
www.MannikSmithGroup.com

PREPARED FOR:
OHIO UNIVERSITY
ATHENS, OHIO 45701

OHIO UNIVERSITY
RIDGES SURVEY
118 RIDGES CIRCLE,
ATHENS, OHIO 45701


RIDGES BUILDING #7
FLOOR PLAN &
BUILDING DIMENSIONS

24 / 64

\\MSGFILESRV\MSGData\Projects\2025\600-799\2500682\CAD\SURV\2500682_BLDG.dwg - Last printed 4/6/2026 2:21 PM


202600604103
FILED FOR RECORD IN
ATHENS COUNTY, OHIO
JESSICA HAWKINS, RECORDER
09/10/2026 02:30:36 PM
OR BOOK: 639 PAGE: 286

Envelope
600 A

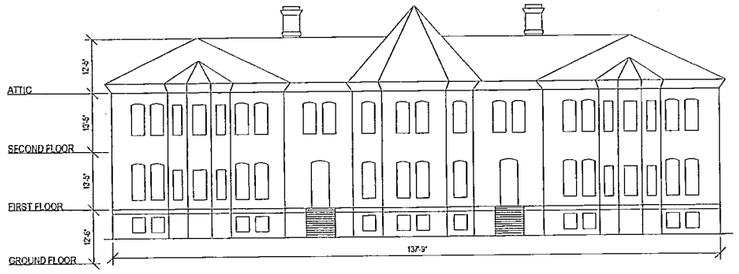

SCALE: $\frac{1}{16}$ = 1' 0"

NORTH ELEVATION - RIDGES BUILDING #7 - UNIT 1101

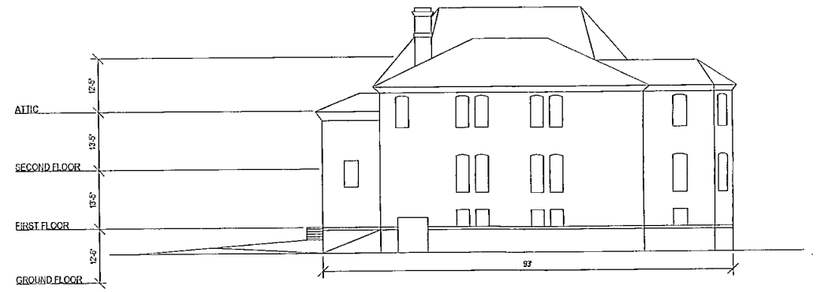


SCALE: $\frac{1}{16}$ = 1' 0"

EAST ELEVATION - RIDGES BUILDING #7 - UNIT 1101



SCALE: $\frac{1}{16}$ = 1' 0"

SOUTH ELEVATION - RIDGES BUILDING #7 - UNIT 1101

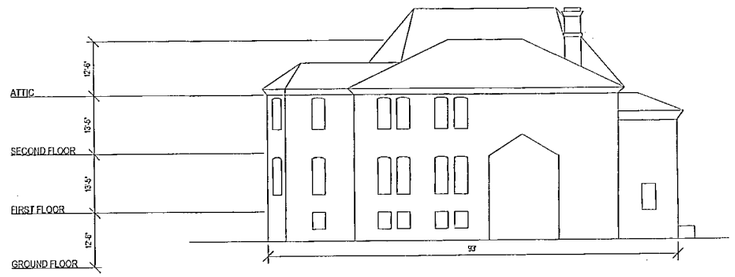

SCALE: $\frac{1}{16}$ = 1' 0"

WEST ELEVATION - RIDGES BUILDING #7 - UNIT 1101

NO.	DATE	BY	DESCRIPTION

237 NORTH MAIN STREET
ADRIAN, MI 49221
TEL: 517.263.4535
FAX: 517.263.4535

PROJECT DATE: 09/12/2025
PROJECT NO.: 2500582
DRAWN BY: CDH
CHECKED BY: PW

TECHNICAL SKILL
CREATIVE SPIRIT.

www.MannikSmithGroup.com

PREPARED FOR:
OHIO UNIVERSITY
ATHENS, OHIO 45701


OHIO UNIVERSITY
RIDGES SURVEY
118 RIDGES CIRCLE,
ATHENS, OHIO 45701

RIDGES BUILDING
#7 ELEVATIONS


25 / 64

\\MSGFILESRV\MSGData\Projects\2025\600-799\2500682\CAD\SURV\2500682_ELEV.dwg - Last printed 4/6/2026 2:22 PM


2026000004104
FILED FOR RECORD IN
ATHENS COUNTY, OHIO
JESSICA WATKINS, RECORDER
09/10/2026 02:30:37 PM
OR BOOK: 639 PAGE: 287
LARGE PLAT ... PG 40 ... PG 1

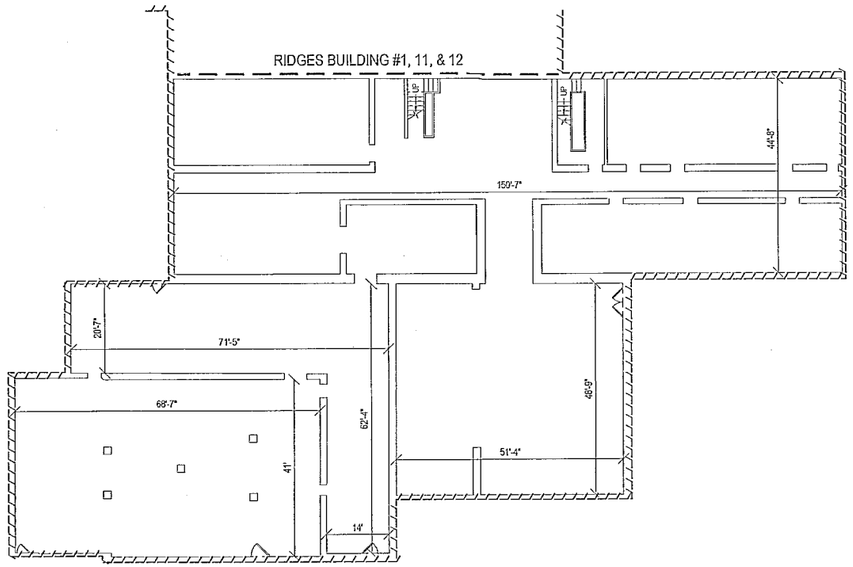


SCALE: $\frac{1}{16}$" = 1' 0" FIRST FLOOR PLAN - RIDGES BUILDING #8, 9, & 10 - UNIT 1201

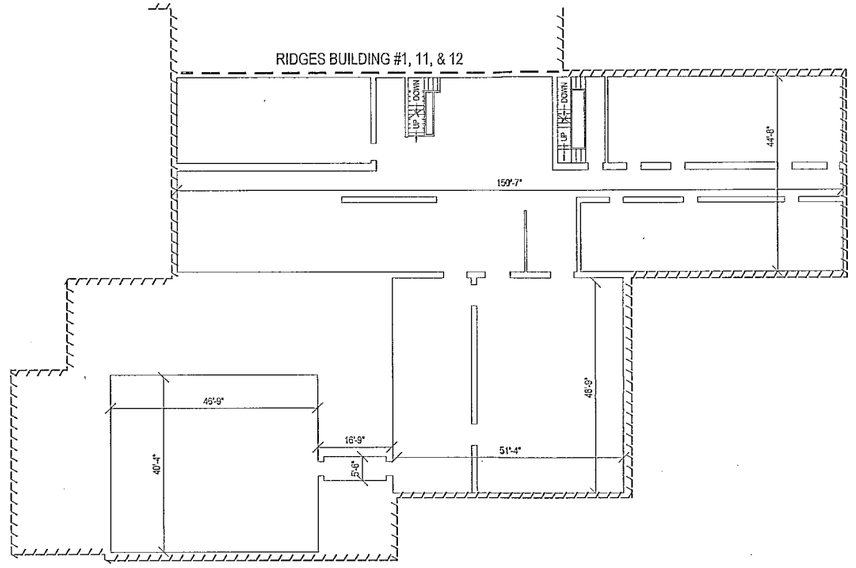

SCALE: $\frac{1}{16}$" = 1' 0" SECOND FLOOR PLAN - RIDGES BUILDING #8, 9, & 10 - UNIT 1201

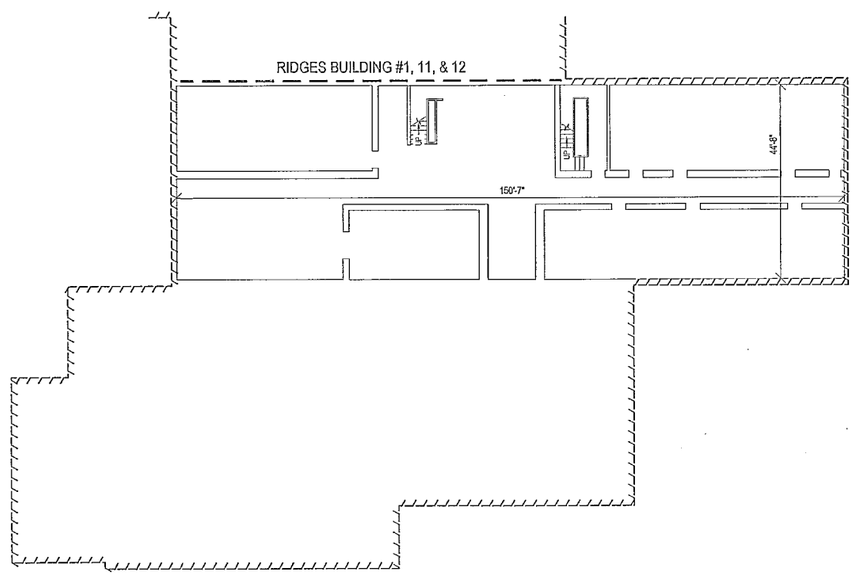

SCALE: $\frac{1}{16}$" = 1' 0" THIRD FLOOR PLAN - RIDGES BUILDING #8, 9, & 10 - UNIT 1201

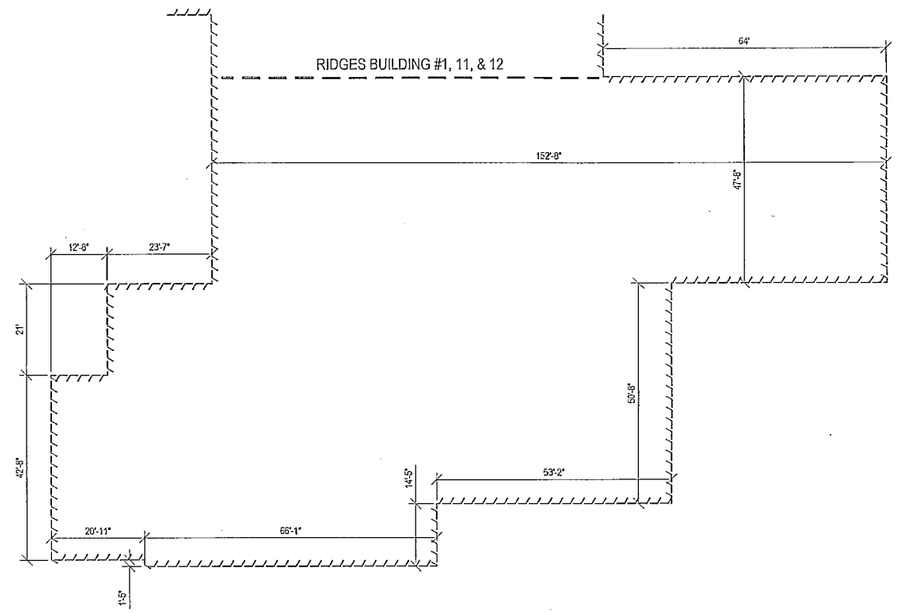

SCALE: $\frac{1}{16}$" = 1' 0" BUILDING DIMENSIONS - RIDGES BUILDING #8, 9, & 10 - UNIT 1201

NO.	DATE	BY	DESCRIPTION

237 NORTH MAIN STREET
ADRIAN, MI 49221
TEL: 517.263.4515
FAX: 517.263.4535

PROJECT DATE: 09/12/2025
PROJECT NO.: 2500682
DRAWN BY: CDH
CHECKED BY: PW


Mannik Smith group

www.MannikSmithGroup.com

PREPARED FOR:
OHIO UNIVERSITY
ATHENS, OHIO 45701

OHIO UNIVERSITY
RIDGES SURVEY
118 RIDGES CIRCLE,
ATHENS, OHIO 45701


RIDGES BUILDING #8, #9, & #10 FLOOR PLAN & BUILDING DIMENSIONS

26 / 64


\\MSGFILESRV\MSGDataIProjects\2025\6\00-7991\2500682\CAD\SURV\2500682_BLDG.dwg - Last printed 4/6/2026 2:22 PM

Exempt
601A


202600004105
FILED FOR RECORD IN
ATHENS COUNTY, OHIO
JESSICA HAWKINS, RECORDER
09/10/2026 02:30:19 PM
OR BOOK: 639 PAGE: 288
LARGE PLAT ... 86.40 ... RG: 1

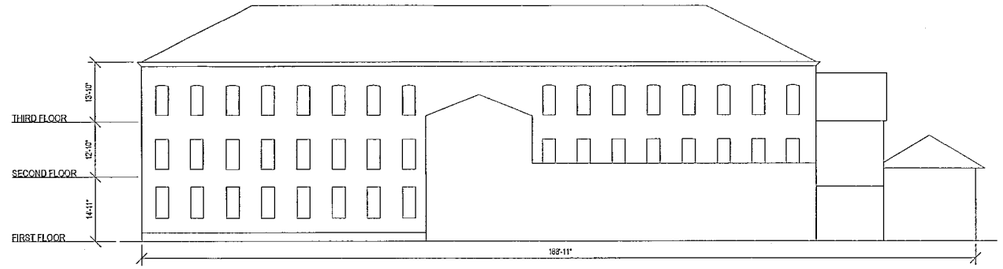


SCALE: $\frac{1}{16}$ = 1' 0" NORTH ELEVATION - RIDGES BUILDING #8, 9, & 10 - UNIT 1201

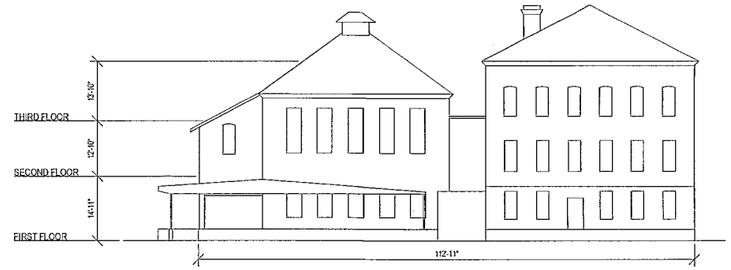

SCALE: $\frac{1}{16}$ = 1' 0" EAST ELEVATION - RIDGES BUILDING #8, 9, & 10 - UNIT 1201

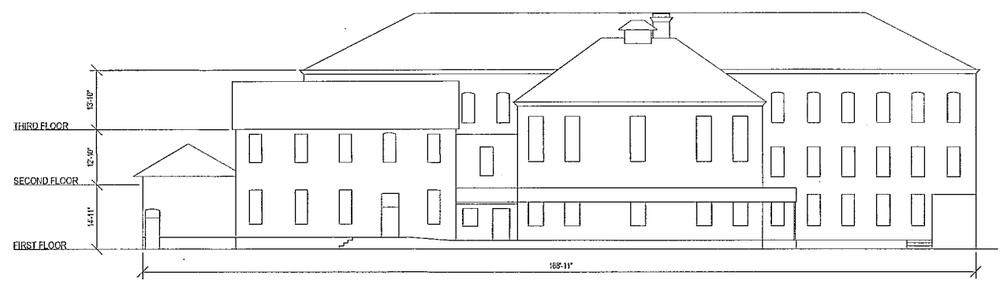

SCALE: $\frac{1}{16}$ = 1' 0" SOUTH ELEVATION - RIDGES BUILDING #8, 9, & 10 - UNIT 1201

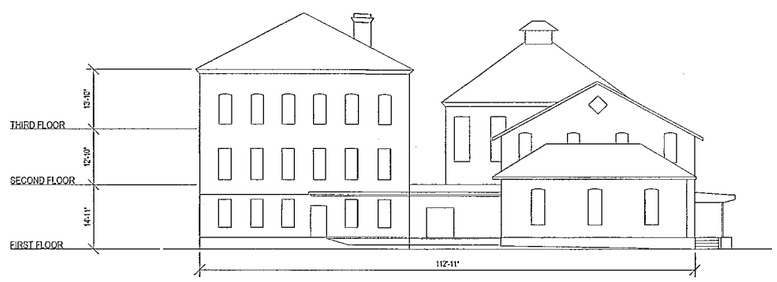

SCALE: $\frac{1}{16}$ = 1' 0" WEST ELEVATION - RIDGES BUILDING #8, 9, & 10 - UNIT 1201

237 NORTH MAIN STREET
ATHENS, OHIO 45701
TEL: 517.263.4515
FAX: 517.263.4535

NO.	DATE	BY	DESCRIPTION

PROJECT DATE: 09/12/2025
PROJECT NO.: 250682
DRAWN BY: CDH
CHECKED BY: PW

TECHNICAL SKILL. CREATIVE SPIRIT.

Mannik Smith Group

www.MannikSmithGroup.com

PREPARED FOR:
OHIO UNIVERSITY
ATHENS, OHIO 45701

OHIO UNIVERSITY
RIDGES SURVEY
118 RIDGES CIRCLE,
ATHENS, OHIO 45701


RIDGES BUILDING
#8, 9, & 10
ELEVATIONS

27 / 64

\\MSGFILESRV\MSGData\Projects\2025\600-799\250682\CAD\SURV\250682_ELEV.dwg - Last printed 4/6/2026 2:22 PM

202600004106
FILED FOR RECORD IN
ATHENS COUNTY, OHIO
JESSICA MARKINS, RECORDER
09/10/2026 02:30:39 PM
OR BOOK: 639 PAGE: 289
LARGE PLAT $6.40 PG: 1

Survey 601 B

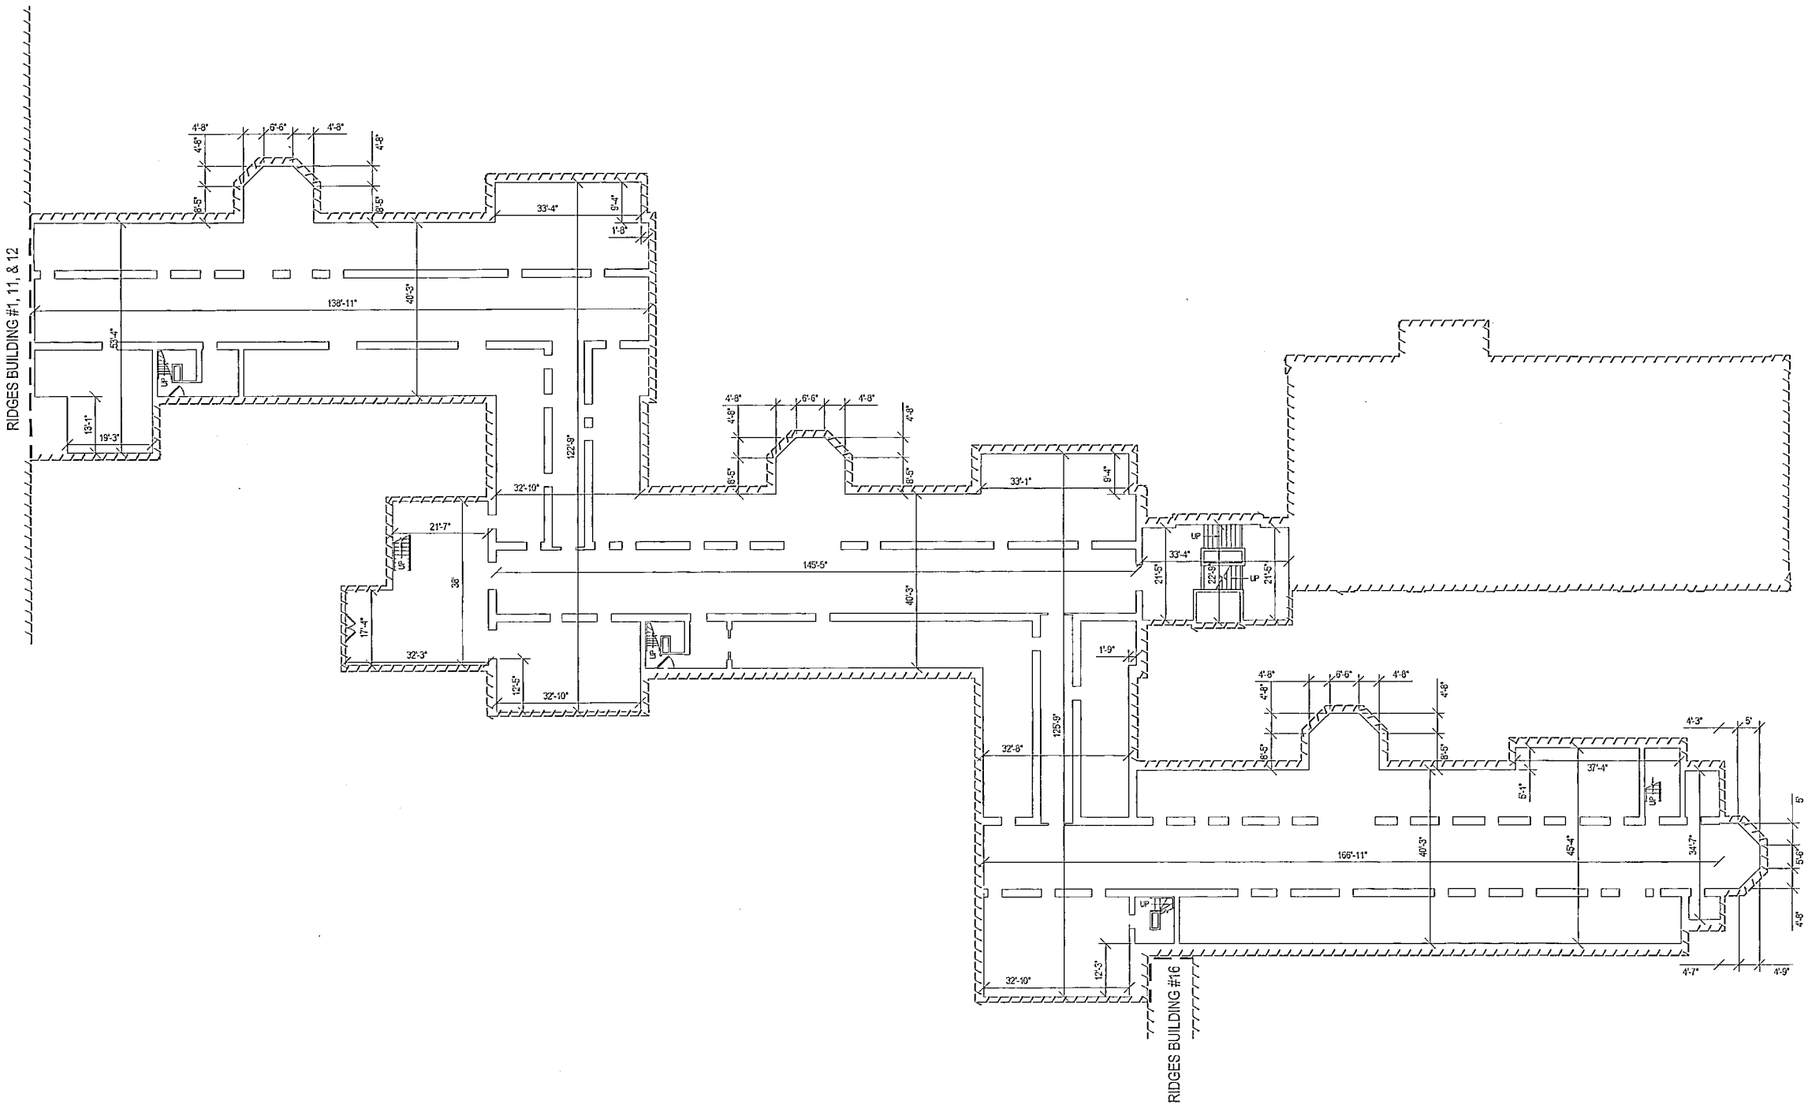

SCALE: $\frac{1}{16}$" = 1' 0"

BASEMENT FLOOR PLAN - RIDGES BUILDING #13, 14, 18, & 19 - UNIT 1301

NO.	DATE	BY	DESCRIPTION

237 NORTH MAIN STREET
ADRIAN, MI 49221
TEL: 517.263.4535
FAX: 517.263.4535

PROJECT DATE: 09/12/2025
PROJECT NO.: 2500682
DRAWN BY: CDH
CHECKED BY: PW

TECHNICAL SKILL
CREATIVE SPIRIT.

Mannik Smith Group

www.MannikSmithGroup.com

PREPARED FOR:
OHIO UNIVERSITY
ATHENS, OHIO 45701

OHIO UNIVERSITY
RIDGES SURVEY
118 RIDGES CIRCLE,
ATHENS, OHIO 45701


RIDGES BUILDING #13, 14, 18, & 19 FLOOR PLAN

28 / 64

W:\SGFILESRV\MSGData\Projects\2025\600-799\2500682\CAD\SURV\2500682_BLDG.dwg - Last printed 4/6/2026 2:22 PM

202600004107
FILED FOR RECORD IN
ATHENS COUNTY, OHIO
JESSICA MARKINS, RECORDER
09/10/2026 02:30:40 PM
OR BOOK: 639 PAGE: 290
LARGE PLAT 86.40 PG: 1

Envelope 602A

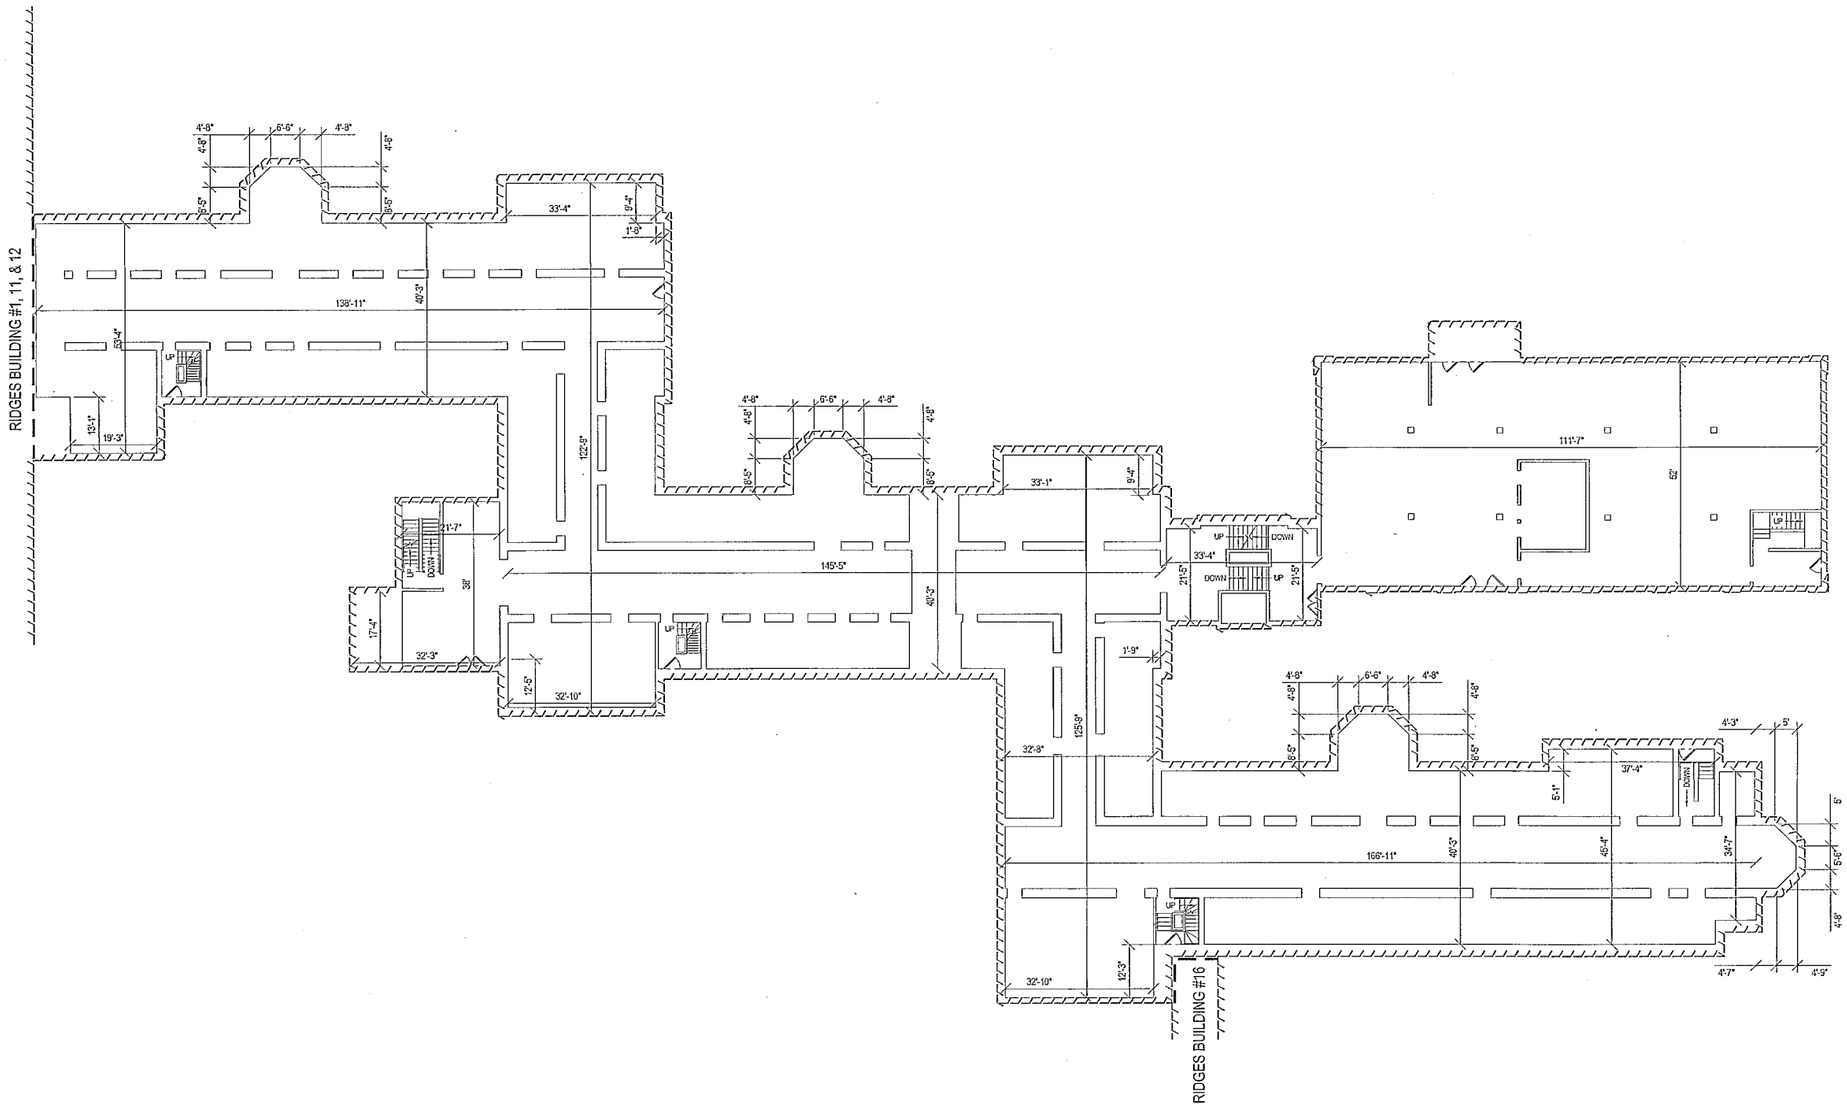

SCALE: $\frac{1}{16}$" = 1' 0"

FIRST FLOOR PLAN - RIDGES BUILDING #13, 14, 18, & 19 - UNIT 1301

NO.	DATE	BY	DESCRIPTION

237 NORTH MAIN STREET
ADRIAN, MI 49221
TEL: 517.263.4545
FAX: 517.263.4535

PROJECT DATE: 09/12/2025
PROJECT NO: 2500682
DRAWN BY: CDH
CHECKED BY: PW

Mannik Smith Group
www.MannikSmithGroup.com

PREPARED FOR:
OHIO UNIVERSITY
ATHENS, OHIO 45701

OHIO UNIVERSITY
RIDGES SURVEY
118 RIDGES CIRCLE,
ATHENS, OHIO 45701


RIDGES BUILDING #13, 14, 18, & 19 FLOOR PLAN

29 / 64

\\MSGFILESRV\MSGData\Projects\2025\600-799\2500682\CAD\SURV\2500682_BLDG.dwg - Last printed 4/6/2026 2:22 PM

202600004108
FILED FOR RECORD IN
ATHENS COUNTY, OHIO
JESSICA HAWKINS, RECORDER
09/10/2026 02:30:41 PM
OR BOOK: 639 PAGE: 291
LARGE FLAT 24.40 PGS: 1

Envelope 602 B

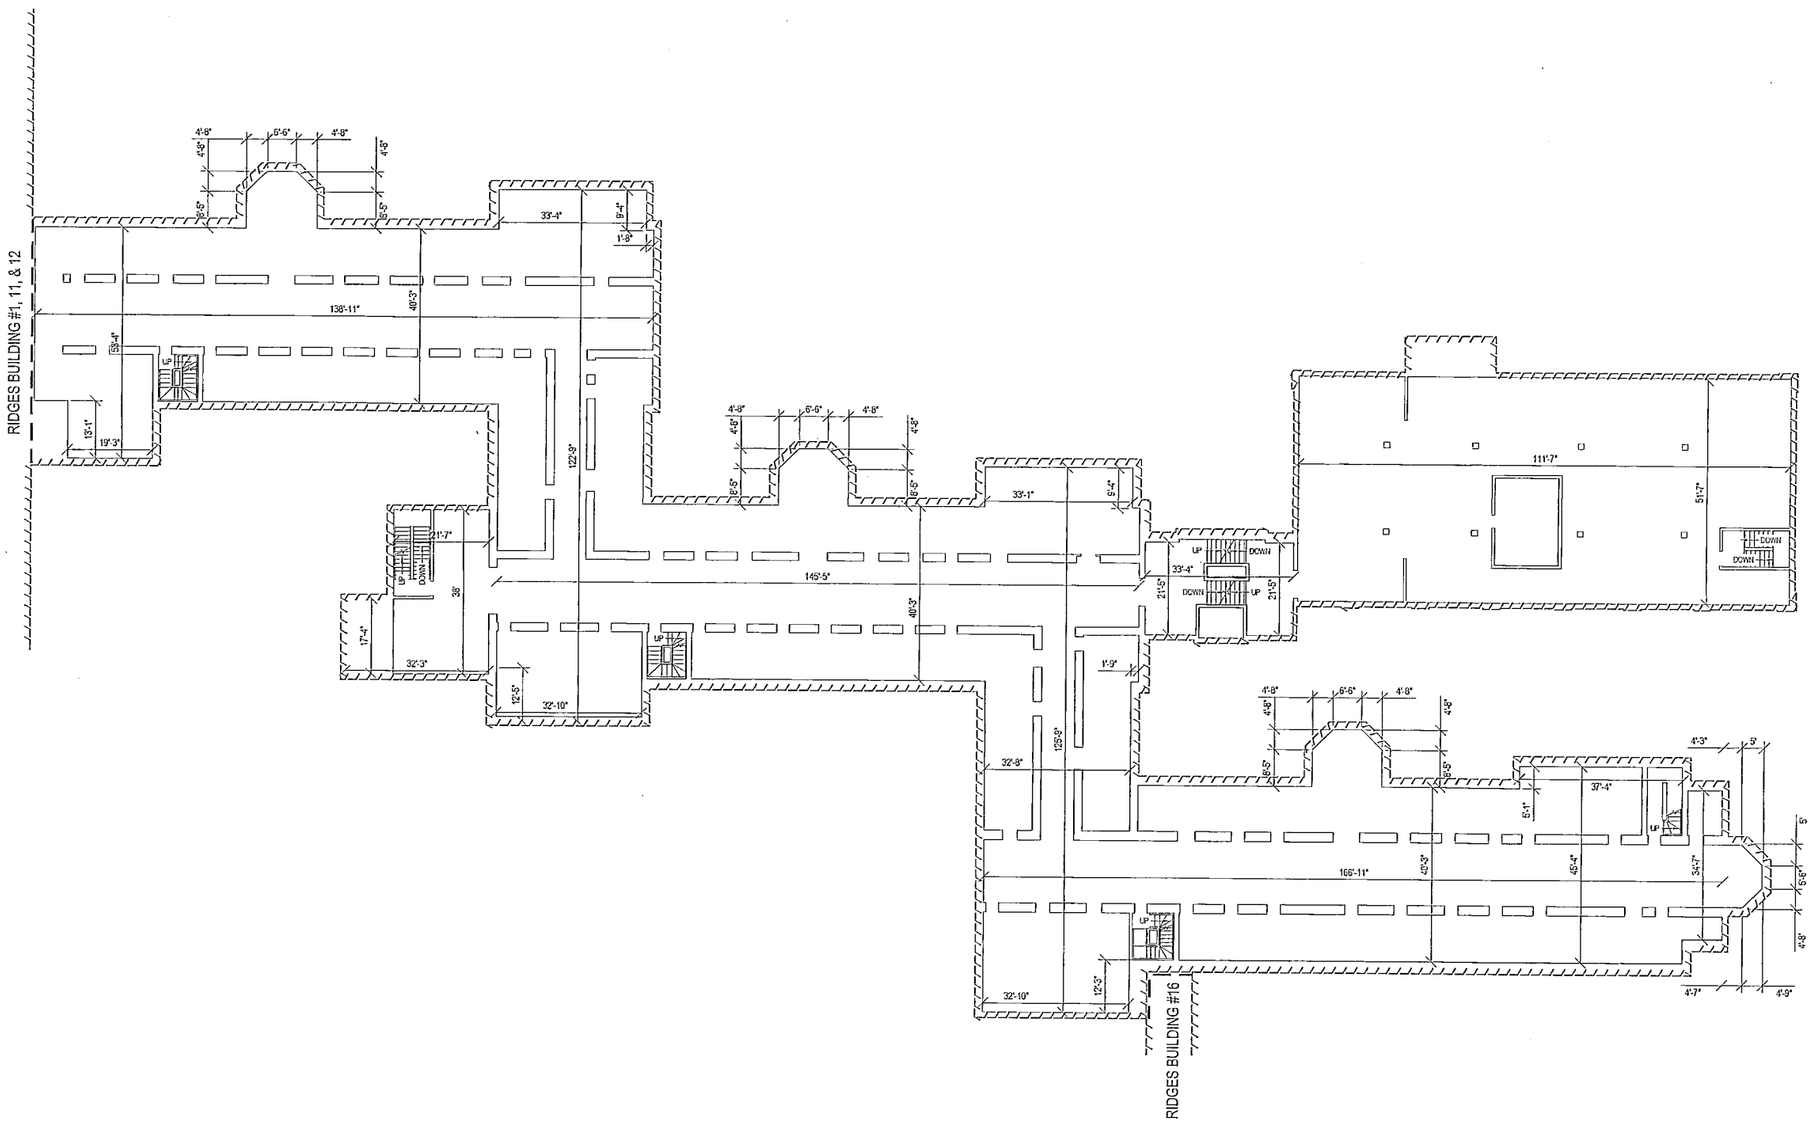

SCALE: $\frac{1}{16}$" = 1' 0"

SECOND FLOOR PLAN - RIDGES BUILDING #13, 14, 18, & 19 - UNIT 1301

\\MSGFILESRV\MSGData\Projects\2025\600-799\2500682\CAD\SURV\2500682_BLDG.dwg - Last printed 4/6/2026 2:22 PM

NO.	DATE	BY	DESCRIPTION

237 NORTH MAIN STREET
ADRIAN, MI 49221
TEL: 517.263.4515
FAX: 517.263.4535

PROJECT DATE: 09/12/2025
PROJECT NO.: 2500682
DRAWN BY: CDH
CHECKED BY: PW

Manik Smith Group
www.ManikSmithGroup.com

PREPARED FOR:
OHIO UNIVERSITY
ATHENS, OHIO 45701


OHIO UNIVERSITY
RIDGES SURVEY
118 RIDGES CIRCLE,
ATHENS, OHIO 45701

RIDGES BUILDING #13, 14, 18, & 19 FLOOR PLAN

30 / 64

2026000411 09
FILED FOR RECORD IN
ATHENS COUNTY, OHIO
JESSICA HARKINS, RECORDER
03/10/2026 02:30:42 PM
OR BOOK: 639 PAGE: 292
LARGE PLAT 84.40 PG: 1

Envelope
603 A

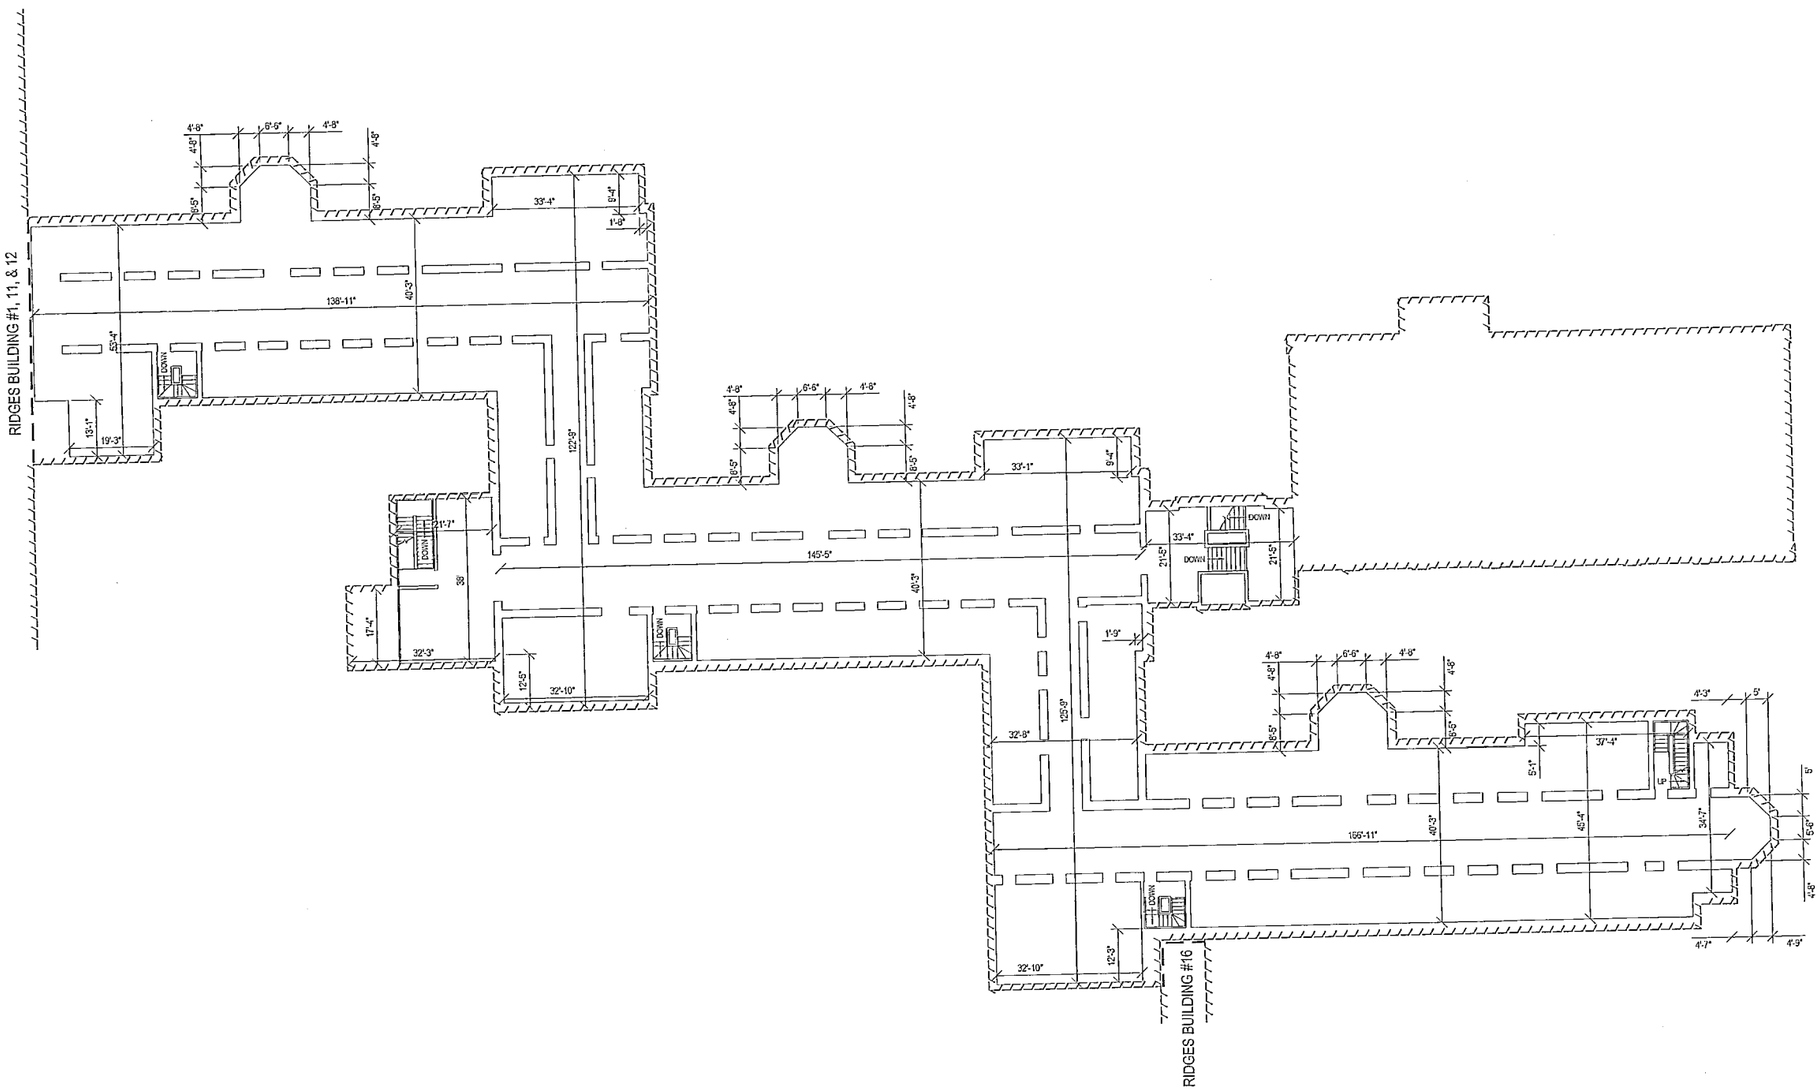

SCALE: $\frac{1}{16}$" = 1' 0"

THIRD FLOOR PLAN - RIDGES BUILDING #13, 14, 18, & 19 - UNIT 1301

NO.	DATE	BY	DESCRIPTION

237 NORTH MAIN STREET
ADRIAN, MI 49221
TEL: 517.264.4515
FAX: 517.263.4535

PROJECT DATE: 09/12/2025
PROJECT NO.: 2500682
DRAWN BY: CDR
CHECKED BY: PWI

Mannik Smith Group
TECHNICAL SKILL. CREATIVE SPIRIT.
www.MannikSmithGroup.com

PREPARED FOR:
OHIO UNIVERSITY

OHIO UNIVERSITY
RIDGES SURVEY
118 RIDGES CIRCLE,
ATHENS, OHIO 45701


RIDGES BUILDING #13, 14, 18, & 19 FLOOR PLAN

31 / 64

\\MSGFILESRV\MSGData\Projects\2025\600-799\2500682\CAD\SURV\2500682_BLDG.dwg - Last printed 4/6/2026 2:22 PM

202600004110
FILED FOR RECORD IN
ATHENS COUNTY, OHIO
JESSICA MARKINS, RECORDER
02/10/2026 02:30:43 PM
OR BOOK: 639 PAGE: 293

Envelope 603 B

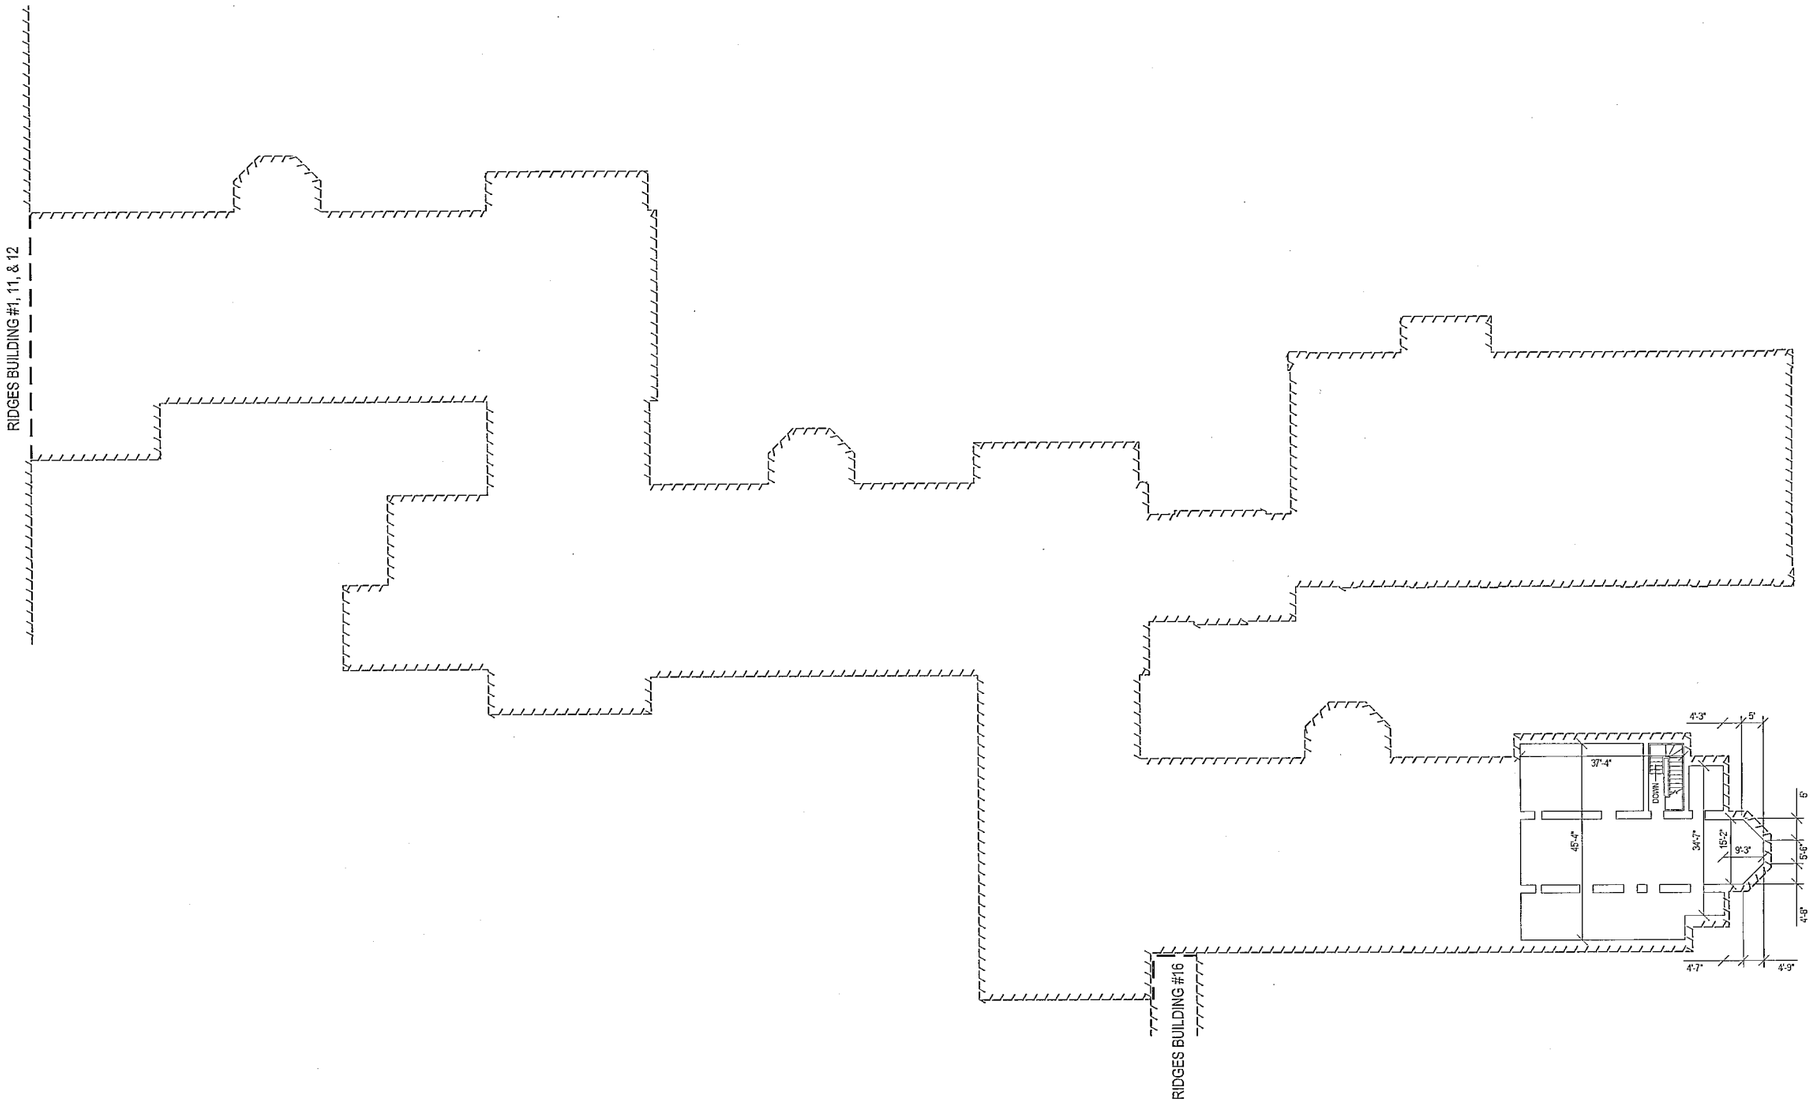

SCALE: $\frac{1}{16}$" = 1' 0"

FOURTH FLOOR PLAN - RIDGES BUILDING #13, 14, 18, & 19 - UNIT 1301

\\MSGFILESRV\MSGData\Projects\2025\600-799\2500682\CAD\SURV\2500682_BLDG.dwg - Last printed 4/9/2026 2:22 PM

NO.	DATE	BY	DESCRIPTION

237 NORTH MAIN STREET
ADRIAN, MI 49221
TEL: 517.263.4116
FAX: 517.263.4555

PROJECT DATE: 08/12/2025
PROJECT NO.: 2500682
DRAWN BY: CDH
CHECKED BY: PW

Manik smith group
TECHNICAL SKILL. CREATIVE SPIRIT.
www.ManikSmithGroup.com


PREPARED FOR:
OHIO UNIVERSITY
ATHENS, OHIO 45701

OHIO UNIVERSITY
RIDGES SURVEY
118 RIDGES CIRCLE,
ATHENS, OHIO 45701

RIDGES BUILDING #13, 14, 18, & 19 FLOOR PLAN

202600004111
FILED FOR RECORD III
ATHENS COUNTY, OHIO
JESSICA MARKINS, RECORDER
03/10/2026 02:30:44 PM
OR BOOK: 639 PAGE: 294
LARGE PLAT ... 24.40 ... PG: 4

Envelope 6094

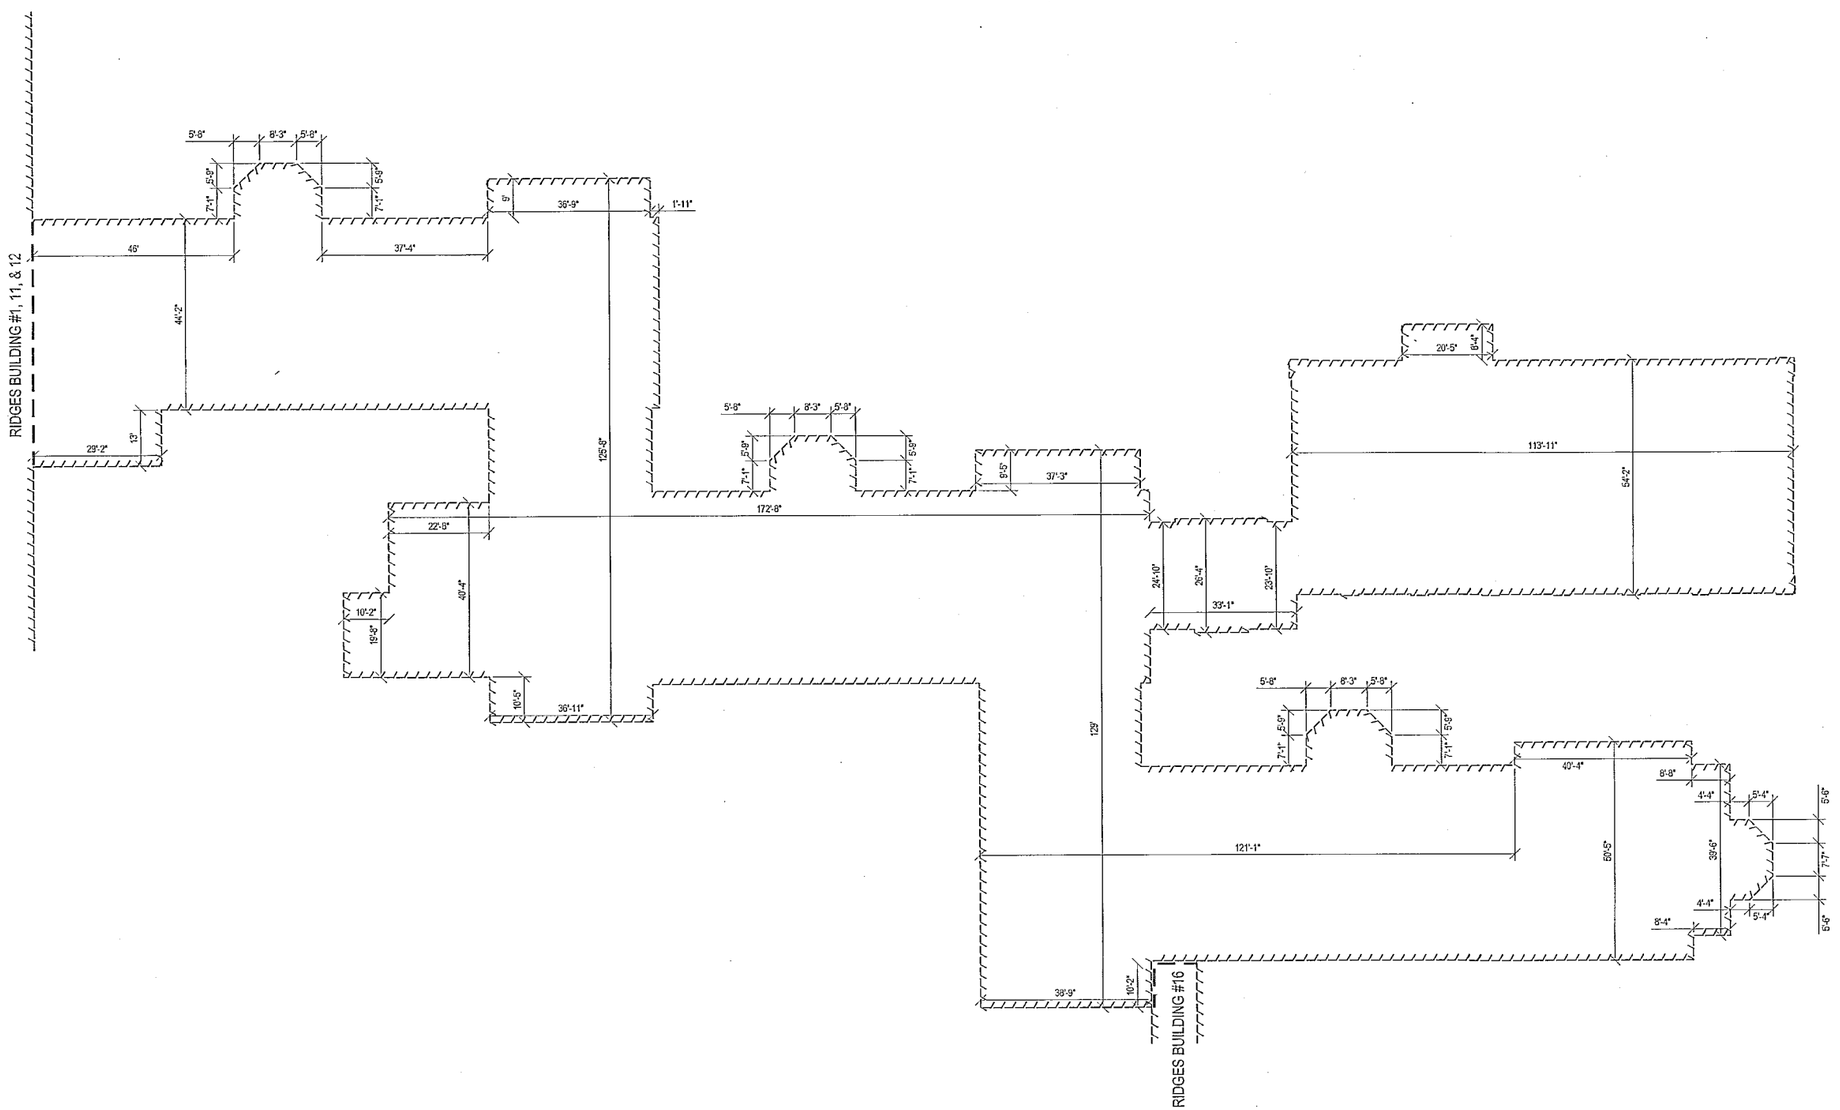

SCALE: $\frac{1}{16}$" = 1' 0"

BUILDING DIMENSIONS - RIDGES BUILDING #13, 14, 18, & 19 - UNIT 1301

NO.	DATE	BY	DESCRIPTION

237 NORTH MAIN STREET
ADRIAN, MI 49221
TEL: 517.263.4535
FAX: 517.263.4535

PROJECT DATE: 09/12/2025
PROJECT NO.: 2500682
DRAWN BY: CDH
CHECKED BY: PW

Mannik Smith Group
TECHNICAL SKILL. CREATIVE SPIRIT.
www.MannikSmithGroup.com

PREPARED FOR:
OHIO UNIVERSITY
ATHENS, OHIO 45701


OHIO UNIVERSITY
RIDGES SURVEY
118 RIDGES CIRCLE,
ATHENS, OHIO 45701

RIDGES BUILDING #13, 14, 18, & 19 BUILDING DIMENSIONS

33 / 64


\\MSGFILESRV\MSGData\Projects\2025\600-799\2500682\CAD\SURV\2500682_BLDG.dwg - Last printed 4/6/2026 2:22 PM

2026000004112
FILED FOR RECORD IN
ATHENS COUNTY, OHIO
JESSICA MARKINS, RECORDER
09/10/2026 02:30:45 PM
OR BOOK: 639 PAGE: 295
Envelope 604 B

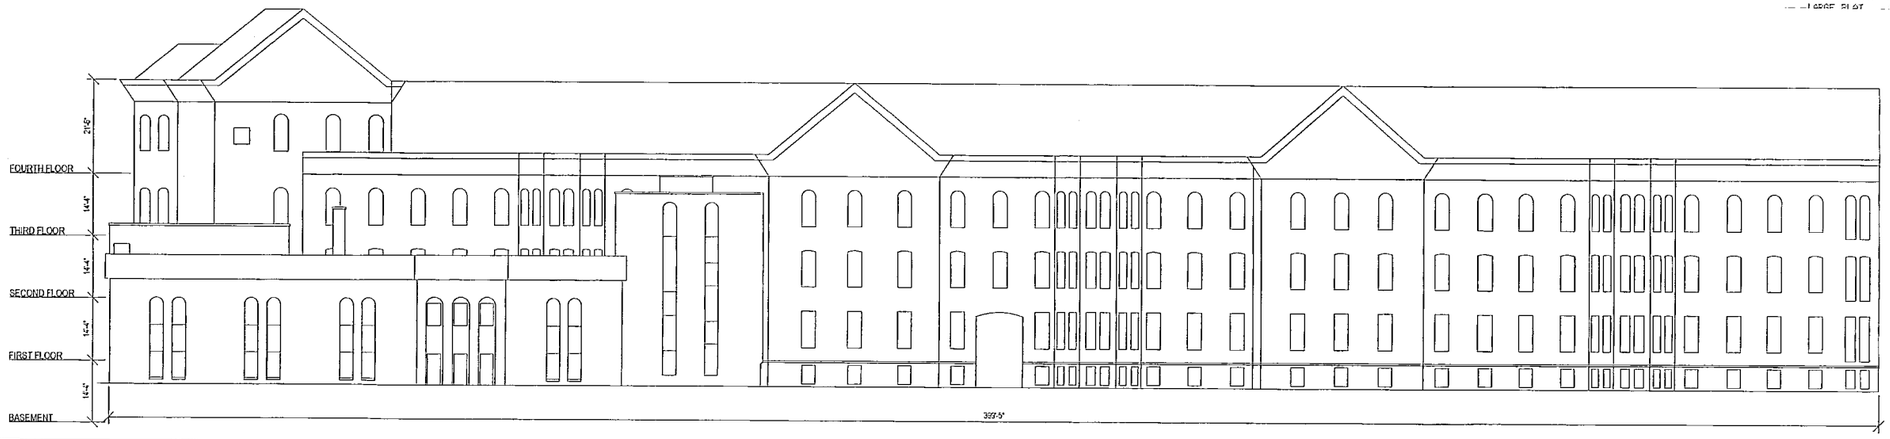

SCALE: $\frac{1}{16}$ = 1' 0"

NORTH ELEVATION - RIDGES BUILDING #13, 14, 18, & 19 - UNIT 1301

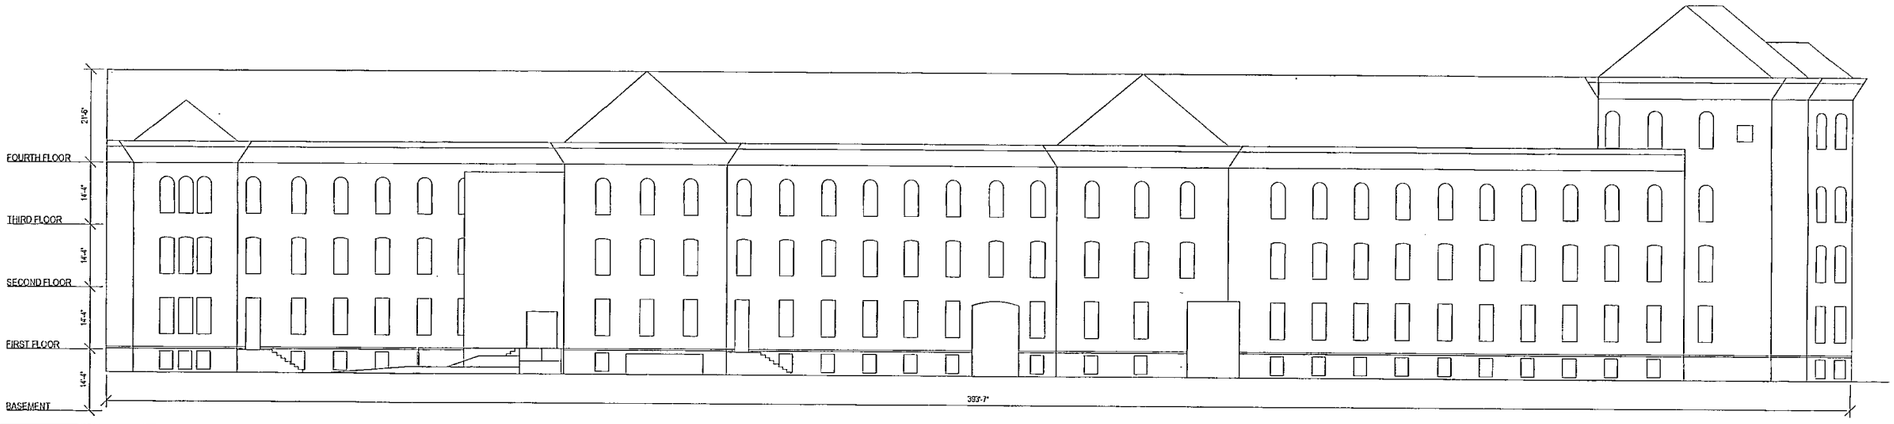


SCALE: $\frac{1}{16}$ = 1' 0"

SOUTH ELEVATION - RIDGES BUILDING #13, 14, 18, & 19 - UNIT 1301



SCALE: $\frac{1}{16}$ = 1' 0"

EAST ELEVATION - RIDGES BUILDING #13, 14, 18, & 19 - UNIT 1301

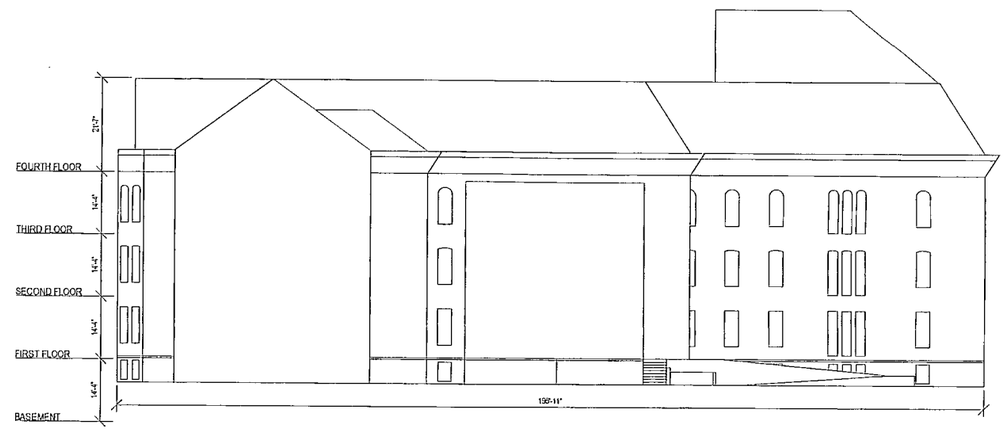

SCALE: $\frac{1}{16}$ = 1' 0"

WEST ELEVATION - RIDGES BUILDING #13, 14, 18, & 19 - UNIT 1301

NO.	DATE	BY	DESCRIPTION

237 NORTH MAIN STREET
ADRIAN, MI 49221
TEL: 517.263.4515
FAX: 517.263.4535

PROJECT DATE: 08/12/2025
PROJECT NO.: 2600682
DRAWN BY: CDH
CHECKED BY: PW

Mannik Smith Group
TECHNICAL SKILL. CREATIVE SPIRIT.
www.MannikSmithGroup.com


PREPARED FOR:
OHIO UNIVERSITY
ATHENS, OHIO 45701

OHIO UNIVERSITY
RIDGES SURVEY
118 RIDGES CIRCLE,
ATHENS, OHIO 45701

RIDGES BUILDING
#13, 14, 18, & 19
ELEVATIONS


34 / 64

\\MSGFILESRV\MSGData\Projects\2025\600-799\2600682\CAD\SURV\2600682_ELEV.dwg - Last printed 4/6/2026 2:22 PM

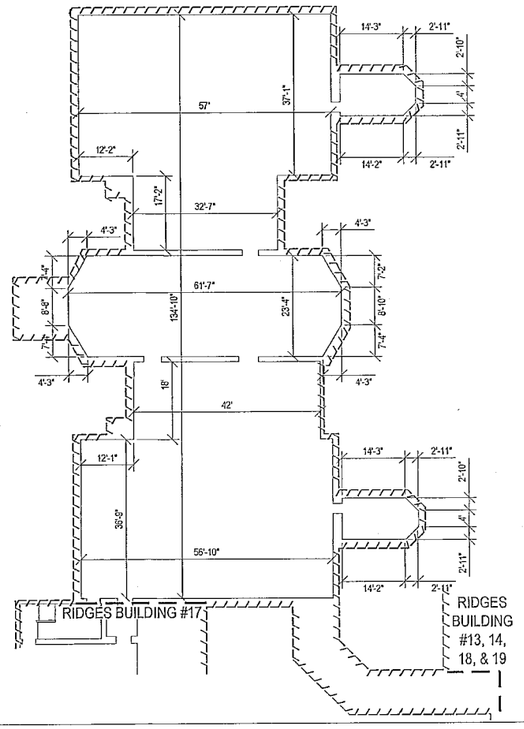


SCALE: $\frac{1}{16}$" = 1' 0"

GROUND FLOOR PLAN - RIDGES BUILDING #16 - UNIT 1401

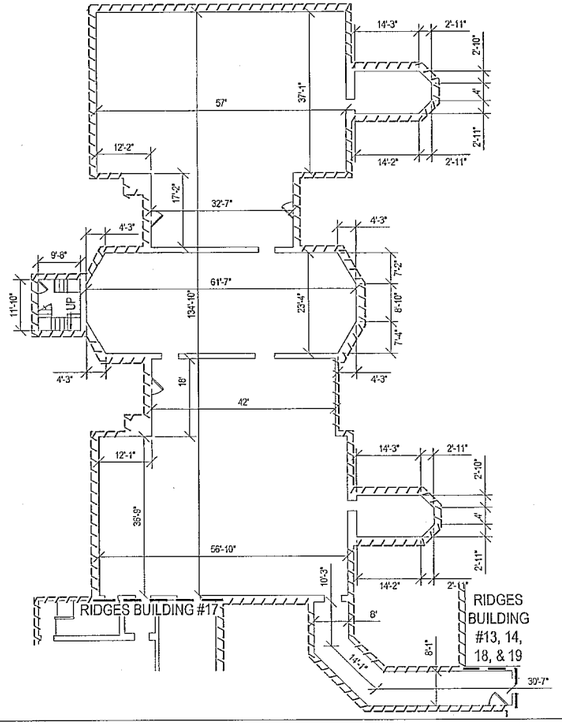


SCALE: $\frac{1}{16}$" = 1' 0"

FIRST FLOOR PLAN - RIDGES BUILDING #16 - UNIT 1401

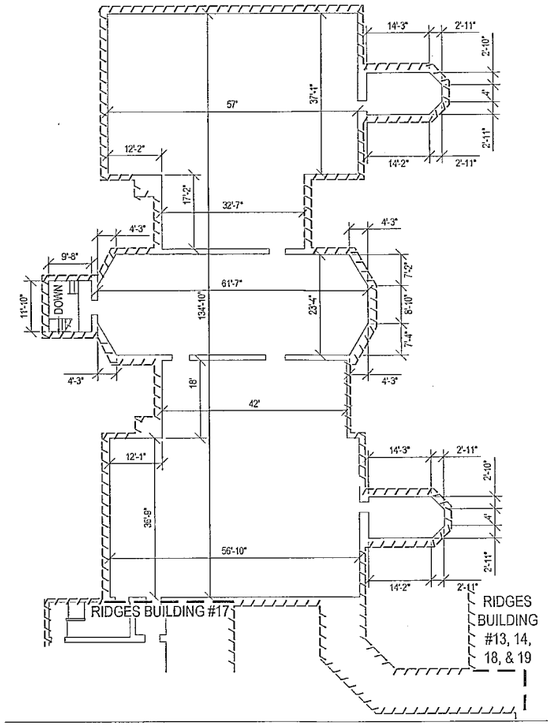


SCALE: $\frac{1}{16}$" = 1' 0"

SECOND FLOOR PLAN - RIDGES BUILDING #16 - UNIT 1401

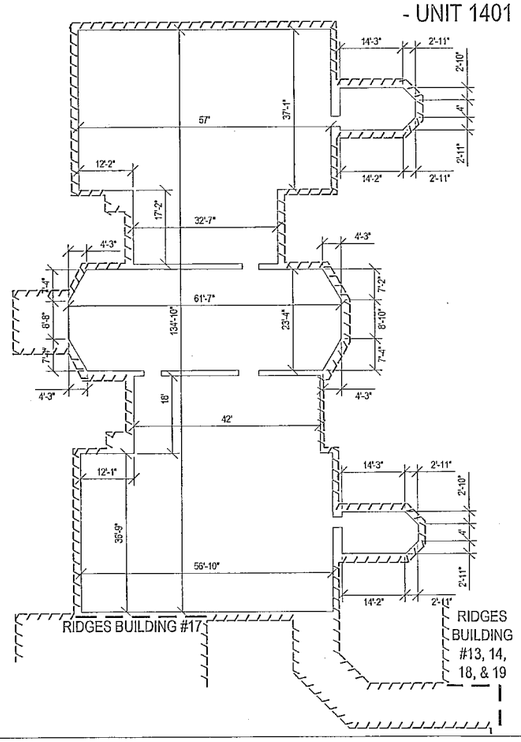

SCALE: $\frac{1}{16}$" = 1' 0"

ATTIC FLOOR PLAN - RIDGES BUILDING #16 - UNIT 1401

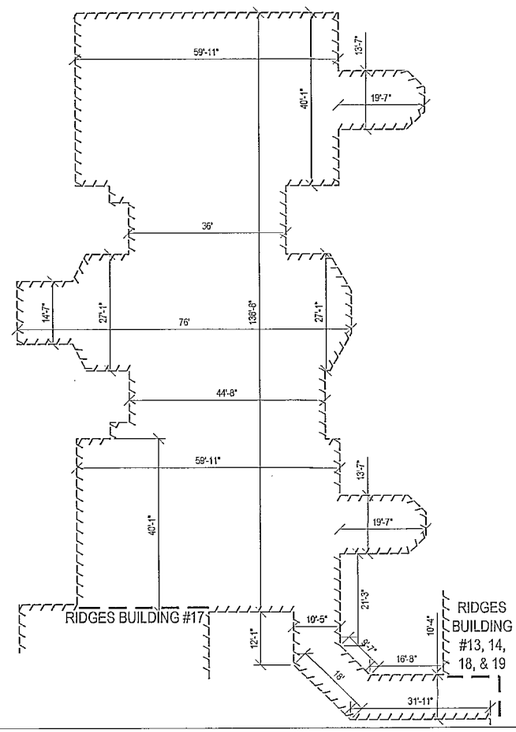

SCALE: $\frac{1}{16}$" = 1' 0"

BUILDING DIMENSIONS - RIDGES BUILDING #16 - UNIT 1401

202000004113
FILED FOR RECORD IN
ATHENS COUNTY, OHIO
JESSICA MARKINS, RECORDER
09/10/2020 02:30:46 PM
OR BOOK: 659 PAGE: 296
DE 64.00 PG: 1
1 NAME PLAT

NO.	DATE	BY	DESCRIPTION

237 NORTH MAIN STREET
ADRIAN, MI 49221
TEL: 517.263.4535
FAX: 517.263.4535

PROJECT DATE: 09/12/2025
PROJECT NO.: 2500682
DRAWN BY: CDH
CHECKED BY: PW

TECHNICAL SKILL. CREATIVE SPIRIT.

Mannik Smith Group

www.MannikSmithGroup.com

PREPARED FOR:
OHIO UNIVERSITY
ATHENS, OHIO 45701

OHIO UNIVERSITY
RIDGES SURVEY
118 RIDGES CIRCLE,
ATHENS, OHIO 45701


RIDGES BUILDING #16
FLOOR PLAN &
BUILDING DIMENSIONS

35 / 64


\\MSGFILESRV\MSGData\Projects\2025\600-799\2500682\CAD\SURV\2500682_BLDG.dwg - Last printed 4/6/2026 2:22 PM

envelope
605 B


202600004114
FILED FOR RECORD IN
ATHENS COUNTY, OHIO
JESSICA MARKINS, RECORDER
09/10/2026 02:30:47 PM
OR BOOK: 639 PAGE: 297
LAND PLAT 86.49 PGS 1

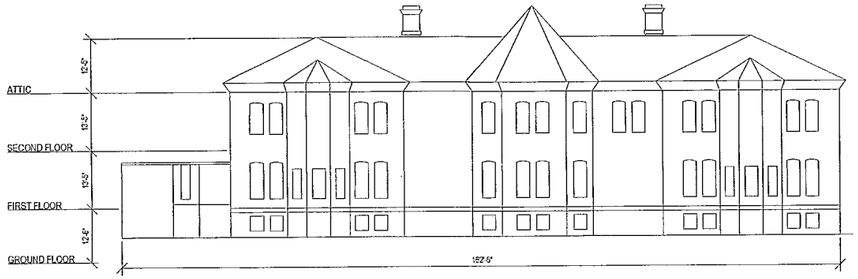

SCALE: $\frac{1}{16}$ = 1' 0" NORTH ELEVATION - RIDGES BUILDING #16 - UNIT 1401

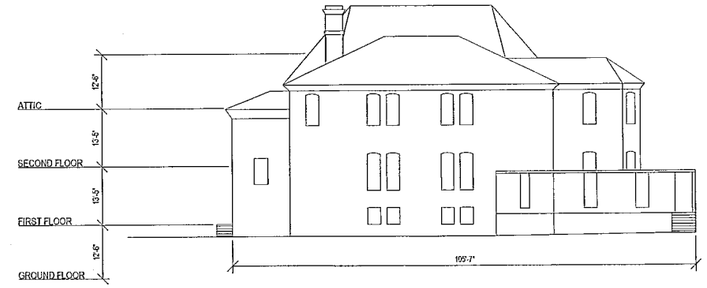

SCALE: $\frac{1}{16}$ = 1' 0" EAST ELEVATION - RIDGES BUILDING #16 - UNIT 1401

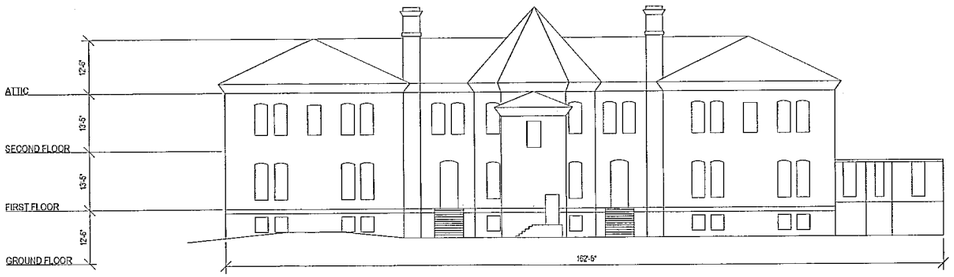

SCALE: $\frac{1}{16}$ = 1' 0" SOUTH ELEVATION - RIDGES BUILDING #16 - UNIT 1401



SCALE: $\frac{1}{16}$ = 1' 0" WEST ELEVATION - RIDGES BUILDING #16 - UNIT 1401

NO.	DATE	BY	DESCRIPTION

237 NORTH MAIN STREET
ADRIAN, MI 49221
TEL: 517.263.4515
FAX: 517.263.4235

PROJECT DATE: 09/12/2025
PROJECT NO.: 2500682
DRAWN BY: CDH
CHECKED BY: PW

TECHNICAL SKILL. CREATIVE SPIRIT.

Mannik Smith Group

www.MannikSmithGroup.com

PREPARED FOR:
OHIO UNIVERSITY
ATHENS, OHIO 45701


OHIO UNIVERSITY
RIDGES SURVEY
118 RIDGES CIRCLE,
ATHENS, OHIO 45701

RIDGES BUILDING
#16 ELEVATIONS

36 / 64


\\MSGFILESRV\MSGData\Projects\2025\600-799\2500682\CAD\SURV\2500682_ELEV.dwg - Last printed 4/6/2026 2:22 PM

202600004115
FILED FOR RECORD IN
ATHENS COUNTY, OHIO
JESSICA MARKING, RECORDER
09/10/2026 02:30:48 PM
OR BOOK: 639 PAGE: 298

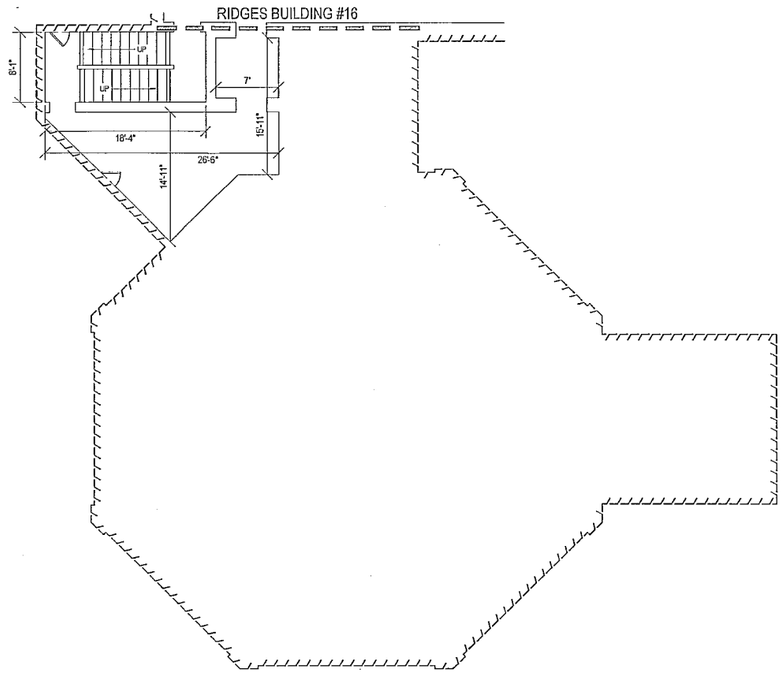


SCALE: $\frac{1}{16}$" = 1' 0"

BASEMENT - RIDGES BUILDING #17 - UNIT 1501

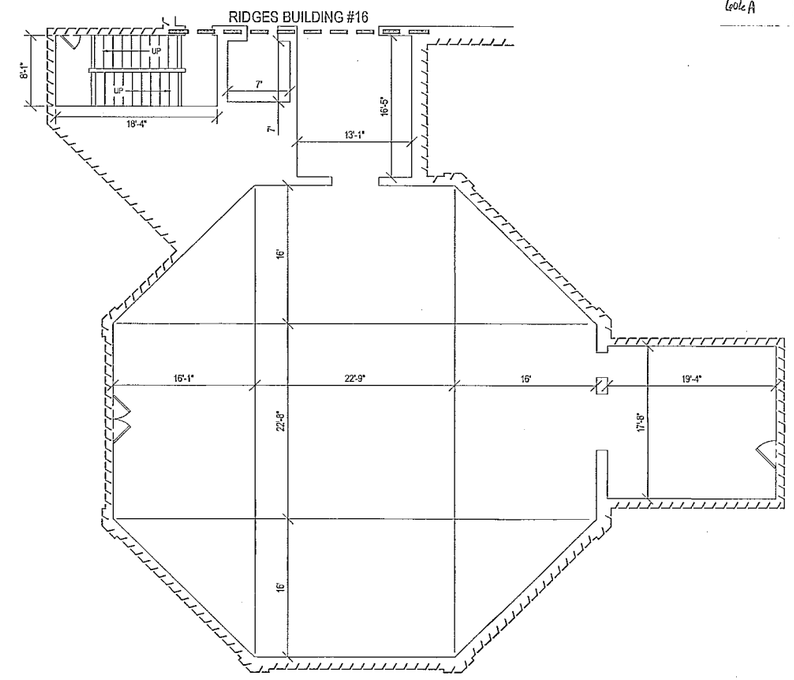


SCALE: $\frac{1}{16}$" = 1' 0"

FIRST FLOOR PLAN - RIDGES BUILDING #17 - UNIT 1501

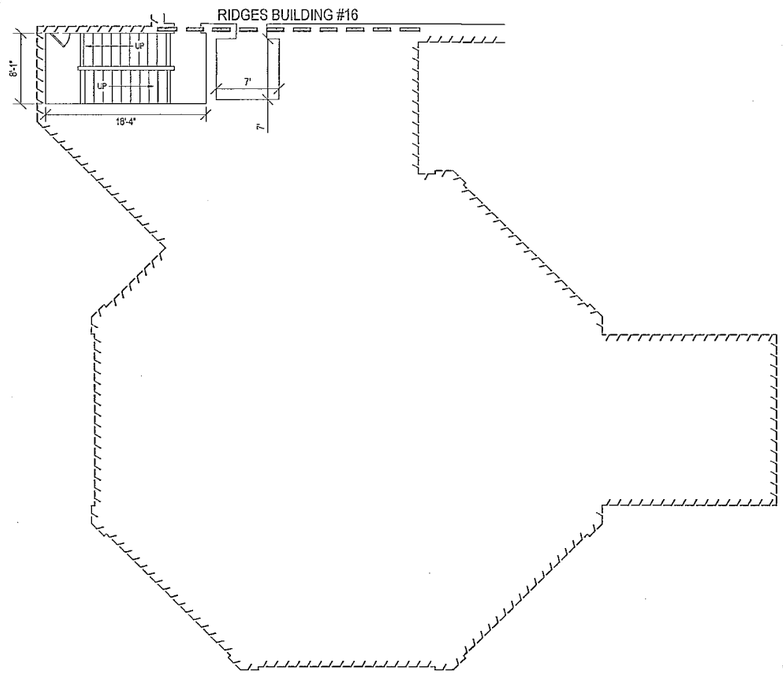

SCALE: $\frac{1}{16}$" = 1' 0"

SECOND FLOOR PLAN - RIDGES BUILDING #17 - UNIT 1501

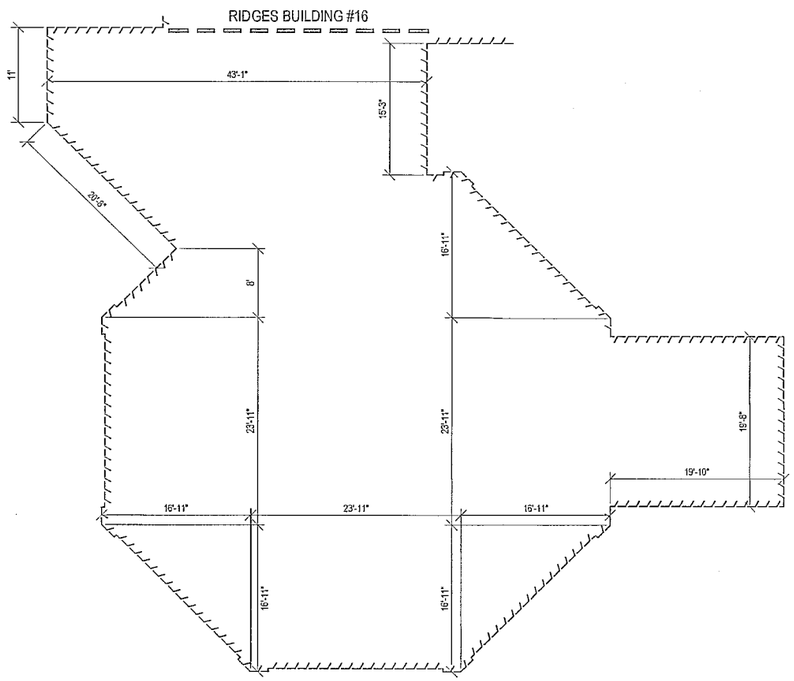

SCALE: $\frac{1}{16}$" = 1' 0"

BUILDING DIMENSIONS - RIDGES BUILDING #17 - UNIT 1501

NO.	DATE	BY	DESCRIPTION

257 NORTH MAIN STREET
ATHENS, MI 49711
TEL: 517.263.4515
FAX: 517.263.4355

PROJECT DATE: 08/12/2025
PROJECT NO.: 2500682
DRAWN BY: CDH
CHECKED BY: PWI

TECHNICAL SKILL. GREATNESS SPIRIT.

Mannik Smith Group

www.MannikSmithGroup.com

PREPARED FOR:
OHIO UNIVERSITY
ATHENS, OHIO 45701

OHIO UNIVERSITY
RIDGES SURVEY
118 RIDGES CIRCLE,
ATHENS, OHIO 45701


RIDGES BUILDING #17
FLOOR PLAN &
BUILDING DIMENSIONS

37 / 64

\\MSGFILESRV\MSGData\Projects\2025\600-799\2500682\CAD\SURV\2500682_BLDG.dwg - Last printed 4/8/2026 2:22 PM


Envelope book 3

202600004116
FILED FOR RECORD IN
ATHENS COUNTY, OHIO
JESSICA WARKINS, RECORDER
09/10/2026 02:30:49 PM
OR BOOK: 639 PAGE: 299

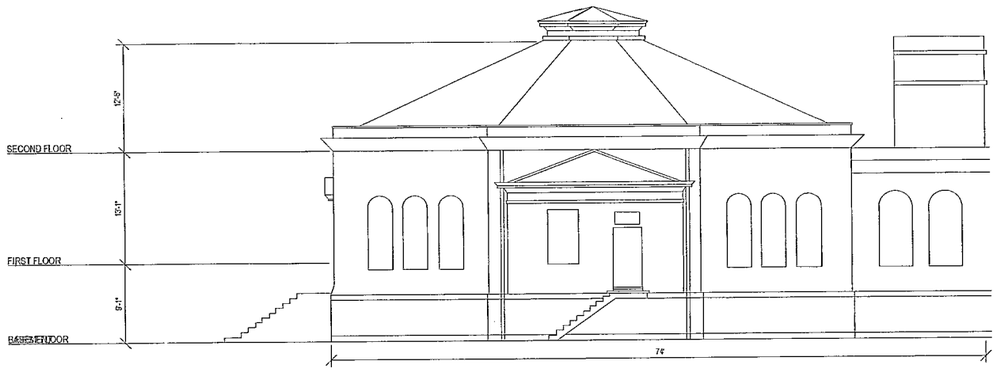


SCALE: $\frac{1}{8}$" = 1' 0"

NORTH ELEVATION - RIDGES BUILDING #17 - UNIT 1501

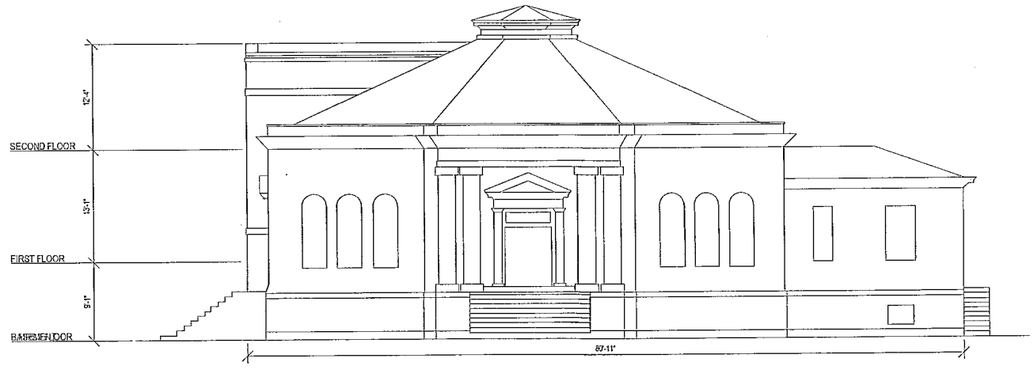


SCALE: $\frac{1}{8}$" = 1' 0"

EAST ELEVATION - RIDGES BUILDING #17 - UNIT 1501

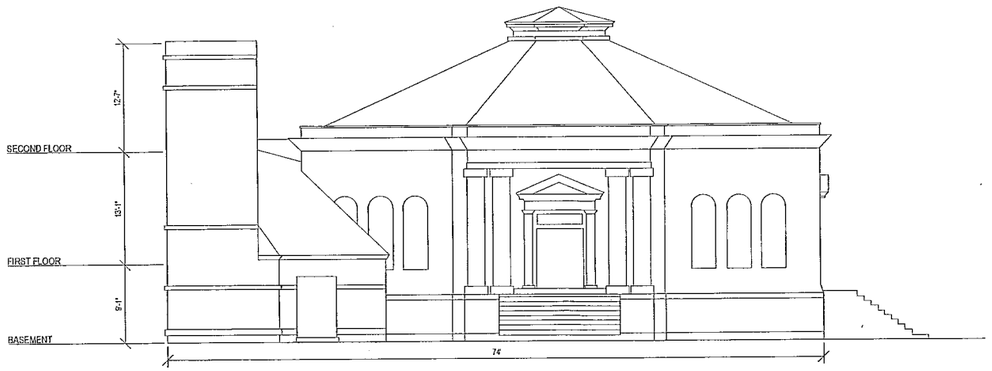

SCALE: $\frac{1}{8}$" = 1' 0"

SOUTH ELEVATION - RIDGES BUILDING #17 - UNIT 1501

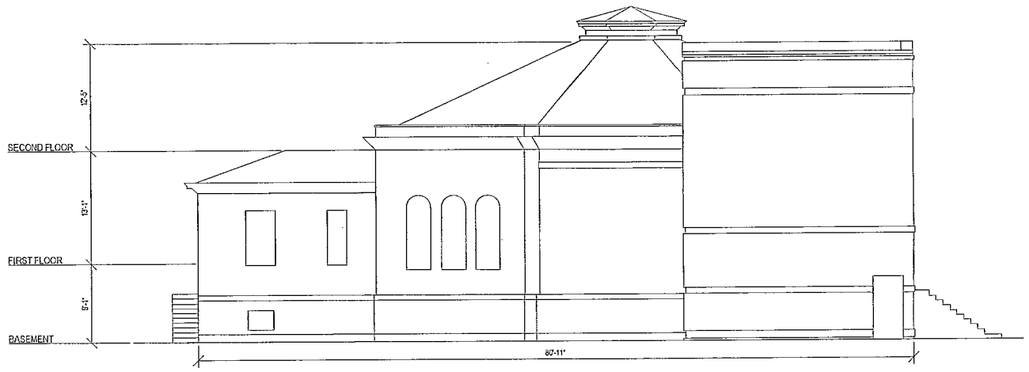

SCALE: $\frac{1}{8}$" = 1' 0"

WEST ELEVATION - RIDGES BUILDING #17 - UNIT 1501

207 NORTH MAIN STREET
ADRIAN, MI 49221
TEL: 517.263.4515
FAX: 517.263.4535

NO.	DATE	BY	DESCRIPTION

PROJECT DATE: 09/12/2025
PROJECT NO.: 2500682
DRAWN BY: CDH
CHECKED BY: PM

Merrick Smith
TECHNICAL SKILL. CREATIVE DESIGN.
www.MerrickSmithGroup.com


PREPARED FOR:
OHIO UNIVERSITY
ATHENS, OHIO 45701

OHIO UNIVERSITY
RIDGES SURVEY
118 RIDGES CIRCLE,
ATHENS, OHIO 45701

RIDGES BUILDING
#17 ELEVATIONS


38 / 64

\\MSGFILESRV\MSGData\Projects\2025\600-799\2500682\CAD\SURV\2500682_ELEV.dwg - Last printed 4/6/2026 2:22 PM

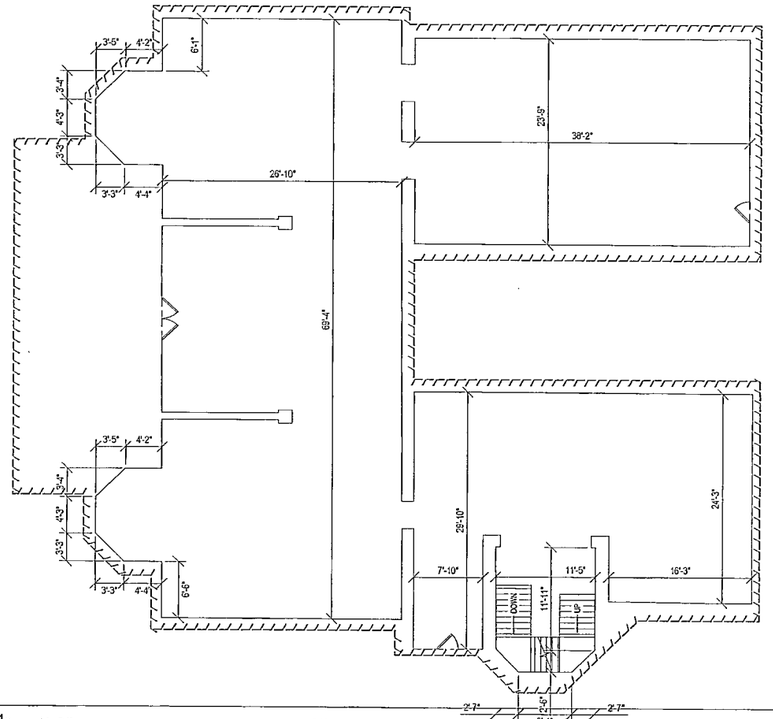


SCALE: $\frac{1}{8}$" = 1' 0"

FIRST FLOOR PLAN - RIDGES BUILDING #21 - UNIT 1601

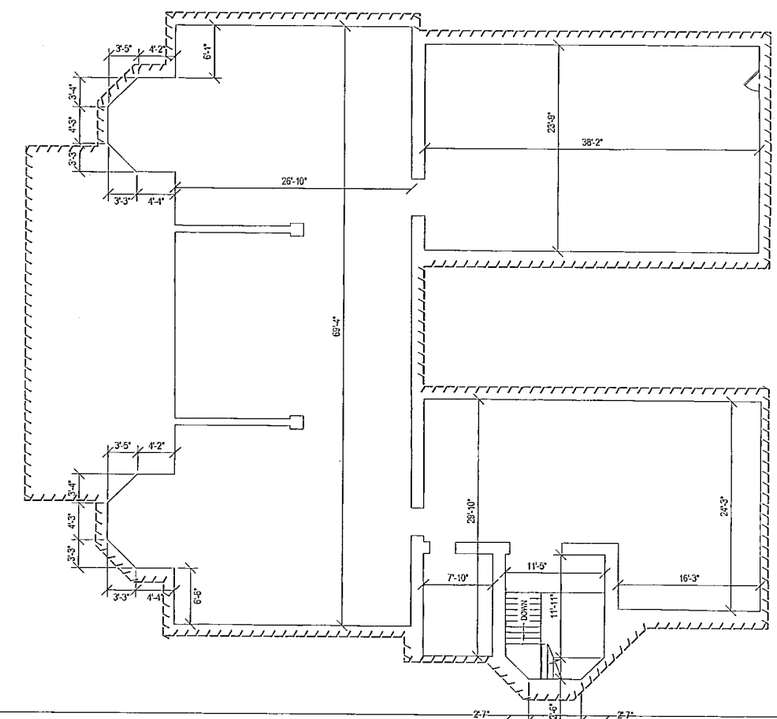


SCALE: $\frac{1}{8}$" = 1' 0"

SECOND FLOOR PLAN - RIDGES BUILDING #21 - UNIT 1601

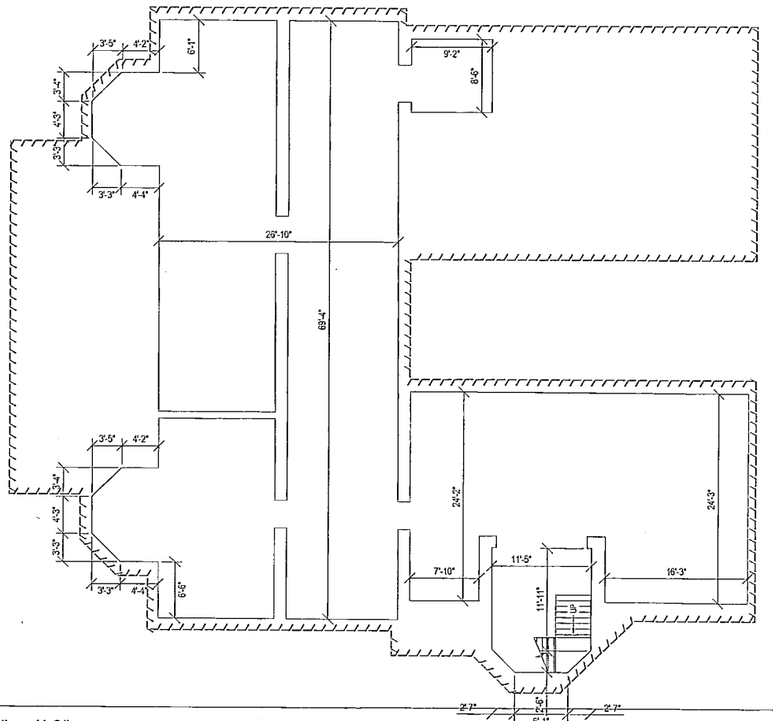

SCALE: $\frac{1}{8}$" = 1' 0"

BASEMENT FLOOR PLAN - RIDGES BUILDING #21 - UNIT 1601

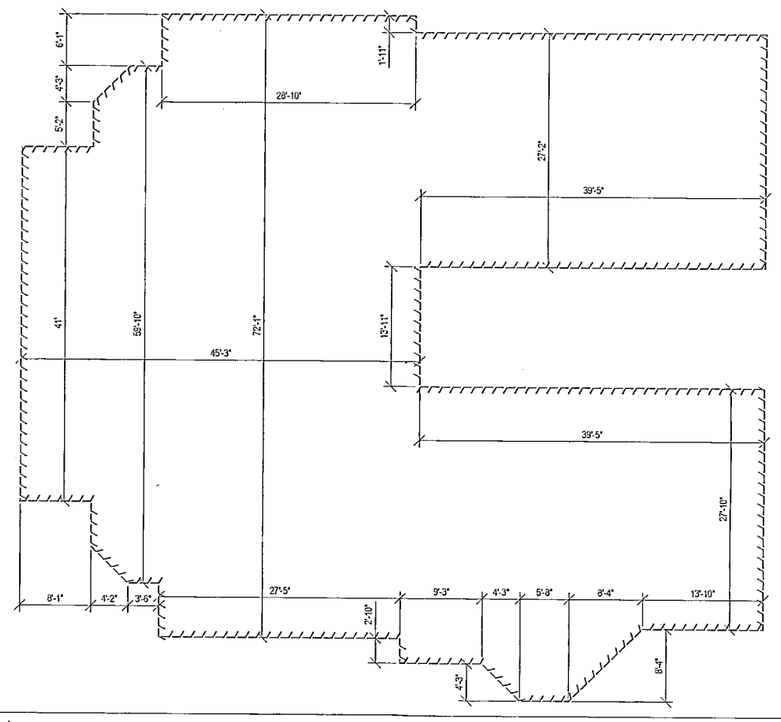

SCALE: $\frac{1}{8}$" = 1' 0"

BUILDING DIMENSIONS - RIDGES BUILDING #21 - UNIT 1601

2026000041117
FILED FOR RECORD IN
ATHENS COUNTY, OHIO
JESSICA MARKINS, RECORDER
04/14/2026 02:30:50 PM
REC FEE: 40.00
PAGES: 259 PAGE: 300

NO.	DATE	BY	DESCRIPTION

237 NORTH MAIN STREET
ADRIAN, MI 49221
TEL: 517.263.4515
FAX: 517.263.4535

PROJECT DATE: 03/12/2025
PROJECT NO.: 2500682
DRAWN BY: CDH
CHECKED BY: PW

Mannik Smith Group
TECHNICAL SKILL. CREATIVE SYNERGY.
www.MannikSmithGroup.com

PREPARED FOR:
OHIO UNIVERSITY
ATHENS, OHIO 45701

OHIO UNIVERSITY
RIDGES SURVEY
118 RIDGES CIRCLE,
ATHENS, OHIO 45701


RIDGES BUILDING #21
FLOOR PLAN &
BUILDING DIMENSIONS

39 / 64

\\MSGFILESRV\MSCData\Projects\2025\600-799\2500682\CADI\SURV\2500682_BLDG.dwg - Last printed 4/6/2026 2:22 PM


FILED FOR RECORD IN
ATHENS COUNTY, OHIO
JESSICA HARKINS, RECORDER
09/10/2026 02:20:51 PM
OR BOOK: 639 PAGE: 301
LARGE PLAT 84.40 FEE: 1

Exempt
607 B

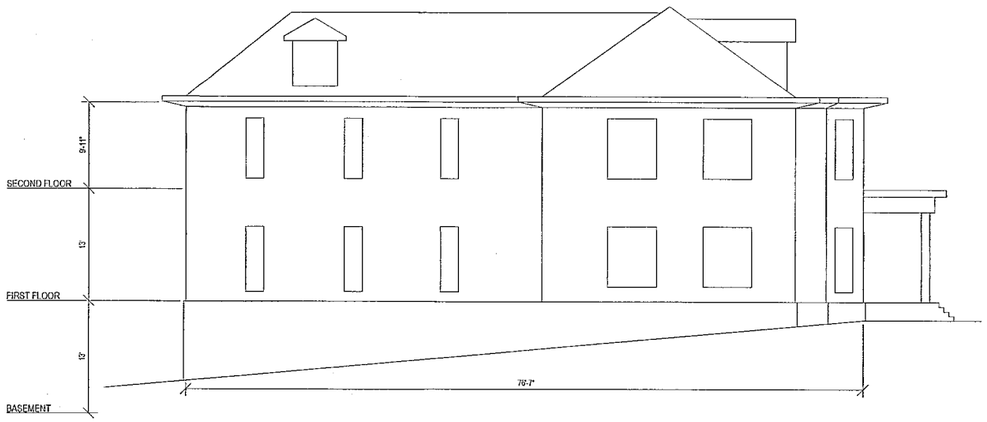


SCALE: $\frac{1}{8}$" = 1' 0"

NORTH ELEVATION - RIDGES BUILDING #21 - UNIT 1601

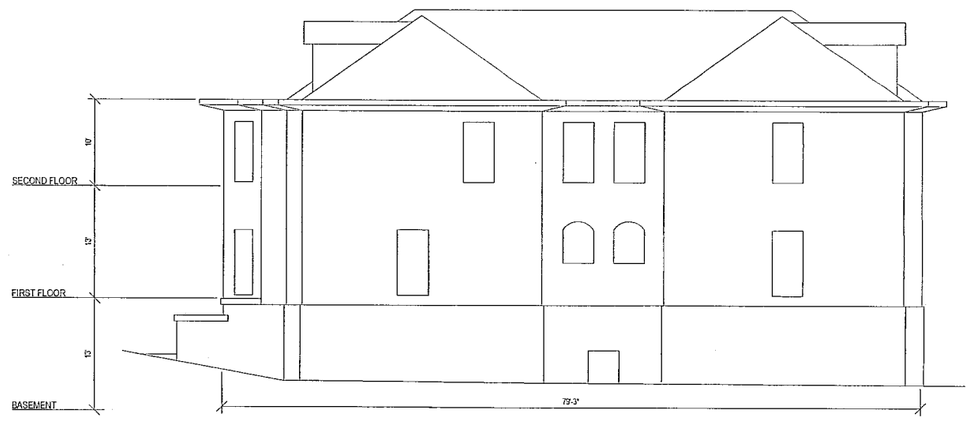


SCALE: $\frac{1}{8}$" = 1' 0"

EAST ELEVATION - RIDGES BUILDING #21 - UNIT 1601

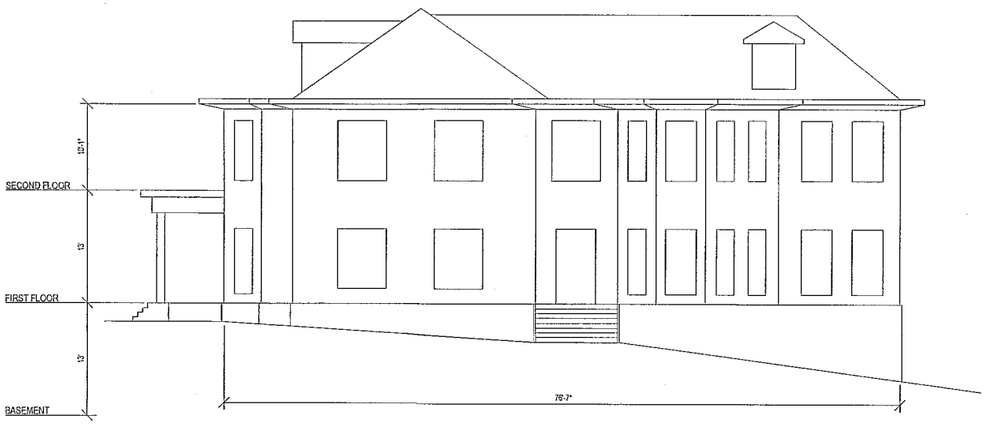

SCALE: $\frac{1}{8}$" = 1' 0"

SOUTH ELEVATION - RIDGES BUILDING #21 - UNIT 1601

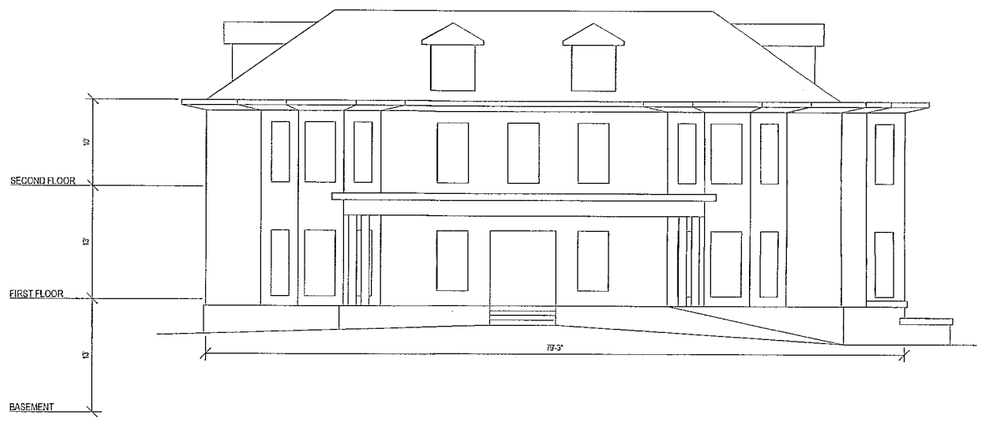

SCALE: $\frac{1}{8}$" = 1' 0"

WEST ELEVATION - RIDGES BUILDING #21 - UNIT 1601

NO.	DATE	BY	DESCRIPTION

237 NORTH MAIN STREET

PROJECT DATE: 09/12/2025
PROJECT NO.: 2500682
DRAWN BY: CDH
CHECKED BY: PW


Mannik Smith Group
www.MannikSmithGroup.com


PREPARED FOR:
OHIO UNIVERSITY
ATHENS, OHIO 45701

OHIO UNIVERSITY
RIDGES SURVEY
118 RIDGES CIRCLE,
ATHENS, OHIO 45701

RIDGES BUILDING
#21 ELEVATIONS


40 / 64

\\MSGFILESRV\MSGData\Projects\2025\600-799\2500682\CAD\SURV\2500682_ELEV.dwg - Last printed 4/6/2026 2:22 PM

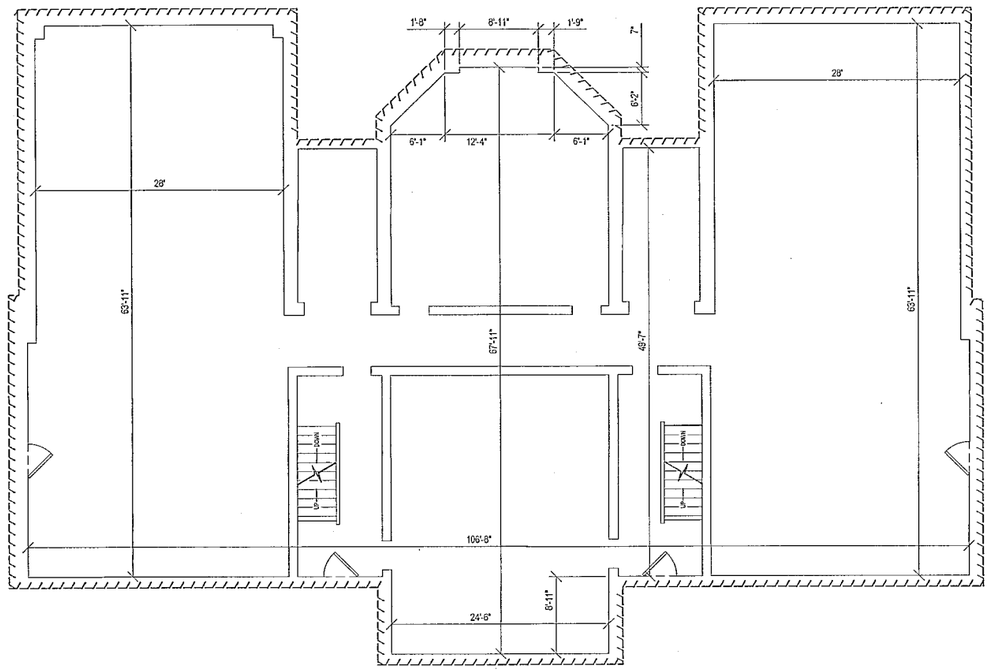


SCALE: $\frac{1}{8}$" = 1' 0"

FIRST FLOOR PLAN - RIDGES BUILDING #22 - UNIT 1701

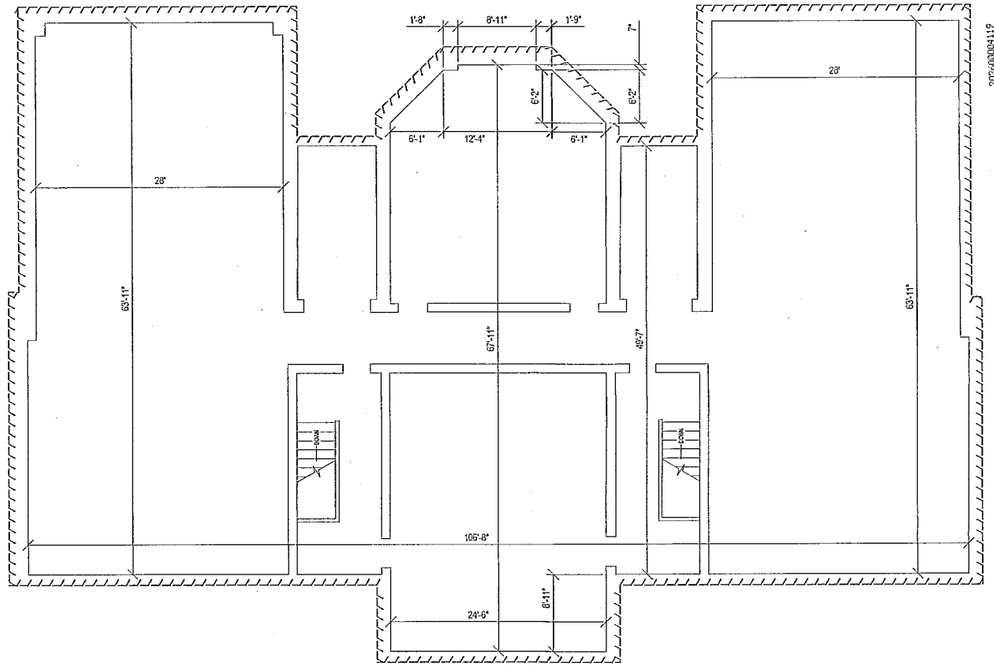


SCALE: $\frac{1}{8}$" = 1' 0"

SECOND FLOOR PLAN - RIDGES BUILDING #22 - UNIT 1701

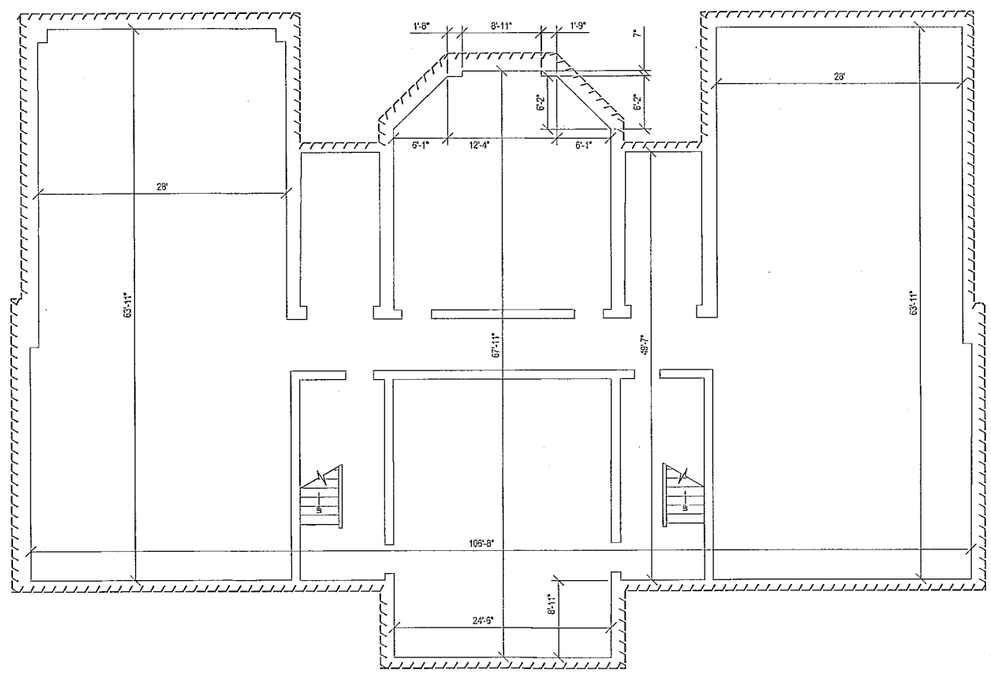

SCALE: $\frac{1}{8}$" = 1' 0"

BASEMENT FLOOR PLAN - RIDGES BUILDING #22 - UNIT 1701

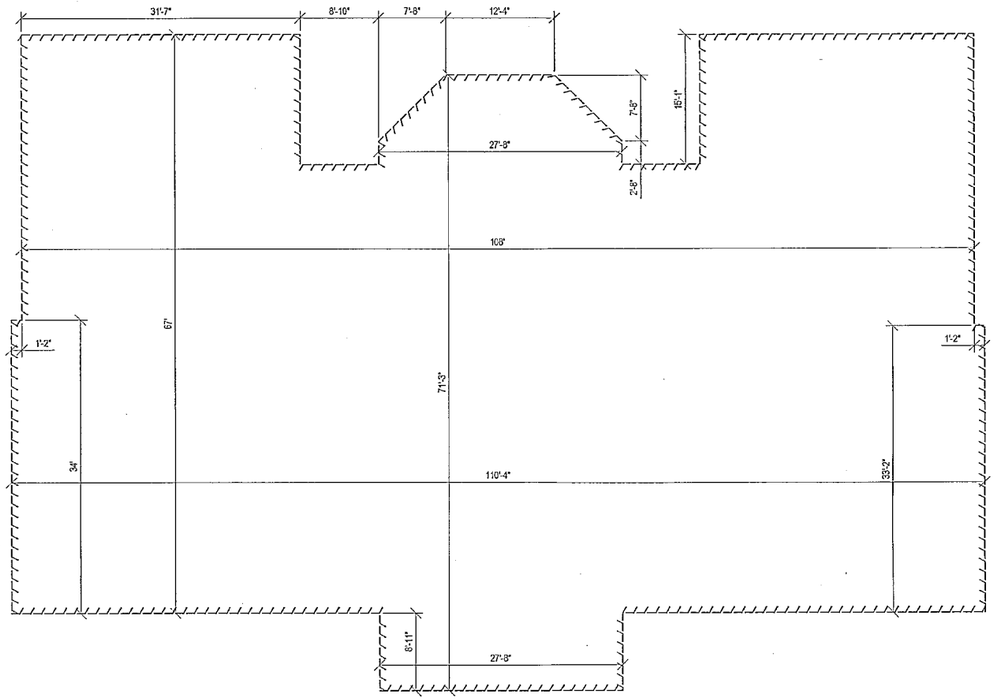

SCALE: $\frac{1}{8}$" = 1' 0"

BUILDING DIMENSIONS - RIDGES BUILDING #22 - UNIT 1701

202600004119
FILED FOR RECORD IN
ATHENS COUNTY, OHIO
OR BOOK: 639 PAGE: 302
RECORDING $40.00 PG: 1

Lot A

NO.	DATE	BY	DESCRIPTION

237 NORTH MAIN STREET
ADRIAN, MI 49221
TELEPHONE: 517.265.4535
FAX: 517.265.4535

PROJECT DATE: 08/12/2025
PROJECT NO.: 2500682
DRAWN BY: CDH
CHECKED BY: PW

Mannik Smith Group
TECHNICAL SKILL. CREATIVE SPIRIT.
www.MannikSmithGroup.com

PREPARED FOR:
OHIO UNIVERSITY
ATHENS, OHIO 45701

OHIO UNIVERSITY
RIDGES SURVEY
118 RIDGES CIRCLE,
ATHENS, OHIO 45701


RIDGES BUILDING #22
FLOOR PLAN &
BUILDING DIMENSIONS

41 / 64

\\MSGFILESRV\MSGData\Projects\2025\600-799\2500682\CAD\SURV\2500682_BLDG.dwg - Last printed 4/6/2026 2:22 PM

2026000004120
FILED FOR RECORD IN
ATHENS COUNTY, OHIO
JESSICA HARKINS, RECORDER
09/10/2026 02:30:53 PM
OR BOOK: 639 PAGE: 303
LARGE PLAT 86.40 PG: 1

Envelope 1006 B

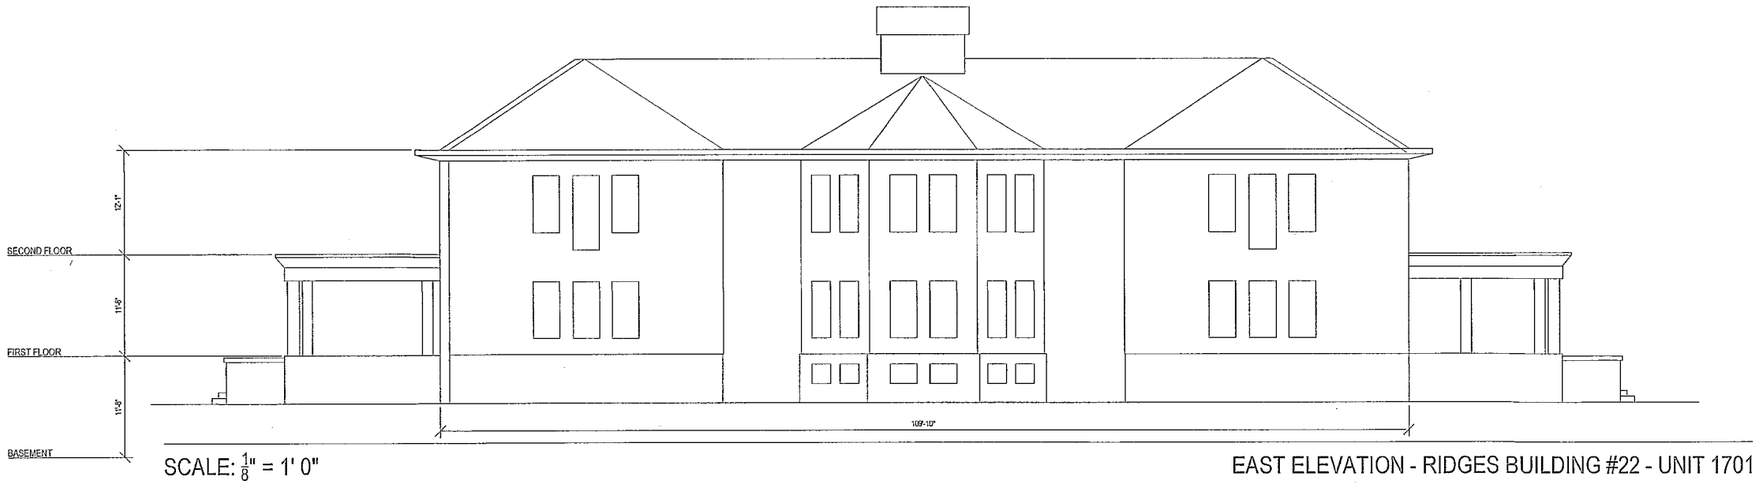


SCALE: $\frac{1}{8}$" = 1' 0"

EAST ELEVATION - RIDGES BUILDING #22 - UNIT 1701



SCALE: $\frac{1}{8}$" = 1' 0"

WEST ELEVATION - RIDGES BUILDING #22 - UNIT 1701

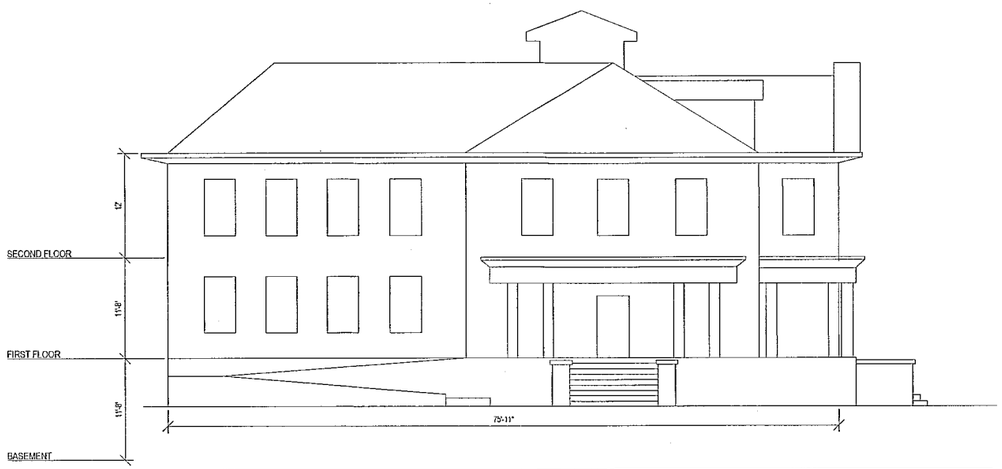

SCALE: $\frac{1}{8}$" = 1' 0"

NORTH ELEVATION - RIDGES BUILDING #22 - UNIT 1701



SCALE: $\frac{1}{8}$" = 1' 0"

SOUTH ELEVATION - RIDGES BUILDING #22 - UNIT 1701

237 NORTH MAIN STREET
ADRIAN, MI 49221
TEL: 517.263.4455
FAX: 517.263.4559

NO.	DATE	BY	DESCRIPTION

PROJECT DATE: 09/12/2025
PROJECT NO.: 2500682
DRAWN BY: CDH
CHECKED BY: PW

TECHNICAL SKILL. CREATIVE SPIRIT.

www.MannikSmithGroup.com

PREPARED FOR:
OHIO UNIVERSITY
ATHENS, OHIO 45701

OHIO UNIVERSITY
RIDGES SURVEY
118 RIDGES CIRCLE,
ATHENS, OHIO 45701


RIDGES BUILDING
#22 ELEVATIONS

42 / 64

\\MSGFILESRV\MSGData\Projects\2025\600-799\2500682\CAD\SURV\2500682_ELEV.dwg - Last printed 4/6/2026 2:22 PM


202600004121
FILED FOR RECORD IN
ATHENS COUNTY, OHIO
JESSICA HARKINS, RECORDER
09/10/2026 02:30:54 PM
OR BOOK: 639 PAGE: 304
LARGE PLAT 56.40 PG: 1

Envelope for A

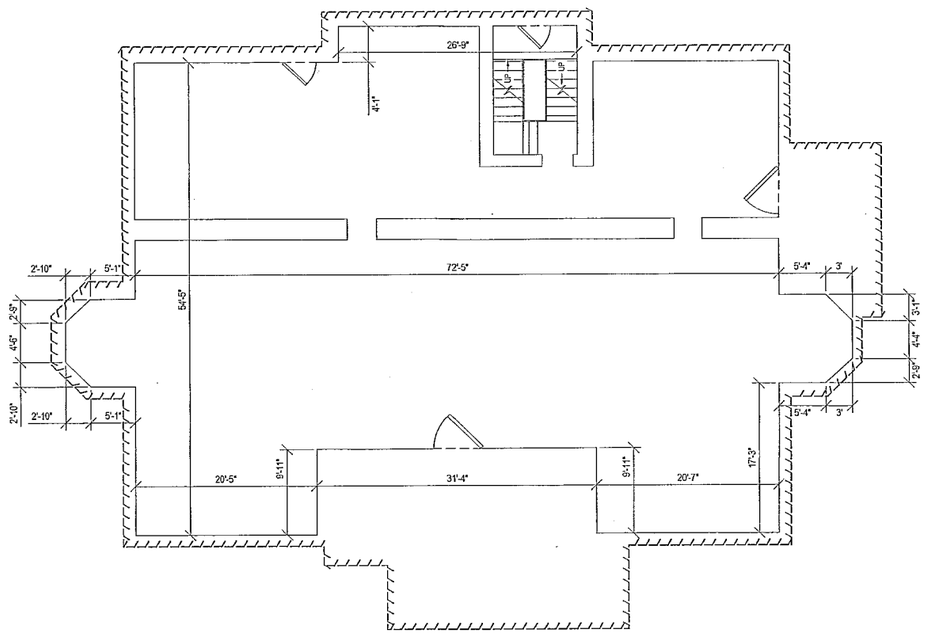


SCALE: $\frac{1}{8}$" = 1' 0"

FIRST FLOOR PLAN - RIDGES BUILDING #24 - UNIT 1801

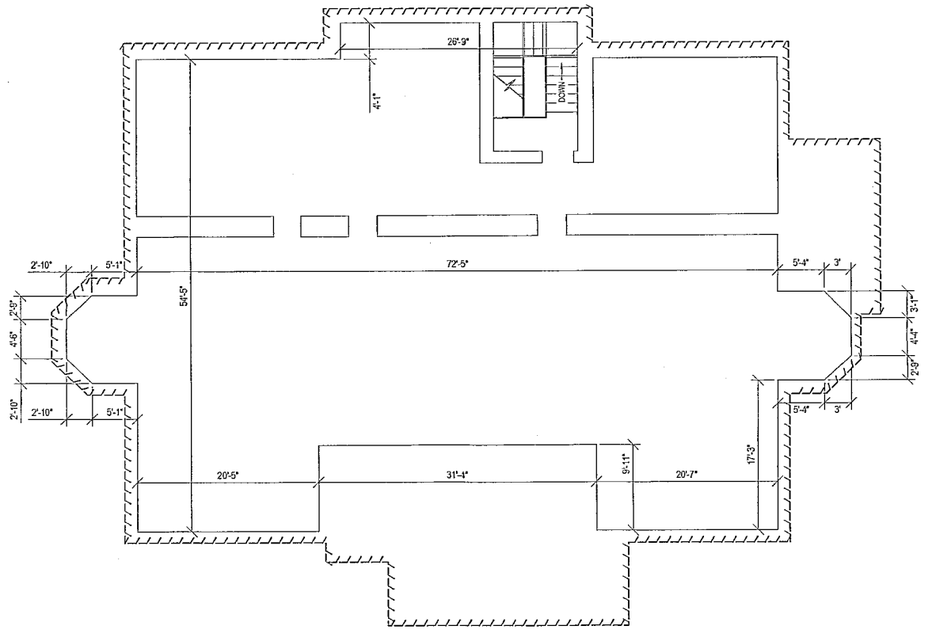


SCALE: $\frac{1}{8}$" = 1' 0"

SECOND FLOOR PLAN - RIDGES BUILDING #24 - UNIT 1801

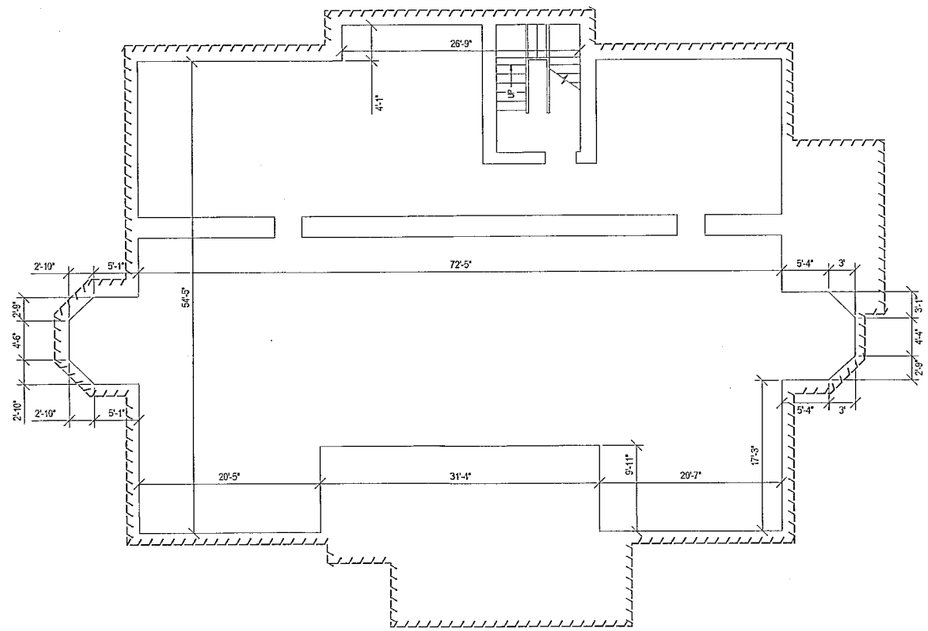

SCALE: $\frac{1}{8}$" = 1' 0"

BASEMENT FLOOR PLAN - RIDGES BUILDING #24 - UNIT 1801

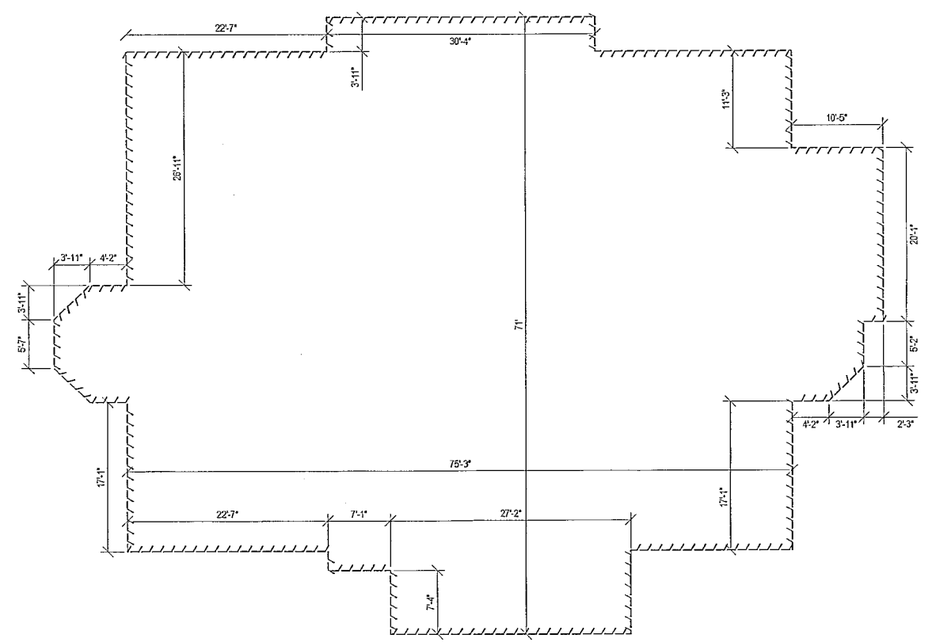

SCALE: $\frac{1}{8}$" = 1' 0"

BUILDING DIMENSIONS - RIDGES BUILDING #24 - UNIT 1801

NO.	DATE	BY	DESCRIPTION

237 NORTH MAIN STREET
ADRIAN, MI 49221
TEL: 517.263.4515
FAX: 517.263.4535

PROJECT DATE: 09/12/2025
PROJECT NO.: 2503682
DRAWN BY: CDH
CHECKED BY: PW

Marnik Smith Group
TECHNICAL SKILL. CREATIVE SOUL.
www.MarnikSmithGroup.com

PREPARED FOR:
OHIO UNIVERSITY
ATHENS, OHIO 45701


OHIO UNIVERSITY
RIDGES SURVEY
118 RIDGES CIRCLE,
ATHENS, OHIO 45701

RIDGES BUILDING #24
FLOOR PLAN &
BUILDING DIMENSIONS

43 / 64


\\MSGFILESRV\MSGData\Projects\2025\600-799\2500682\CAD\SURV2500682_BLDG.dwg - Last printed 4/6/2026 2:22 PM

202600004122
FILED FOR RECORD IN
ATHENS COUNTY, OHIO
JESSICA MASKINS, RECORDER
09/10/2026 02:30:55 PM
OR BOOK: 639 PAGE: 305
LARGE PLAT 86.40 FEE: 1.
Envelope 609 B

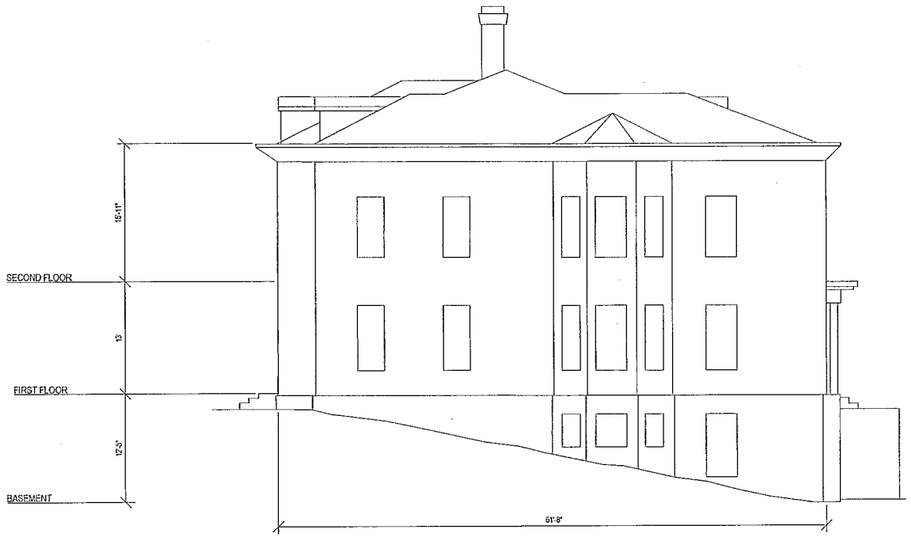

SCALE: $\frac{1}{8}$" = 1' 0"

NORTH ELEVATION - RIDGES BUILDING #24 - UNIT 1801

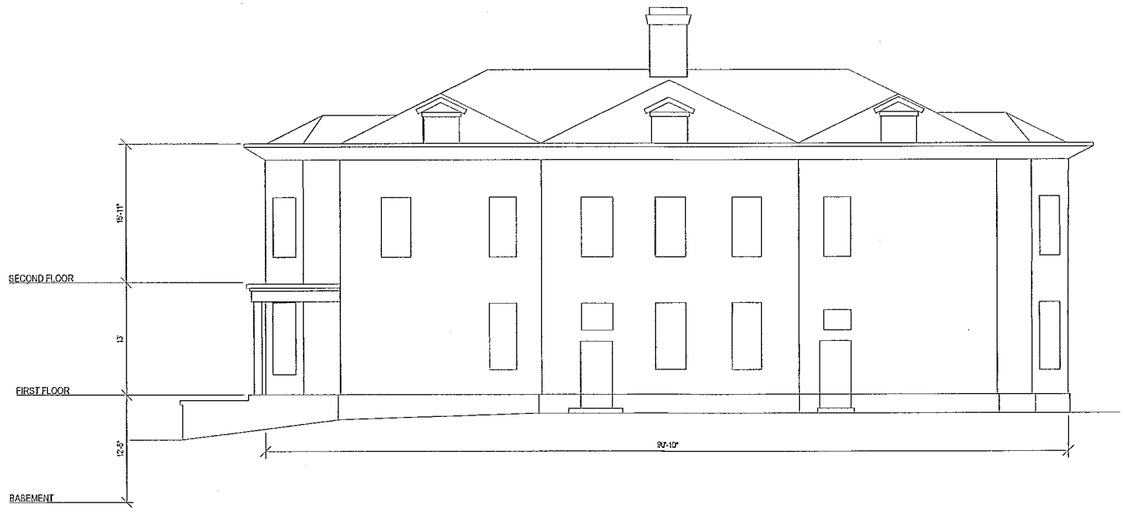


SCALE: $\frac{1}{8}$" = 1' 0"

SOUTH ELEVATION - RIDGES BUILDING #24 - UNIT 1801



SCALE: $\frac{1}{8}$" = 1' 0"


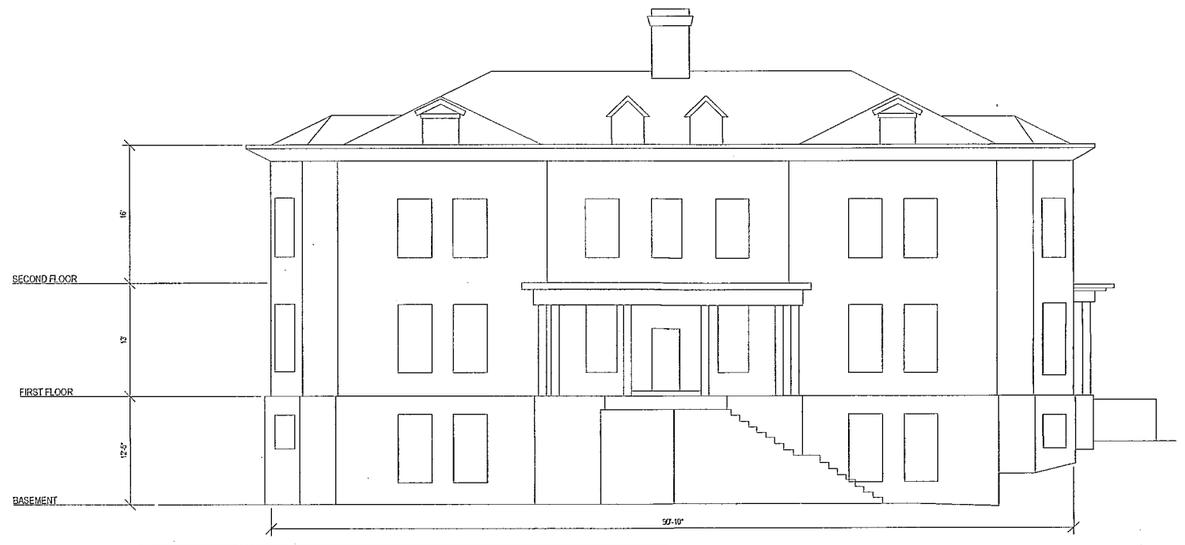

SCALE: $\frac{1}{8}$" = 1' 0"

SOUTH ELEVATION - RIDGES BUILDING #24 - UNIT 1801

237 NORTH MAIN STREET
ADRIAN, MI 49221
TEL: 517.263.4515
FAX: 517.263.4535

NO.	DATE	BY	DESCRIPTION

PROJECT DATE: 08/12/2025
PROJECT NO.: 2500682
DRAWN BY: CDH
CHECKED BY: PW

TECHNICAL SKILL. CREATIVE SPIRIT.

www.MannikSmithGroup.com

PREPARED FOR:
OHIO UNIVERSITY
ATHENS, OHIO 45701

OHIO UNIVERSITY
RIDGES SURVEY
118 RIDGES CIRCLE,
ATHENS, OHIO 45701


RIDGES BUILDING
#24 ELEVATIONS

44 / 64

\\MSGFILESRV\MSGData\Projects\2025\600-799\2500682\CADISURV\2500682_ELEV.dwg - Last printed 4/6/2026 2:23 PM


202600004123
FILED FOR RECORD IN
ATHENS COUNTY, OHIO
JESSICA MARKINS, RECORDER
09/10/2026 02:30:56 PM
OR BOOK: 639 PAGE: 306
LARGE PLAT ... 86.40 ... PG: 1

Envelop 6104

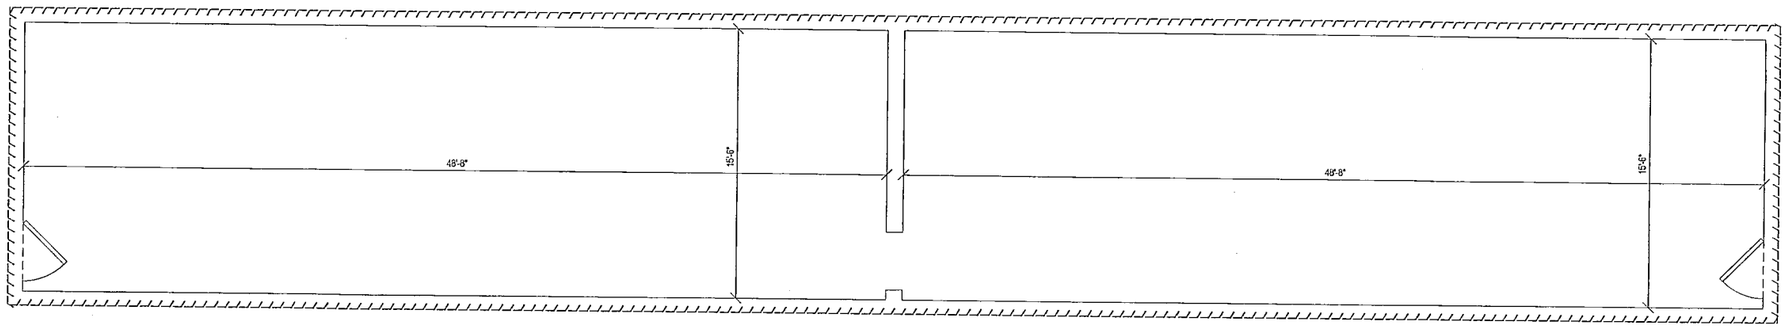

SCALE: $\frac{1}{4}$" = 1' 0"

FLOOR PLAN - RIDGES BUILDING #30 - UNIT 1901

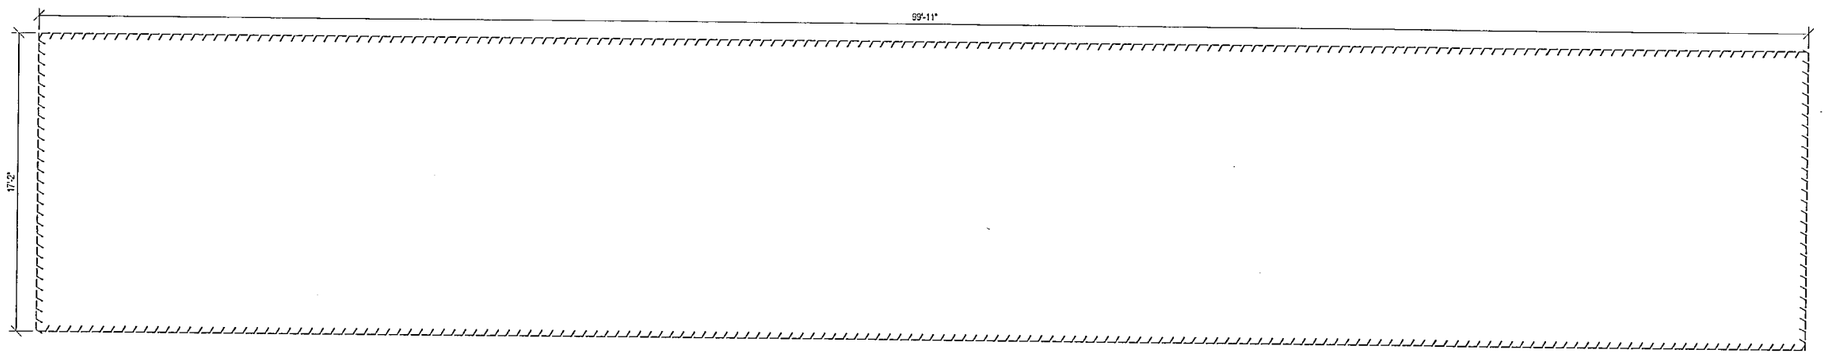

SCALE: $\frac{1}{4}$" = 1' 0"

BUILDING DIMENSIONS - RIDGES BUILDING #30 - UNIT 1901

\\MSGFILESRV\MSGData\Projects\2025\600-799\2500682\CAD\SURV\2500682_BLDG.dwg - Last printed 4/6/2026 2:23 PM

NO.	DATE	BY	DESCRIPTION

237 NORTH MAIN STREET
ADRIAN, MI 49221
TEL: 517.263.4515
FAX: 517.263.4535

PROJECT DATE: 09/12/2025
PROJECT NO.: 2500682
DRAWN BY: CDH
CHECKED BY: PW

TECHNICAL SKILL. CREATIVE SPIRIT.

Manik Smith Group

www.ManikSmithGroup.com

PREPARED FOR:
OHIO UNIVERSITY


OHIO UNIVERSITY
RIDGES SURVEY
118 RIDGES CIRCLE,
ATHENS, OHIO 45701

RIDGES BUILDING #30
FLOOR PLAN &
BUILDING DIMENSIONS

45 / 64


202600004124
FILED FOR RECORD IN
ATHENS COUNTY, OHIO
JESSICA WARKINS, RECORDER
09/10/2026 02:30:57 PM
OR BOOK: 639 PAGE: 307

Envelope
610 B

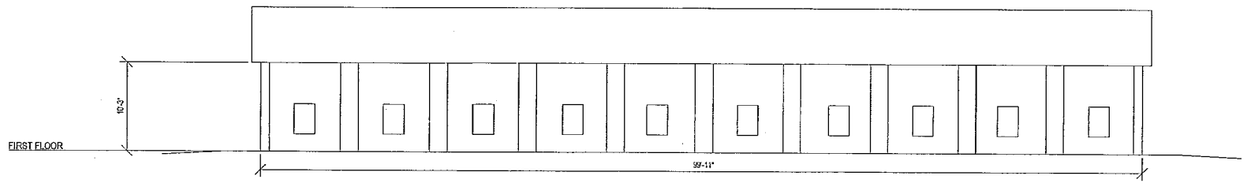


SCALE: 1/8" = 1' 0"

EAST ELEVATION - RIDGES BUILDING #30 - UNIT 1901

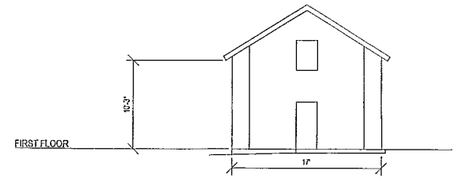


SCALE: 1/8" = 1' 0"

NORTH ELEVATION - RIDGES BUILDING #30 - UNIT 1901

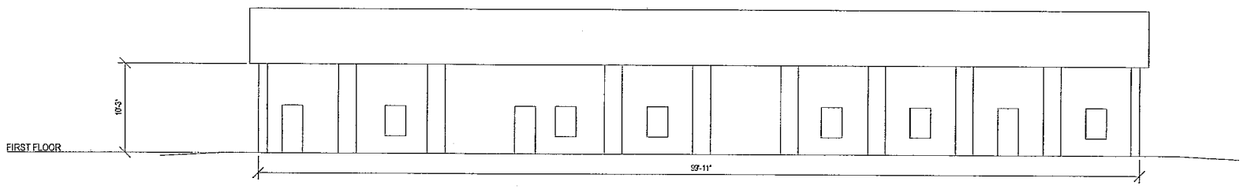

SCALE: 1/8" = 1' 0"

WEST ELEVATION - RIDGES BUILDING #30 - UNIT 1901

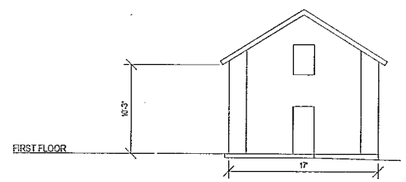

SCALE: 1/8" = 1' 0"

SOUTH ELEVATION - RIDGES BUILDING #30 - UNIT 1901

NO.	DATE	BY	DESCRIPTION

237 NORTH MAIN STREET
ADRIAN, MI 49221
TEL: 517.263.4515
FAX: 517.263.4556

PROJECT DATE: 09/12/2025
PROJECT NO.: 2500682
DRAWN BY: CDH
CHECKED BY: PW


Mannik Smith Group
www.MannikSmithGroup.com

PREPARED FOR:
OHIO UNIVERSITY
ATHENS, OHIO 45701

OHIO UNIVERSITY
RIDGES SURVEY
118 RIDGES CIRCLE,
ATHENS, OHIO 45701


RIDGES BUILDING
#30 ELEVATIONS

46 / 64

\\MSGFILESRV\MSGData\Projects\2025\600-799\2500682\CAD\SURV\2500682_ELEV.dwg - Last printed 4/6/2026 2:23 PM


202600004125
FILED FOR RECORD IN
ATHENS COUNTY, OHIO
JESSICA MARKINS, RECORDER
09/10/2026 02:39:59 PM
OR BOOK: 639 PAGE: 308
LARGE PLAT ... 64-40 ... PG: 1

Envelope 611 A

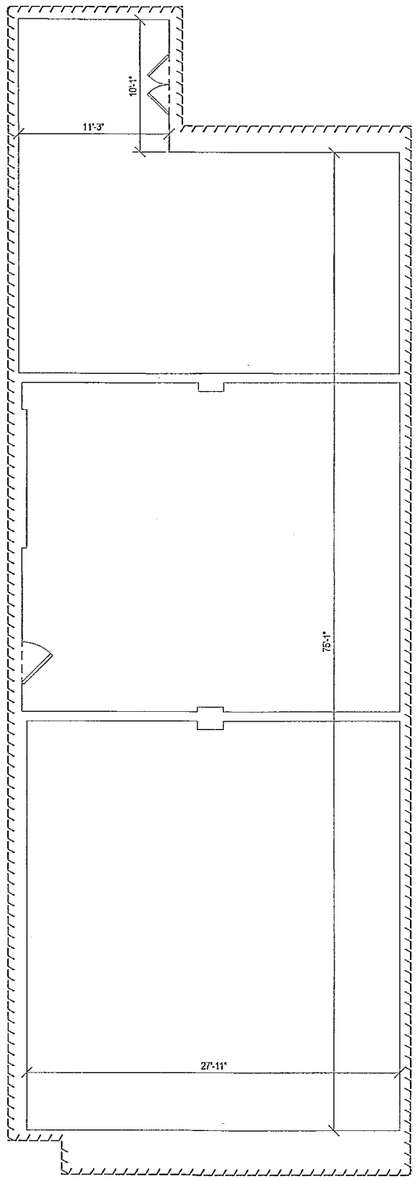

SCALE: $\frac{3}{16}$" = 1' 0"

FLOOR PLAN - RIDGES BUILDING #31 - UNIT 2001

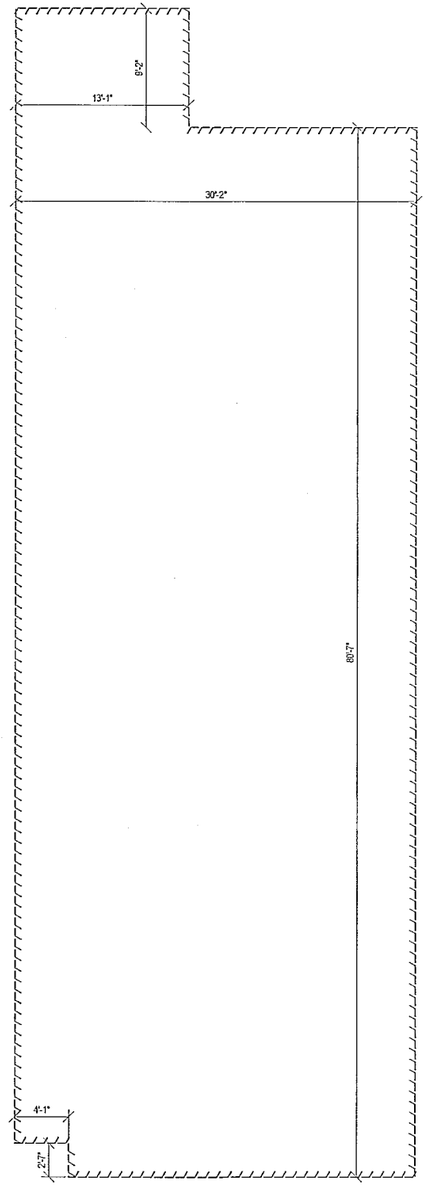

SCALE: $\frac{3}{16}$" = 1' 0"

BUILDING DIMENSIONS - RIDGES BUILDING #31 - UNIT 2001

237 NORTH MAIN STREET
ADRIAN, MI 49221
TEL: 517.263.4515
FAX: 517.263.4535

TECHNICAL SKILL.
CREATIVE SPIRIT.

Mannik Smith Group
www.MannikSmithGroup.com

NO.	DATE	BY	DESCRIPTION

PROJECT DATE: 09/17/2025
PROJECT NO.: 2500682
DRAWN BY: CDN
CHECKED BY: PW

PREPARED FOR:
OHIO UNIVERSITY
ATHENS, OHIO 45701

OHIO UNIVERSITY
RIDGES SURVEY
118 RIDGES CIRCLE,
ATHENS, OHIO 45701


RIDGES BUILDING #31
FLOOR PLAN &
BUILDING DIMENSIONS

47 / 64


\\MSGFILESRV\MSGData\Projects\2025\600-799\2500682\CAD\SURV\2500682_BLDG.dwg - Last printed 4/6/2026 2:23 PM

2026000041126
FILED FOR RECORD IN
ATHENS COUNTY, OHIO
JESSICA WARKINS, RECORDER
09/10/2026 02:30:59 PM
OR BOOK: 639 PAGE: 309
LARGE PLAT 88,40 PG: 1


Envelope
Cell 4

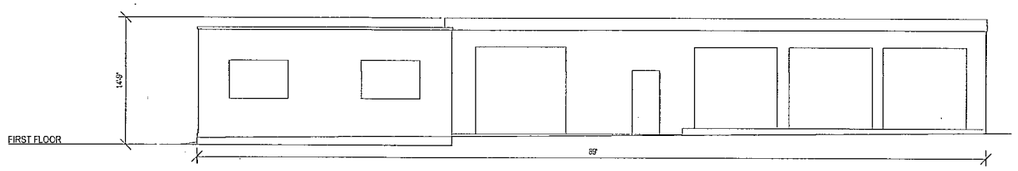


SCALE: $\frac{1}{8}$" = 1' 0" NORTH ELEVATION - RIDGES BUILDING #31 - UNIT 2001

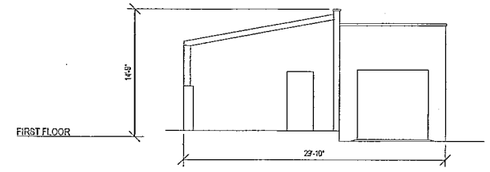

SCALE: $\frac{1}{8}$" = 1' 0" SOUTH ELEVATION - RIDGES BUILDING #31 - UNIT 2001

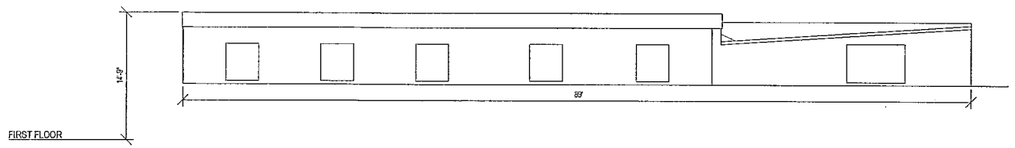

SCALE: $\frac{1}{8}$" = 1' 0" NORTH ELEVATION - RIDGES BUILDING #31 - UNIT 2001

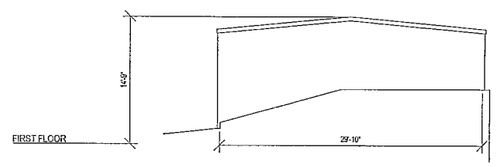

SCALE: $\frac{1}{8}$" = 1' 0" SOUTH ELEVATION - RIDGES BUILDING #31 - UNIT 2001

237 NORTH MAIN STREET
ADRIAN, MI 49221
TEL: 517.263.4515
FAX: 517.263.4535

NO.	DATE	BY	DESCRIPTION

PROJECT DATE: 08/12/2025
PROJECT NO.: 2500382
DRAWN BY: CDN
CHECKED BY: PW

Mannik Smith Group

www.MannikSmithGroup.com

PREPARED FOR:
OHIO UNIVERSITY
ATHENS, OHIO 45701

OHIO UNIVERSITY
RIDGES SURVEY
118 RIDGES CIRCLE,
ATHENS, OHIO 45701


RIDGES BUILDING
#31 ELEVATIONS

48 / 64

\\MSGFILESRV\MSGData\Projects\2025\600-799\2500682\CAD\SURV\2500682_ELEV.dwg - Last printed 4/6/2026 2:23 PM


Envelope 6128

202600004127
FILED FOR RECORD IN
ATHENS COUNTY, OHIO
JESSICA WARKINS, RECORDER
09/10/2026 02:31:00 PM
OR BOOK: 639 PAGE: 310
LARGE PLAT 86.40 PG: 1

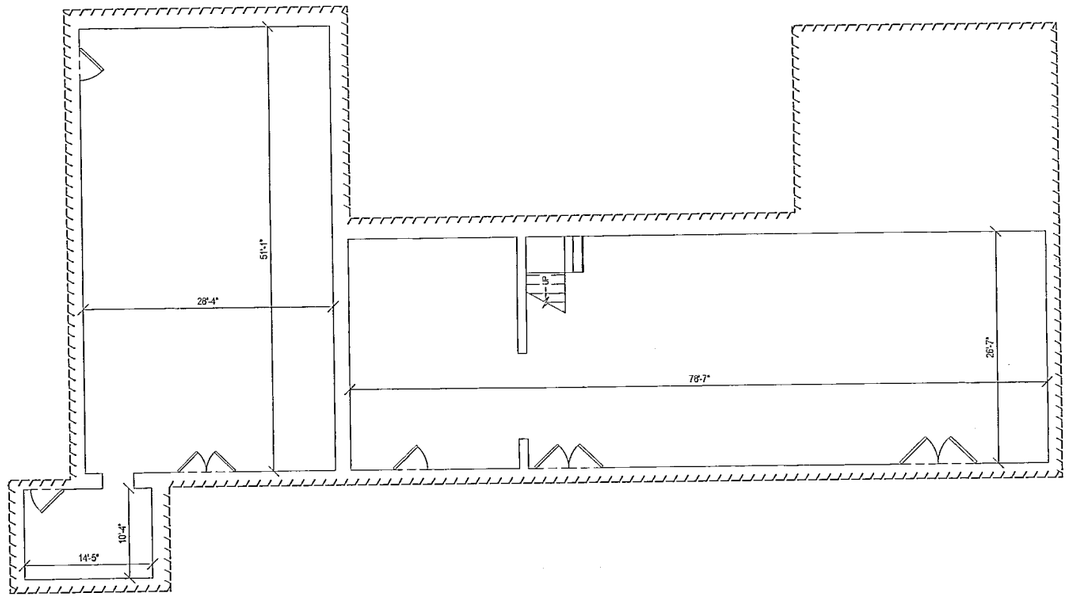


SCALE: $\frac{1}{8}$" = 1' 0"

FIRST FLOOR PLAN - RIDGES BUILDING #32 - UNIT 2101

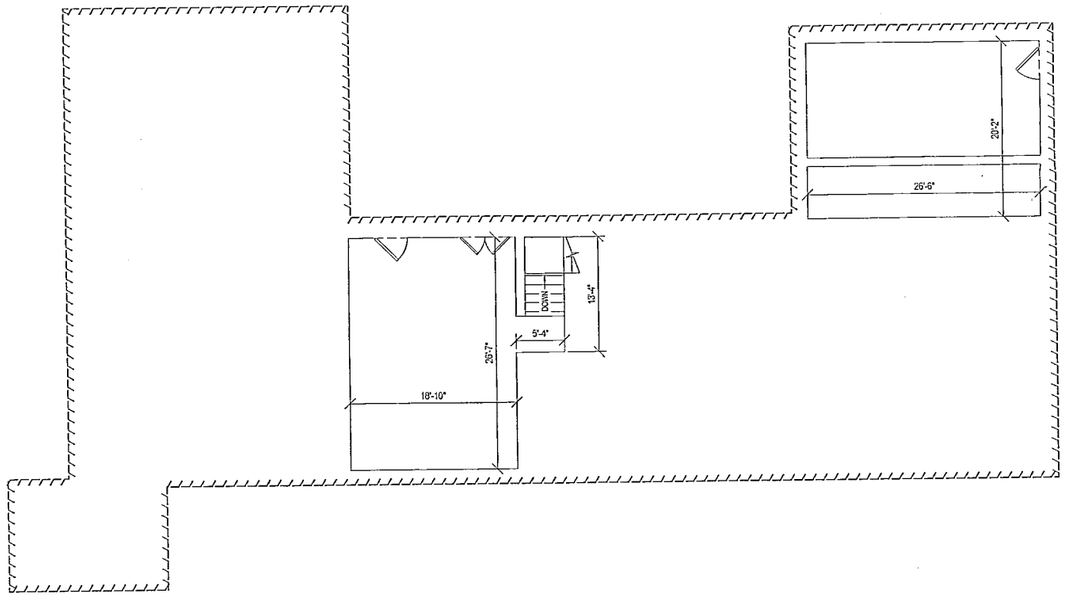

SCALE: $\frac{1}{8}$" = 1' 0"

SECOND FLOOR PLAN - RIDGES BUILDING #32 - UNIT 2101

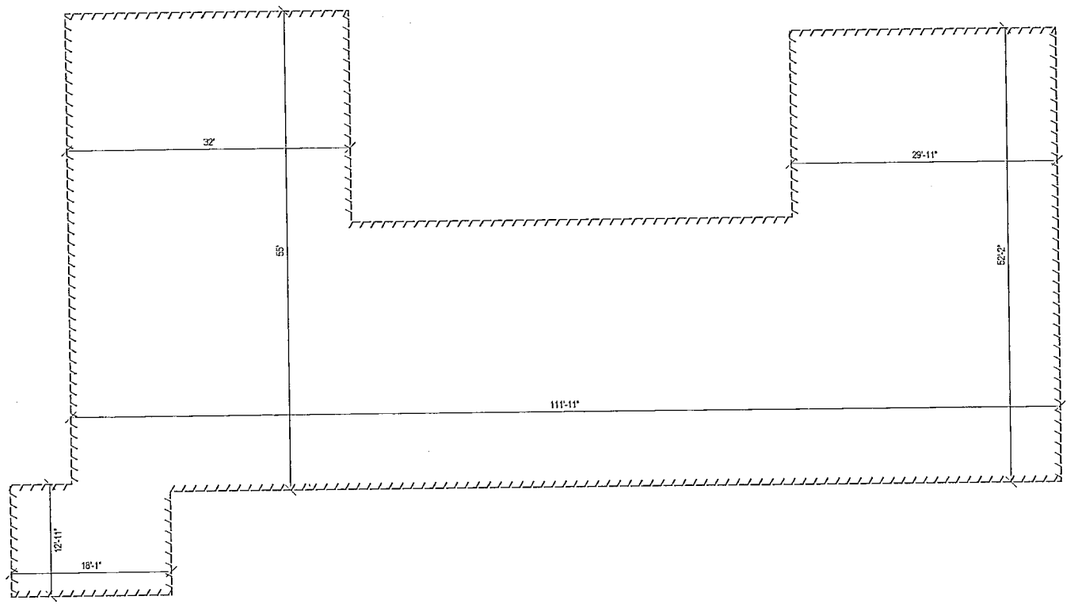

SCALE: $\frac{1}{8}$" = 1' 0"

BUILDING DIMENSIONS - RIDGES BUILDING #32 - UNIT 2101

Mannik Smith Group
TECHNICAL SKILL. CREATIVE SPIRIT.
237 NORTH MAIN STREET
ADRIAN, MI 49221
TEL: 517.263.4516
FAX: 517.263.4536
www.MannikSmithGroup.com

NO.	DATE	BY	DESCRIPTION

PROJECT DATE: 09/10/2025
PROJECT NO.: 2500682
DRAWN BY: CDH
CHECKED BY: PW

PREPARED FOR:
OHIO UNIVERSITY
ATHENS, OHIO 45701

OHIO UNIVERSITY
RIDGES SURVEY
118 RIDGES CIRCLE,
ATHENS, OHIO 45701


RIDGES BUILDING #32
FLOOR PLAN &
BUILDING DIMENSIONS

49 / 64

\\MSGFILESRV\MSGData\Projects\2025\600-799\2500682\CAD\SURV\2500682_BLDG.dwg - Last printed 4/6/2026 2:23 PM


202600004128
FILED FOR RECORD IN
ATHENS COUNTY, OHIO
JESSICA HAWKINS, RECORDER
03/10/2026 02:31:01 PM
OR BOOK: 639 PAGE: 311

Envelope
6 12 B

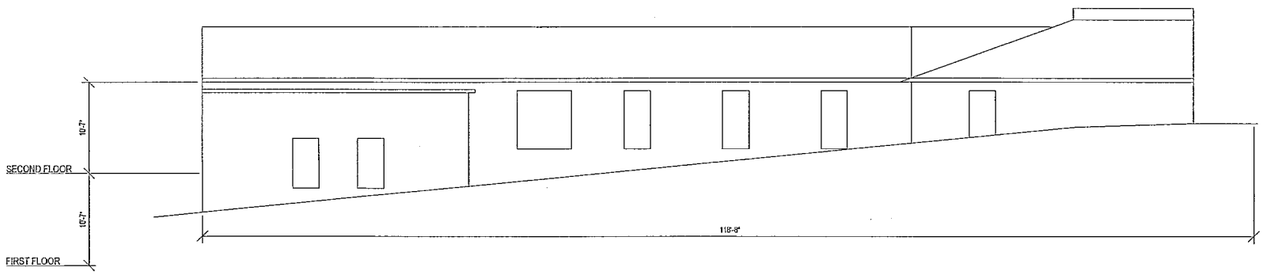


SCALE: 1/8" = 1' 0"

NORTH ELEVATION - RIDGES BUILDING #32 - UNIT 2101

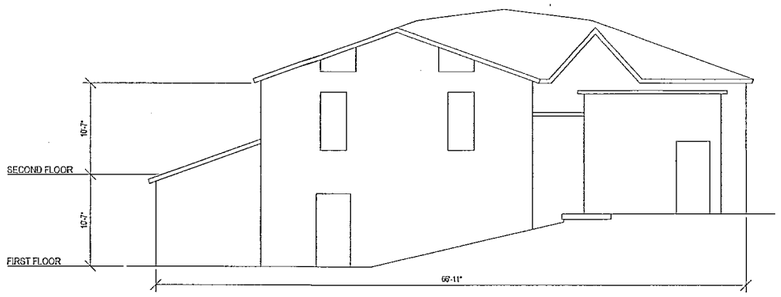


SCALE: 1/8" = 1' 0"

EAST ELEVATION - RIDGES BUILDING #32 - UNIT 2101

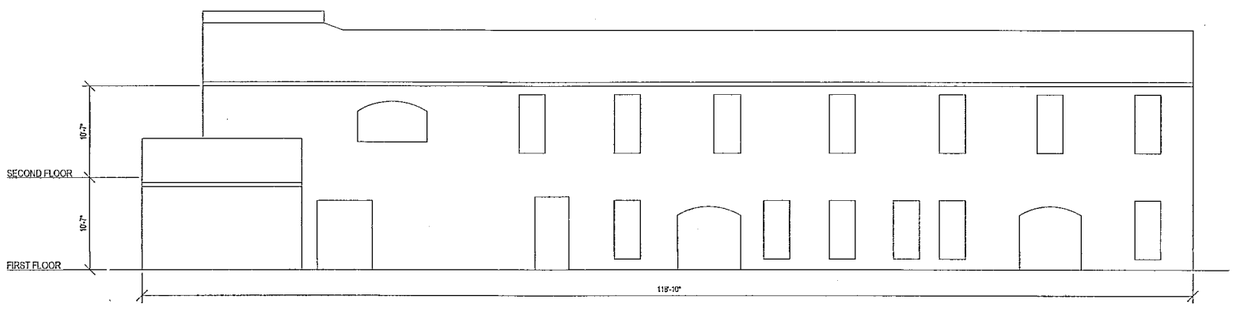

SCALE: 1/8" = 1' 0"

SOUTH ELEVATION - RIDGES BUILDING #32 - UNIT 2101

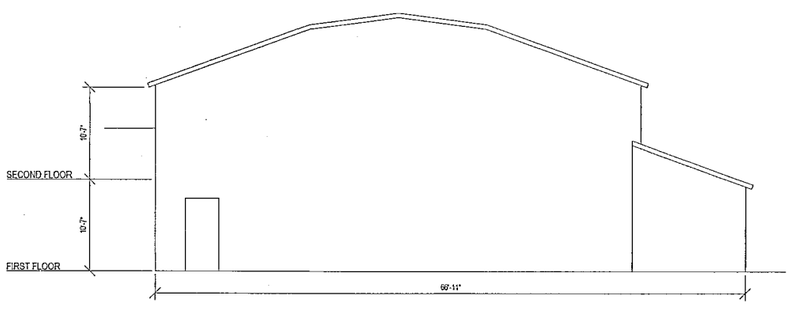

SCALE: 1/8" = 1' 0"

WEST ELEVATION - RIDGES BUILDING #32 - UNIT 2101

237 NORTH MAIN STREET
ADRIAN, MI 49221
TEL: 517.263.4515
FAX: 517.263.4535

NO.	DATE	BY	DESCRIPTION

PROJECT DATE: 09/12/2025
PROJECT NO.: 2500682
DRAWN BY: CDH
CHECKED BY: PW

TECHNICAL SKILL.

Mannik Smith Group
www.MannikSmithGroup.com

PREPARED FOR:
OHIO UNIVERSITY
ATHENS, OHIO 45701

OHIO UNIVERSITY
RIDGES SURVEY
118 RIDGES CIRCLE,
ATHENS, OHIO 45701


RIDGES BUILDING
#32 ELEVATIONS

50 / 64

\\MSGFILESRV\MSGData\Projects\2025\600-799\2500682\CAD\SURV\2500682_ELEV.dwg - Last printed 4/6/2026 2:23 PM


Envelope
415 A

2026000041129
FILED FOR RECORD IN
ATHENS COUNTY, OHIO
JESSICA HAWKINS, RECORDER
09/10/2026 02:31:02 PM
OR BOOK: 639 PAGE: 312

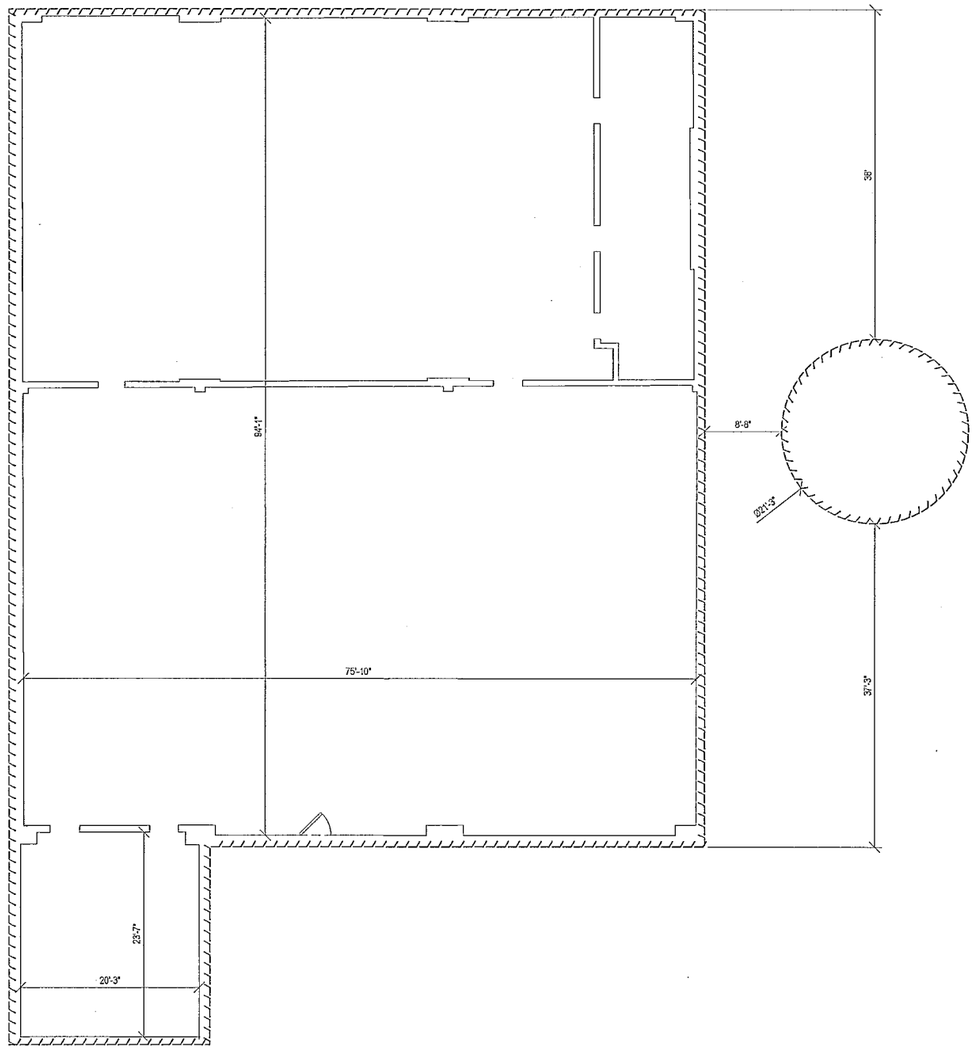

SCALE: $\frac{1}{8}$" = 1' 0"

FLOOR PLAN - RIDGES BUILDING #33 - UNIT 2201

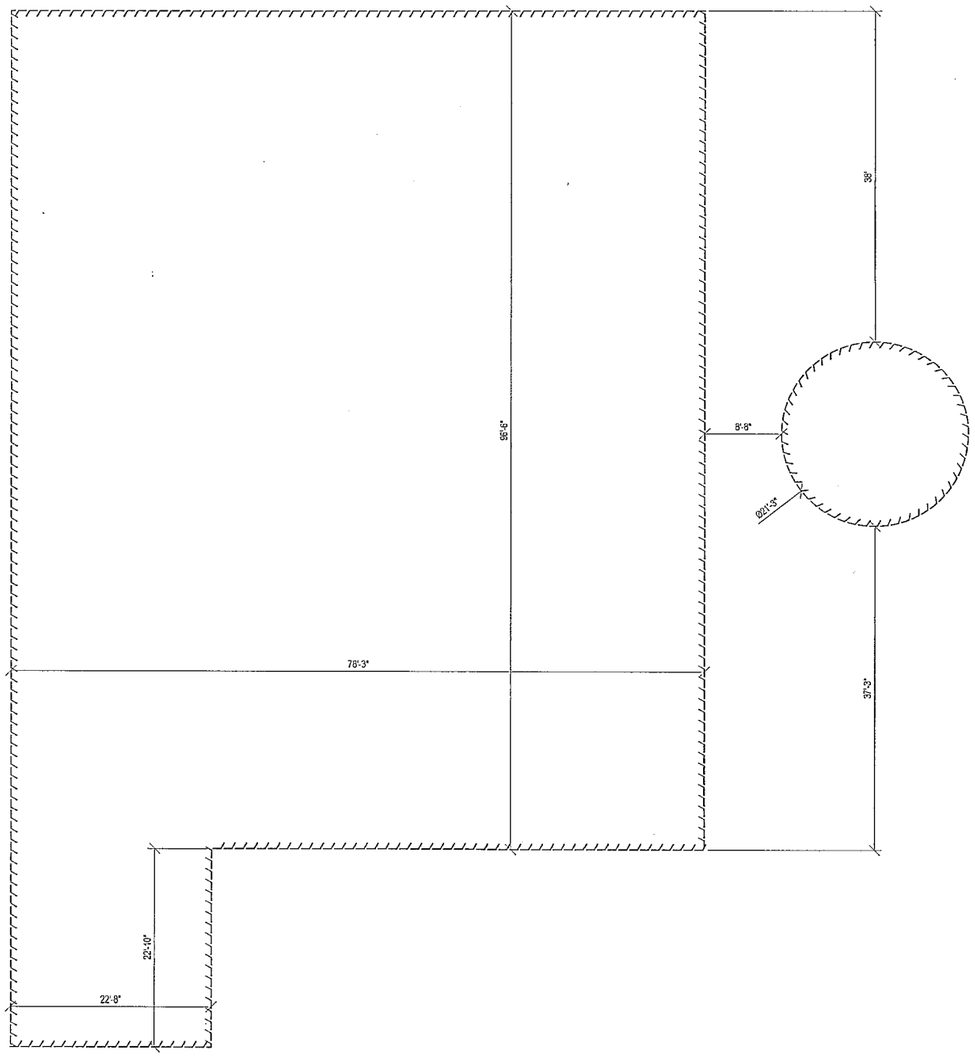

SCALE: $\frac{1}{8}$" = 1' 0"

BUILDING DIMENSIONS - RIDGES BUILDING #33 - UNIT 2201

237 NORTH MAIN STREET
ADRIAN, MI 49221
TEL: 517.263.4515
FAX: 517.263.4535

TECHNICAL SKILL.
CREATIVE SPIRIT.

Mannik Smith Group
www.MannikSmithGroup.com

NO.	DATE	BY	DESCRIPTION

PROJECT DATE: 09/12/2025
PROJECT NO.: 2500882
DRAWN BY: CDH
CHECKED BY: PWI

PREPARED FOR:
OHIO UNIVERSITY
ATHENS, OHIO 45701

OHIO UNIVERSITY
RIDGES SURVEY
118 RIDGES CIRCLE,
ATHENS, OHIO 45701


RIDGES BUILDING #33
FLOOR PLAN &
BUILDING DIMENSIONS

51 / 64


\\MSGFILESRV\MSGData\Projects\2025\600-799\2500882\CAD\SURV\2500882_BLDG.dwg - Last printed 4/6/2026 2:23 PM

202600004130
FILED FOR RECORD IN
ATHENS COUNTY, OHIO
JESSICA HAWKINS, RECORDER
02/10/2026 02:31:03 PM
OR BOOK: 639 PAGE: 313
LARGE PLAT 24.40 Pgs: 1


Envelope 613B

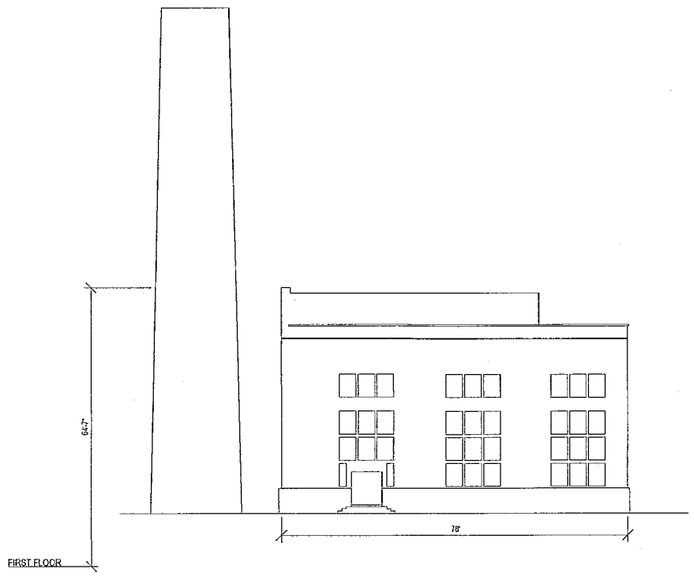


SCALE: $\frac{1}{16}$" = 1' 0" NORTH ELEVATION - RIDGES BUILDING #33 - UNIT 2201

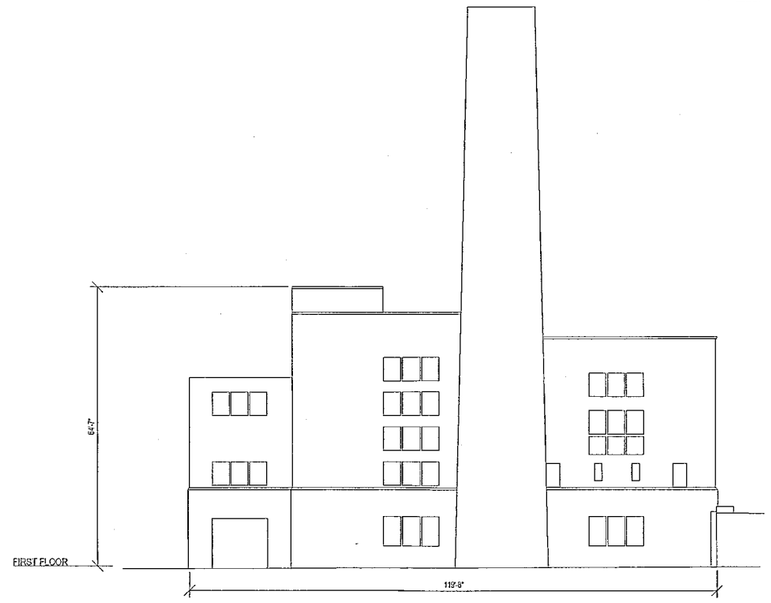

SCALE: $\frac{1}{16}$" = 1' 0" EAST ELEVATION - RIDGES BUILDING #33 - UNIT 2201

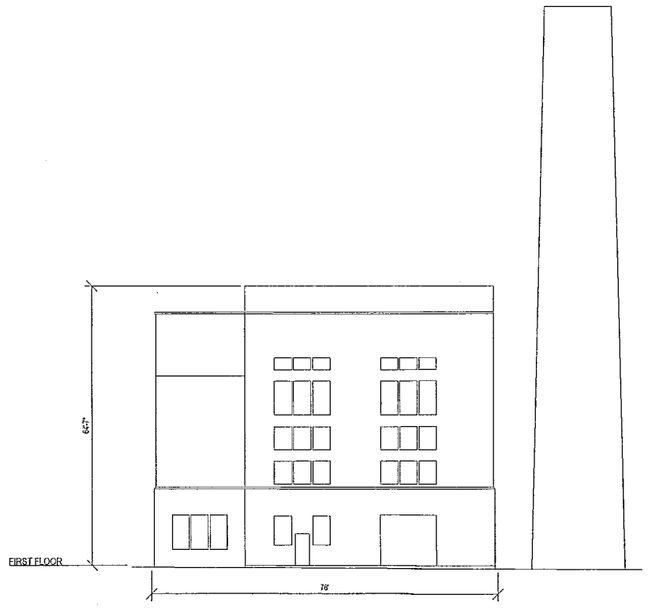

SCALE: $\frac{1}{16}$" = 1' 0" SOUTH ELEVATION - RIDGES BUILDING #33 - UNIT 2201

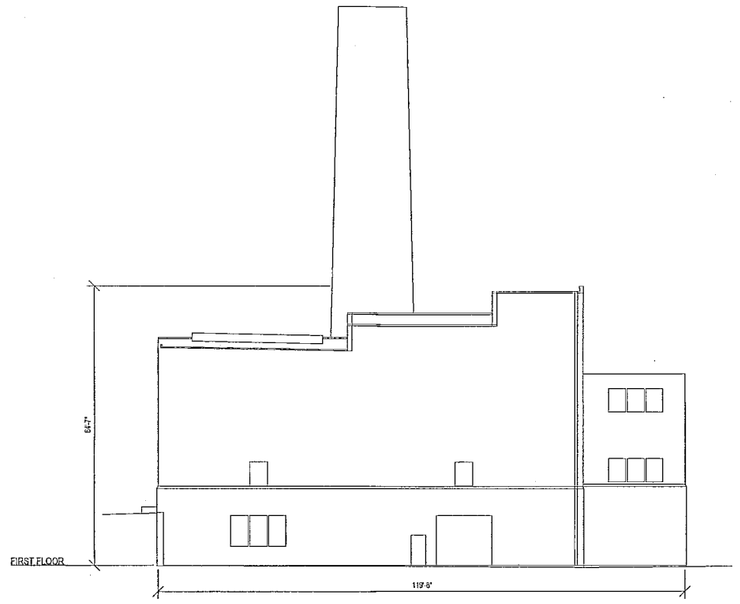

SCALE: $\frac{1}{16}$" = 1' 0" WEST ELEVATION - RIDGES BUILDING #33 - UNIT 2201


NO.	DATE	BY	DESCRIPTION

PROJECT DATE: 03/12/2025
PROJECT NO.: 2500682
DRAWN BY: CDH
CHECKED BY: PW

Mannik Smith Group
TECHNICAL SKILL. CREATIVE SPIRIT.
www.MannikSmithGroup.com

PREPARED FOR:
OHIO UNIVERSITY
ATHENS, OHIO 45701

OHIO UNIVERSITY
RIDGES SURVEY
118 RIDGES CIRCLE,
ATHENS, OHIO 45701


RIDGES BUILDING
#33 ELEVATIONS

52 / 64

\\MSGFILESRV\MSGData\Projects\2025\600-799\2500682\CAD\SURV\2500682_ELEV.dwg - Last printed 4/6/2026 2:23 PM


202600004131
FILED FOR RECORD IN
ATHENS COUNTY, OHIO
JESSICA MARKINS, RECORDER
09/10/2026 02:31:04 PM
OR BOOK: 639 PAGE: 314

Envelope 614 A

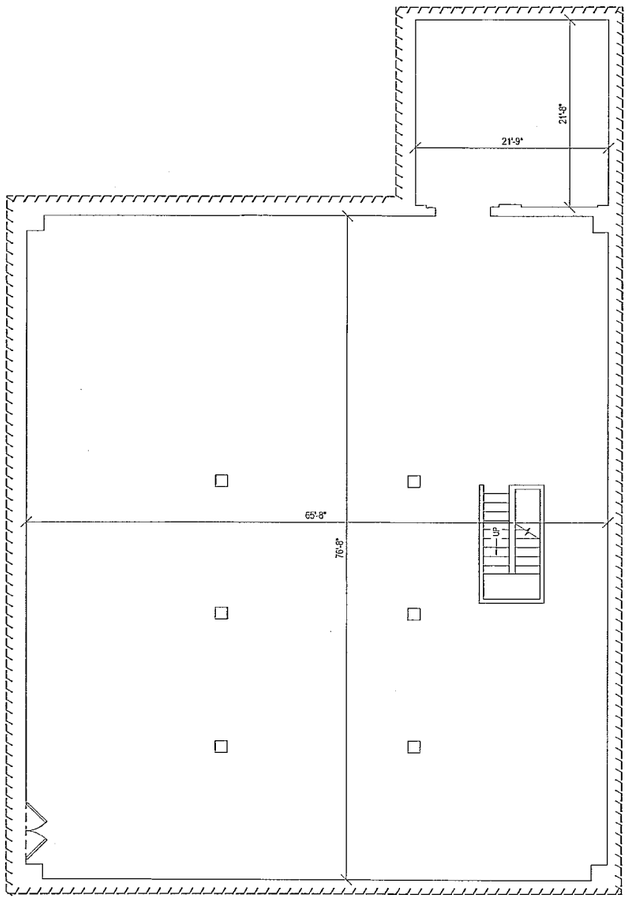


SCALE: 1/8" = 1' 0"

FIRST FLOOR PLAN - RIDGES BUILDING #34 - UNIT 2301

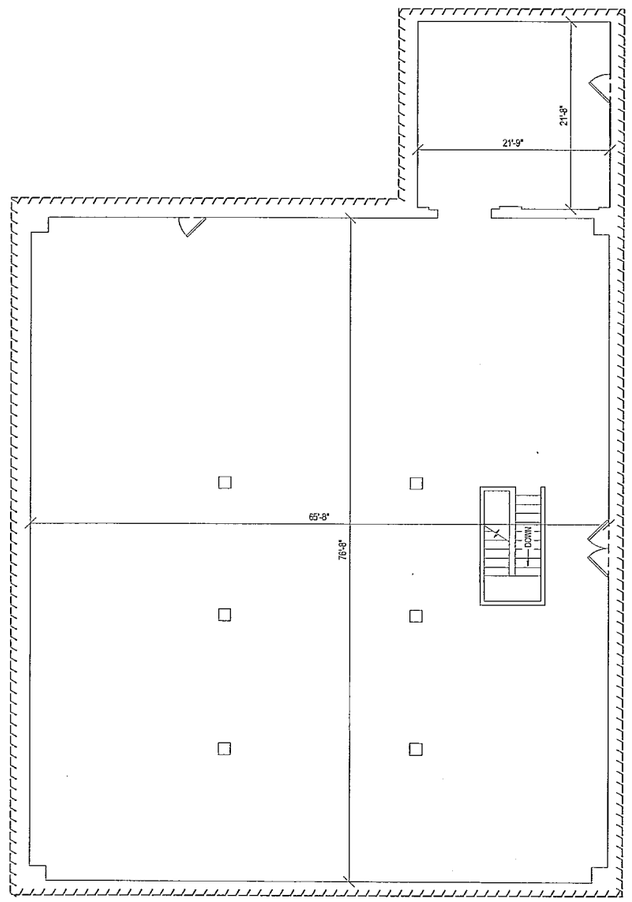

SCALE: 1/8" = 1' 0"

SECOND FLOOR PLAN - RIDGES BUILDING #34 - UNIT 2301

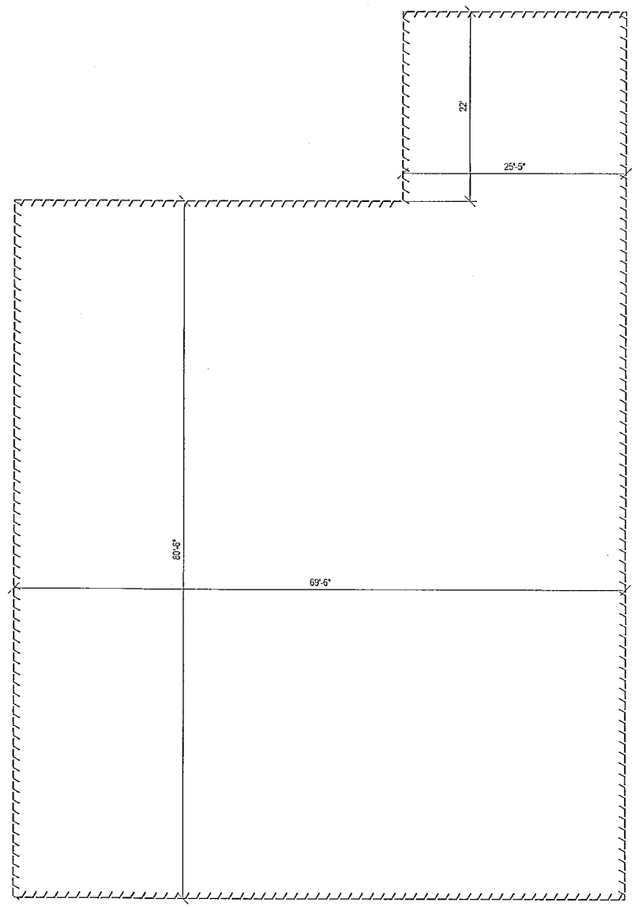

SCALE: 1/8" = 1' 0"

BUILDING DIMENSIONS - RIDGES BUILDING #34 - UNIT 2301

237 NORTH MAIN STREET
TEL: 517.263.4545
FAX: 517.263.4535

TECHNICAL SKILL. CREATIVE SPIRIT.

Mannik Smith Group

www.MannikSmithGroup.com

NO.	DATE	BY:	DESCRIPTION

PROJECT DATE: 09/12/2025
PROJECT NO.: 2500682
DRAWN BY: CDH
CHECKED BY: PW

PREPARED FOR:
OHIO UNIVERSITY
ATHENS, OHIO 45701


OHIO UNIVERSITY
RIDGES SURVEY
118 RIDGES CIRCLE,
ATHENS, OHIO 45701

RIDGES BUILDING #34
FLOOR PLAN &
BUILDING DIMENSIONS

53 / 64


\\MSGFILESRV\MSGData\Projects\2025\600-799\2500682\CAD\SURV\2500682_BLDG.dwg - Last printed 4/6/2026 2:23 PM

202600004132
FILED FOR RECORD IN
ATHENS COUNTY, OHIO
JESSICA MARKINS, RECORDER
09/10/2026 02:31:05 PM
OR BOOK: 639 PAGE: 315
LARGE PLAT

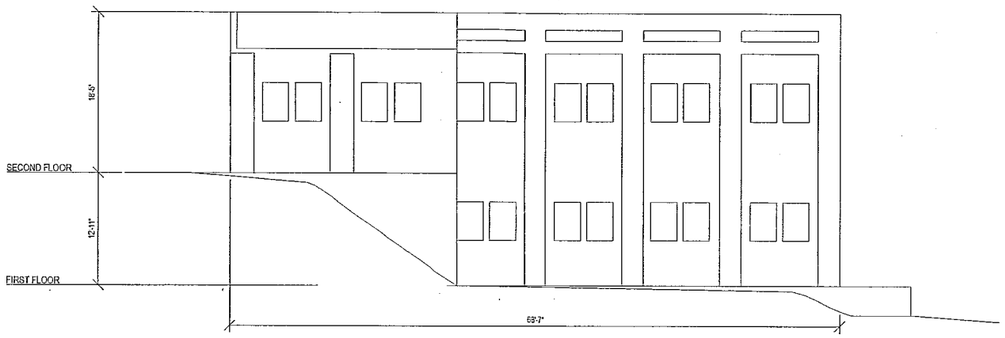


SCALE: $\frac{1}{8}$" = 1' 0"

WEST ELEVATION - RIDGES BUILDING #34 - UNIT 2301

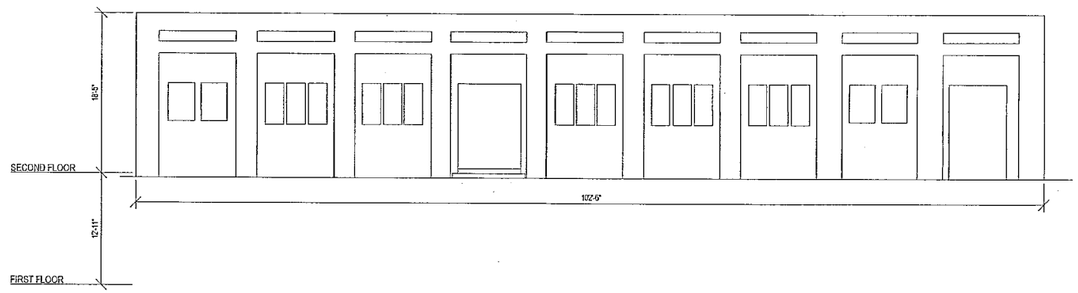


SCALE: $\frac{1}{8}$" = 1' 0"

NORTH ELEVATION - RIDGES BUILDING #34 - UNIT 2301

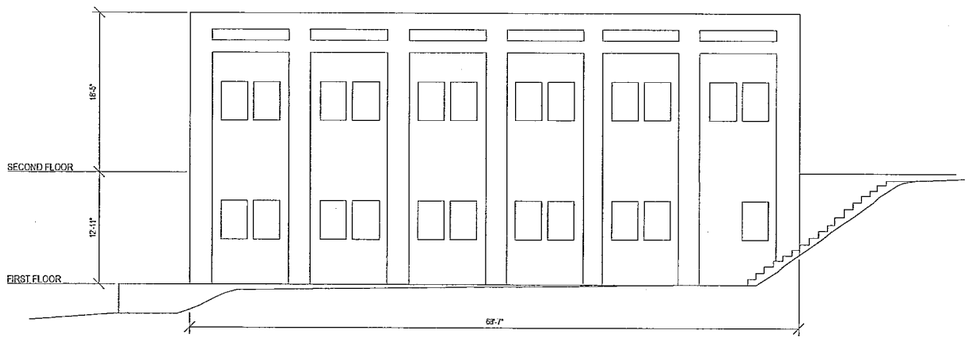

SCALE: $\frac{1}{8}$" = 1' 0"

EAST ELEVATION - RIDGES BUILDING #34 - UNIT 2301

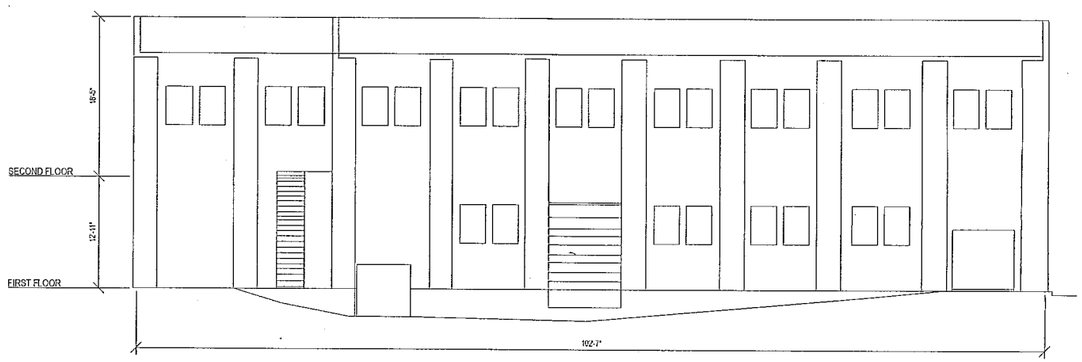

SCALE: $\frac{1}{8}$" = 1' 0"

SOUTH ELEVATION - RIDGES BUILDING #34 - UNIT 2301

237 NORTH MAIN STREET
ADRIAN, MI 49221
TEL: 517.263.4515
FAX: 517.263.4535

NO.	DATE	BY	DESCRIPTION

PROJECT DATE: 09/12/2025
PROJECT NO.: 2500682
DRAWN BY: CDH
CHECKED BY: PM


Mannik Smith Group

www.MannikSmithGroup.com

PREPARED FOR:
OHIO UNIVERSITY
ATHENS, OHIO 45701

OHIO UNIVERSITY
RIDGES SURVEY
118 RIDGES CIRCLE,
ATHENS, OHIO 45701


RIDGES BUILDING
#34 ELEVATIONS

54 / 64

\\MSGFILESRV\MSGData\Projects\2025\600-799\2500682\CAD\SURV\2500682_ELEV.dwg - Last printed 4/6/2026 2:23 PM


202600004133
FILED FOR RECORD IN
ATHENS COUNTY, OHIO
JESSICA HAWKINS, RECORDER
09/10/2026 02:31:06 PM
OR BOOK: 639 PAGE: 316
LARGE PLAT

Envelope
615 A

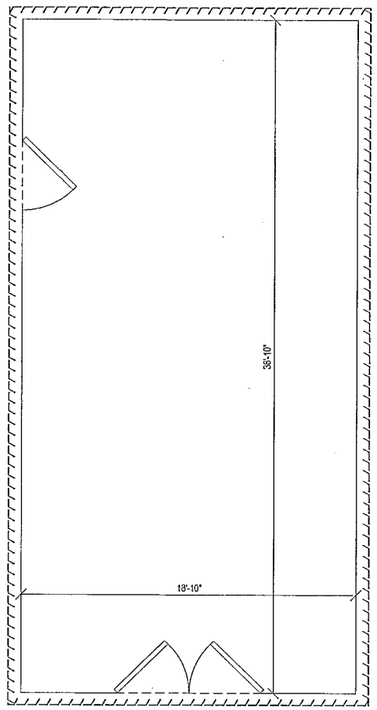

SCALE: $\frac{1}{4}$" = 1' 0"

FLOOR PLAN - RIDGES BUILDING #35 - UNIT 2401

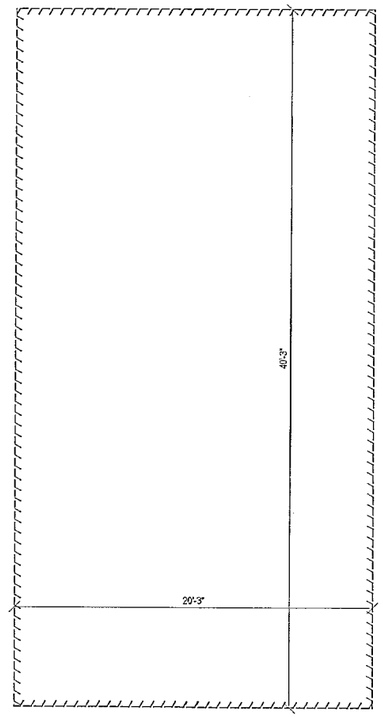

SCALE: $\frac{1}{4}$" = 1' 0"

BUILDING DIMENSIONS - RIDGES BUILDING #35 - UNIT 2401

237 NORTH MAIN STREET
ADRIAN, MI 49221
TEL: 517.263.4515
FAX: 517.263.4535

Mannik Smith Group


www.MannikSmithGroup.com

NO.	DATE	BY	DESCRIPTION

PROJECT DATE: 09/12/2025
PROJECT NO: 2500682
DRAWN BY: CDH
CHECKED BY: PM

PREPARED FOR:
OHIO UNIVERSITY
ATHENS, OHIO 45701

OHIO UNIVERSITY
RIDGES SURVEY
118 RIDGES CIRCLE,
ATHENS, OHIO 45701


RIDGES BUILDING #35
FLOOR PLAN &
BUILDING DIMENSIONS

55 / 64


\\MSGFILESRV\MSGData\Projects\2025\600-799\2500682\CAD\SURV\2500682_BLDG.dwg - Last printed 4/6/2026 2:23 PM

202600004134
FILED FOR RECORD IN
ATHENS COUNTY, OHIO
JESSICA MARKINS, RECORDER
09/10/2026 02:31:07 PM
OR BOOK: 639 PAGE: 317
LARGE PLAT


Envelope 615 B

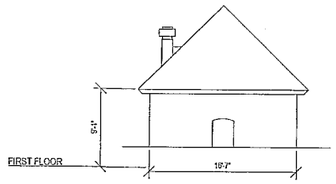


SCALE: 1/8" = 1' 0" NORTH ELEVATION - RIDGES BUILDING #35 - UNIT 2401

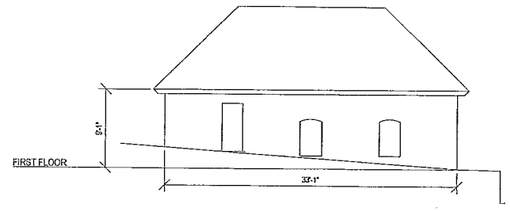

SCALE: 1/8" = 1' 0" EAST ELEVATION - RIDGES BUILDING #35 - UNIT 2401

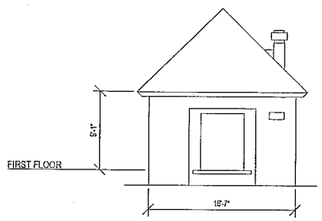

SCALE: 1/8" = 1' 0" SOUTH ELEVATION - RIDGES BUILDING #35 - UNIT 2401

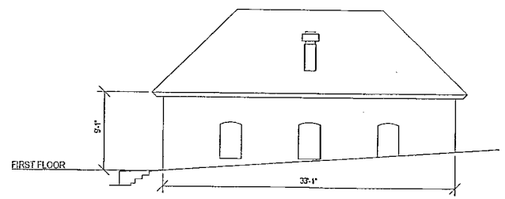

SCALE: 1/8" = 1' 0" WEST ELEVATION - RIDGES BUILDING #35 - UNIT 2401

Mannik smith group
237 NORTH MAIN STREET
ADRIAN, MI 49221
TEL: 517.263.4515
FAX: 517.263.4535
www.MannikSmithGroup.com

NO.	DATE	BY	DESCRIPTION

PROJECT DATE: 09/12/2025
PROJECT NO.: 2500682
DRAWN BY: CDH
CHECKED BY: PW

PREPARED FOR:
OHIO UNIVERSITY
ATHENS, OHIO 45701

OHIO UNIVERSITY
RIDGES SURVEY
118 RIDGES CIRCLE,
ATHENS, OHIO 45701


RIDGES BUILDING
#35 ELEVATIONS

56 / 64

\\MSGFILESRV\MSGData\Projects\2025\600-799\2500682\CAD\SURV\2500682_ELEV.dwg - Last printed 4/6/2026 2:23 PM


202600004135
FILED FOR RECORD IN
ATHENS COUNTY, OHIO
JESSICA MARKINS, RECORDER
09/10/2026 02:31:09 PM
OR BOOK: 639 PAGE: 318

Envelope 616A

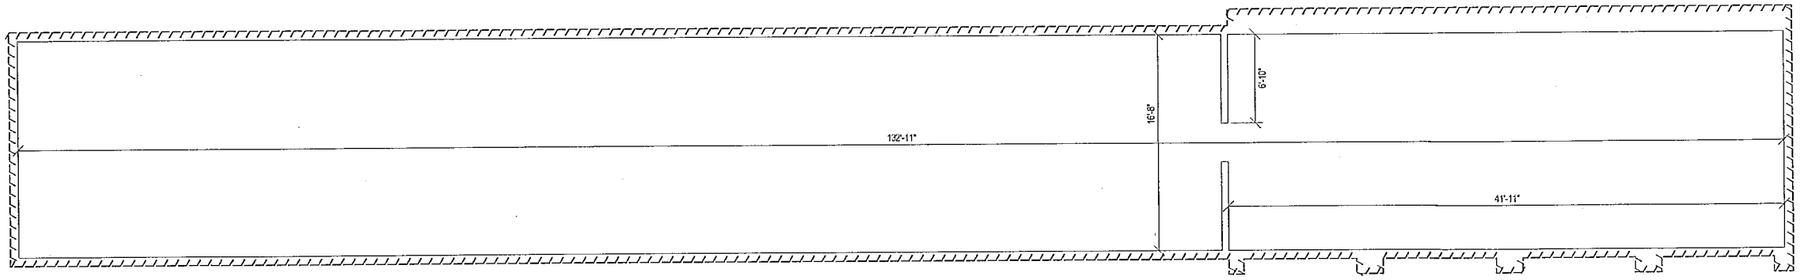

SCALE: $\frac{1}{4}$" = 1' 0"

FLOOR PLAN - RIDGES BUILDING #36 - UNIT 2501

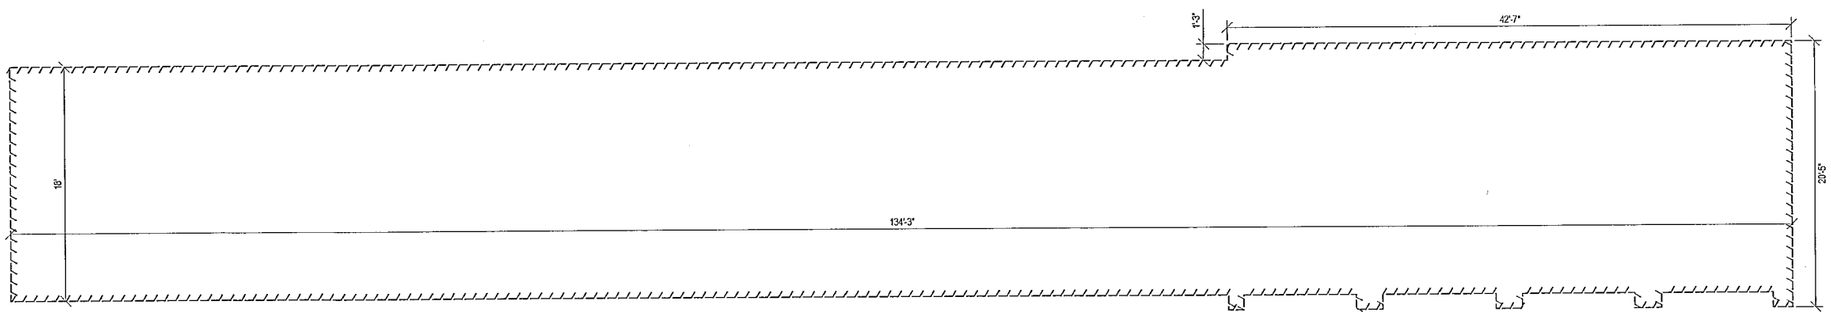

SCALE: $\frac{3}{16}$" = 1' 0"

BUILDING DIMENSIONS - RIDGES BUILDING #36 - UNIT 2501

237 NORTH MAIN STREET
ADRIAN, MI 49221
TEL: 517.263.4515
FAX: 517.263.4535

NO.	DATE	BY	DESCRIPTION

PROJECT DATE: 09/12/2025
PROJECT NO.: 2500682
DRAWN BY: CDH
CHECKED BY: PW

TECHNICAL SKILL. CREATIVE SPIRIT.

Mannik Smith Group

www.MannikSmithGroup.com

PREPARED FOR:
OHIO UNIVERSITY
ATHENS, OHIO 45701

OHIO UNIVERSITY
RIDGES SURVEY
118 RIDGES CIRCLE,
ATHENS, OHIO 45701


RIDGES BUILDING #36
FLOOR PLAN &
BUILDING DIMENSIONS

57 / 64

\\MSGFILESRV\MSGData\Projects\2025\600-799\2500682\CAD\SURV\2500682_BLDG.dwg - Last printed 4/6/2026 2:23 PM


202600004136
FILED FOR RECORD IN
ATHENS COUNTY, OHIO
JESSICA WARKINS, RECORDER
09/10/2026 02:31:09 PM
OR BOOK: 639 PAGE: 319
LARGE PLAT 86.40 PG: 1

Envelope File B

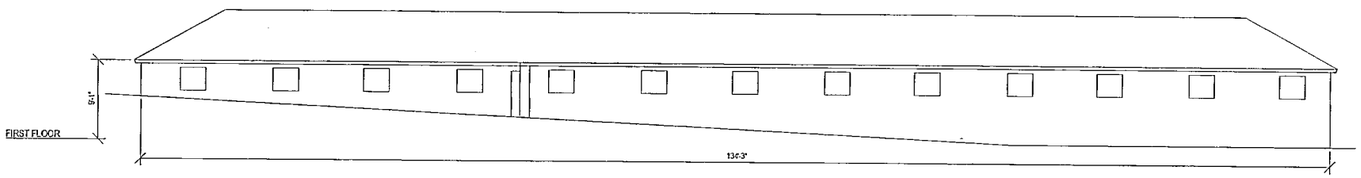


SCALE: $\frac{1}{8}$" = 1' 0"

NORTH ELEVATION - RIDGES BUILDING #36 - UNIT 2501

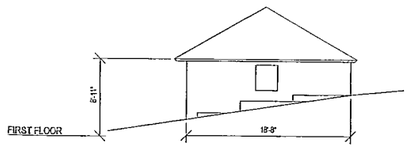


SCALE: $\frac{1}{8}$" = 1' 0" EAST ELEVATION - RIDGES BUILDING #36 - UNIT 2501

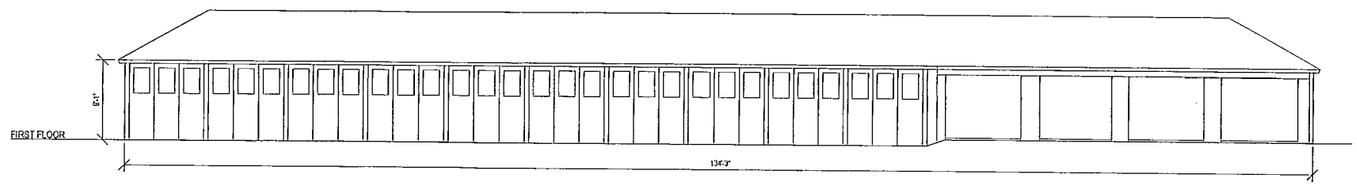

SCALE: $\frac{1}{8}$" = 1' 0"

SOUTH ELEVATION - RIDGES BUILDING #36 - UNIT 2501

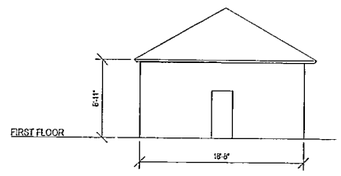

SCALE: $\frac{1}{8}$" = 1' 0" WEST ELEVATION - RIDGES BUILDING #36 - UNIT 2501

237 NORTH MAIN STREET
ADRIAN, MI 49221
TEL: 517.263.4515
FAX: 517.263.4535

NO.	DATE	BY	DESCRIPTION

PROJECT DATE: 08/12/2025
PROJECT NO: 2500682
DRAWN BY: CDH
CHECKED BY: PWT

TECHNICAL SKILL. OBSERVABLE BENEFIT.

Mannik Smith Group

www.MannikSmithGroup.com

PREPARED FOR:
OHIO UNIVERSITY
ATHENS, OHIO 45701


OHIO UNIVERSITY
RIDGES SURVEY
118 RIDGES CIRCLE,
ATHENS, OHIO 45701

RIDGES BUILDING
#36 ELEVATIONS


58 / 64

\\MSGFILESRV\MSGData\Projects\20251600-79\2500682\CAD\SURV\2500682_ELEV.dwg - Last printed 4/6/2026 2:23 PM


20260000458 4138
FILED FOR RECORD IN
ATHENS COUNTY, OHIO
JESSICA WATKINS, RECORDER
03/10/2026 02:23:07 PM
OR BOOK: 639 PAGE: 320
Envelope 617A

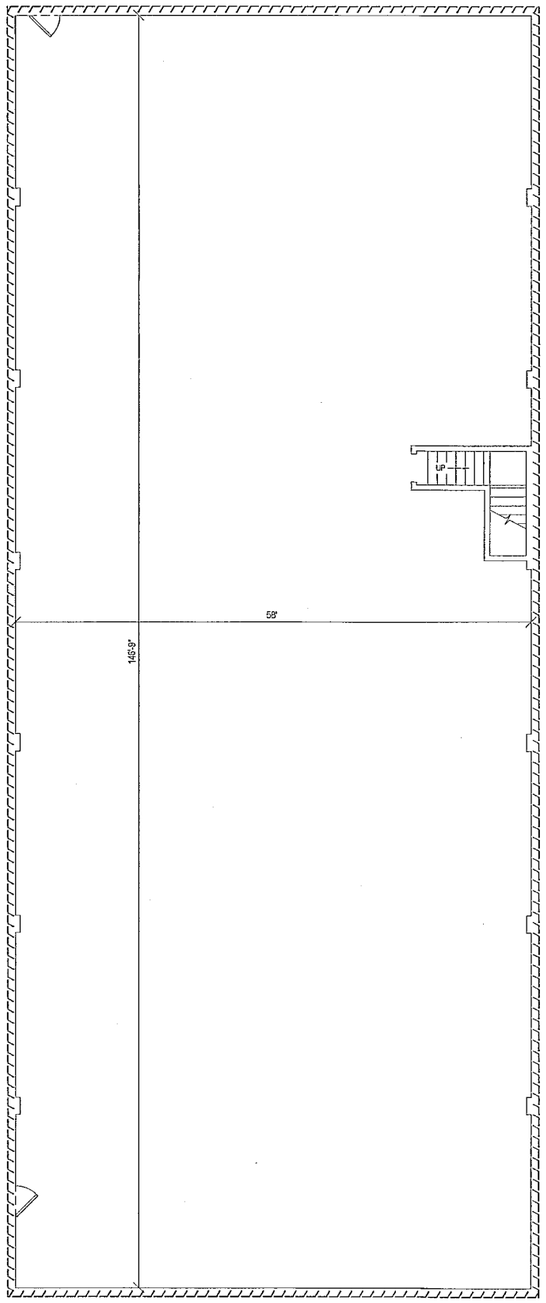

SCALE: $\frac{1}{8}$" = 1' 0" FIRST FLOOR PLAN - RIDGES BUILDING #37 - UNIT 2601

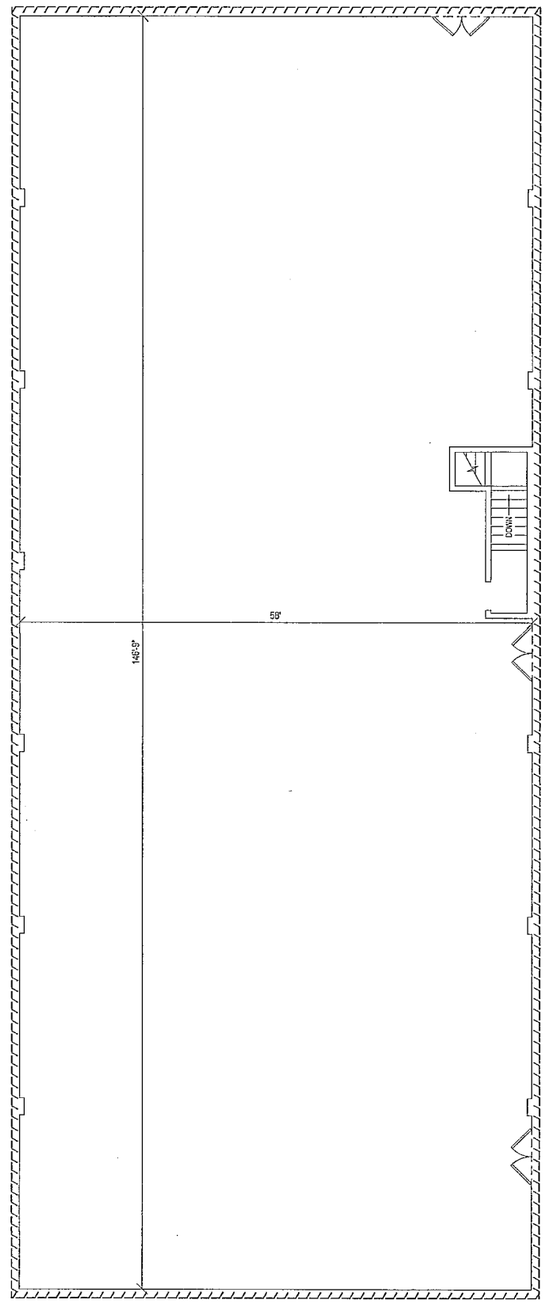

SCALE: $\frac{1}{8}$" = 1' 0" SECOND FLOOR PLAN - RIDGES BUILDING #37 - UNIT 2601

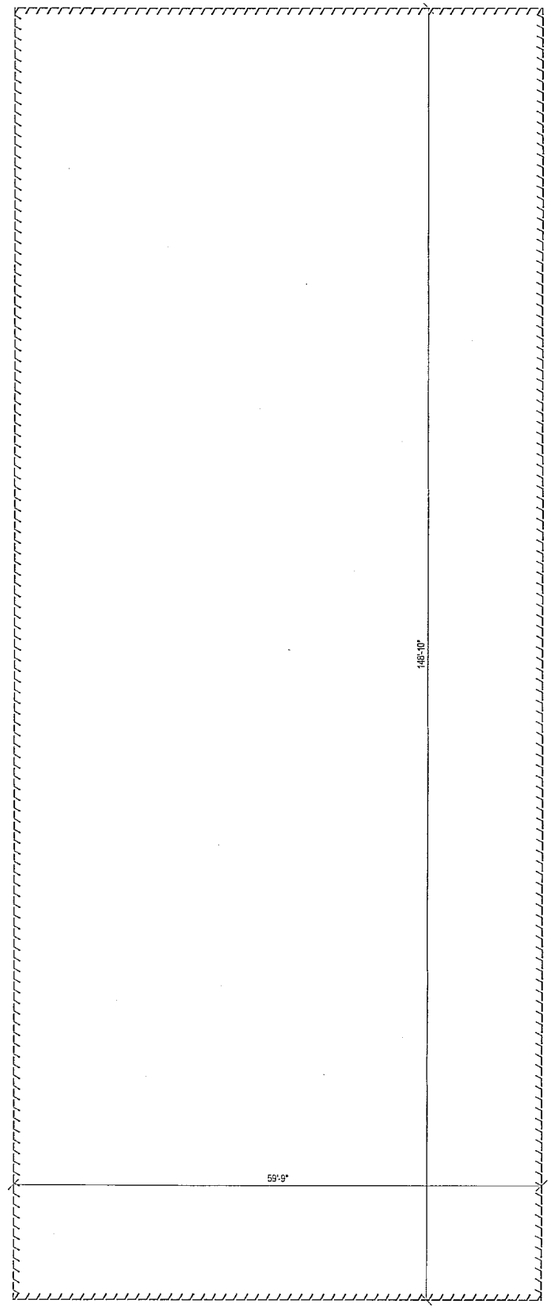

SCALE: $\frac{1}{8}$" = 1' 0" BUILDING DIMENSIONS - RIDGES BUILDING #37 - UNIT 2601

NO.	DATE	BY	DESCRIPTION

237 NORTH MAIN STREET
ADRIAN, MI 49221
TEL: 517.263.4515
FAX: 517.263.4535

TECHNICAL SKILL. CREATIVE DESIGN.

Mannik Smith Group

www.MannikSmithGroup.com

PROJECT DATE: 09/12/2025
PROJECT NO.: 2506862
DRAWN BY: CDH
CHECKED BY: PW

PREPARED FOR:
OHIO UNIVERSITY
ATHENS, OHIO 45701

OHIO UNIVERSITY
RIDGES SURVEY
118 RIDGES CIRCLE,
ATHENS, OHIO 45701


RIDGES BUILDING #37
FLOOR PLAN &
BUILDING DIMENSIONS

59 / 64

I:\MSGFILESRV\MSGData\Projects\2025\600-799\2506862\CAD\SURV\2506862_BLDG.dwg - Last printed 4/6/2026 2:23 PM


Envelope 617 B

202600004138
FILED FOR RECORD IN
ATHENS COUNTY, OHIO
JESSICA HAWKINS, RECORDER
02/10/2026 02:31:11 PM
OR BOOK: 639 PAGE: 321

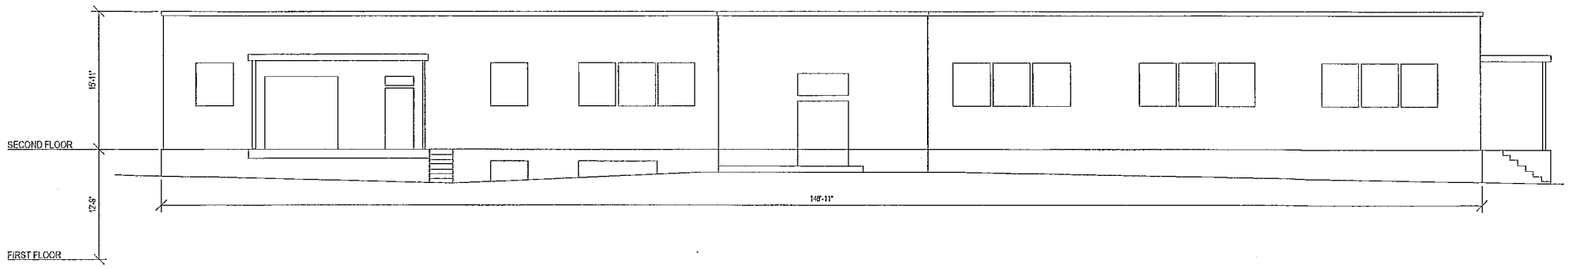


SCALE: 1/8" = 1' 0"

NORTH ELEVATION - RIDGES BUILDING #37 - UNIT 2601

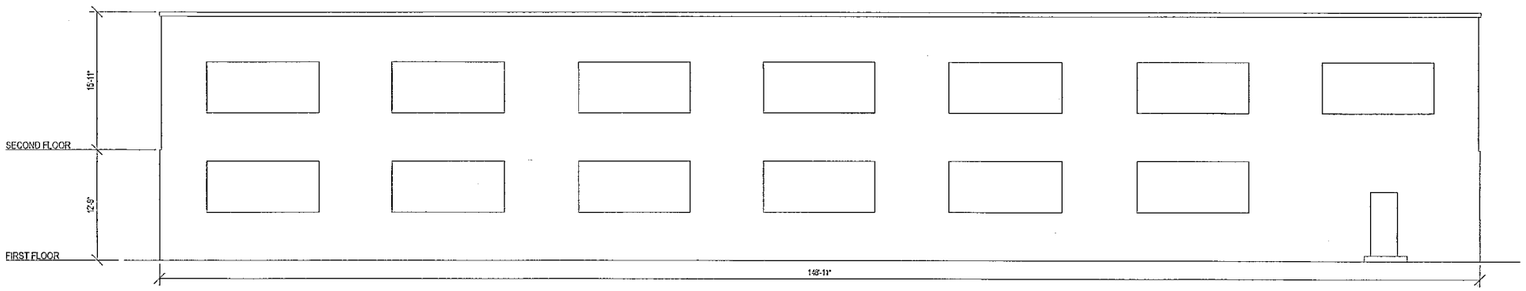


SCALE: 1/8" = 1' 0"

SOUTH ELEVATION - RIDGES BUILDING #37 - UNIT 2601

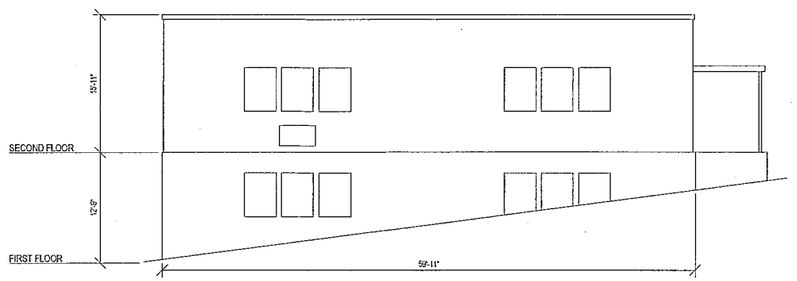

SCALE: 1/8" = 1' 0"

EAST ELEVATION - RIDGES BUILDING #37 - UNIT 2601

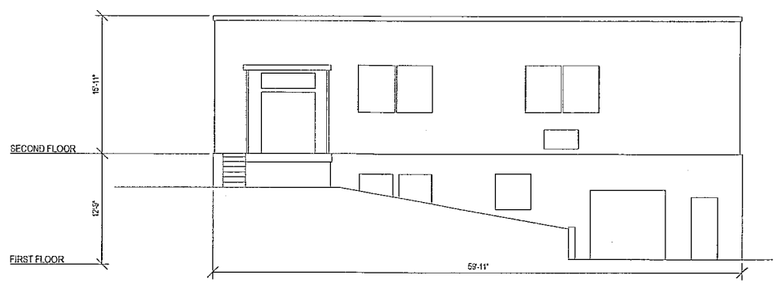

SCALE: 1/8" = 1' 0"

WEST ELEVATION - RIDGES BUILDING #37 - UNIT 2601

NO.	DATE	BY	DESCRIPTION

237 NORTH MAIN STREET
ADRIAN, MI 49221
TEL: 517.263.4515
FAX: 517.263.4655

PROJECT DATE: 09/12/2025
PROJECT NO.: 2500682
DRAWN BY: CDK
CHECKED BY: PW

TECHNICAL SKILL. GREATER GOOD.

Mannik Smith Group

www.MannikSmithGroup.com

PREPARED FOR:
OHIO UNIVERSITY
ATHENS, OHIO 45701

OHIO UNIVERSITY
RIDGES SURVEY
118 RIDGES CIRCLE,
ATHENS, OHIO 45701


RIDGES BUILDING
#37 ELEVATIONS

60 / 64


\\MSGFILESRV\MSGData\Projects\2025\600-799\2500682\CAD\SURV\2500682_ELEV.dwg - Last printed 4/6/2026 2:24 PM

2026000004139
FILED FOR RECORD IN
ATHENS COUNTY, OHIO
JESSICA MASKINS, RECORDER
02/10/2026 02:51:12 PM
OR BOOK: 639 PAGE: 322


Envelope 618 A

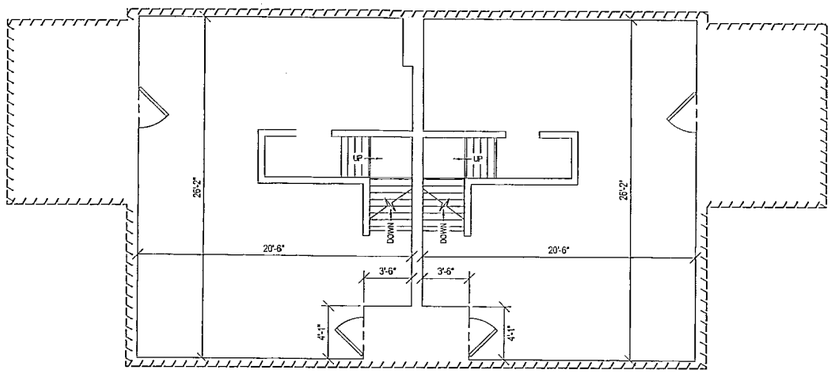


SCALE: $\frac{3}{16}$" = 1' 0" FIRST FLOOR PLAN - RIDGES BUILDING #38 & #39 - UNIT 2701 & 2801

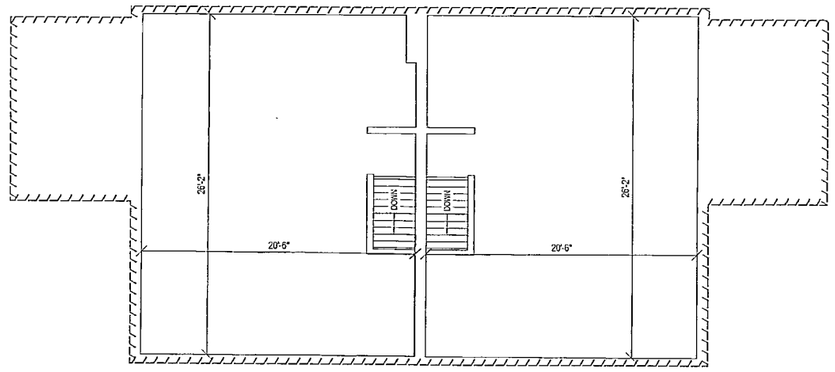

SCALE: $\frac{3}{16}$" = 1' 0" SECOND FLOOR PLAN - RIDGES BUILDING #38 & #39 - UNIT 2701 & 2801

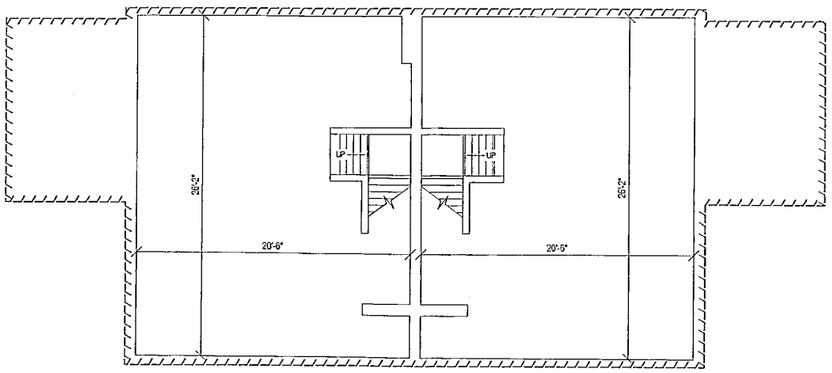

SCALE: $\frac{3}{16}$" = 1' 0" BASEMENT FLOOR PLAN - RIDGES BUILDING #38 & #39 - UNIT 2701 & 2801

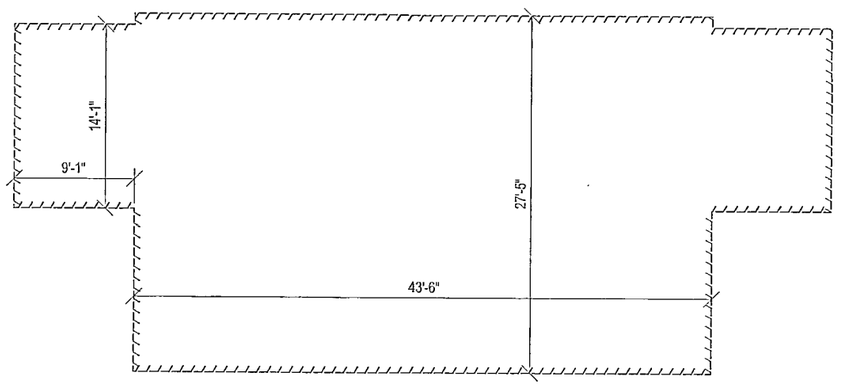

SCALE: $\frac{3}{16}$" = 1' 0" BUILDING DIMENSIONS - RIDGES BUILDING #38 & #39 - UNIT 2701 & 2801

Mannik Smith Group
TECHNICAL SKILL. CREATIVE DYNAMIC.
237 NORTH MAIN STREET
ADRIAN, MI 49221
TEL: 517.263.4515
FAX: 517.263.4535
www.MannikSmithGroup.com

NO.	DATE	BY	DESCRIPTION

PROJECT DATE: 09/12/2025
PROJECT NO.: 2500682
DRAWN BY: CDH
CHECKED BY: PW

PREPARED FOR:
OHIO UNIVERSITY
ATHENS, OHIO 45701

OHIO UNIVERSITY
RIDGES SURVEY
118 RIDGES CIRCLE,
ATHENS, OHIO 45701


RIDGES BUILDING #38 & #39
FLOOR PLAN & BUILDING
DIMENSIONS

61 / 64


\\MSGFILESRV\MSGData\Projects\2025\600-799\2500682\CAD\SURV\2500682_BLDG.dwg - Last printed 4/6/2026 2:24 PM

202600004140
FILED FOR RECORD IN
ATHENS COUNTY, OHIO
JESSICA MARKINS, RECORDER
09/10/2026 02:31:13 PM
OR BOOK: 639 PAGE: 323


Envelope 618 B

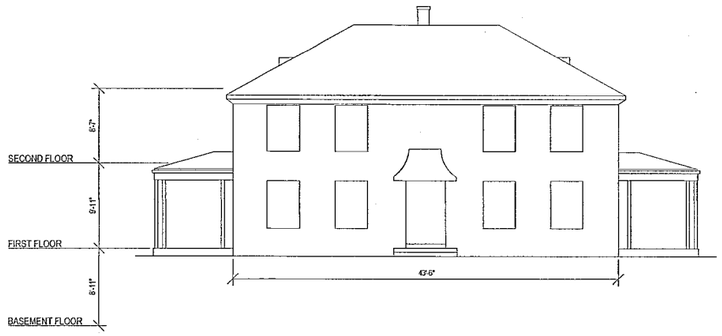


SCALE: $\frac{1}{8}$" = 1' 0" NORTH ELEVATION - RIDGES BUILDING #38 & 39 - UNIT 2701 & 2801

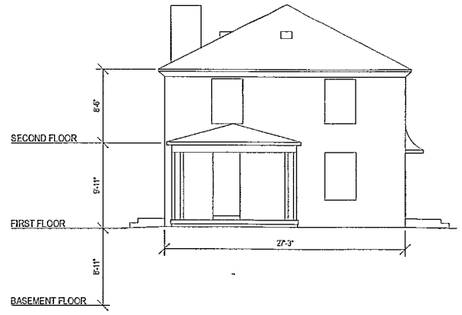

SCALE: $\frac{1}{8}$" = 1' 0" EAST ELEVATION - RIDGES BUILDING #38 & 39 - UNIT 2701 & 2801

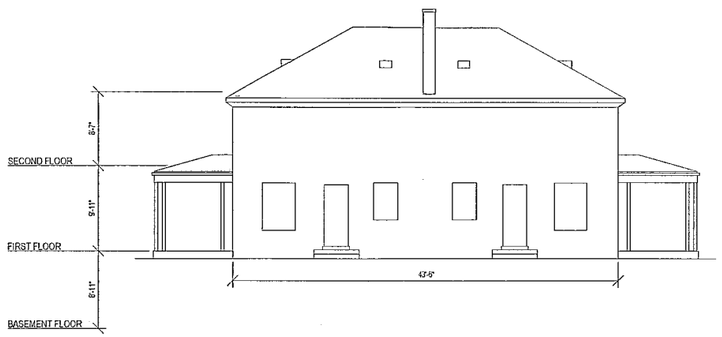

SCALE: $\frac{1}{8}$" = 1' 0" SOUTH ELEVATION - RIDGES BUILDING #38 & 39 - UNIT 2701 & 2801

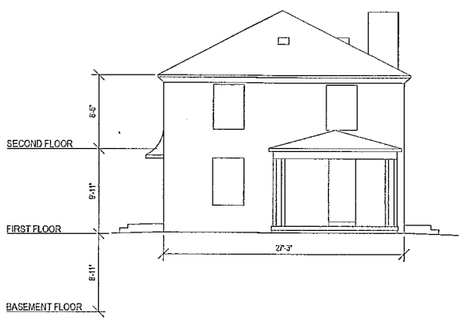

SCALE: $\frac{1}{8}$" = 1' 0" WEST ELEVATION - RIDGES BUILDING #38 & 39 - UNIT 2701 & 2801

237 NORTH MAIN STREET
FAX: 517.263.4535

NO.	DATE	BY	DESCRIPTION

PROJECT DATE: 09/12/2025
PROJECT NO.: 2500682
DRAWN BY: CDH
CHECKED BY: PW

Mannik Smith Group
TECHNICAL SKILL. CREATIVE STRENGTH.
www.MannikSmithGroup.com

PREPARED FOR:
OHIO UNIVERSITY
ATHENS, OHIO 45701

OHIO UNIVERSITY
RIDGES SURVEY
118 RIDGES CIRCLE,
ATHENS, OHIO 45701


RIDGES BUILDING #38 & 37
ELEVATIONS

62 / 64

\\MSGFILESRV\MSGData\Projects\2025\600-799\2500682\CADISURV\2500682_ELEV.dwg - Last printed 4/6/2026 2:24 PM


202600004141
FILED FOR RECORD IN
ATHENS COUNTY, OHIO
JESSICA MARLING, RECORDER
09/10/2026 02:31:14 PM
OR BOOK: 639 PAGE: 324

Envelope 6191

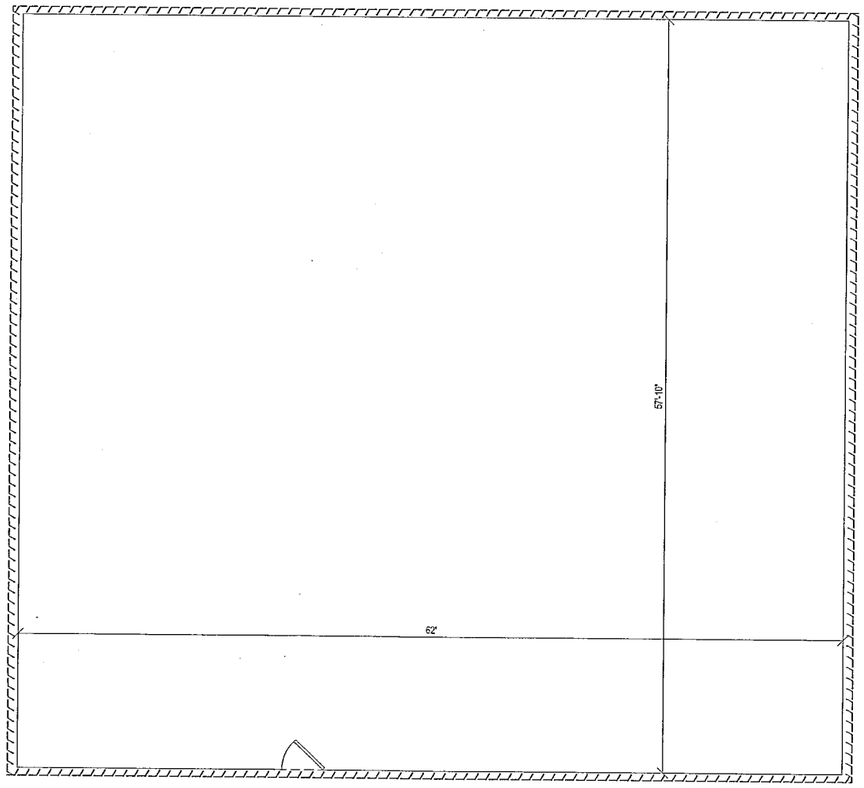

SCALE: $\frac{3}{16}$" = 1' 0"

FLOOR PLAN - RIDGES BUILDING #45 - UNIT 2901

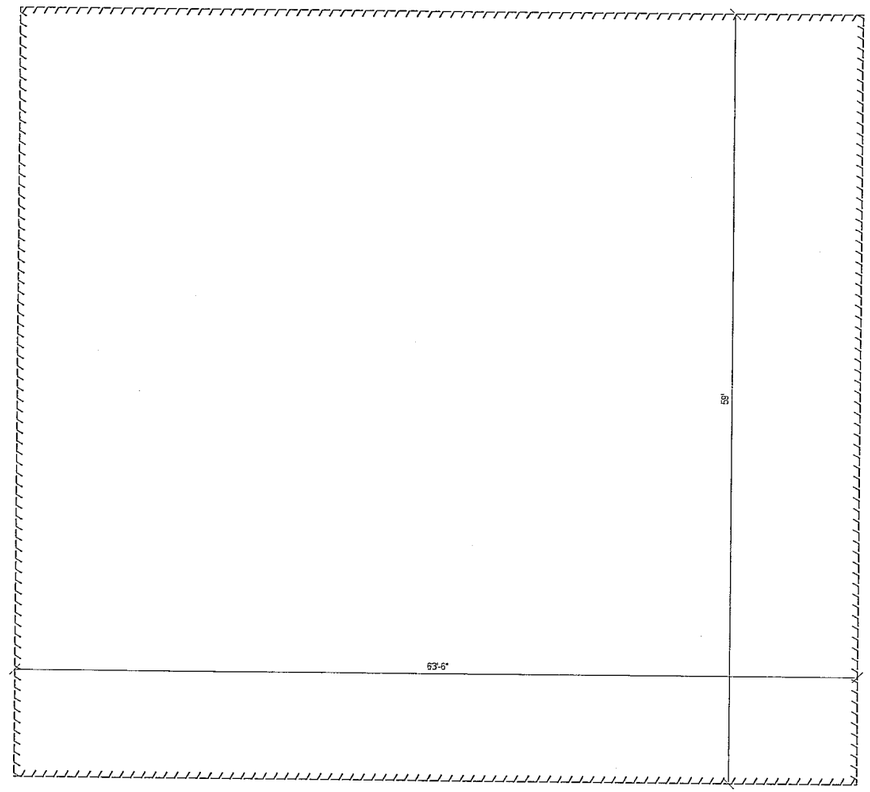

SCALE: $\frac{3}{16}$" = 1' 0"

BUILDING DIMENSIONS - RIDGES BUILDING #45 - UNIT 2901

NO.	DATE	BY	DESCRIPTION

237 NORTH MAIN STREET
ADRIAN, MI 49221
TEL: 517.263.4515
FAX: 517.263.4535

PROJECT DATE: 09/12/2025
PROJECT NO.: 2500682
DRAWN BY: CDH
CHECKED BY: PW

Mannik Smith Group

TERMINATE SKILL. CREATIVE SPIRIT.

www.MannikSmithGroup.com

PREPARED FOR:
OHIO UNIVERSITY
ATHENS, OHIO 45701

OHIO UNIVERSITY
RIDGES SURVEY
118 RIDGES CIRCLE,
ATHENS, OHIO 45701


RIDGES BUILDING #45
FLOOR PLAN &
BUILDING DIMENSIONS

63 / 64

\\MSGFILESRV\MSGData\Projects\2025\600-799\2500682\CAD\SURV\2500682_BLDG.dwg - Last printed 4/6/2026 2:24 PM


envelope
619 B

2026000041 42
FILED FOR RECORD IN
ATHENS COUNTY, OHIO
JESSICA MARKINS, RECORDER
02/10/2026 02:31:15 PM
OR BOOK: 639 PAGE: 325
LARGE PLAT

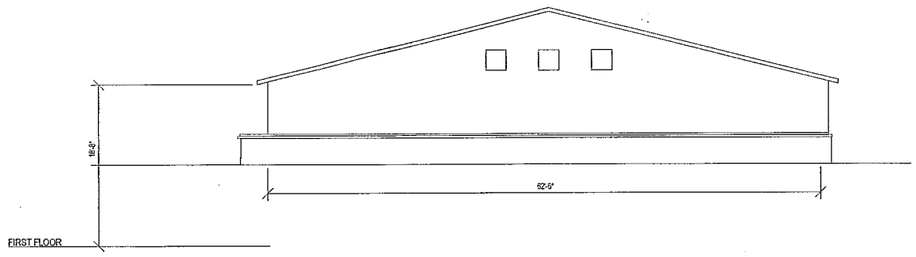


SCALE: $\frac{1}{8}$" = 1' 0"

NORTH ELEVATION - RIDGES BUILDING #45 - UNIT 2901

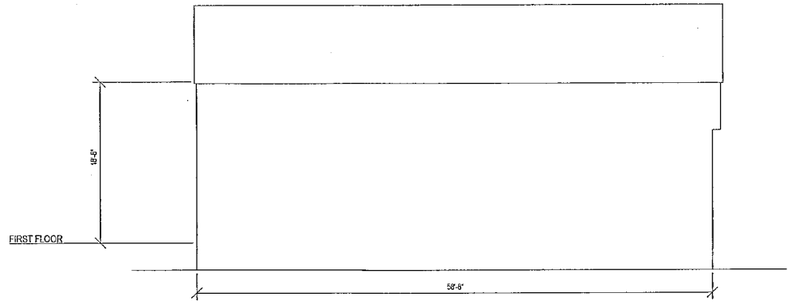


SCALE: $\frac{1}{8}$" = 1' 0"

EAST ELEVATION - RIDGES BUILDING #45 - UNIT 2901

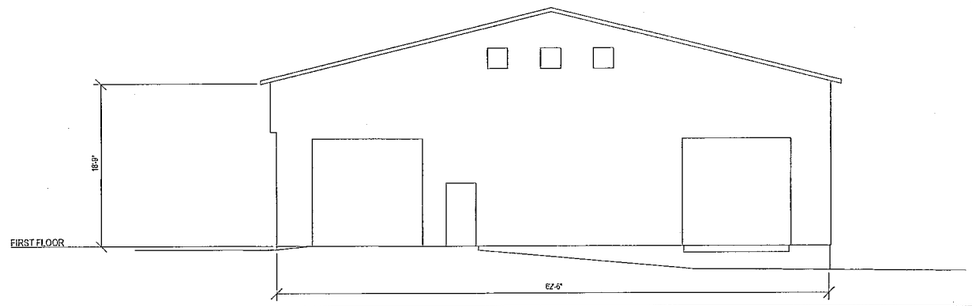

SCALE: $\frac{1}{8}$" = 1' 0"

SOUTH ELEVATION - RIDGES BUILDING #45 - UNIT 2901

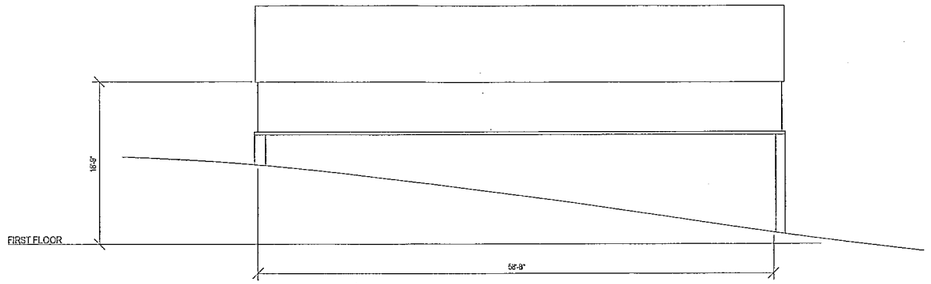

SCALE: $\frac{1}{8}$" = 1' 0"

WEST ELEVATION - RIDGES BUILDING #45 - UNIT 2901

237 NORTH MAIN STREET
FAX: 517.263.4535

NO.	DATE	BY	DESCRIPTION

PROJECT DATE: 09/22/2025
PROJECT NO.: 2500682
DRAWN BY: CDH
CHECKED BY: PW

Mannik Smith Group
TECHNICAL SKILL. CREATIVE SPIRIT.
www.MannikSmithGroup.com

PREPARED FOR:
OHIO UNIVERSITY
ATHENS, OHIO 45701

OHIO UNIVERSITY
RIDGES SURVEY
118 RIDGES CIRCLE,
ATHENS, OHIO 45701

RIDGES BUILDING
#45 ELEVATIONS

64 / 64

\\MSGFILESRV\MSGData\Projects\2025\600-799\2500682\CADISURV\2500682_ELEV.dwg - Last printed 4/6/2026 2:24 PM