Mat Throckmortons Survey in Albany Lee Twp

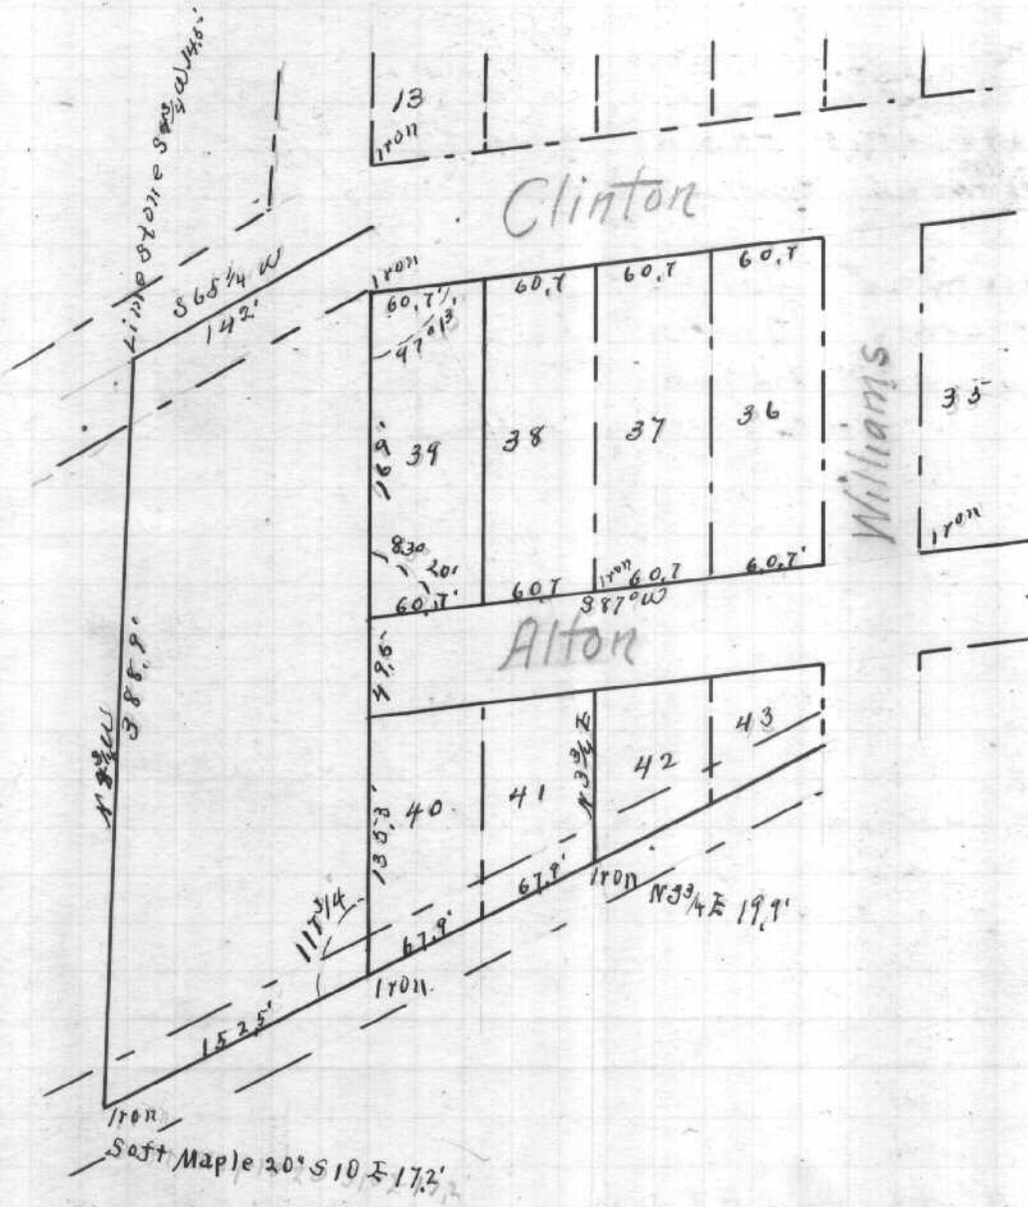

Scale of 100' to an inch

Surveyed April 23d 1907
Recorded Dec 31st 1907
D. H. Hibbard
Surveyor of Athens Co

Dover.

Dodridge Augustines Survey in Sec No 7 Town No 10 Range No 14

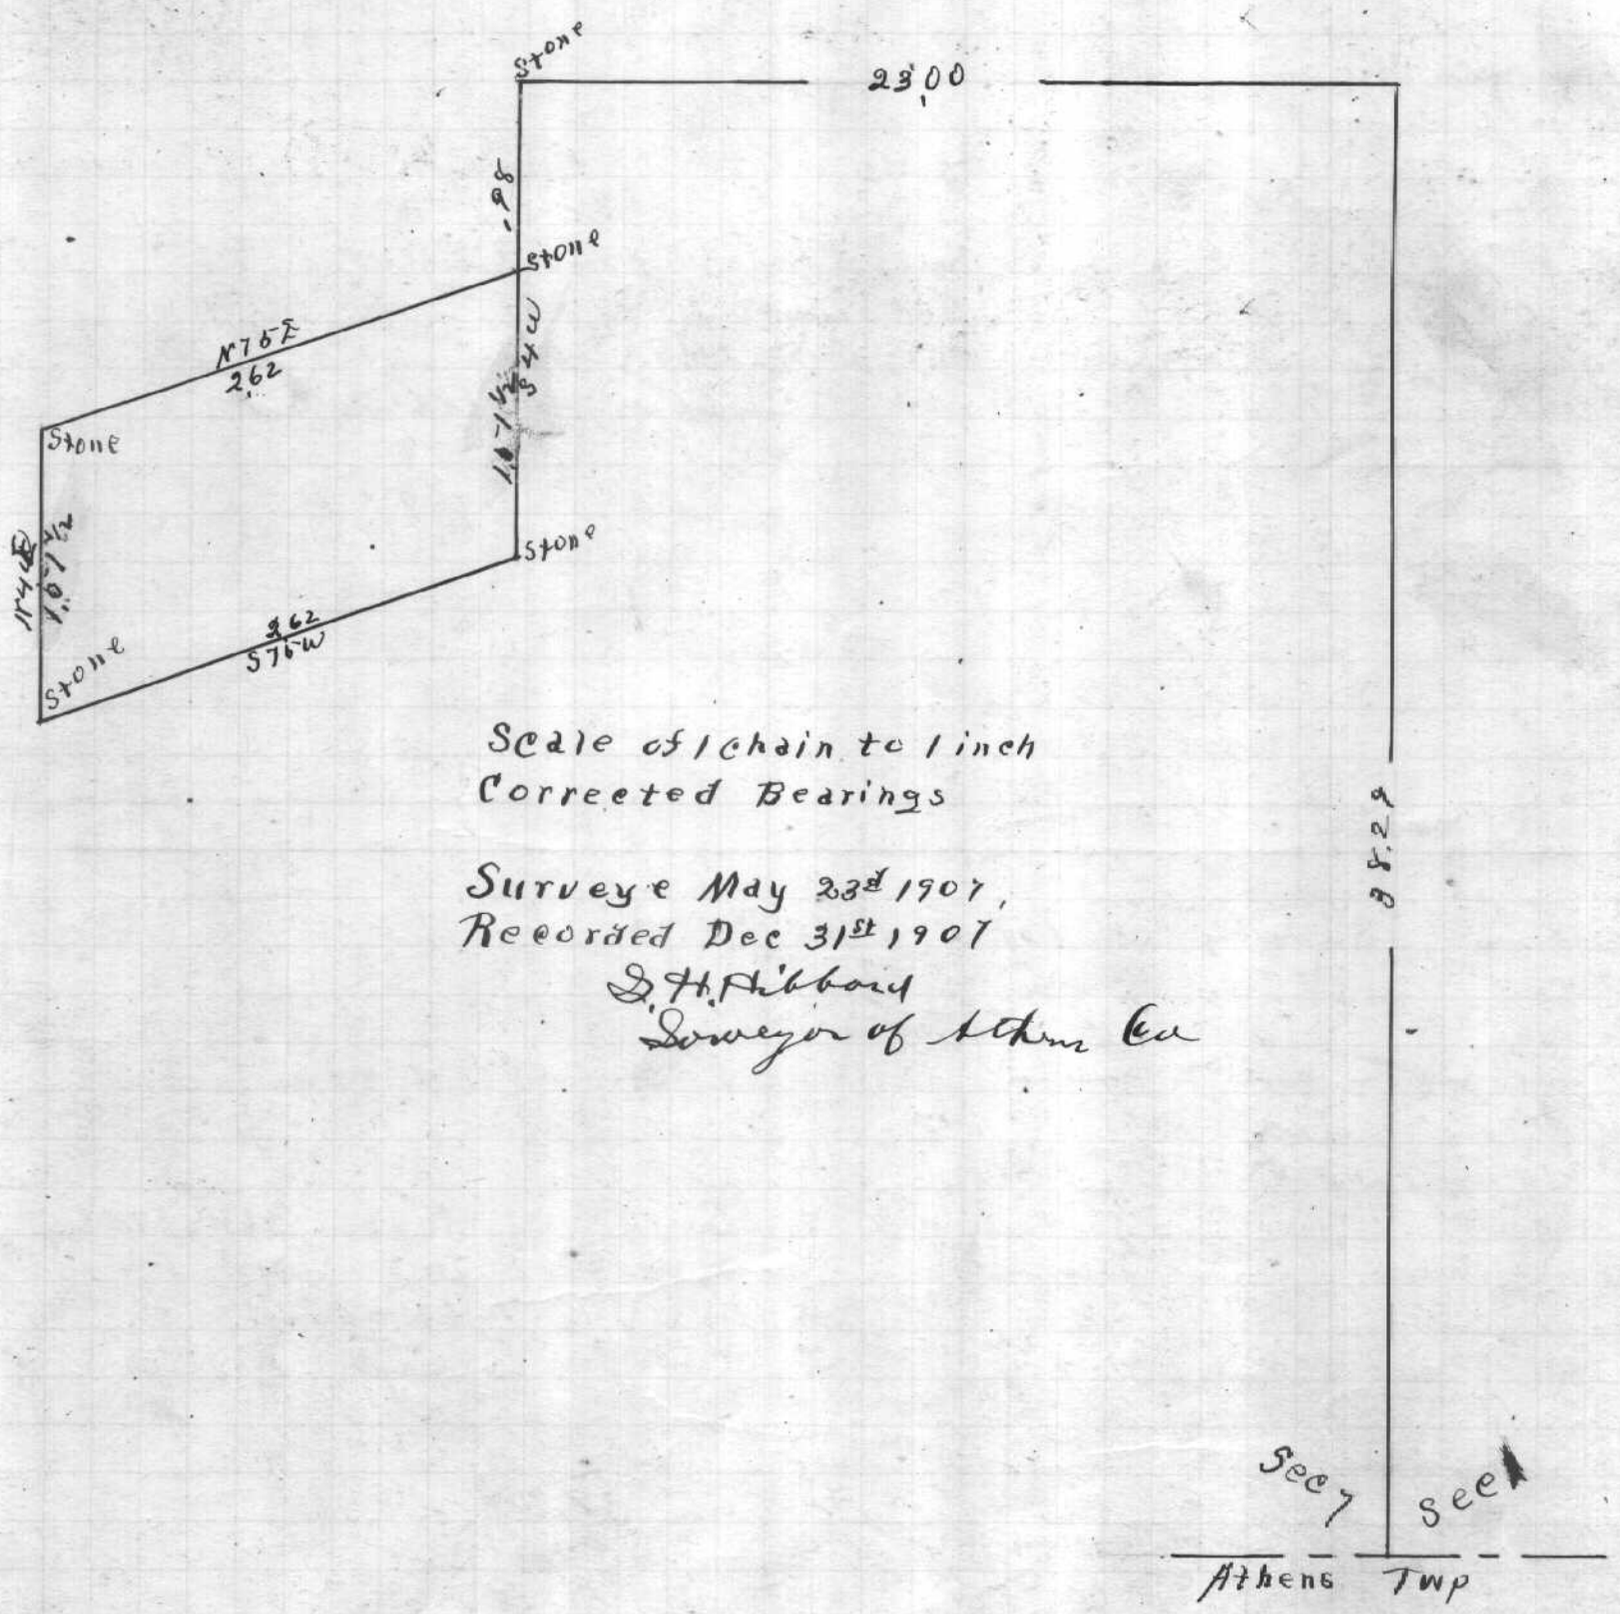

Scale of 1 chain to 1 inch
Corrected Bearings

Surveye May 23d 1907,
Recorded Dec 31st 1907
D. H. Hibbard
Surveyor of Athens Co