J.C. Hewitts Survey in Sec No 29 Town No 11 Range No 15 Waterloo

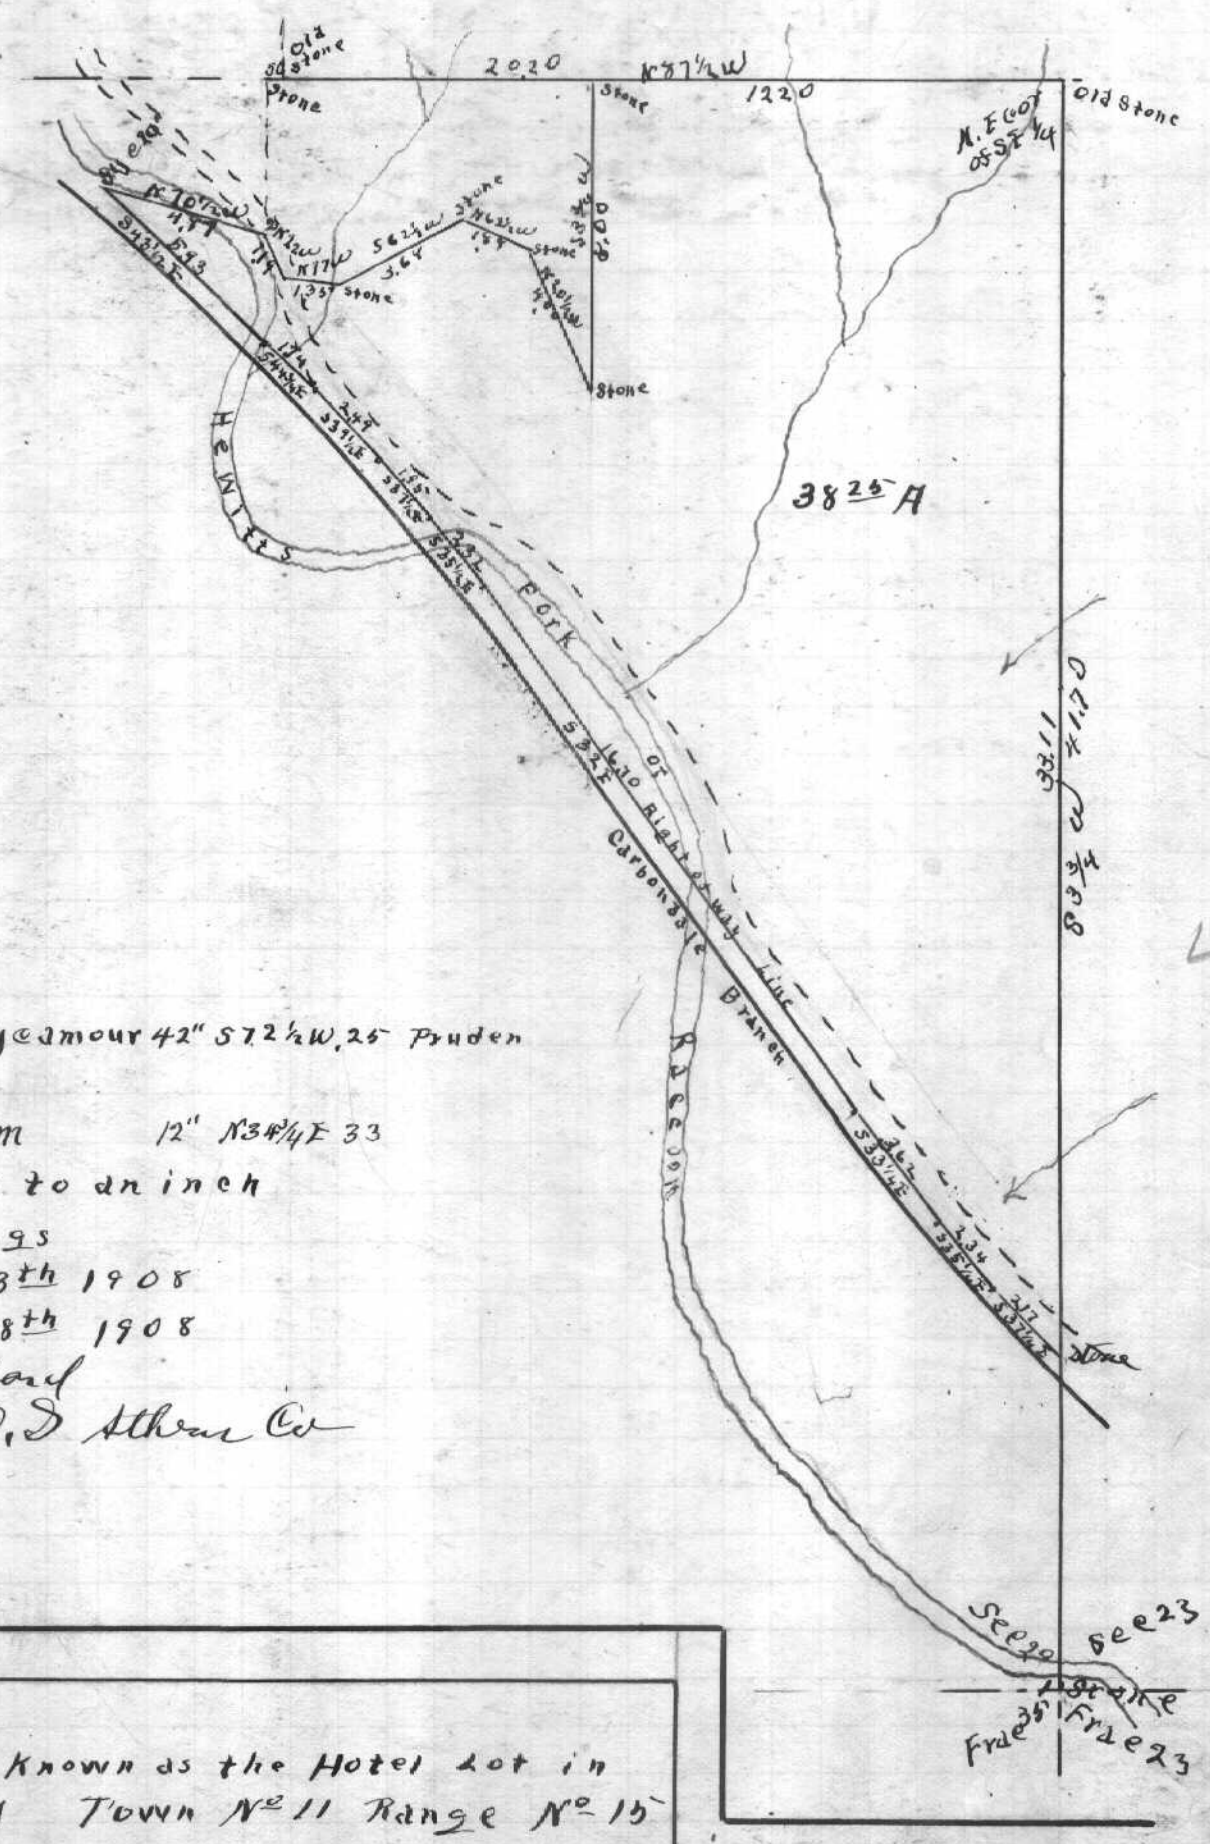
Old Stone
2020
N 87½ W
1220
Old Stone
N. E cor of S.E ¼
Stone
Stone
Stone