


Surveyed For O. A Parker May 27 1931
E. H. Beckson
Hoff. Co Surveyor

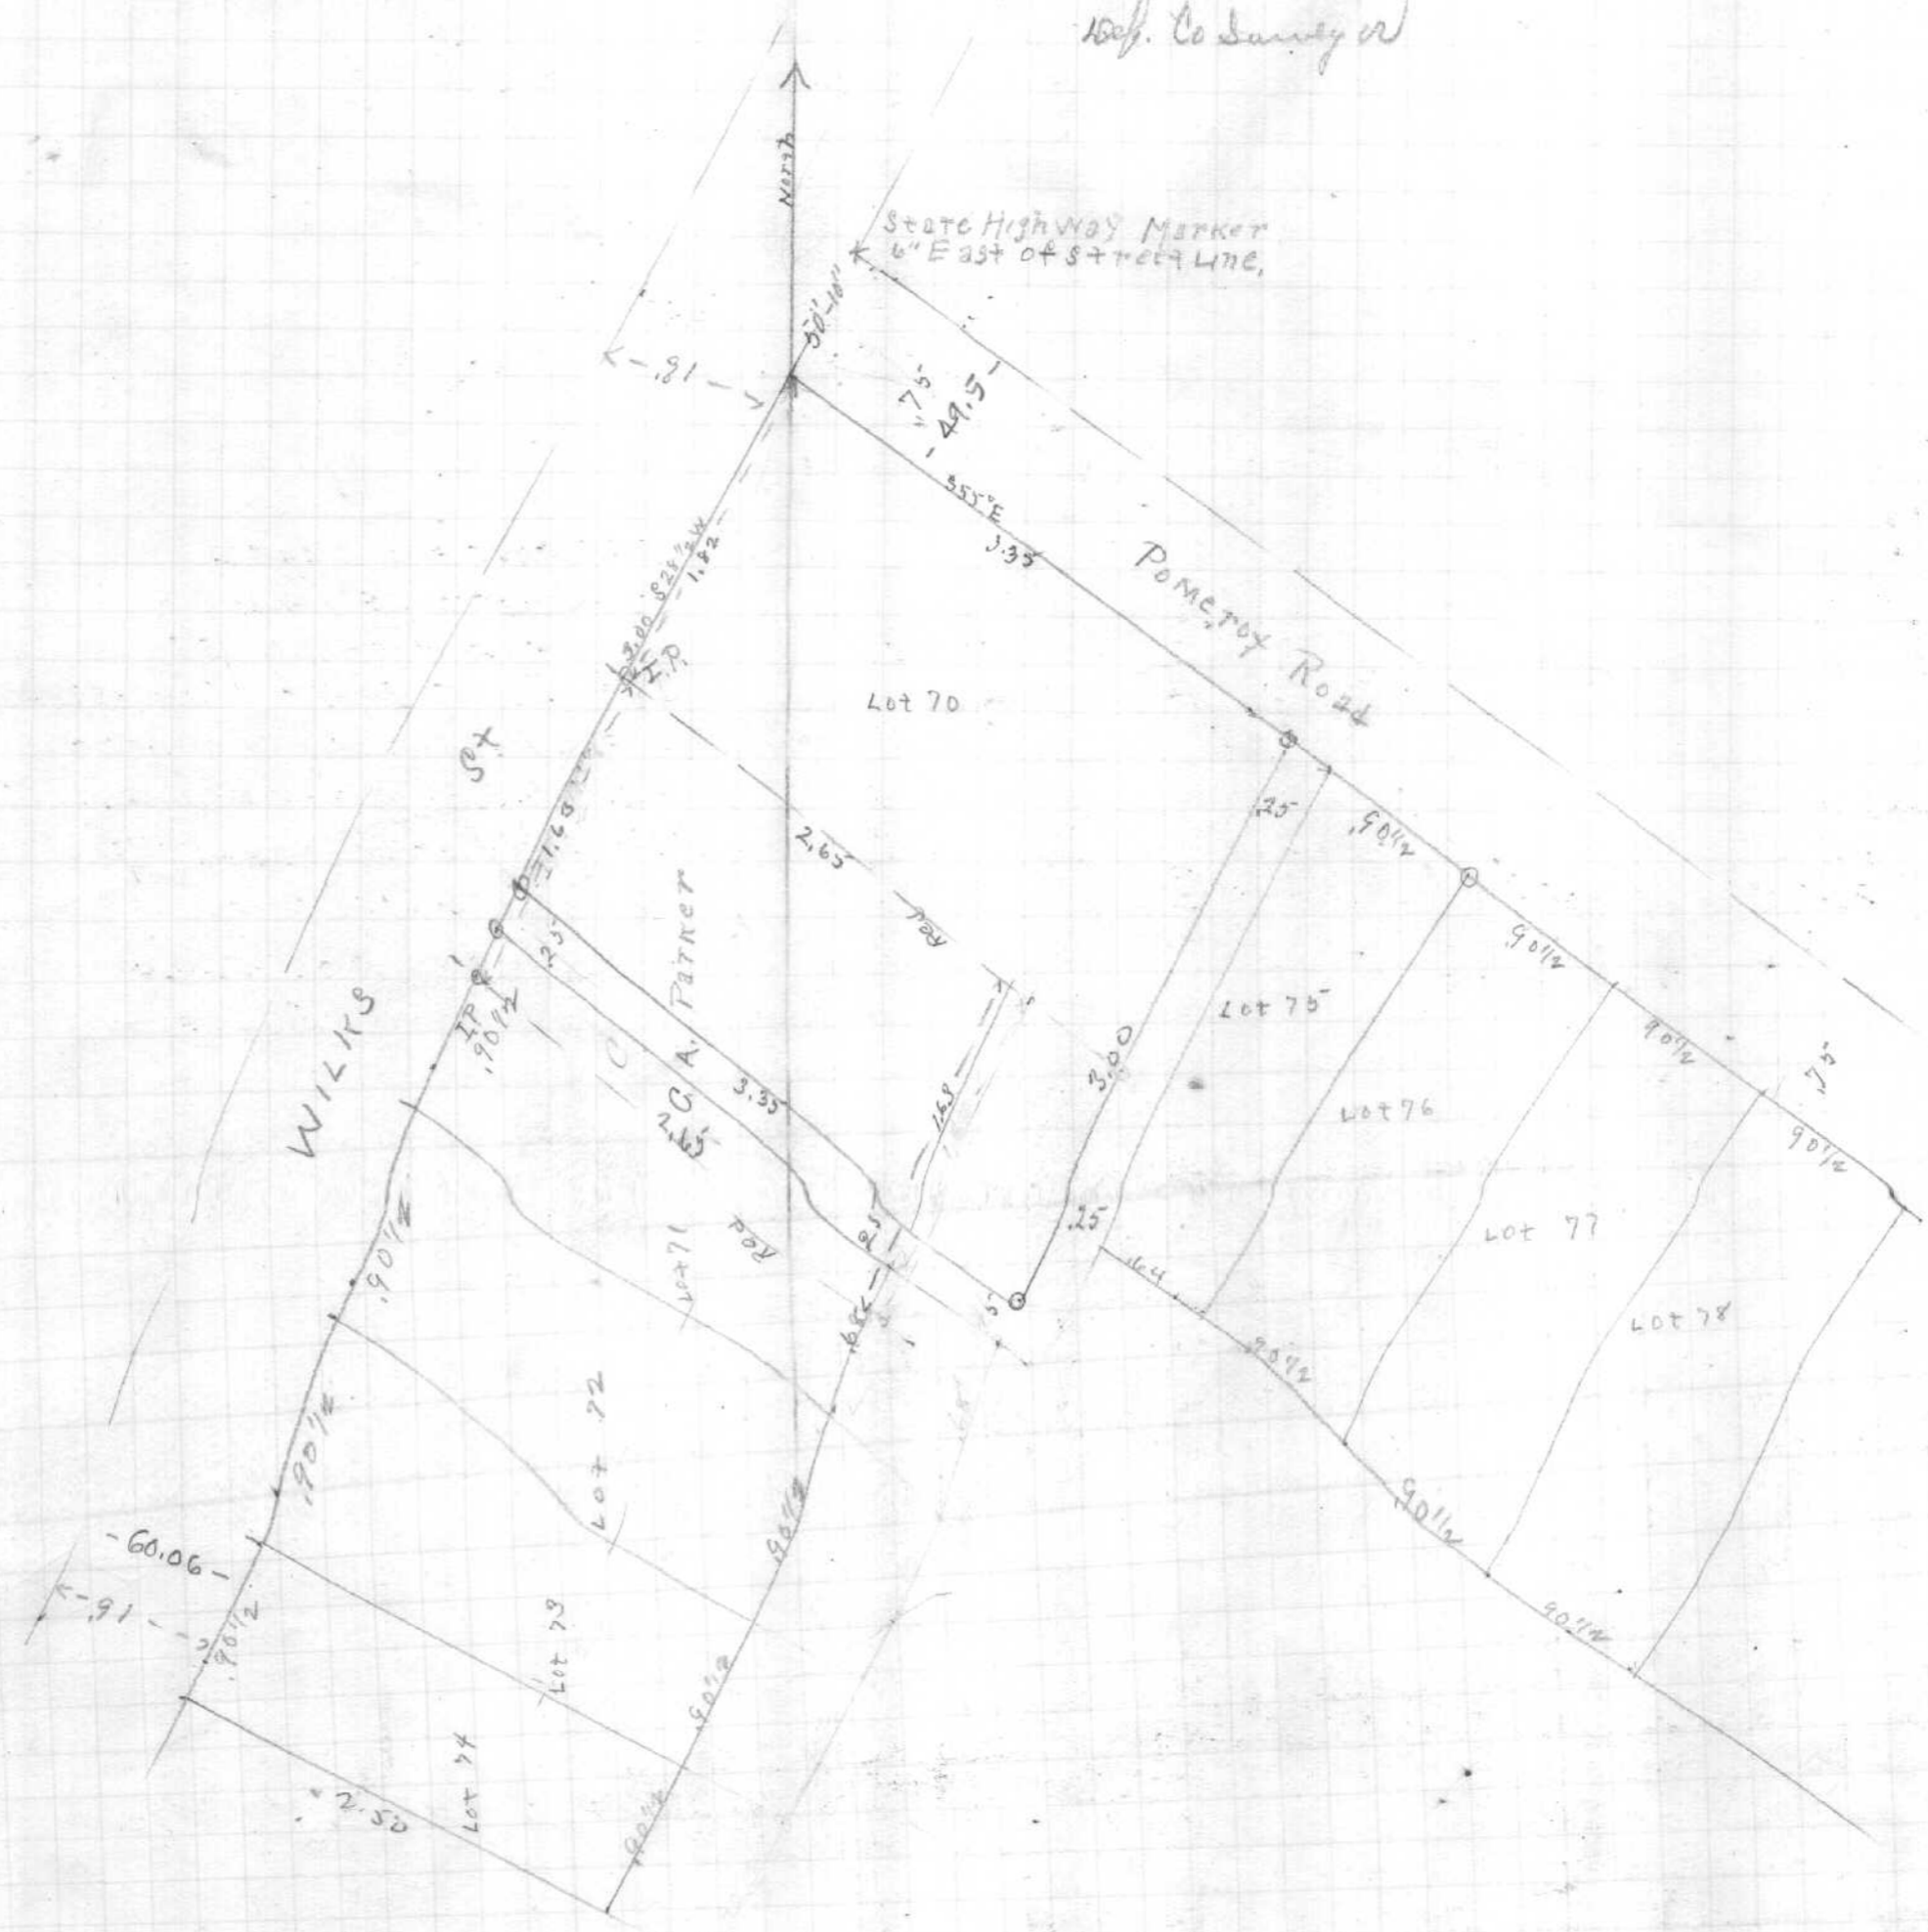

Addition to Albany
 Partial Plat of a survey made by John Ackley for
 Amos Thompson March 20 1850
 Recorded April 30 1850 by H. P. Brown Reg. Recorder
 in Dnd book Wt 17 Page 460.
 Black lines show Ackley's survey
 Red lines show land possessed by O. A. Parker which
 are intended to cover land described in deed and was
 stable by John Luskley and others to be same
 owned and possessed by Grantor and those owning
 same before for more than 21 years.
 Deed description does not correspond with land
 possessed.
 Possession and descriptions cover the Alley and
 what had been previously possessed for over 21 years
 Measurements given in chains and links
 Vacation and purchase of Alley is shown by Resolution of Alley Council
 a copy of which is recorded in V 2 P 35 Surveyor records