FED. RD. DIVISION	STATE	PROJECT	
5	OHIO	APD-433(5)	

578/584

ATHENS COUNTY
ATH-50-4.95
LIMITED ACCESS
APD-433(5) R/W ONLY
State Project - 106940(0)

36/47

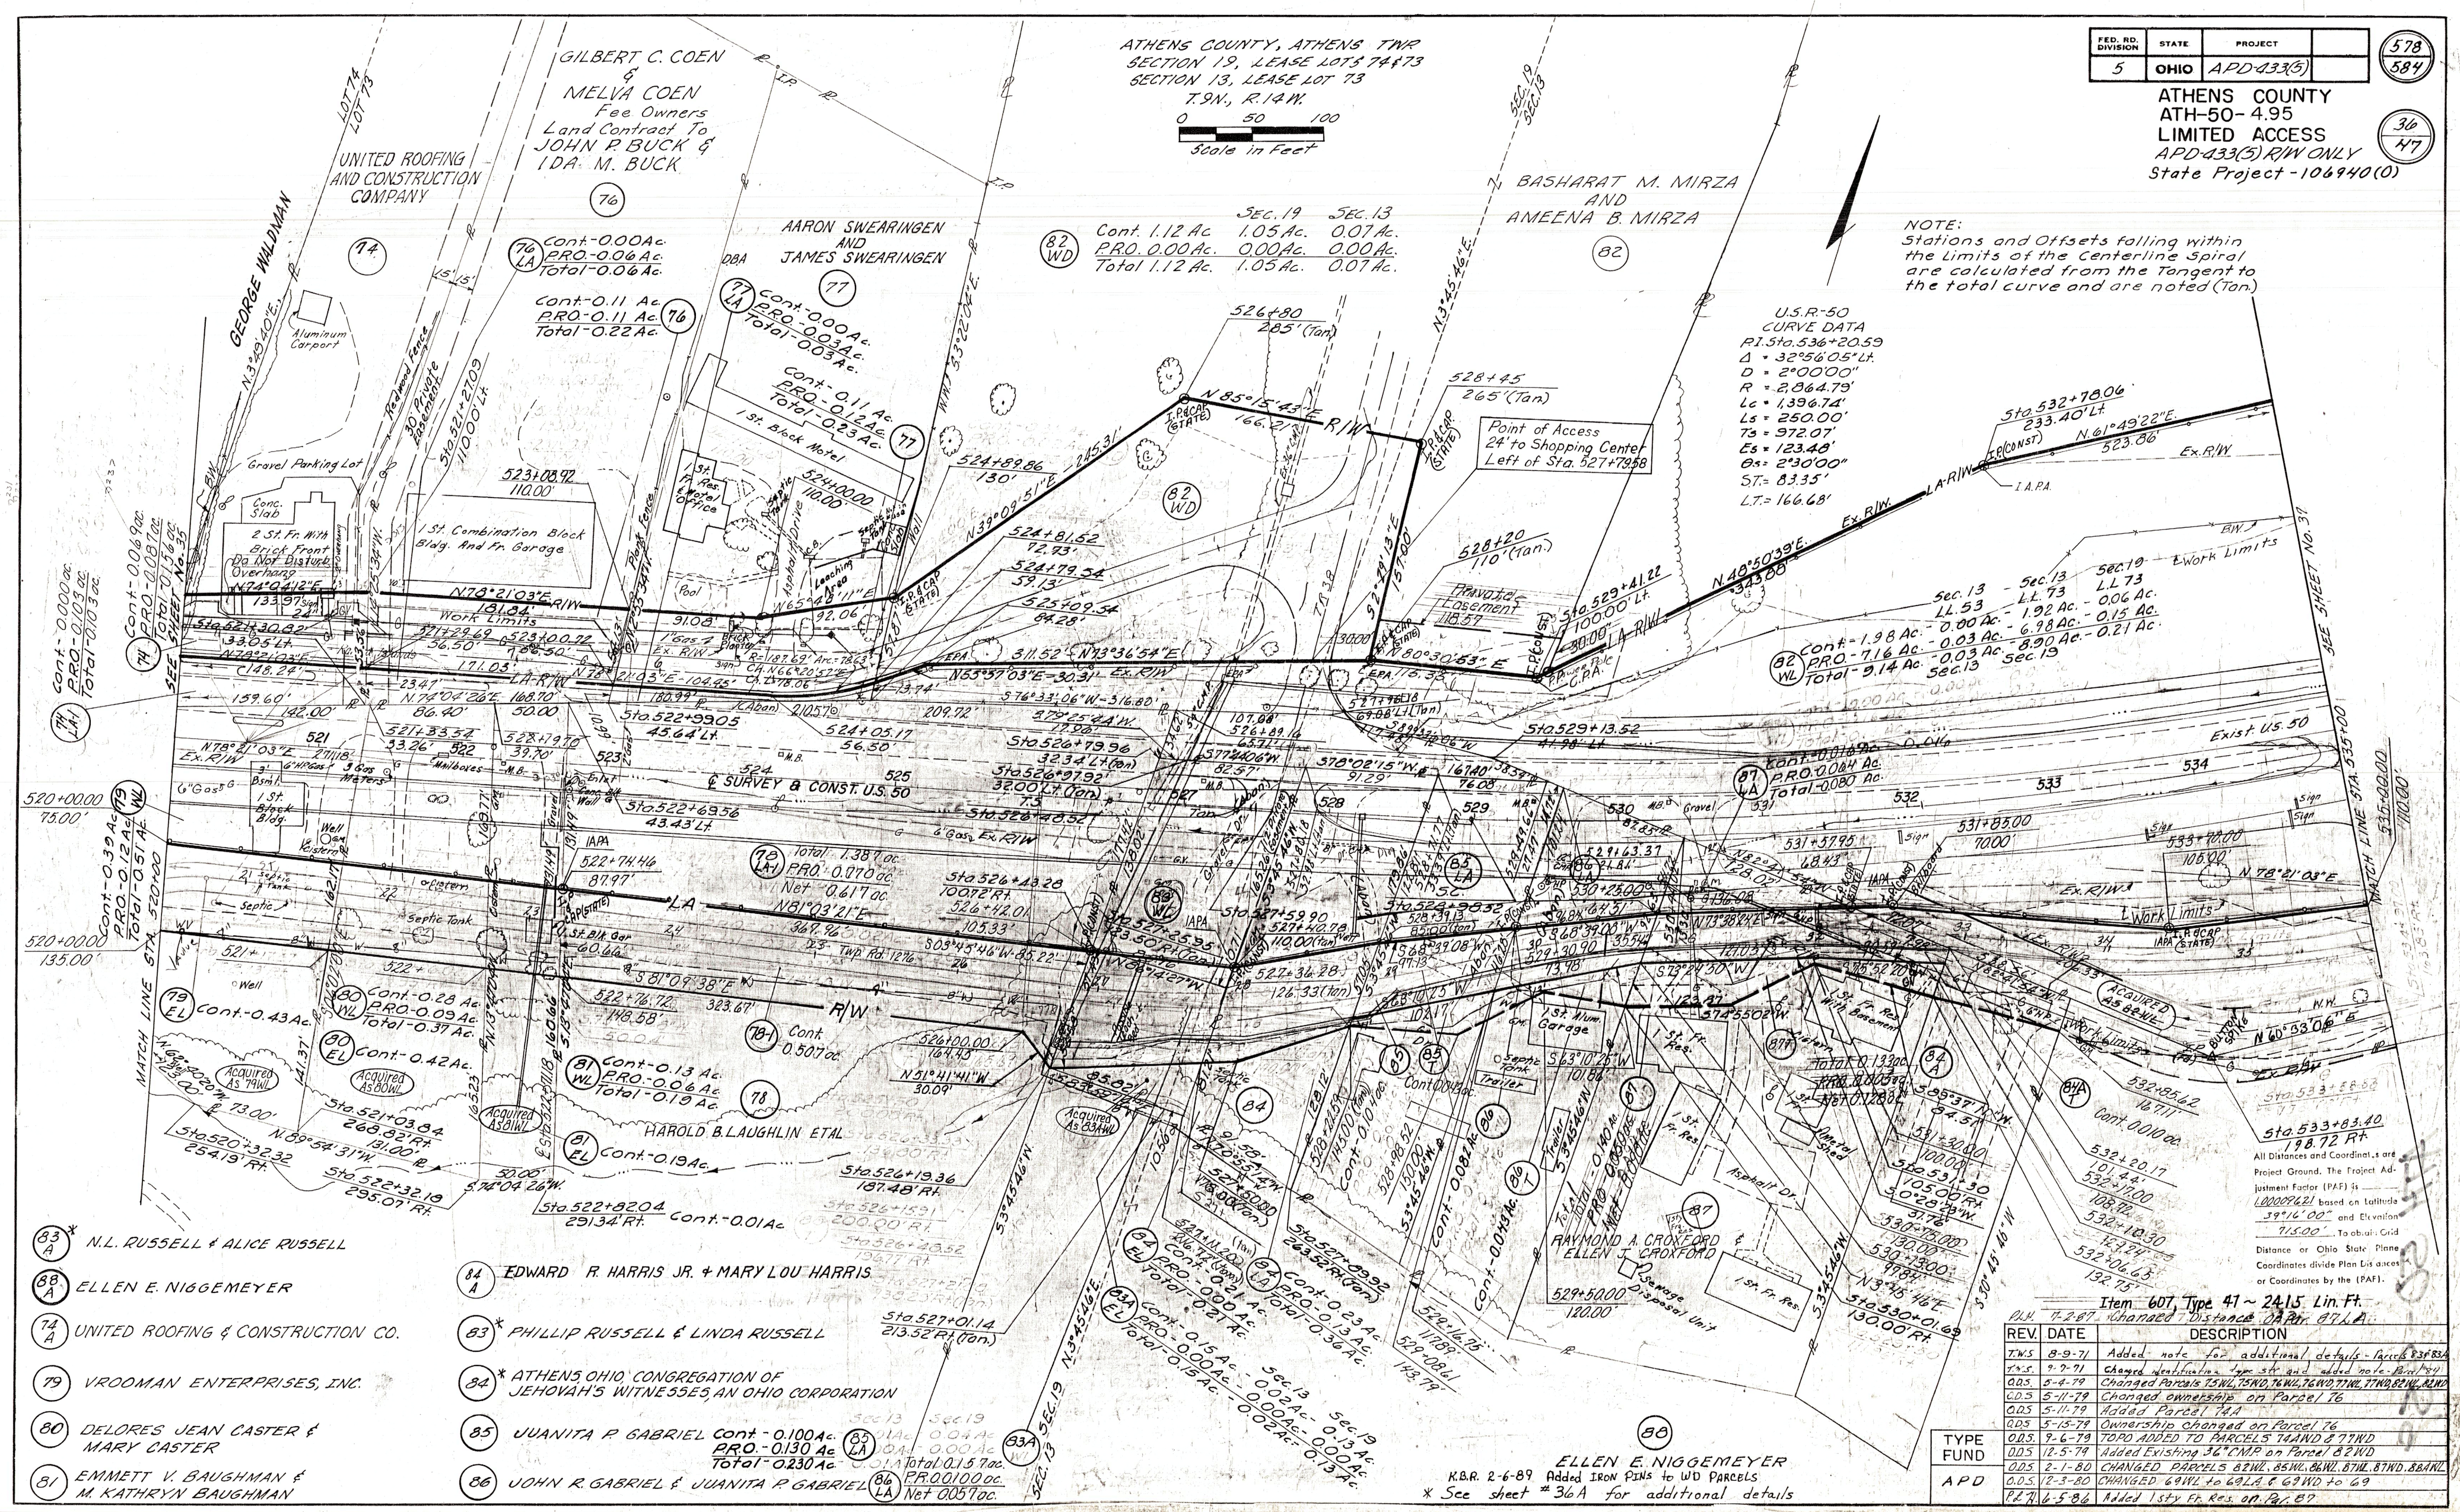

(83)A* N.L. RUSSELL & ALICE RUSSELL

(88)A ELLEN E. NIGGEMEYER

(74)A UNITED ROOFING & CONSTRUCTION CO.

(79) VROOMAN ENTERPRISES, INC.

(80) DELORES JEAN CASTER & MARY CASTER

(81) EMMETT V. BAUGHMAN & M. KATHRYN BAUGHMAN

(84)A EDWARD R. HARRIS JR. & MARY LOU HARRIS

(83)* PHILLIP RUSSELL & LINDA RUSSELL

(84)* ATHENS OHIO CONGREGATION OF JEHOVAH'S WITNESSES, AN OHIO CORPORATION

(85) JUANITA P. GABRIEL Cont - 0.100 Ac. P.R.O. - 0.130 Ac. Total - 0.230 Ac.

(86) JOHN R. GABRIEL & JUANITA P. GABRIEL Total 0.15 Ac. P.R.O. 0.0100 Ac. Net 0.057 Ac.

(88) ELLEN E. NIGGEMEYER
K.B.R. 2-6-89 Added IRON PINS to WD PARCELS
* See sheet #36A for additional details

REV.	DATE	DESCRIPTION
T.W.S.	8-9-71	Added note for additional details - Parcels 83 & 83A
T.W.S.	9-7-71	Changed identification type str and added note - Parcel 87
O.D.S.	5-4-79	Changed Parcels 75WL, 75WD, 76WL, 76WD, 77WL, 77WD, 82WL, 82WD
O.D.S.	5-11-79	Changed ownership on Parcel 77
O.D.S.	5-11-79	Added Parcel 74A
O.D.S.	5-15-79	Ownership changed on Parcel 76
O.D.S.	9-6-79	TOPO ADDED TO PARCELS 74AWD & 77WD
O.D.S.	12-5-79	Added Existing 36" CMP on Parcel 82WD
O.D.S.	2-1-80	CHANGED PARCELS 82WL, 85WL, 86WL, 87WL, 87WD, 88AWL
O.D.S.	12-3-80	CHANGED 69WL to 69LA & 69WD to 69
P.L.H.	6-5-86	Added 1 sty Fr. Res. on Parcel 87

TYPE FUND APD