
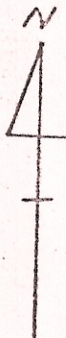


SURVEY OF A 0.9768 ACRE TRACT AND A 2.2536 ACRE TRACT IN
 LEASE LOT NO. 5, SEC. 35, & A 1.4885 ACRE TRACT IN LEASE LOT NO. 3, SEC. 36,
 T. 8, R. 14, ALEXANDER TOWNSHIP, ATHENS COUNTY, OHIO,
 for B.G. & LEONA CONANT

SURVEYED Nov. 1974 by HAROLD D. WHALEY

Harold D. Whaley

REG. SURVEYOR NO. 4986

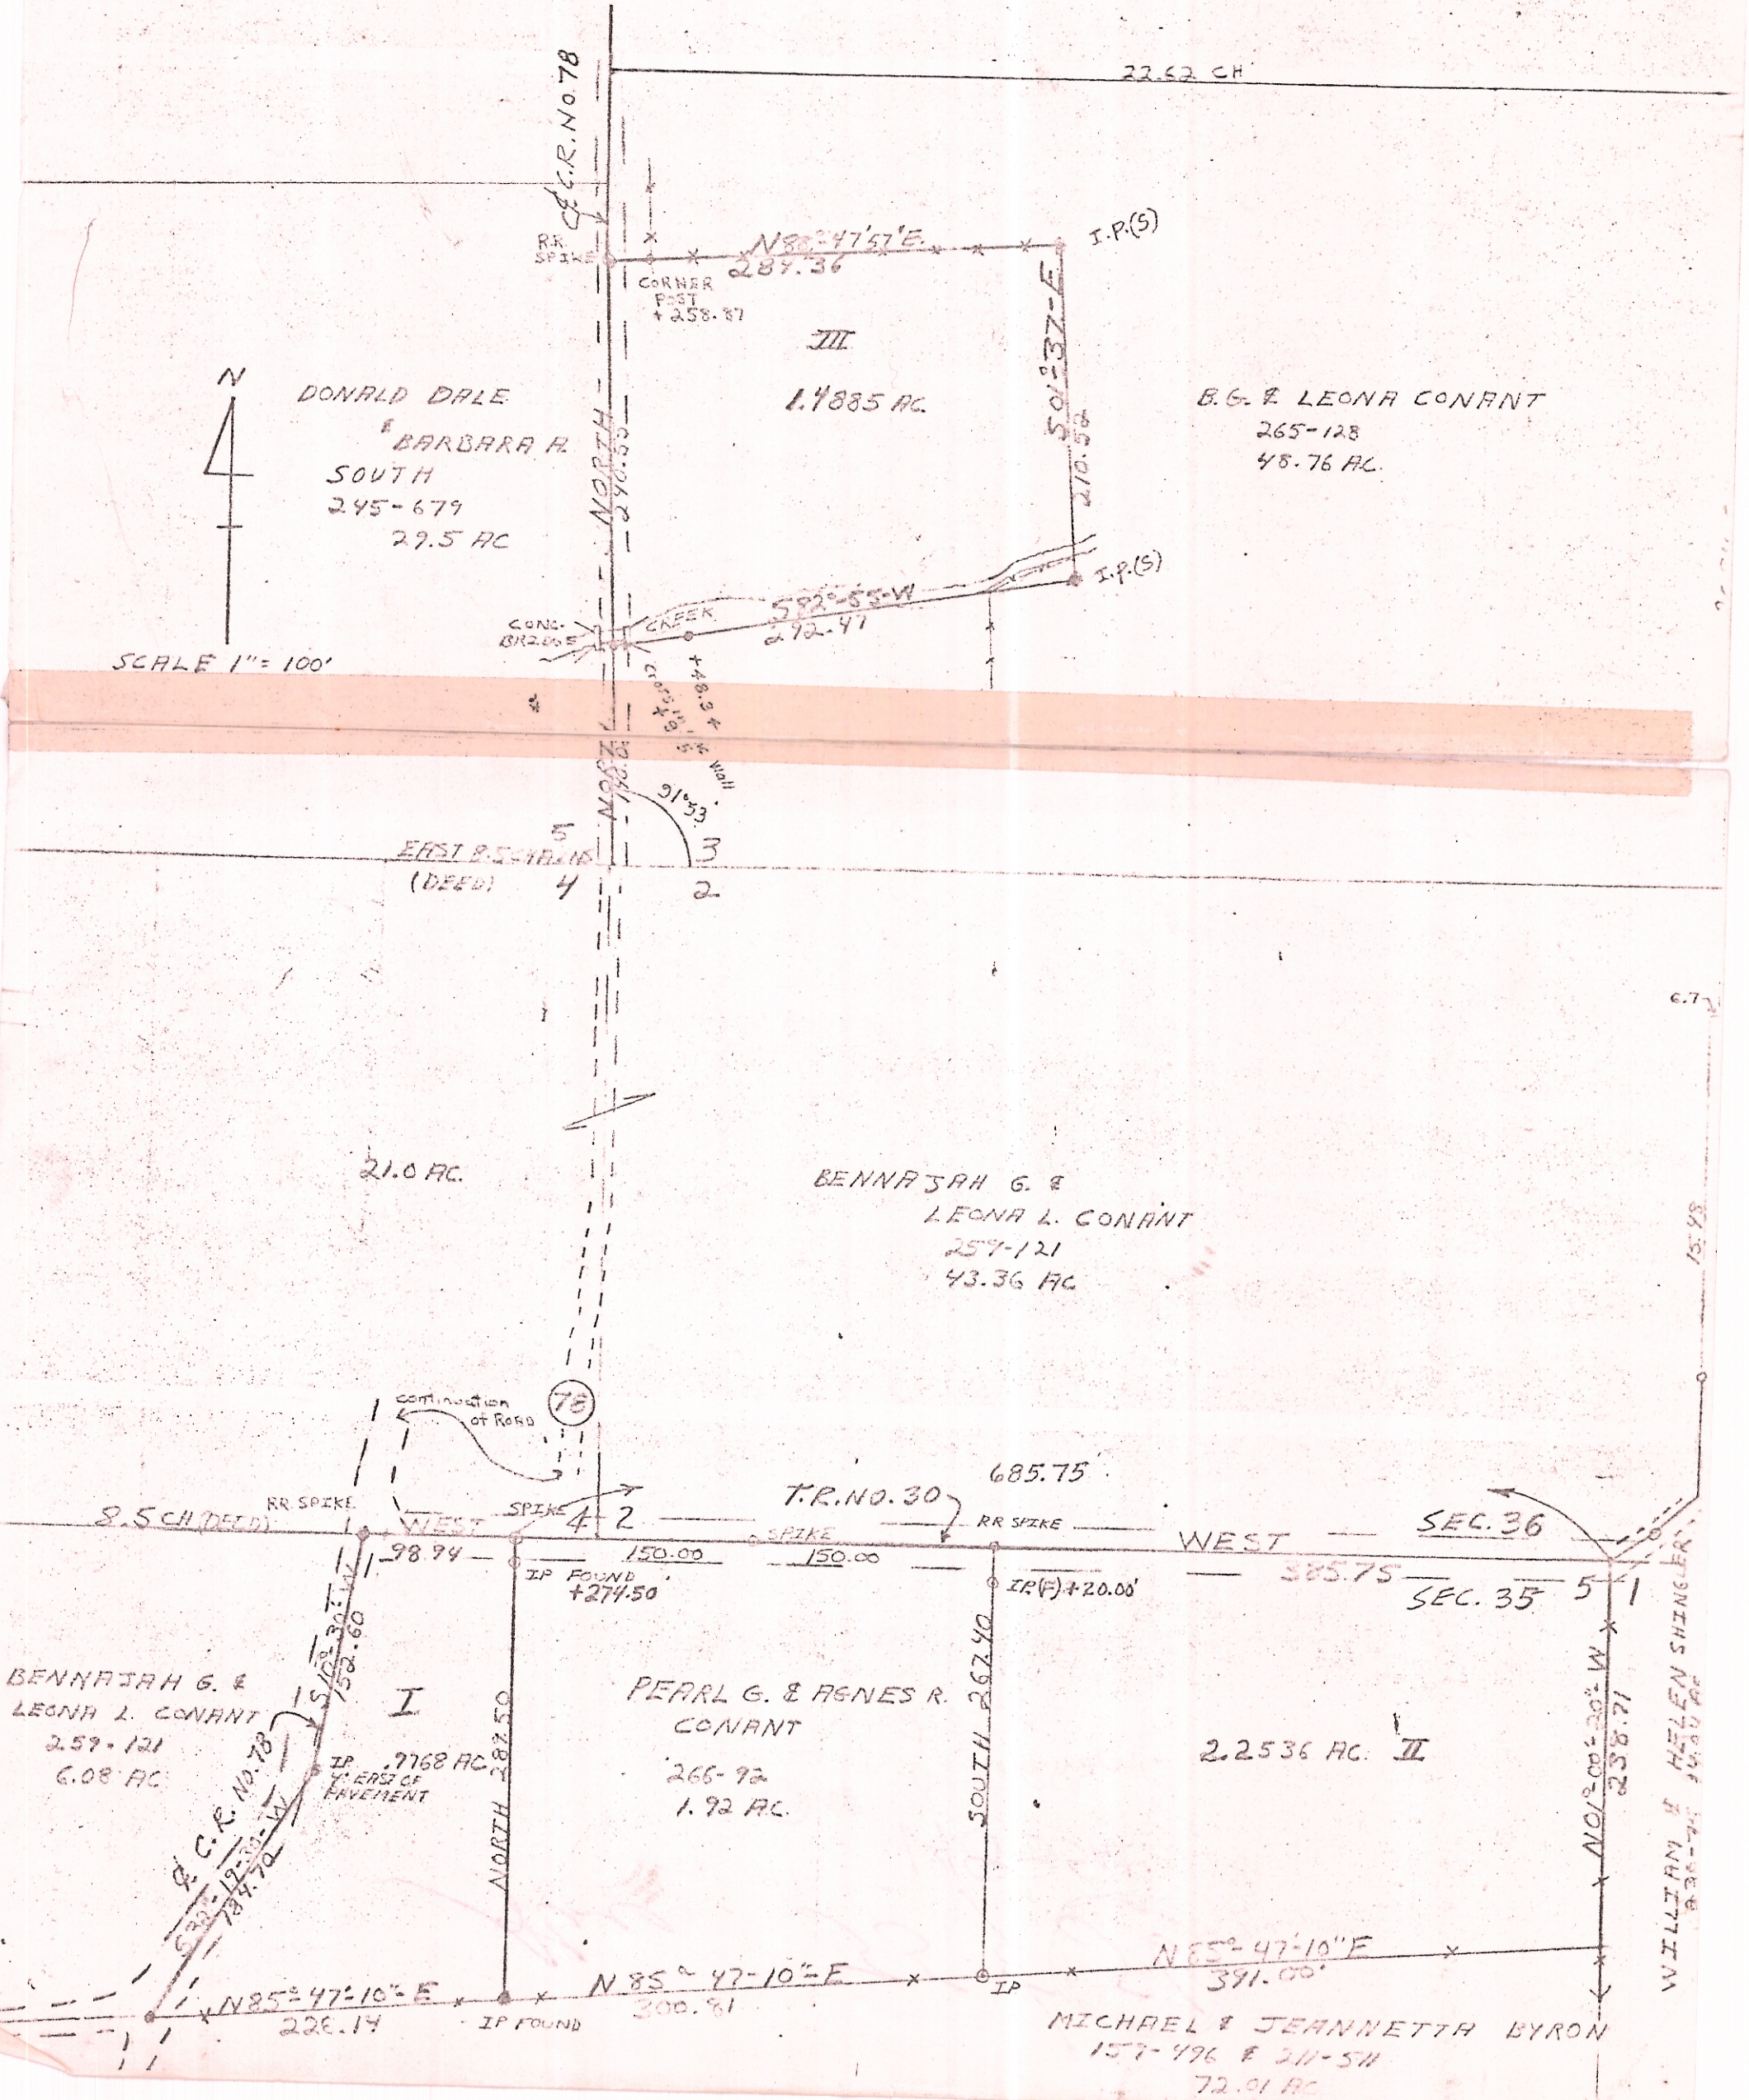

SCALE 1" = 100'

DONALD DALE
 & BARBARA H.
 SOUTH
 245-679
 29.5 AC

III
 1.4885 AC

B.G. & LEONA CONANT
 265-128
 48.76 AC

BENNAJAH G. &
 LEONA L. CONANT
 257-121
 43.36 AC

PEARL G. & RENES R.
 CONANT
 266-92
 1.92 AC

2.2536 AC. II

BENNAJAH G. &
 LEONA L. CONANT
 257-121
 6.08 AC

MICHAEL & JEANNETTA BYRON
 157-496 & 211-511
 72.01 AC

WILLIAM & HELEN SHINGLER
 236-745
 14.80 AC