SURVEY FOR NEAL S. LEE

LOCATED IN LEASE LOT 2, (FRACTION 2), SECTION 22, TOWNSHIP 8, RANGE 14, ALEXANDER TOWNSHIP, ATHENS COUNTY, OHIO

0' 200' 400' 600'
SCALE IN FEET
1" = 200'

BEARINGS ARE TO AN ASSUMED MERIDIAN AND ARE USED TO DENOTE ANGLES ONLY

NOTE: THIS PLAT TO BE USED FOR THE TRANSFER OF PROPERTY AND DOES NOT INTEND TO SHOW ALL STRUCTURES, ANY LEASES, EASEMENTS, RIGHT-OF-WAYS, OR RESTRICTIONS OF LEGAL RECORD OR THOSE THAT MIGHT EXIST ON THE PROPERTY

PERTINENT SURVEYS

SURVEY PLAT OF A 57.203 AC. TR. DONE BY ROBERT R. KASON IN JUNE 2007

SURVEY PLAT OF A 3.592 AC. TR. DONE BY DANA A. SNOUFFER ON JULY 31, 2007

DENOTES

X - EXISTING FENCE LINE

■ - STONE FOUND

O - IRON PIN FOUND

• - 5/8" REBAR PIN SET WITH A PLASTIC I.D. CAP STAMPED SNOUFFER - RLS # 7543

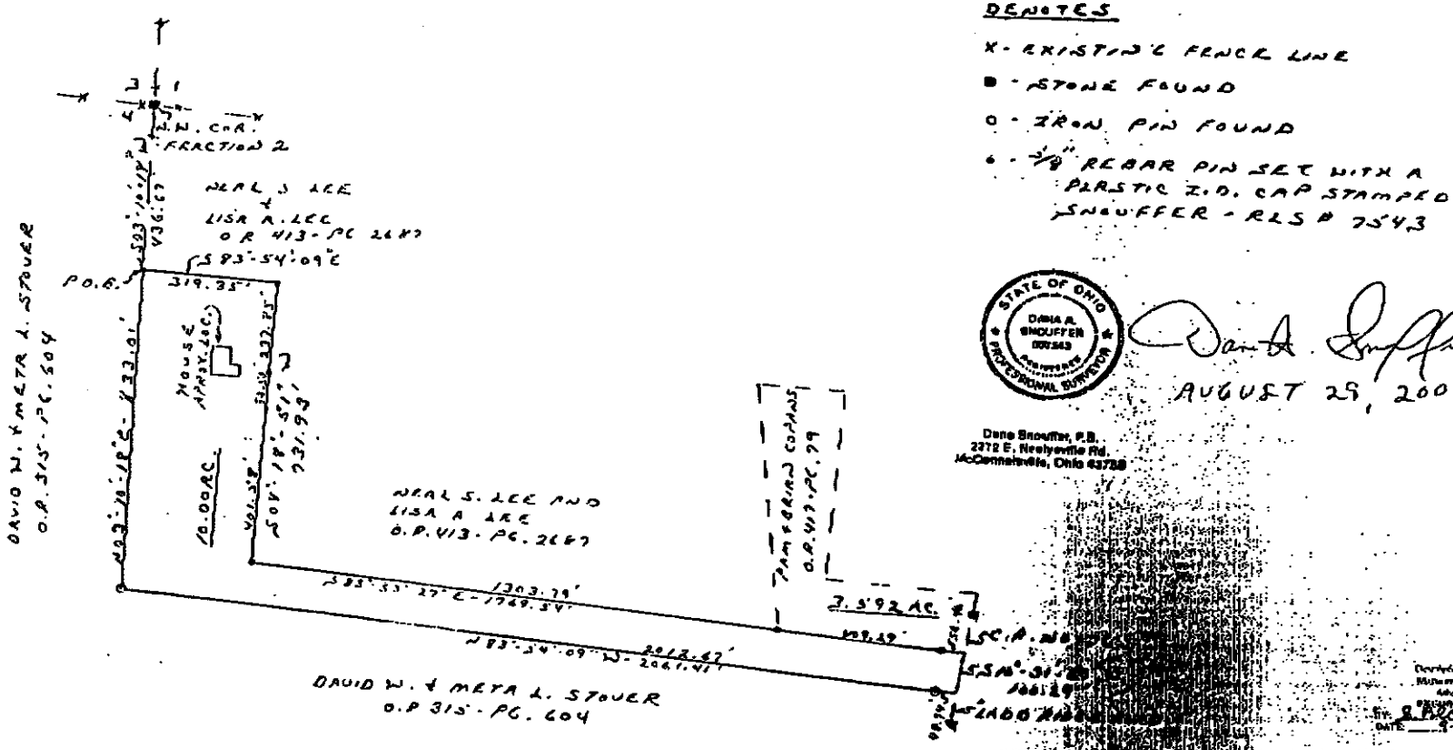

STATE OF OHIO
DANA A. SNOUFFER
007543
REGISTERED
PROFESSIONAL SURVEYOR

Dana A. Snouffer

AUGUST 29, 2008

Dana Snouffer, P.S.
2272 E. Newlyville Rd.
McConnelsville, Ohio 43756

Recorded in Plat Book
Athens County
Page
RECORDER'S SEAL
BY: R. BALLARD
DATE: 9-3-08