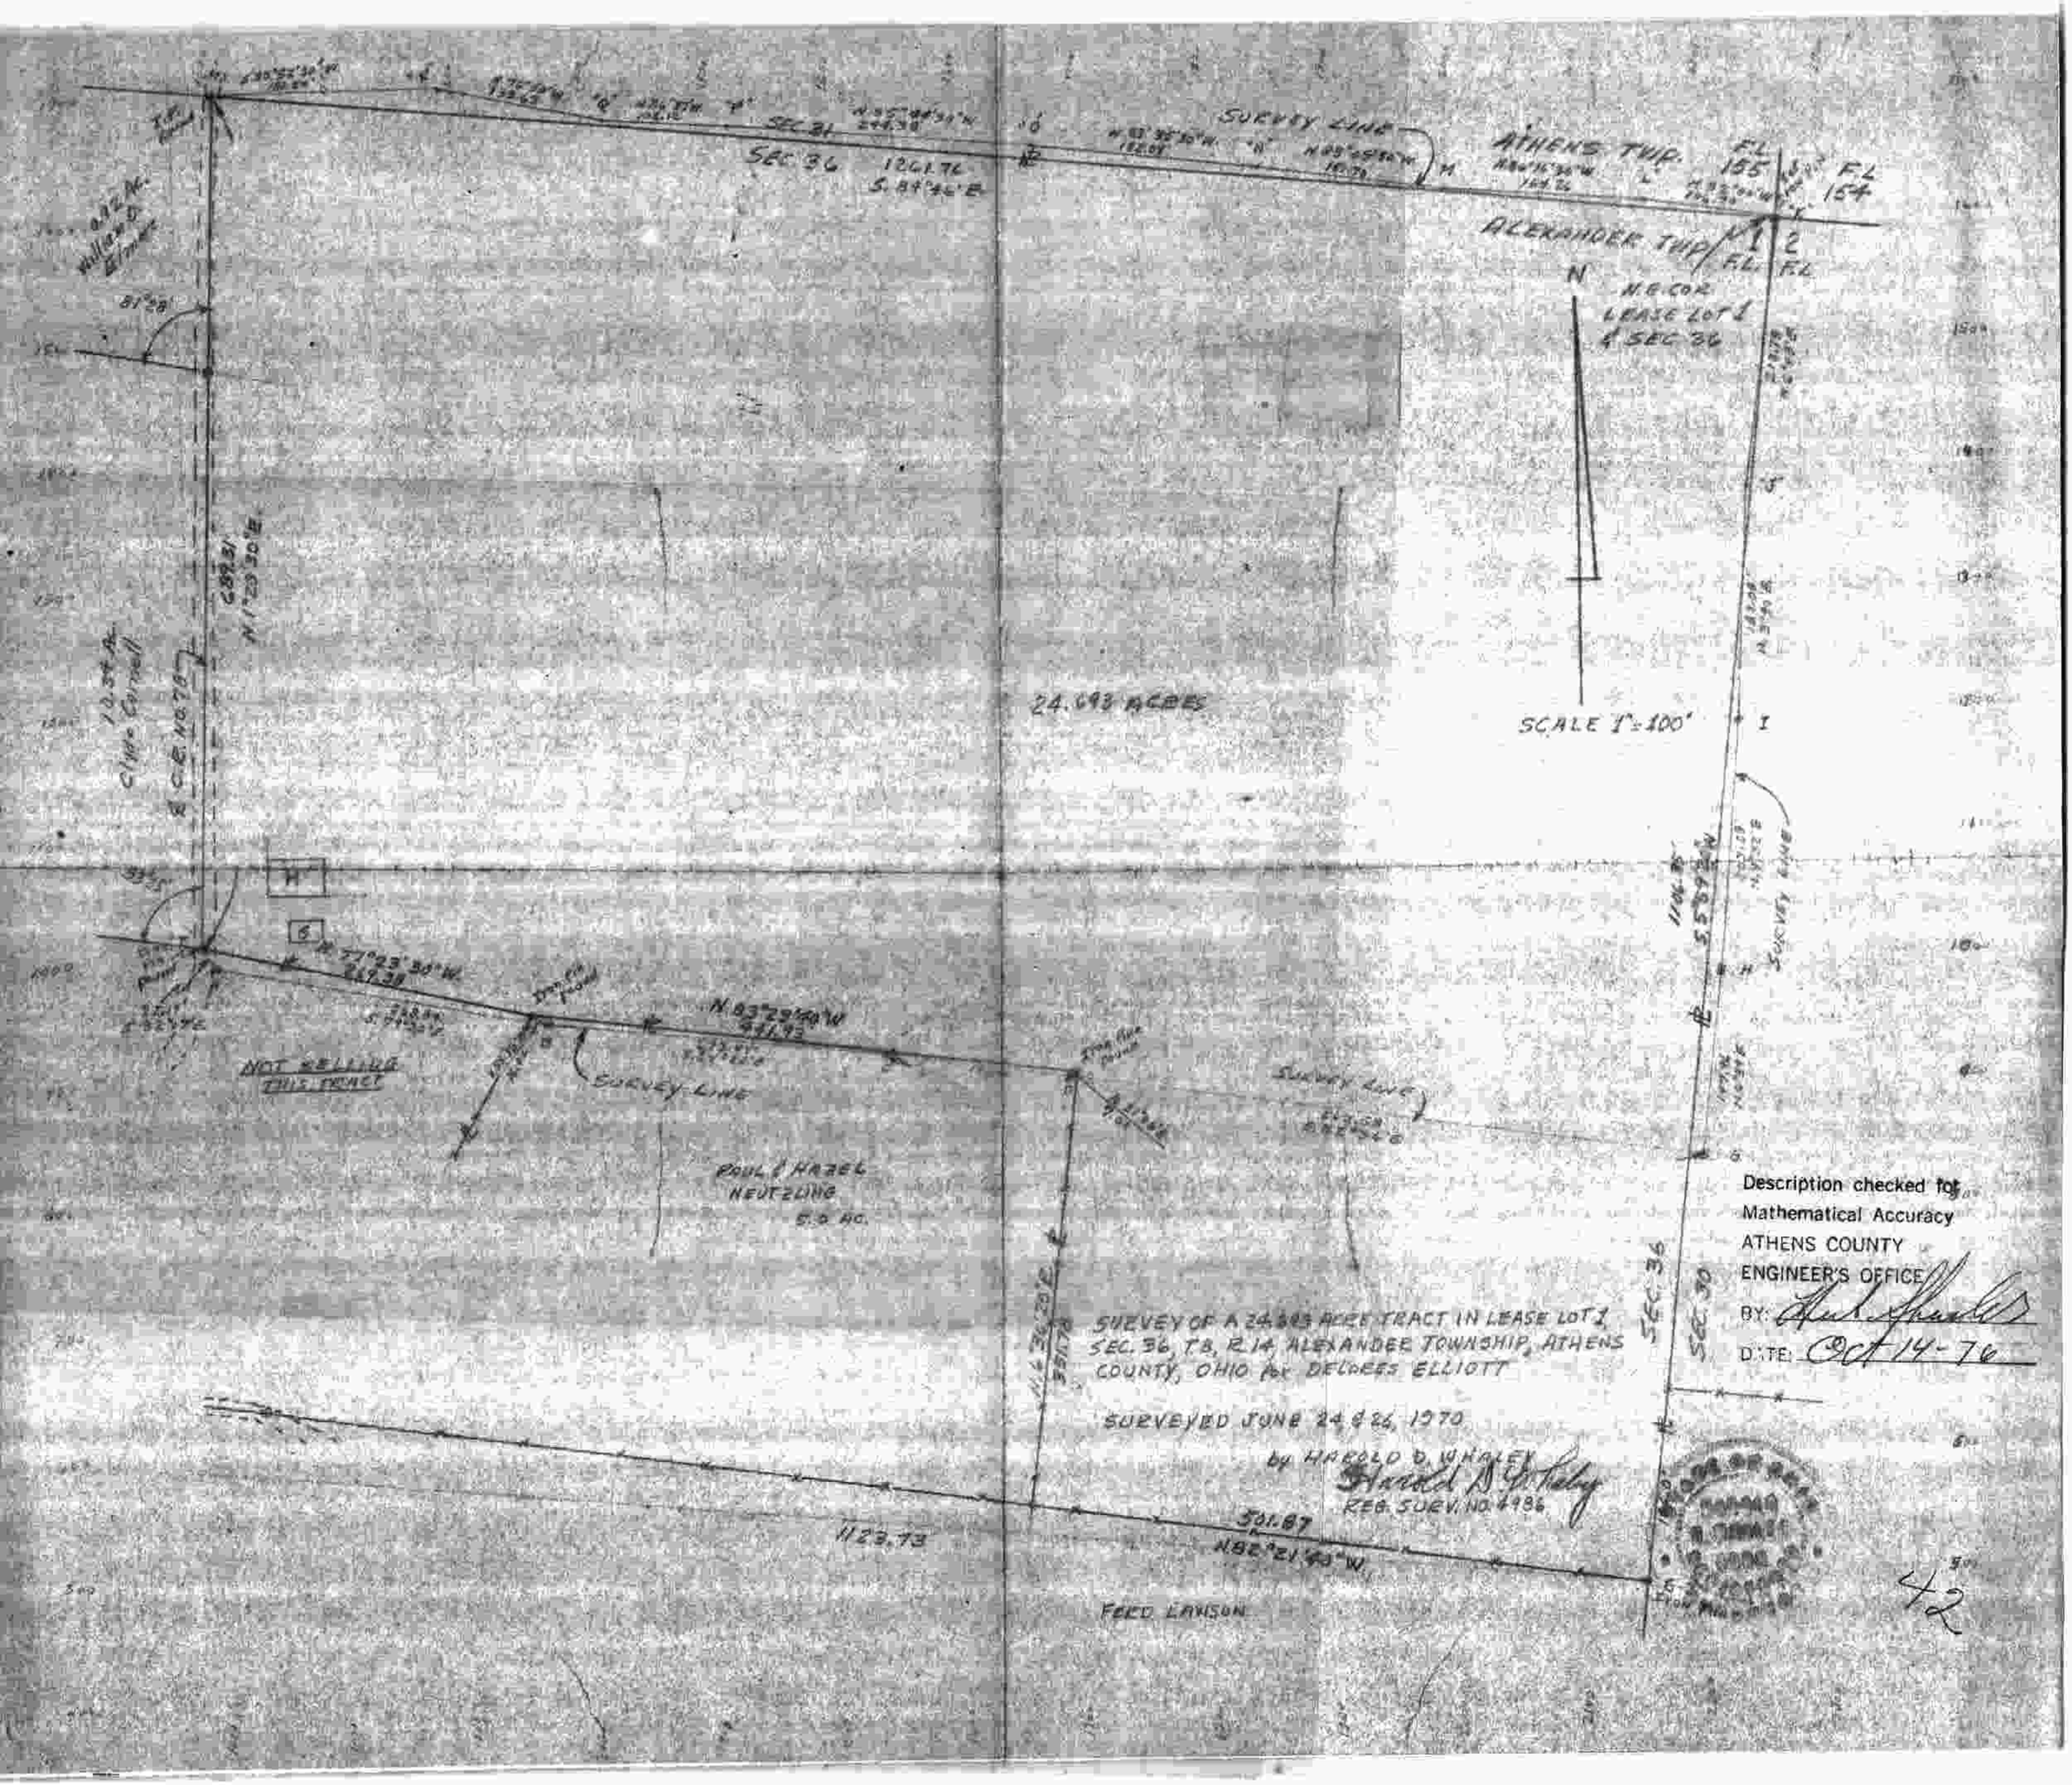
SURVEY LINE
ATHENS TWP.
ALEXANDER TWP.
SEC 31
SEC 36
F.L. 155
F.L. 154
N.E. COR. LEASE LOT 1 & SEC 36
N
SCALE 1"=100'
24.693 ACRES
NOT SELLING THIS TRACT
SURVEY LINE
PAUL & HAZEL NEUTZLING
SURVEY OF A 24.693 ACRE TRACT IN LEASE LOT 1, SEC. 36, T8, R14, ALEXANDER TOWNSHIP, ATHENS COUNTY, OHIO for DELORES ELLIOTT
SURVEYED JUNE 24 & 26, 1970
by HAROLD D. WHALEY
REG. SURV. NO. 4986
FERD LAWSON
SEC 36
SEC 30
Description checked for Mathematical Accuracy
ATHENS COUNTY
ENGINEER'S OFFICE
BY:
DATE: Oct 14-76
42