Know All Men By Orese Hresents.

That EDWIN HIXSON and FLORA HIXSON, husband and wife, GRANTORS

, the Grantor s, who claim title by or through instrument, recorded in Volume 188, Page 540, County Recorder's Office, for the divers good causes and considerations thereunto moving, and especially for the sum of One Dollar and natural love and affection Dollars (\$ 1.00) received to their full satisfaction of Leo W. Hixson and Patricia A. Hixson, husband and wife,

the Grantees, whose $TAX\ MAILING\ ADDRESS\ will\ be\$ Route\ #3, Box\ 73, Athens, Ohio, do

Give, Grant, Bargain, Sell and Convey unto the said Grantees, LEO W.

HIXSON and PATRICIA A. HIXSON, husband and wife, GRANTEES,
a joint life estate with remainder over in fee simple to the survivor of them,
their heirs and assigns, the following described premises, situated in the
Township of Ames , County of Athens and State of Ohio:

The following Real Estate situate in Section 25 T.6, R. 13, Ames Township, Athens County, Ohio, and bounded and described as follows:

Beginning at a point on the half Section line which is S 84°00'E 2769.21 feet along the north line and S 6°00'W 182.75 feet from the northwest corner of Section 25 thence N 73°22'E 115.45 Feet to an iron pin thence S 48°45'E 230.76 feet to an iron pin thence S 56°31'W 435.44 feet to the center of County Road 34, passing an iron pin at 405.34 feet, thence along said road N 30°53'W 331.86 feet to a point, thence leaving said road N 73°22'E 260.34 feet to the place of beginning passing an iron pin at 27.42 feet, and containing 1.11

in the west half, and 1.37 acres in the east half, making 2.48 in said tract, subject to road R/W.

REFERENCE: Being part of the premises described in Volume 188, Page 540 of the Athens County Deed Records.

Surveyed by Joe L. Galvin, May 14, 1969. Reg. Sur. #1684.

Description checked for Mathematical Accuracy

/ THENS COUNTY ENG.NEER'S OFFICE


1-74-76

DATE 5-24-14

On have and in hold the above granted and bargained premises, with the appurtenances thereunto belonging, unto the said Grantees, a joint life estate with remainder over in fee simple to the survivor of them, heirs and assigns forever. And the said Grantors , for themselves and their heirs, executors and administrators, hereby covenant with the said Grantees, their heirs and assigns, that said Grantor s the true and lawful owners are said premises, and are well seized of the same in FEE SIMPLE, and good right and full power to bargain, sell and convey the same in the manner aforesaid, and that the same are free and clear from all encumbrances, excepting taxes, easements, assessments and rights of ways of record, and further, that said Grantors will warrant and defend the same against all claims of all persons whatsoever, except as hereinbefore provided. In Witness Whereof have hereunto set our hand s, the We June day of , in the year of our Lord one thousand nine hundred and seventy-four. and acknowledged in presence of Flora Hixson State of Ohio | ss. Before me, a Notary Public in and for said County and State, personally appeared County, \ the above named Edwin Hixson and Flora Hixson, husband and wife, Grantors, who acknowledged that they did sign the foregoing instrument and free act and deed. that the same is their In Testimony Whereof, I have hereunto set my hand and official seal, at Athens, Ohio, A. D. 1974 20th thisday of June Oother F. Newcomb, Notary Public State of Ohio, Lifetime Commission (SEAL) This instrument prepared by John F. Newcomb, Attorney, Athens, COUNTY AUDITOR Flora Patricia and and wfie and and husband husband

3

Leo

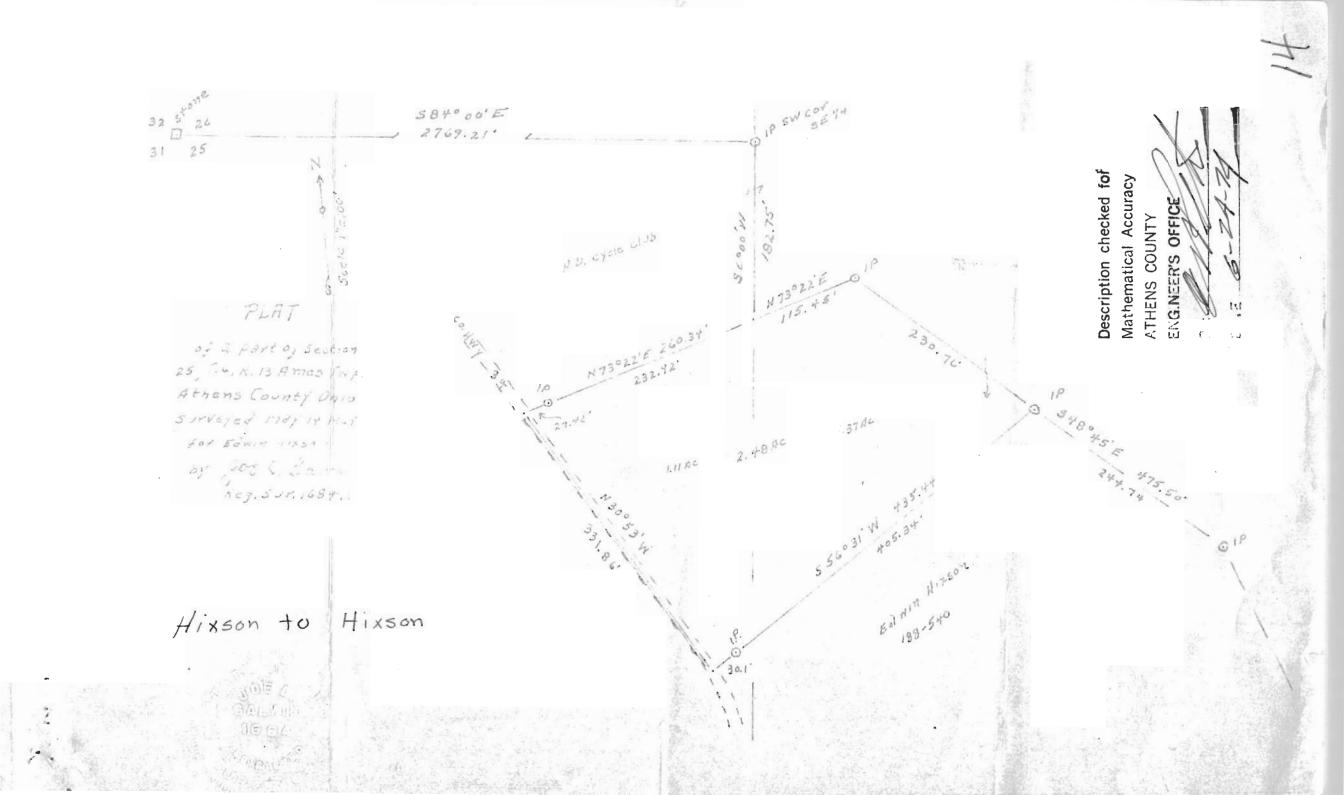

John F. Newcomb Attorney And Counsellor At Law 15-17 Court Street Athens, Ohio 45701

June 20, 1974

Athens County Engineer's Office 555 East State Street Athens, Ohio 45701

Re: Hixson To Hixson Description

Dear Sir: Enclosed herein, find copies of a plat and a deed in the name of Edwin and Flora Hixson to Leo and Patricia Hixson.

Please check this proposed deed description and notify my office of your results upon completion.

John F. Newcomb

JFN/dlm Enclosures