



SCALE 1 INCH = 300 FEET
 ○ = IRON PIN FD.
 ● = IRON PIN SET
 BEARING ARE TO BE USED
 TO DENOTE INTERIOR ANGLES ONLY
 □ = STONE FD.

Line	Bearing	Distance
19	S 66°57'39"W	93.16'
20	S 84°55'09"W	241.99'
21	N 32°41'00"E	42.50'
22	N 27°52'00"E	108.98'

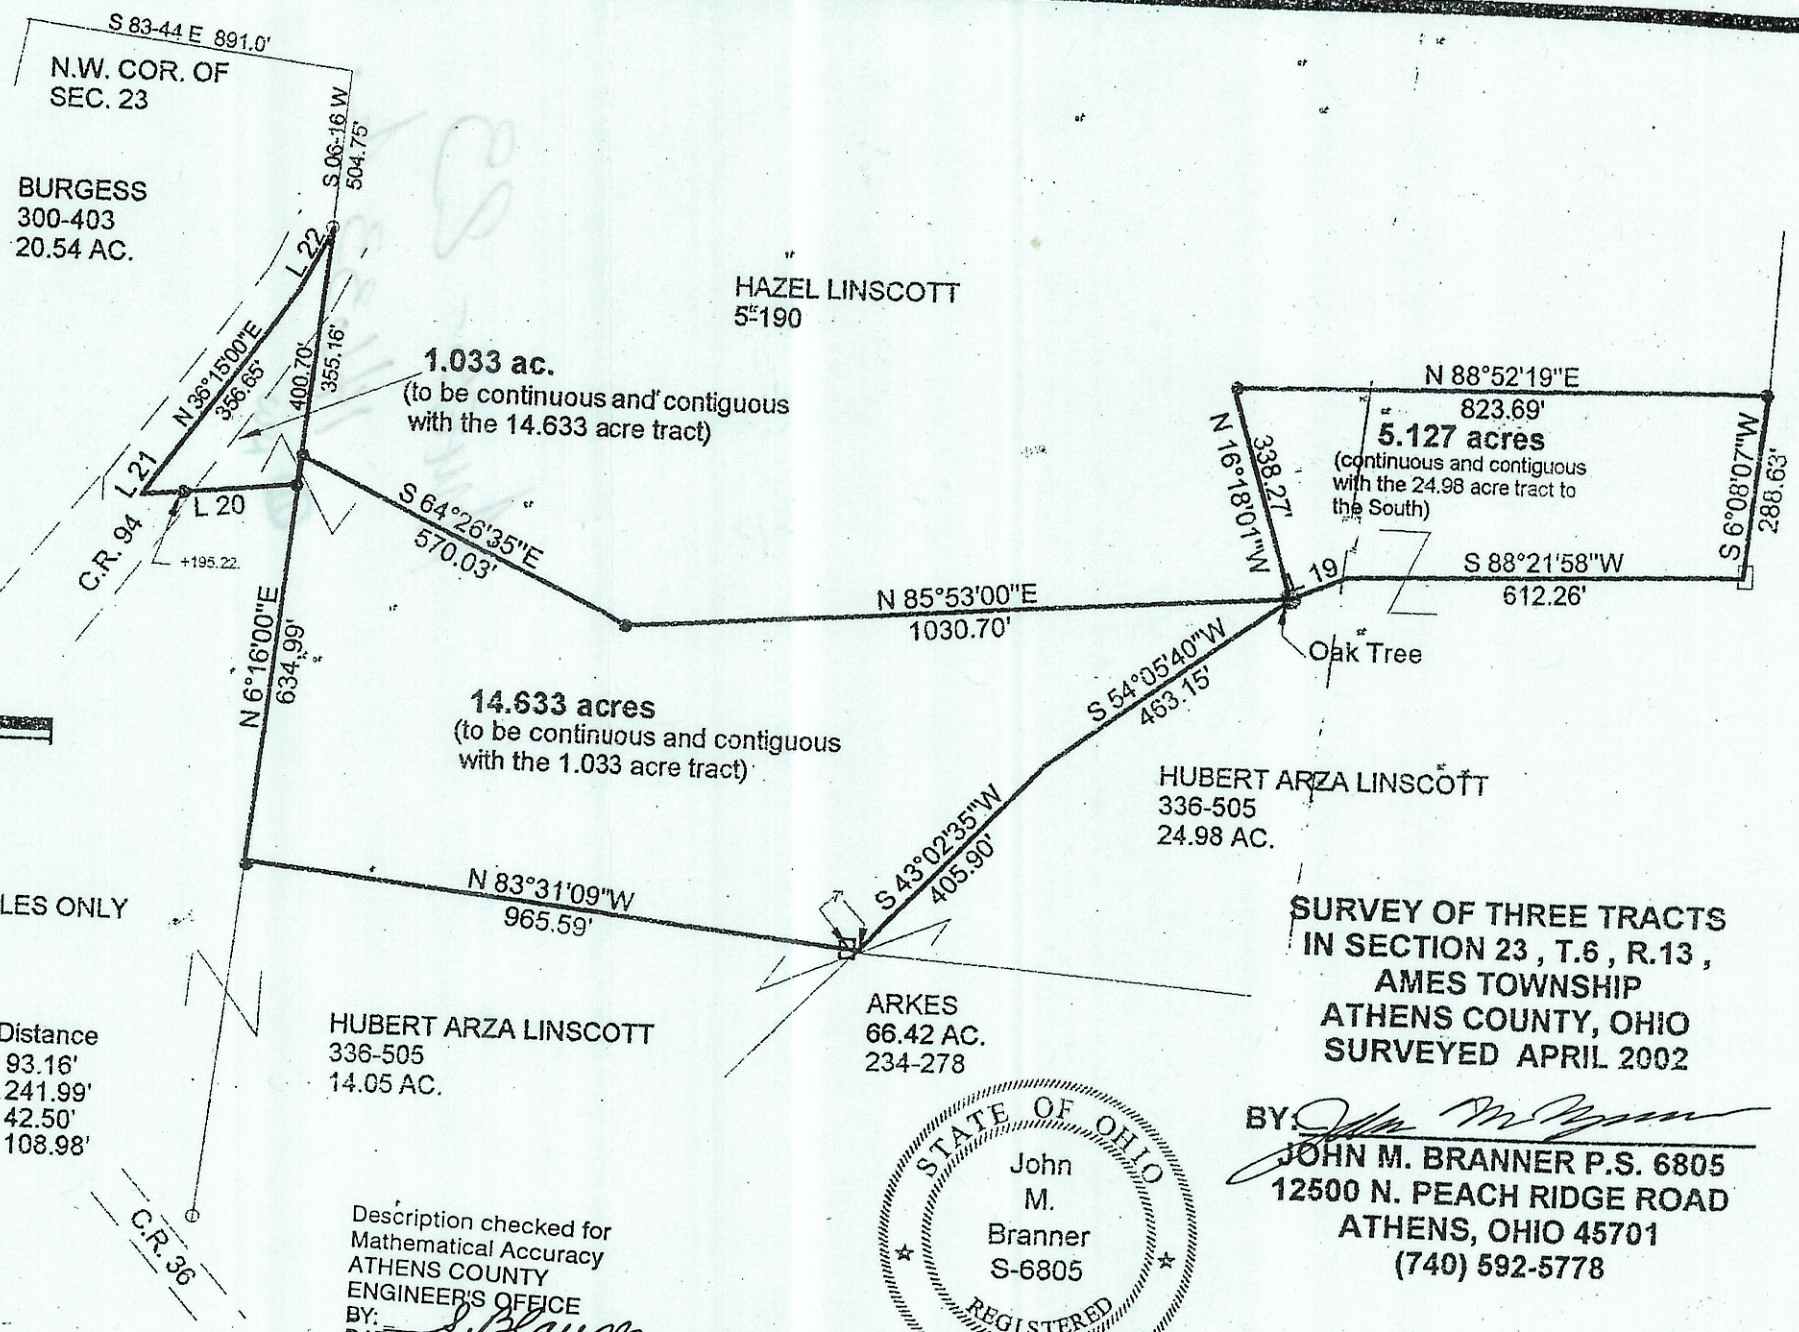

Description checked for
 Mathematical Accuracy
 ATHENS COUNTY
 ENGINEER'S OFFICE
 BY: *S. Blauson*
 DATE: 4-29-02

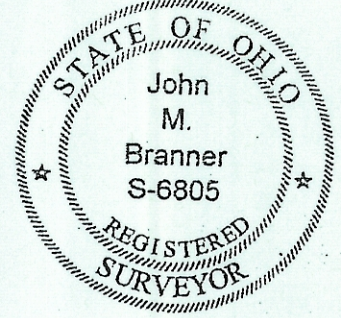

**SURVEY OF THREE TRACTS
 IN SECTION 23, T.6, R.13,
 AMES TOWNSHIP
 ATHENS COUNTY, OHIO
 SURVEYED APRIL 2002**

BY: *John M. Branner*
**JOHN M. BRANNER P.S. 6805
 12500 N. PEACH RIDGE ROAD
 ATHENS, OHIO 45701
 (740) 592-5778**