


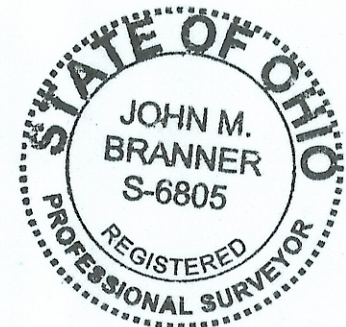

STELLA ROAD
L7

Description Checked for
Mathematical Accuracy
Athens County
ENGINEER'S OFFICE
BY: Peranda Williams
DATE: 10/23/14

Line	Bearing	Distance
1	N 3° 49' 54" E	134.76'
2	N 7° 36' 49" E	97.32'
3	N 5° 56' 2" W	82.68'
4	N 23° 37' 40" E	32.12'
5	N 38° 18' 19" E	44.92'
6	N 51° 57' 46" E	54.16'
7	N 65° 33' 49" E	204.22'
8	N 49° 27' 39" E	38.41'
9	N 42° 43' 50" E	141.62'
10	N 62° 40' 0" E	119.09'
11	N 78° 01' 35" E	110.06'
12	S 86° 23' 49" E	48.46'
13	S 65° 29' 17" E	62.59'
14	S 47° 52' 45" E	127.71'



BORTON
ADELAIDE
307-793

10.15 Acres

Sec.34 (4.65 AC.)
Sec.33 (5.50 ac.)

Black walnut tree
S 83° 17' 57" E
205.74'

Survey of a 10.15 Acre Tract in
Sec. 23 and Sec. 24, T.9, R.13,
Ames Twp., Athens-Co., Oh

Surveyed October 2104

John M. Branner P.S. 6805
62 East First Street
The Plains, Ohio
740-541-0350



Scale 1 inch = 100 feet
● = iron pin fd
○ = iron pin set 5/8"x 30" rebar w/plastic I.D. cap
Bearings Based on N.A.D. 83 Grid North

S.W. Cor of Fr. 24

John M. Branner

Ames-23-24-10.15-10.15-7

