

S 43° 36' 19" E 139.81'

IV

10.45 Ac

S 89° 24' 47" E 394.00'

VI

S 45° 40' 13" E 430.00'

PART OF LOT IV

5.00 ACRES

~~TO BE CONTIGUOUS WITH LOT III~~

PART OF LOT IV

4.33 AC

TO BE CO CONTIGUOUS WITH LOT III

N 31° 36' 31" W 720.77'

50' EASEMENT INGRESS EGRESS


448.93'

N 06° 22' 55" E 257.750'

III

SW COR SEC. 33

SCALE: 1"=100'

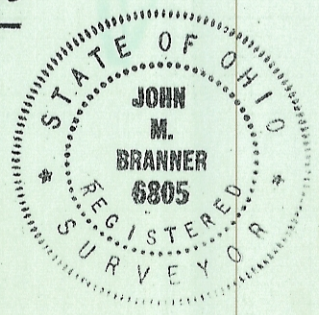

BRANNER SURVEYING  
12500 N PEACH RIDGE RD  
ATHENS, OHIO 45701

PLAT OF DESCRIPTION  
OF A 5.00 ACRE TRACT T6, R13 Ames  
IN SEC. 33 T-6 R-13 BOWER TWP  
ATHENS CO. OHIO  
Mc DOUGALVILLE  
SUBDIVISION

*John M. Branner*  
JOHN M. BRANNER P.S. 6805

63-748