


Sayers Parcel 2-A

Description of 8.431 acres

Situated in Section 36, Town 6, Range 13, Ames Township, Athens County, Ohio and being more particularly described as follows;

Commencing at a stone found on the northwest corner of Said Section 36; thence along the north of said section S 88°28'03" E 1654.75 feet to an iron pin found; thence leaving the section line S 36°26'45" E 373.51 feet to an iron pin found; thence N 61°18'14" E 385.19 feet to an iron pin found in North LaFollette Road; thence along the center of said road S 1°33'10" W 480.00 feet; thence continuing S 1°33'10" W 375.68 feet to an iron pin set in the intersection of North LaFollette Road and North Concord Road, the point of beginning of the tract herein described; thence continuing S 1°33'10" W 1110.81 feet to an iron pin set; thence N 88°26'50" W 350.00 feet to an iron pin set; thence N 1°33'10" E 1050.00 feet (passing an iron pin set at 1020.00 feet) to a point in the center of North Concord Road; thence along said road S 79°14'26" E 127.33 feet; thence N 88°44'24" E 65.40 feet; thence N 75°20'24" E 49.12 feet; thence N 70°34'23" E 47.26 feet; thence N 56°35'34" E 82.61 feet to the point of beginning containing 8.431 acres.

Prior deed reference Volume 369, Page 695 Athens County Deed Records.

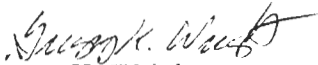

Gregory K. Wright
Registered Suveyor S-6535
11684 Channingway Blvd
The Plains, Ohio 45780

Description checked for
Mathematical Accuracy
ATHENS COUNTY
ENGINEER'S OFFICE
BY: S. Blause
DATE: 6-30-98

63


Morgan County
Athens County
Northwest Corner Section 36

S 88°28'03" E
1654.75'

- = Iron Pin Found
- = Iron Pin Set
- = Stone Found

North LaFollette Road

Parcel 2-A
Survey of 8.431 Acres
Situated in Section 36,
Town 6, Range 13, Ames
Township, Athens County,
Ohio
Surveyed June 1998

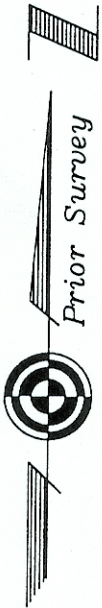

Gregory K. Wright

Gregory K. Wright

North Concord Road
S 79°14'26" E L14
127.33' L13 L15

2-A
367,243 sq. ft.
8.431 acres

LINE TABLE		
LINE	LENGTH	BEARING
L13	65.40	N88°44'24"E
L14	49.12	N75°20'24"E
L15	47.26	N70°34'23"E
L16	82.61	N56°35'34"E

N 01°33'10" E
1050.00'
1110.81'
S 01°33'10" W
350.00'
N 88°26'50" W

OK to transfer
Athens City Co (H.I.)
Dexter Conrad (RS)
9-4-98

Description checked for
Mathematical Accuracy
ATHENS COUNTY
ENGINEER'S OFFICE
BY: *S. Plausen*
DATE: 6-30-98



GRAPHIC SCALE



(IN FEET)
1 inch = 200 ft.