SOUTHEASTERN LAND SURVEYS

LEONARD F. SWOYER
REGISTERED PROFESSIONAL LAND SURVEYOR

3428 Pleasant Hill Road
Athens, Ohio 45701
614/593-8701

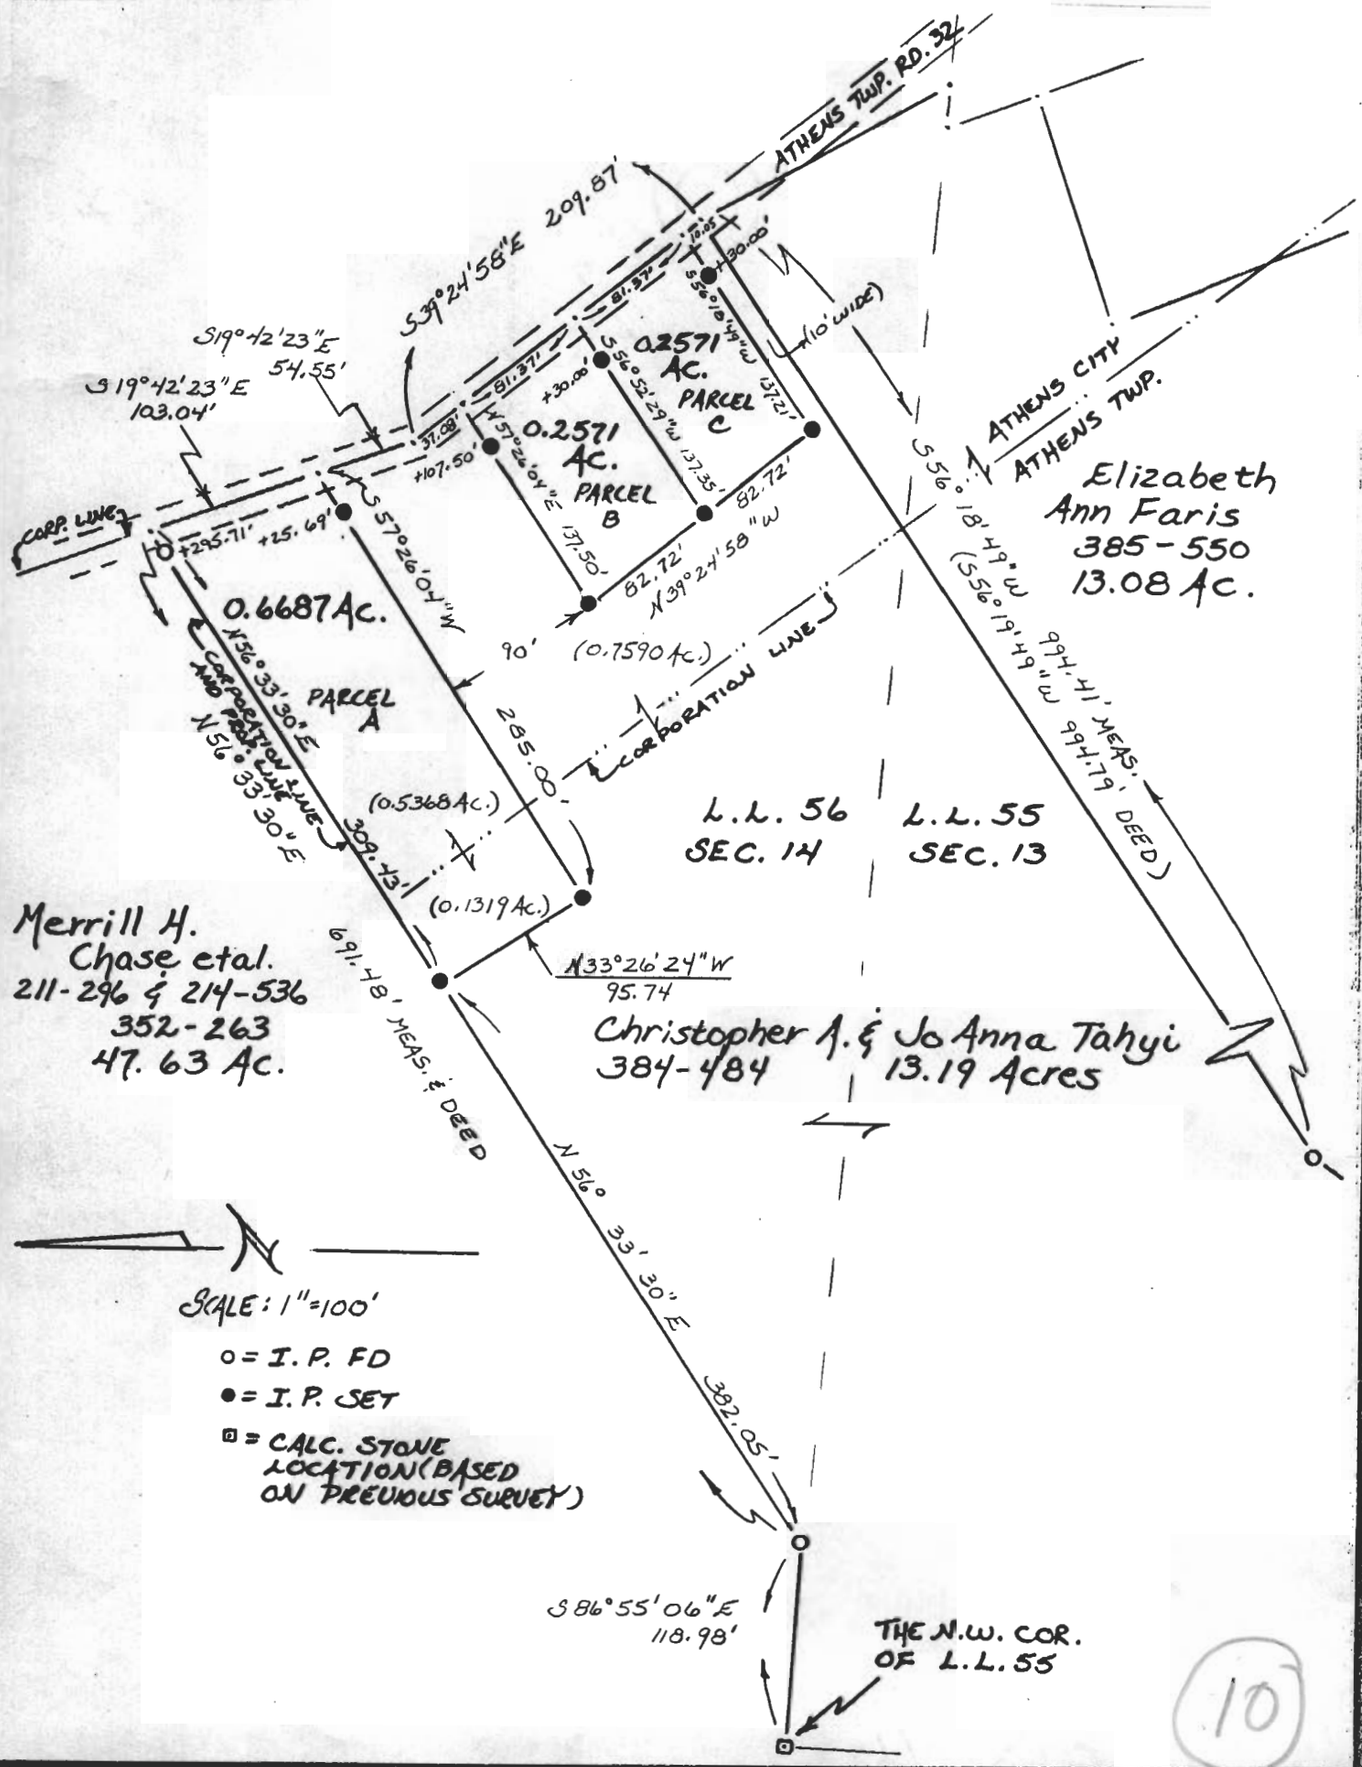

10

Plat of Three Parcels: A,B, and C Scale 1"= 100'

Surveyed for Mr. Christopher Tahyi Date 3/29/90

Subdivision L.L.56

Township Athens Section 14 Town 9 Range 14

Corporation (Partly) Athens City County Athens State Ohio

Leonard F. Swoyer II

Leonard F. Swoyer II Reg. Prof. Land Surveyor No. 6765