Phone 740-753-1264 Fax 740-753-1264

Description of a 1.783 Acre Tract

Situated in Farm Lot 68, Section 18, T-9, R-14, City of Athens, Athens Township, Athens County, State of Ohio and being a tract as described in Volume 83, Page 602 of the Official Records of Athens County and being more particularly described as follows;

BEGINNING at an iron pin on the south line of Farm Lot 68 that bears North 85°53'37"West, 1356.13 feet (calculated) from the southeast corner of said Farm Lot,

THENCE along said south line North 85°53'37"West, 204.04 feet to an iron pin found,

THENCE North 16°01'55"East, 416.56 feet to an iron pin set on the south Right of Way of TR-1255, (passing an iron pin set at 206.56 feet),

THENCE along said Right of Way South 70°20'15"East, 200.00 feet to an iron pin found,

THENCE South 16°01'35"West, 361.73 feet to the point of beginning (passing an iron pin set at 174.92 feet) and containing 1.783 acres.

Bearings are to an assumed meridian and are for angular determination only Subject to all Easements and Rights of Way of record

Kenneth E. Highland S-7581

KENNETH E. HIGHLAND


Description checked for Mathematical Accuracy ATHENS COUNTY ENGINEERS OFFICE

BY: Can to hun

Railroad Spike set in Power Pole Elevation =651.23' TR-1255 **Bortle** 83-602 OR ¹206.56' Athens Motel Assoc. 174.92 28-915 OR 1.783 Ac. Taylor Real Estate, Ltd. 285-1766 OR S.E. corner of F.L. 68 -Farm Lot 68 N 85°53'37"W Farm Lot 50 N 85°53'37"W 1356.13' (calc.) 204.04 o = Iron Pin Set Scale 1"=80' 160' = Iron Pin Found 80' Description checked for

HIGHLAND SURVEYING Ltd.

Registered Professional Land Surveyor

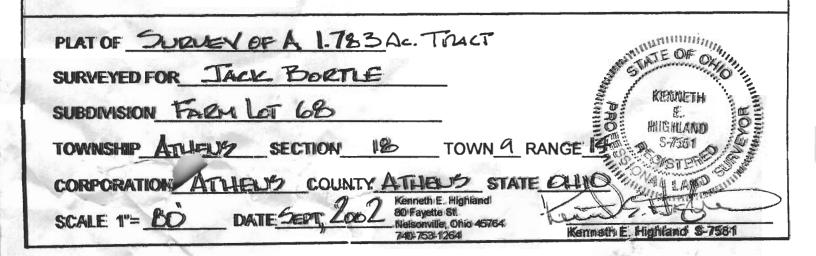

Mathematical Accuracy ATHENS COUNTY ENGINEERIS OFFICE BY:

Lante,