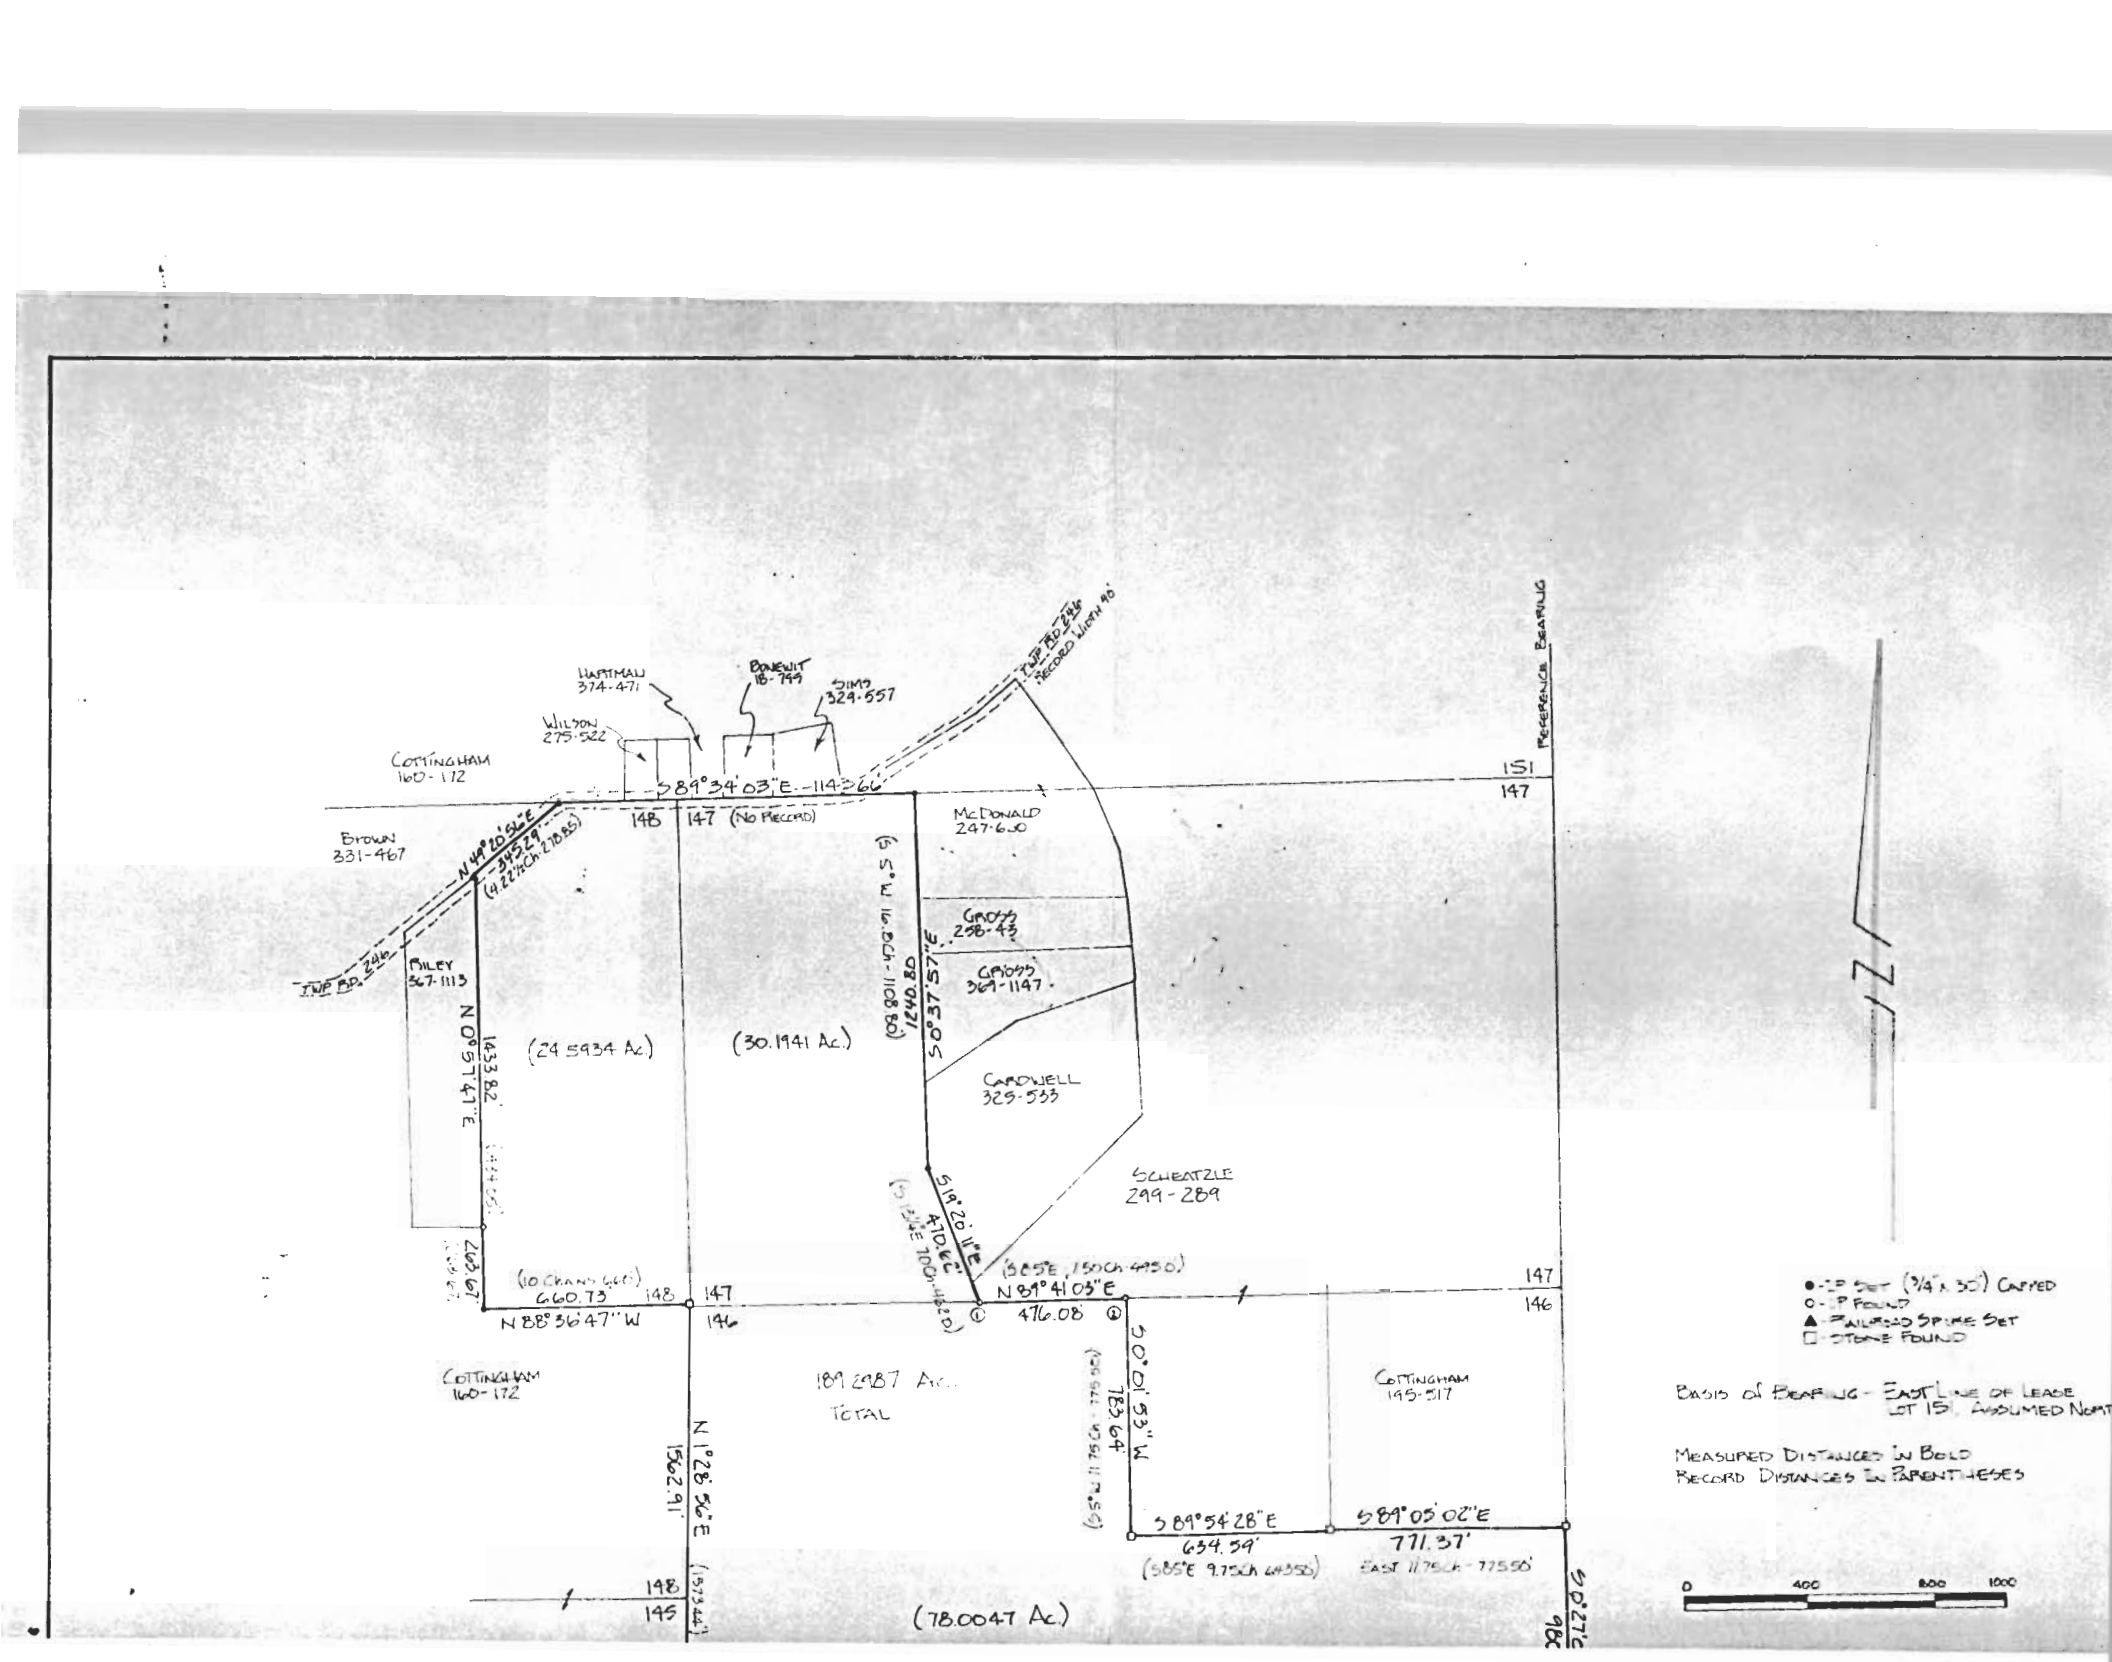

FOUND IRON PIN W/RING ON TOP END AS DESCRIBED IN 1930 SURVEY. ATHENS COUNTY SURVEYORS RECORDS

FOUND 1½" x ¼" IRON BAR AS DESCRIBED IN 1930 SURVEY.

For:

SOUTHERN OHIO COAL COMPANY

PLAT OF SURVEY

220.2987 Acres

LOCATED IN FARM LOTS 144, 146, 147 & 148
SECTIONS 23, 29, 30 TOWN 9, RANGE 14
ATHENS TOWNSHIP, ATHENS CO. OHIO

SCALE 1" = 400' JAN. 1986

PREPARED BY

EVANS, MECHWART, HAMBLETON & TILTON INC.
CONSULTING ENGINEERS AND SURVEYORS
GALLIPOLIS, OHIO — ATHENS, OHIO

Gregory K. Wright
REGISTERED SURVEYOR No. 6535

STATE OF OHIO
GREGORY K. WRIGHT
S-6535
REGISTERED SURVEYOR

31

REVISED 4/22/86