

BY DATE
CHKD. BY DATE


SUBJECT

SHEET NO. OF 75 # 9

JOB NO.



FLOYD BURKE
222 - 423

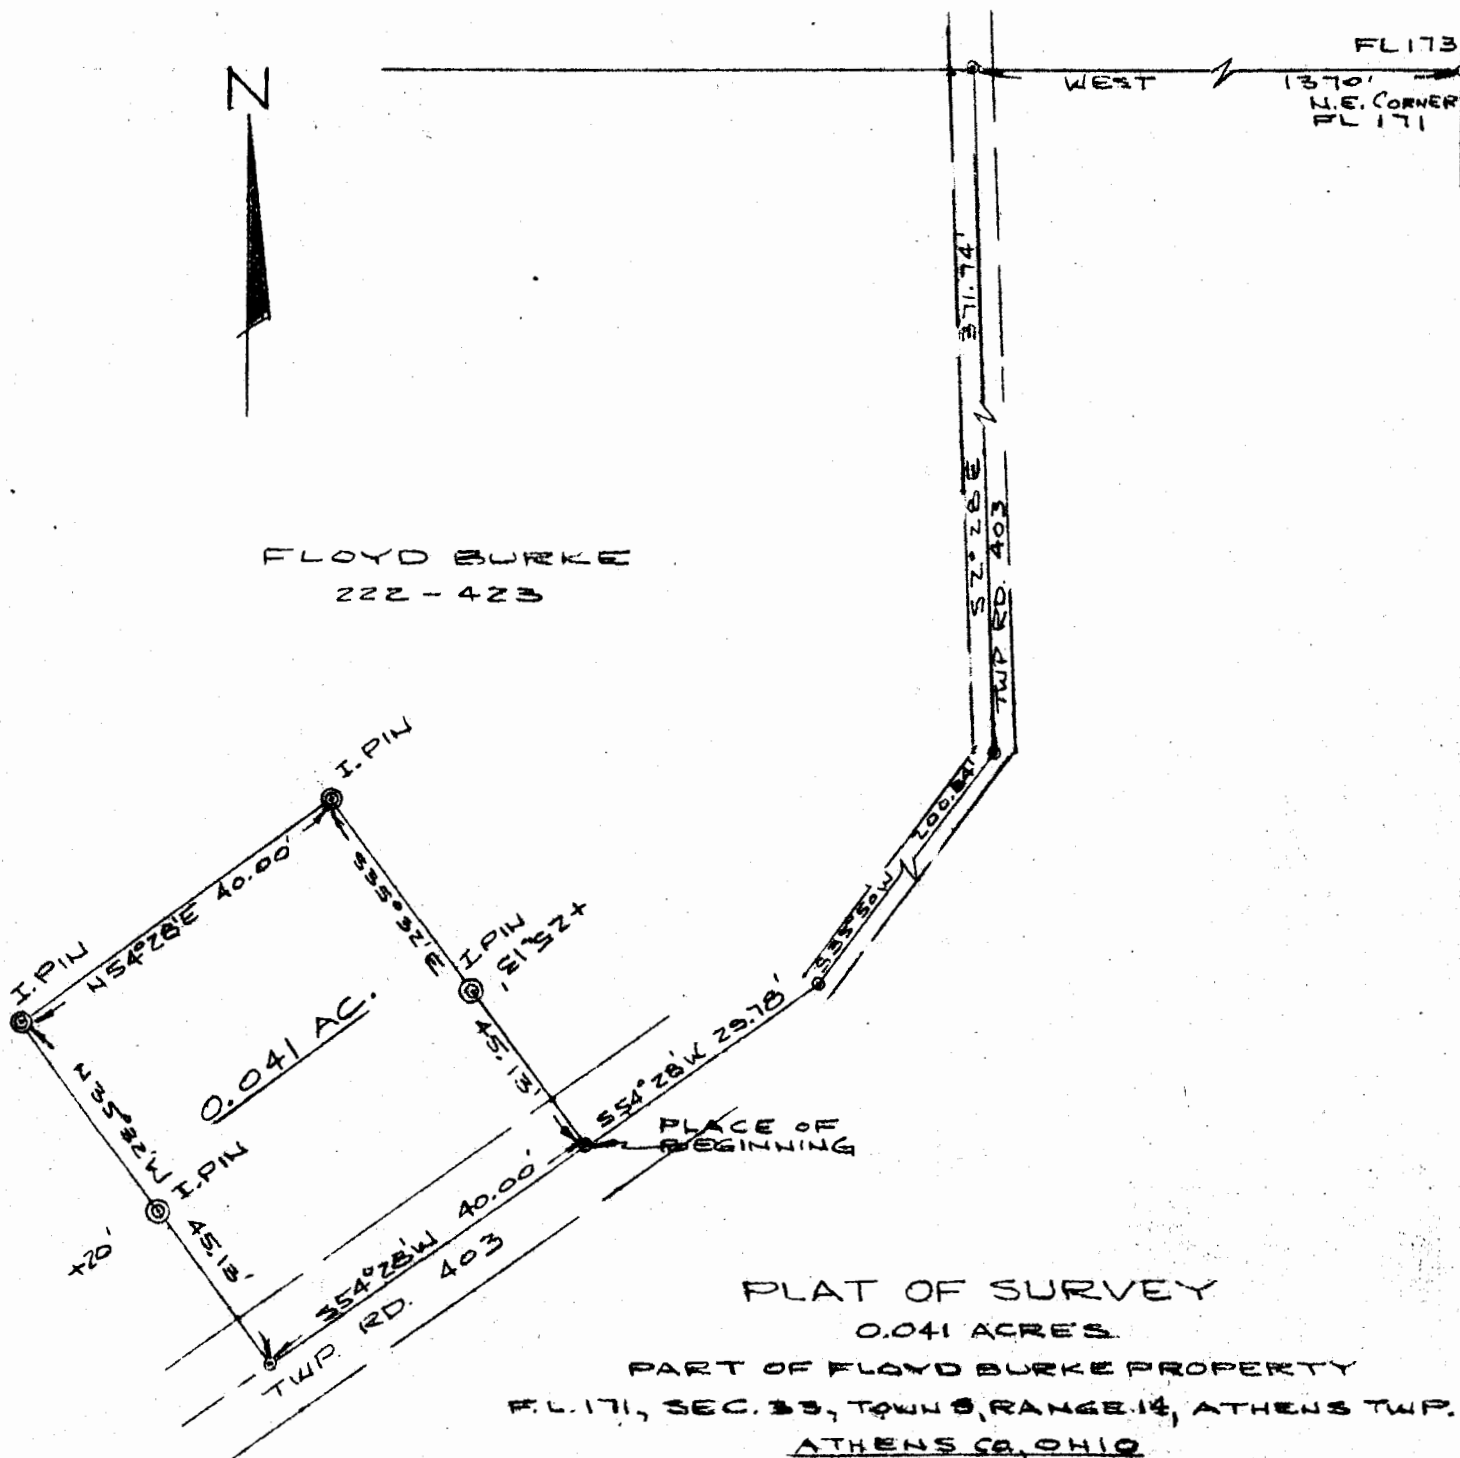

PLAT OF SURVEY

0.041 ACRES

PART OF FLOYD BURKE PROPERTY

P.L. 171, SEC. 33, TOWNSHIP RANGE 14, ATHENS TWP.

ATHENS CO, OHIO

PREPARED BY

EVANS, MECHWART, HAMBLETON & TILTON, INC.

CONSULTING ENGINEERS & SURVEYORS

GAHANNA, OHIO

ATHENS, OHIO

SCALE: 1"=50'

NOV., 1975

William M. Watkins
REGISTERED SURVEYOR #5216