


APPROVED BY THE CITY PLANNING
COMMISSION; NO PLAT REQUIRED.


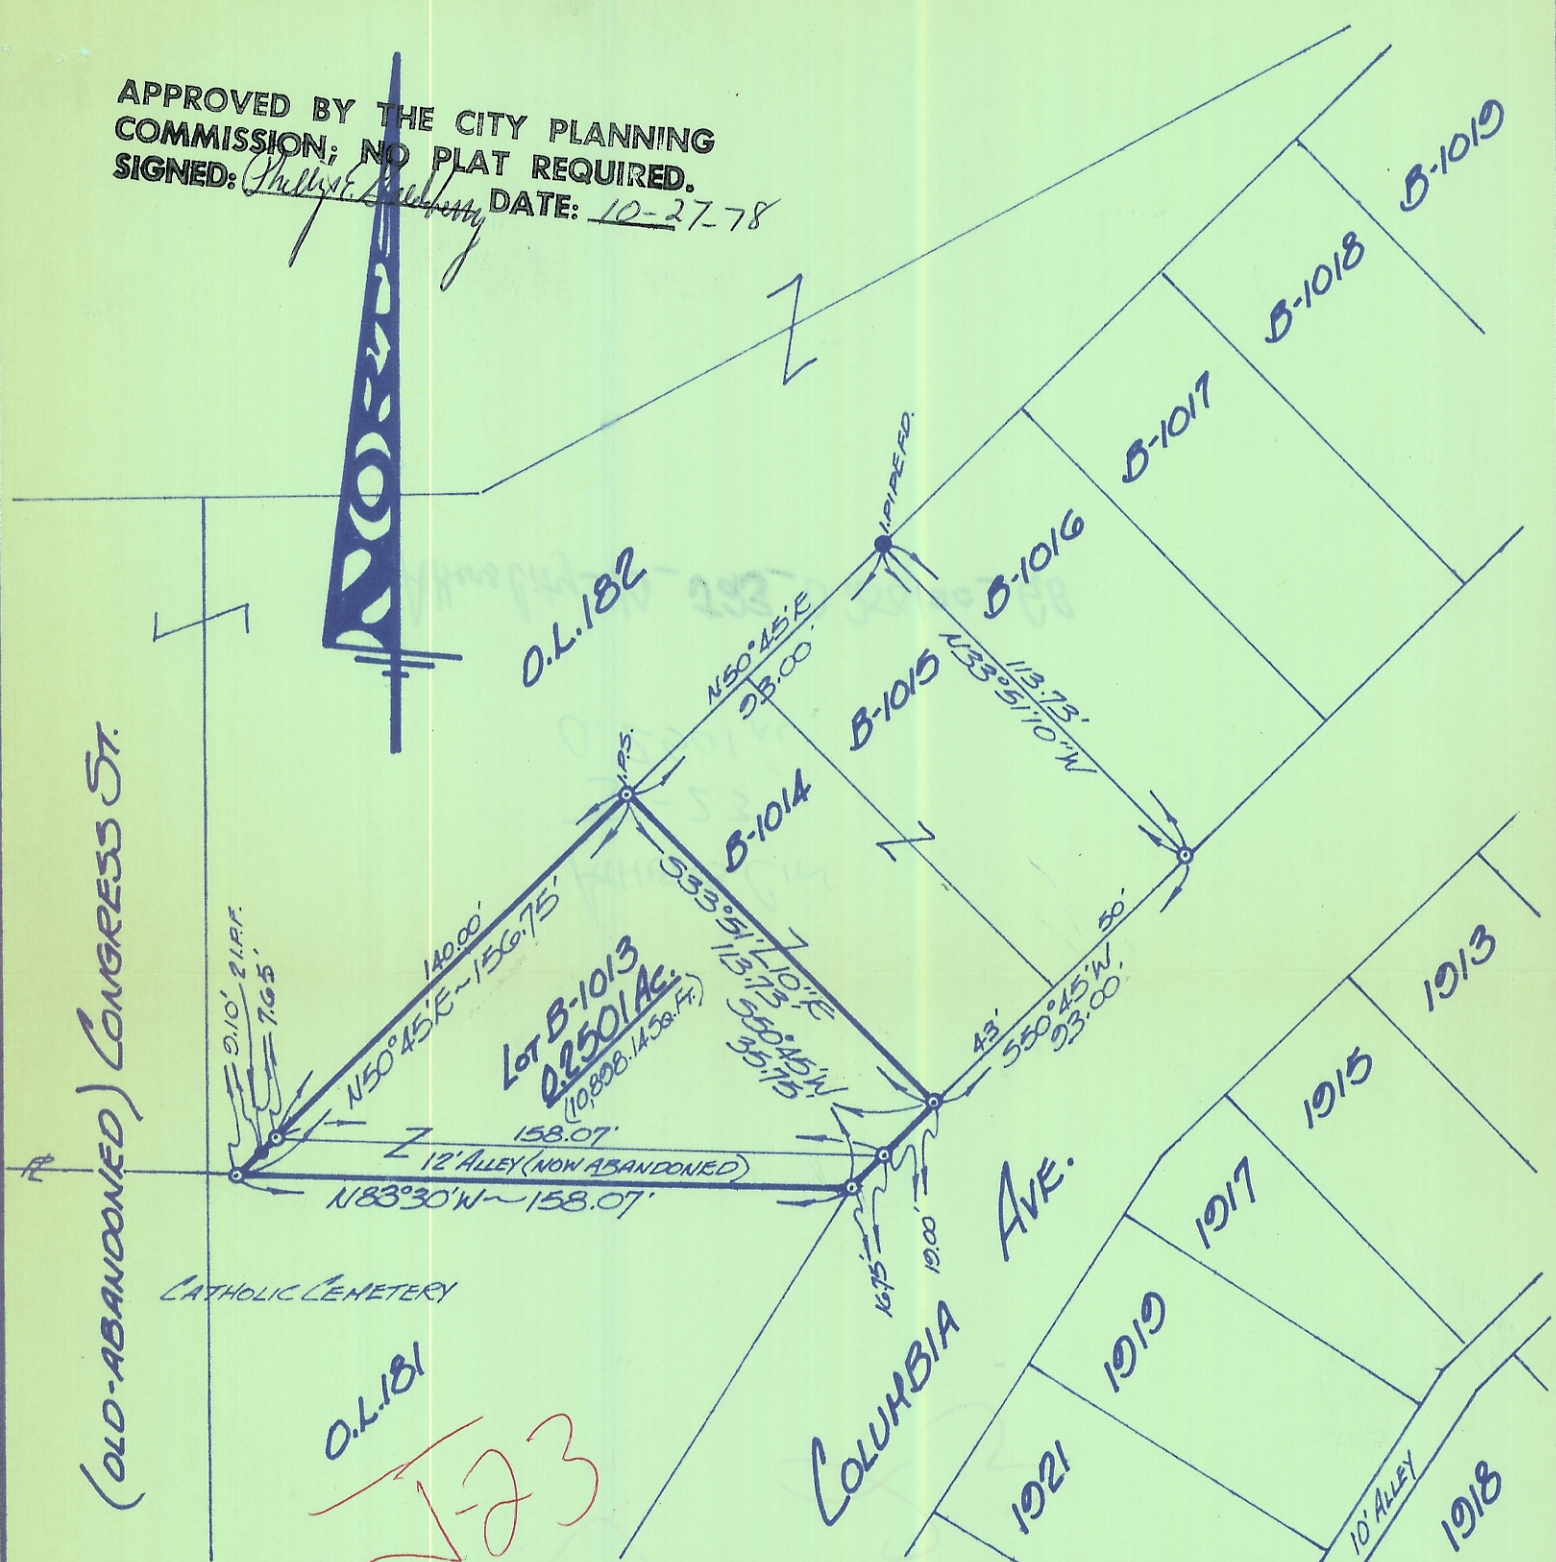

DRAWN: *SB*

SURVEYED FOR: **CARL WEBER**

SCALE: 1" = 50'

PLAT OF SURVEY

OF LOTS No. 1013 & 1014 AND A 12.0' ALLEY TO THE SOUTH OF LOT 1013 IN THE "HENRY BOSKA SUB'D." SITUATE IN O.L. 182 - SECTION 10 - T.9 N - R. 14 W - ATHENS CITY - ATHENS TOWNSHIP - ATHENS COUNTY - OHIO - U.S.A.

GERALD W. BAYHA, P.S.

REGISTERED PROFESSIONAL SURVEYOR No. 5-6139
 ROUTE No. 5 - Box No. 204 (PEASANT HILL) ATHENS, OHIO - 45701 - PHONE: (614) 592-4398
 JOB No.: 878-05 SURVEY DATE: 1 SEPT. 78 PLAT DATE: 23 OCT. 78

Gerald W. Bayha, P.S.