Hunter Hooe Survey - By Galvin

ATHENS CITY 10
JG
4 LOTS

K-24

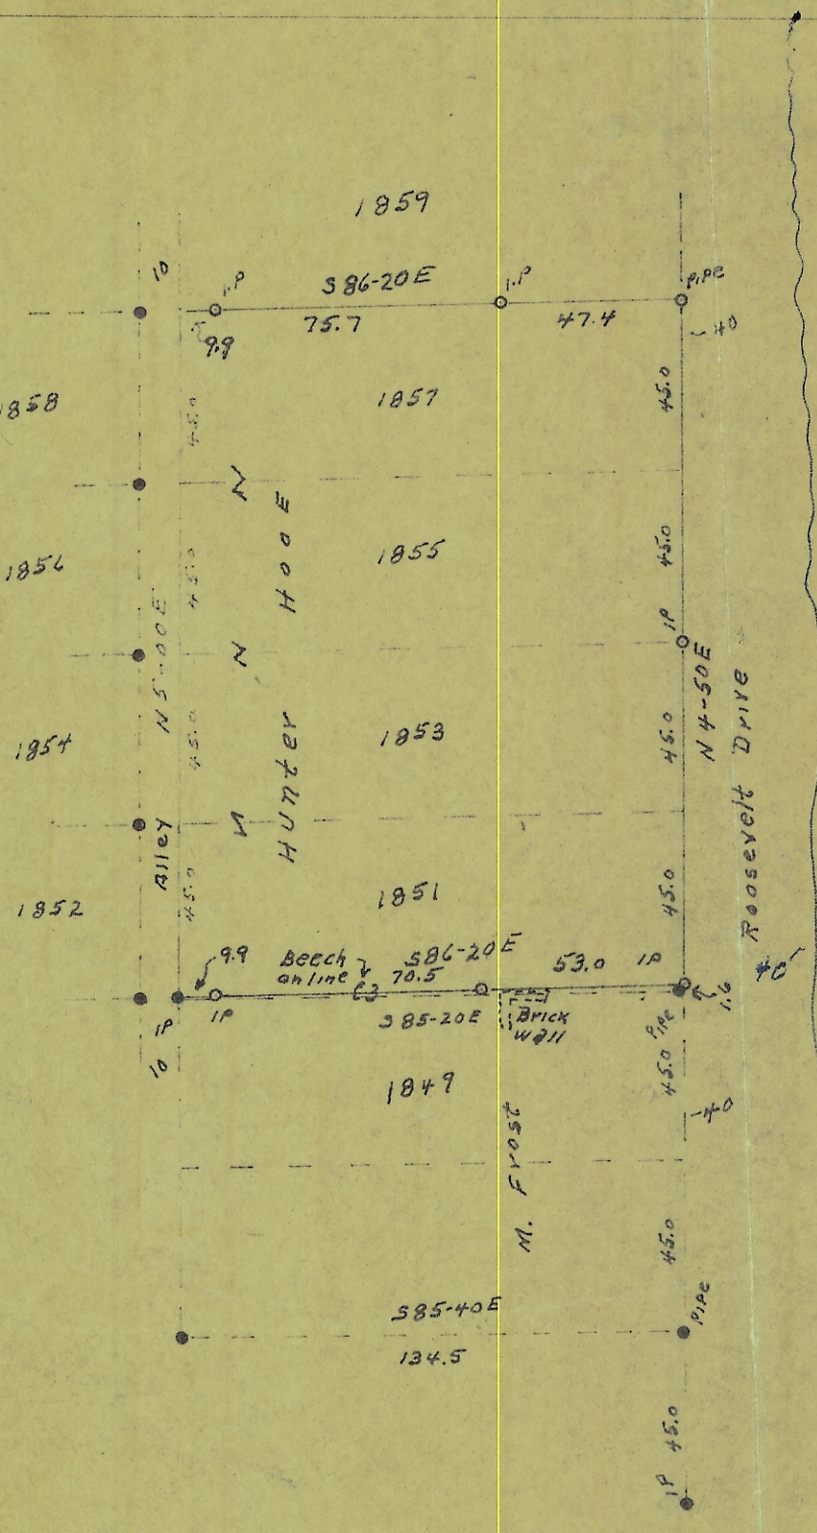

N

Scale 1" = 50'

PLAT of Survey

Lots 1851, 1853, 1855 & 1857
SYCAMORE HEIGHTS Add
to ATHENS OHIO

Surveyed for Hunter Hooe
4-9-58
By Joe L. Galvin
Reg. Sur. 1684

- iron pins found
- o iron pins set