


SITUATED IN THE STATE OF OHIO,
 COUNTY OF ATHENS, TOWNSHIP OF
 ATHENS, CITY OF ATHENS AND
 IN LOTS 90 & 91

- IRON PIN FOUND
- DRILL HOLE IN CONCRETE



I HEREBY CERTIFY THIS PLAT TO BE AN ACCURATE
 REPRESENTATION OF FIELD WORK PERFORMED BY
 ME IN JUNE, 1984

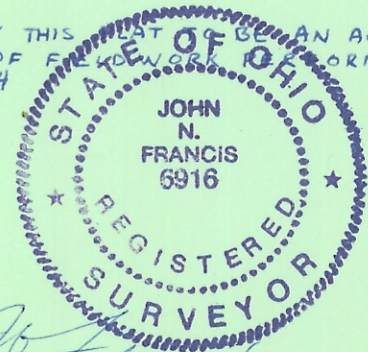

John N. Francis
 JOHN NICK FRANCIS
 REGISTERED SURVEYOR 5-6916

Description checked for
 Mathematical Accuracy
 ATHENS COUNTY
 ENGINEER'S OFFICE
 BY *Archibald Stealy Jr.*
 DATE: 11-14-84

N23

Sec. 24
 Athens Twp

lots 90 & 91