

Plat of Survey of 0.025 Acres
Situated in inclots 82 and 83
in the City of Athens
Surveyed September 2007 for:
Bart Kasler


Charles T. Newman
Charles T. Newman

Description Checked for
Mathematical Accuracy
Athens County
ENGINEER'S OFFICE
BY: *S. Blaus*
DATE: 10-3-07


- ⊙ = Iron Pin Found
- = Iron Pin Set

LINE TABLE		
LINE	LENGTH	BEARING
L1	10.00	N89°33'20"W
L2	6.00	N00°09'09"E

GRAPHIC SCALE

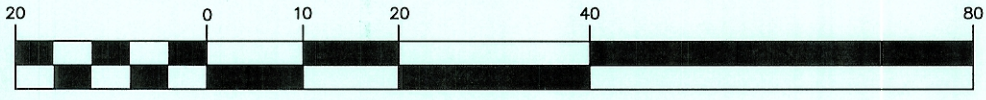

(IN FEET)
1 inch = 20 ft.

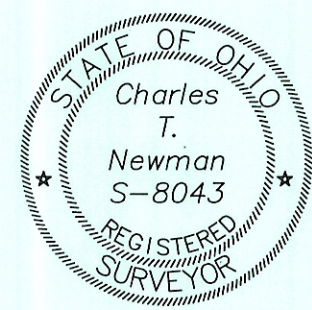

Member of Professional Land Surveyors of Ohio Land Surveys, Subdivisions

C. Tim Newman
C. TIM NEWMAN
Professional Surveyor

66 Elmwood Place Athens, Ohio 45701 740-594-1884
FAX 740-594-9413

