


LINE TABLE		
LINE	LENGTH	BEARING
L6	10.69	S73°47'42"E
L7	19.34	S15°35'42"W
L8	10.69	N73°47'42"W
L9	19.34	N15°35'42"E

- ▲ = P.K. Nail Set
- ⊙ = Iron Pin Found
- = Iron Pin Set


Plat of Survey of 0.005 Acres
 Situated in Inlots 27 and 28 In the City of Athens,
 Athens Township, Athens County, Ohio
 Surveyed March 2012 for:
 Lamborn Studios

Charles T. Newman
 Charles T. Newman

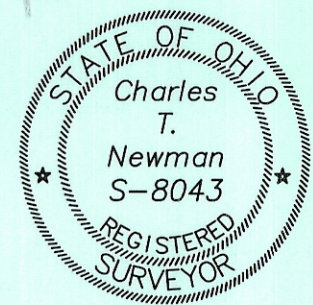

Member of Professional Land Surveyors of Ohio Land Surveys, Subdivisions

Description Checked for
 Mathematical Accuracy
 Athens County
 ENGINEER'S OFFICE
 BY: *S. Blause*
 DATE: *4-4-12*


C. TIM NEWMAN
 Professional Surveyor

66 Elmwood Place Athens, Ohio 45701 740-594-1884
 FAX 740-594-9413

