D-24

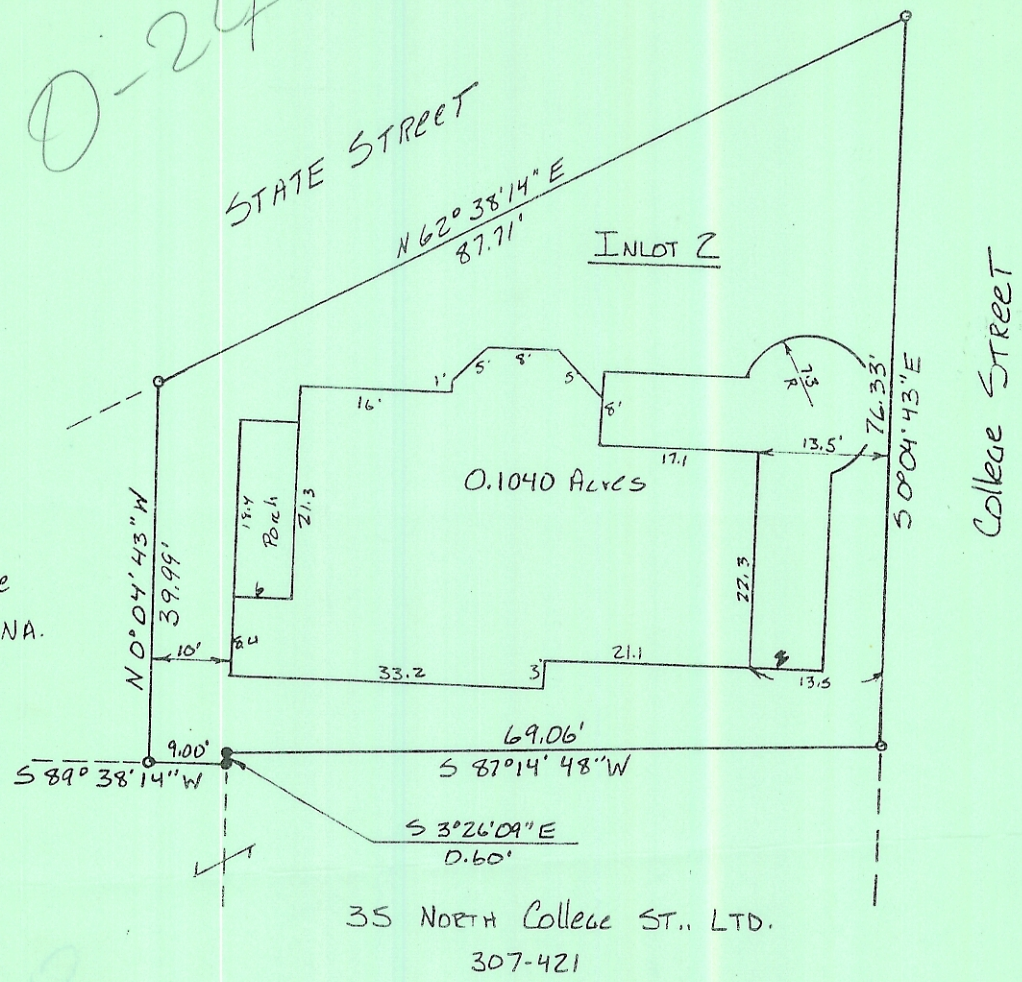

○ IRON PIN SET

● IRON PIN FOUND

PLAT OF SURVEY
0.1040 ACRES

LOCATED IN INLOT NO. 2, CITY OF ATHENS,
ATHENS TOWNSHIP, ATHENS COUNTY OHIO

SCALE 1" = 20" May, 1987

FOR PAUL CALLIHAN

PREPARED BY

EVANS, MECHWART, HAMBLETON & TILTON, INC.
CONSULTING ENGINEERS AND SURVEYORS
GAHANNA, OHIO ATHENS, OHIO

Gregory K. Wright
Registered Surveyor #6535

STATE OF OHIO
GREGORY K. WRIGHT
S-6535
REGISTERED SURVEYOR

AO-17D2