


ATHENS  
 12.27  
 B.27  
 12.27

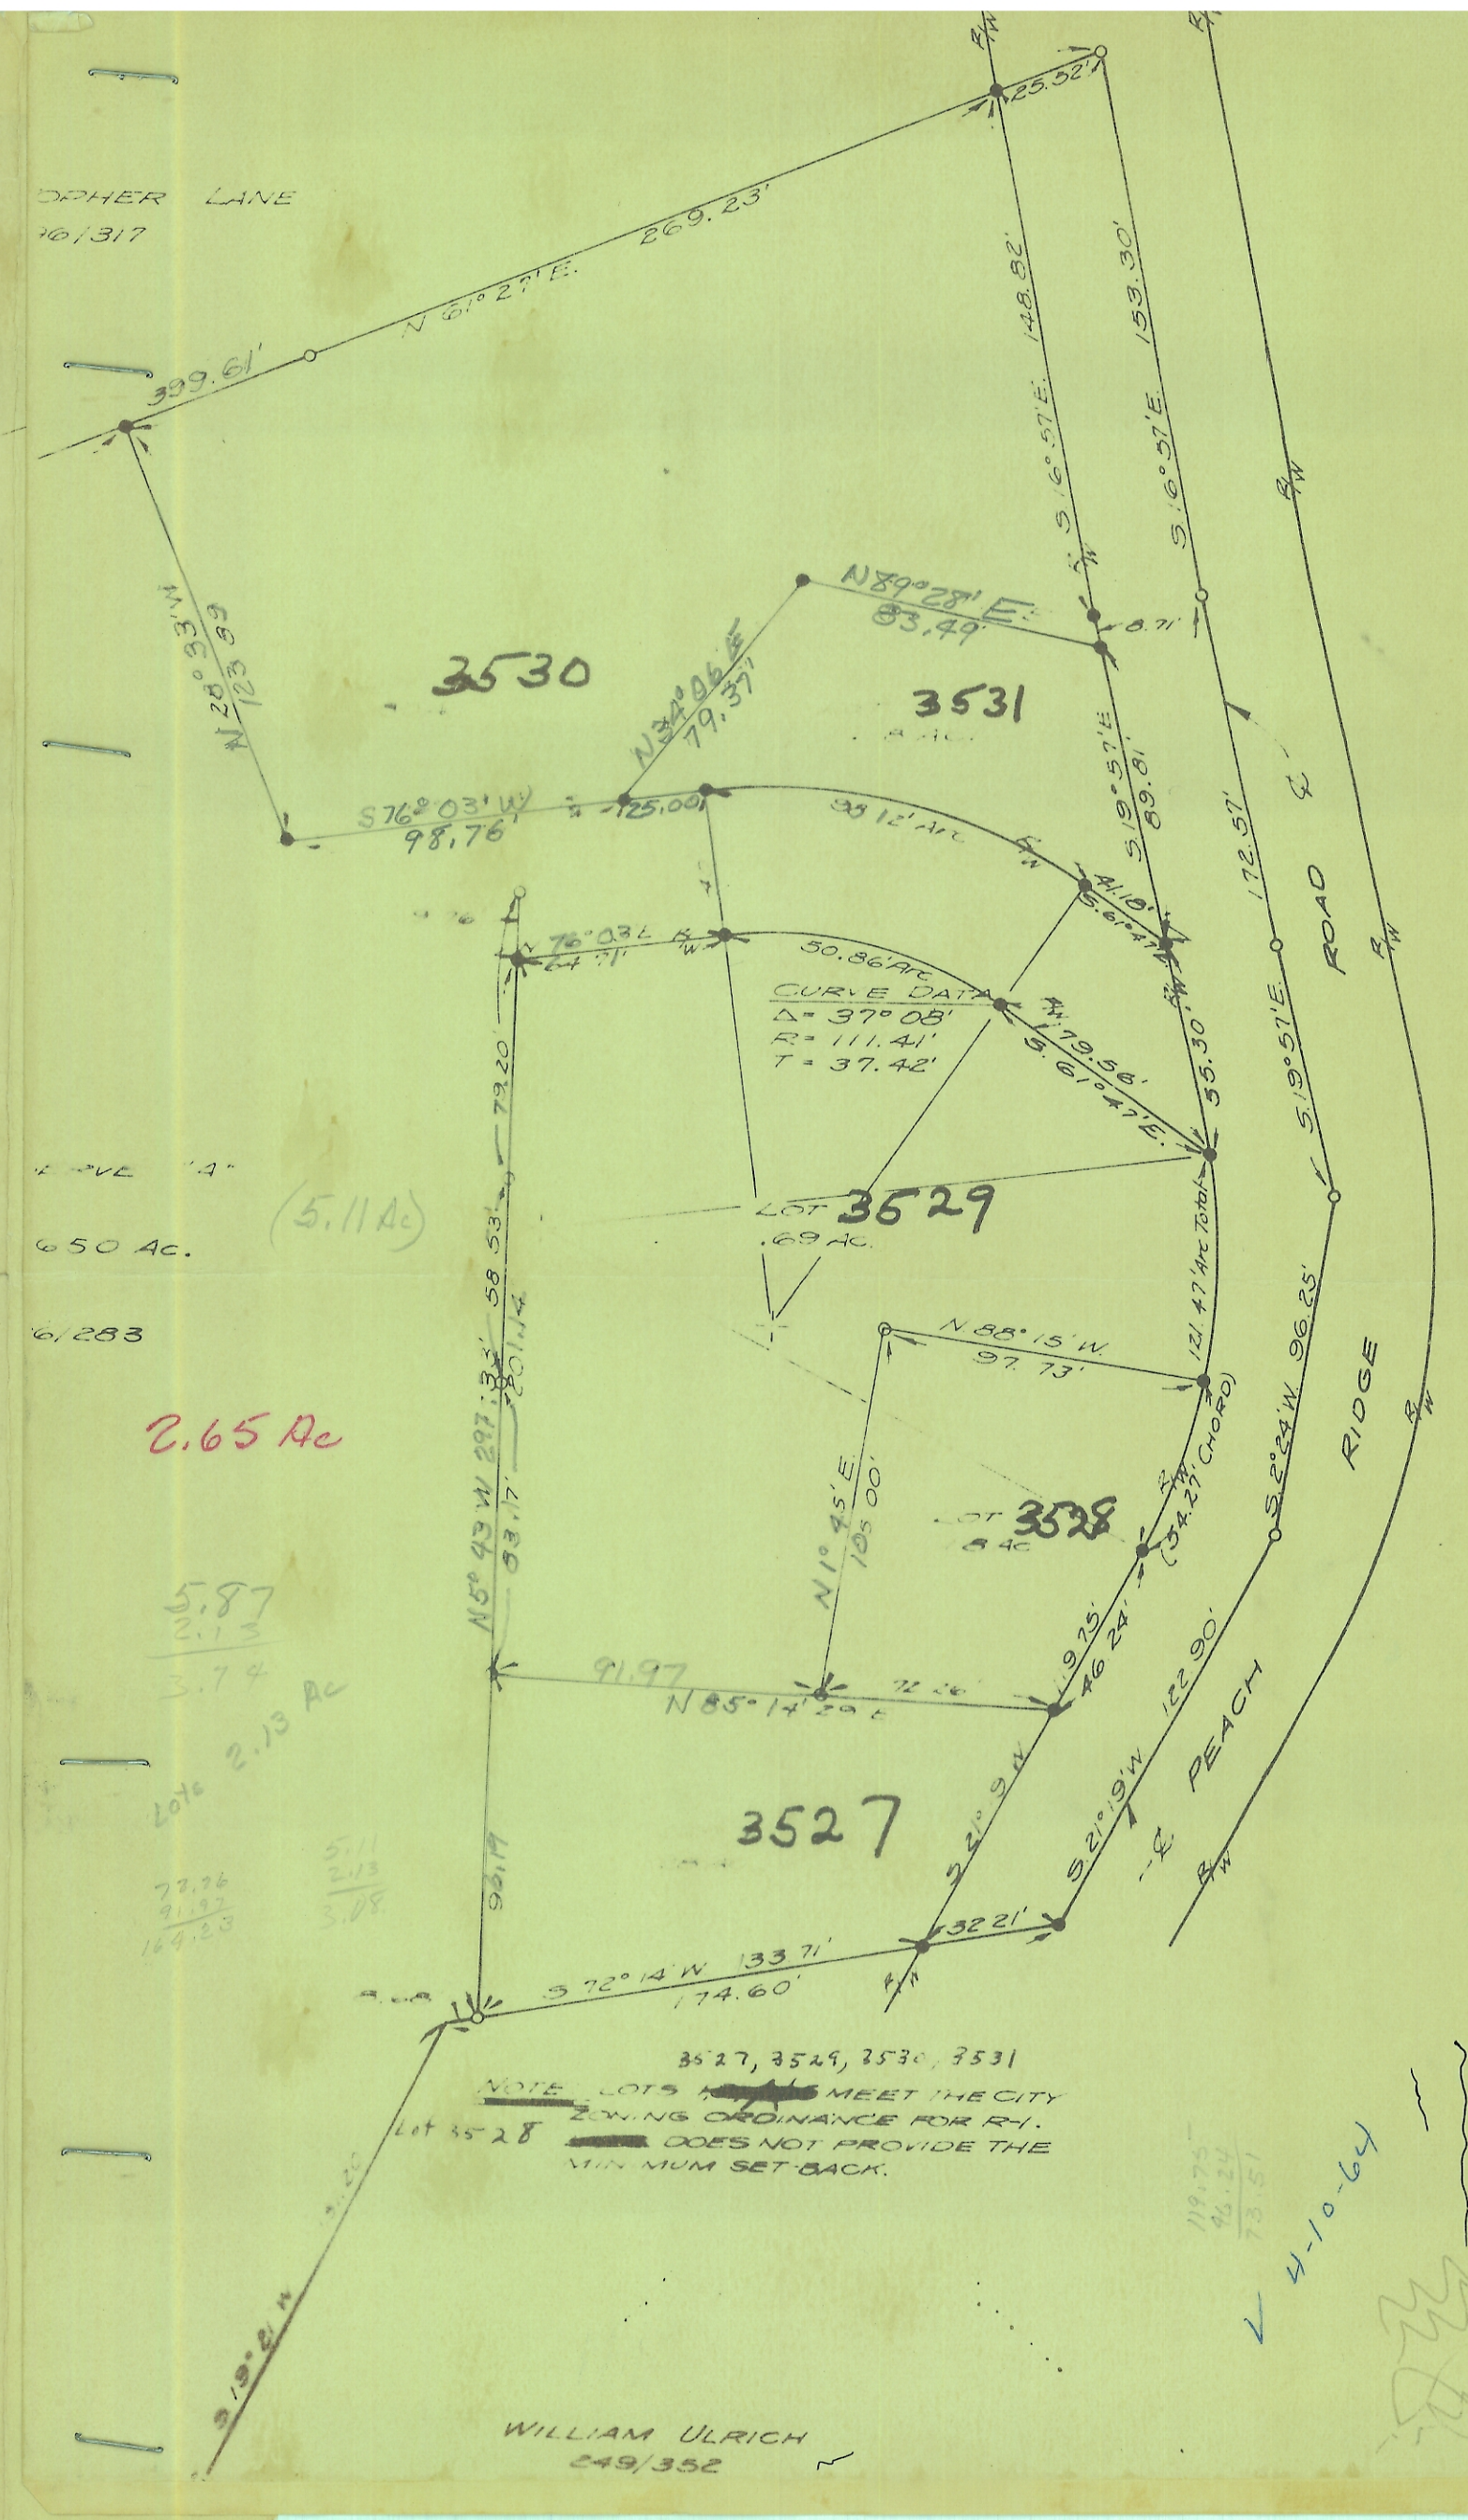

6/283  
 650 AC.

2.65 Ac

5.87  
 2.13  
 3.74

5.11  
 2.13  
 3.08

77.76  
 91.92  
 169.23

FRANK L. WOODWORTH  
 Approved: Athens City Planning Commission  
 By William H. Herbert  
 William H. Herbert,  
 Chairman

Accepted and Approved by Athens City Council  
 By Ordinance No. 64-1/64  
Harry H. ...  
 President of Council

6.47  
 66  
 3882  
 3882  
 927.02

WILLIAM ULRICH  
 249/352

119.75  
 46.24  
 73.51  
 4-10-64