

SHAFER STREET

W.S. BLACKWOOD'S
SUBDIVISION

2200 PB 5 Pg 105

GRATIA BEATRICE PRATT
158/393

2301

2302

WALTON E & ADRIENNE W DAINES
180/2 494

NETA STAUFFER SPAULDING,
ET AL
299/485

2 STY FR DWELL

2 STY FR DWELL

N 07° 58' 50" E ~ 125.00'

AREA = 4,655.75 S.F.
0.1068 AC.

JOHN A & JANE
ZARTMAN WOODROW
315/475


N 07° 58' 50" E ~ 100.20'

MARY E. JOHNSON FRANTZ
295/477

Athens Twp. Sec 16
Athens City

N-19

16 98 0.1068 AC

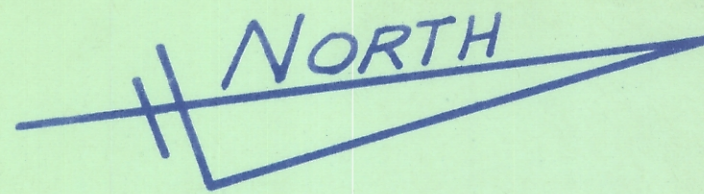

SCALE: 1" = 20'

WEST STATE STREET

MILLER AVENUE

W.S. BLACKWOOD'S
ADDITION PB 4
Pg 56

TO ALL PERSONS INTERESTED TO THE TITLE TO THE PREMISES SHOWN ON THIS PLAT OF SURVEY:

I hereby certify that I personally made an actual survey of the premises shown on this plat of survey on the 26th day of FEB., 1975; that this plat of survey is a correct representation of the premises as determined by said survey. I further certify that there are no encroachments, either way across any boundary line of the premises except as shown hereon.

FRIEDL & HARRIS, INC.

Date: 2/26/75

Gerald R. Bayha, P.E.
REGISTERED SURVEYOR #6139



For:

Mr. John Woodrow
204 West State Street
Athens, Ohio 45701

FRIEDL & HARRIS, INC.
LAND DESIGN CO-ORDINATORS

ATHENS, OHIO COLUMBUS, OHIO NORTH CANTON, OHIO
(614-592-2777)

PLAT OF SURVEY

Of the Northerly Portion of In-Lot No. 494 of the H.T. Brown Addition - A Subdivision of Original Out-Lot No. 161 in Section 16, Town 9 N., Range 14 W., City of Athens, Athens Township, Athens County, Ohio

DRAWN	CHECKED	REVISIONS	DATE	PROJ. NO.
LBF	GB.		25 Feb/75	6016

1
1
SHEET NO.