


# SOUTHEASTERN LAND SURVEYS

LEONARD F. SWOYER  
REGISTERED PROFESSIONAL LAND SURVEYOR

3428 Pleasant Hill Road  
Athens, Ohio 45701  
614/593-8701

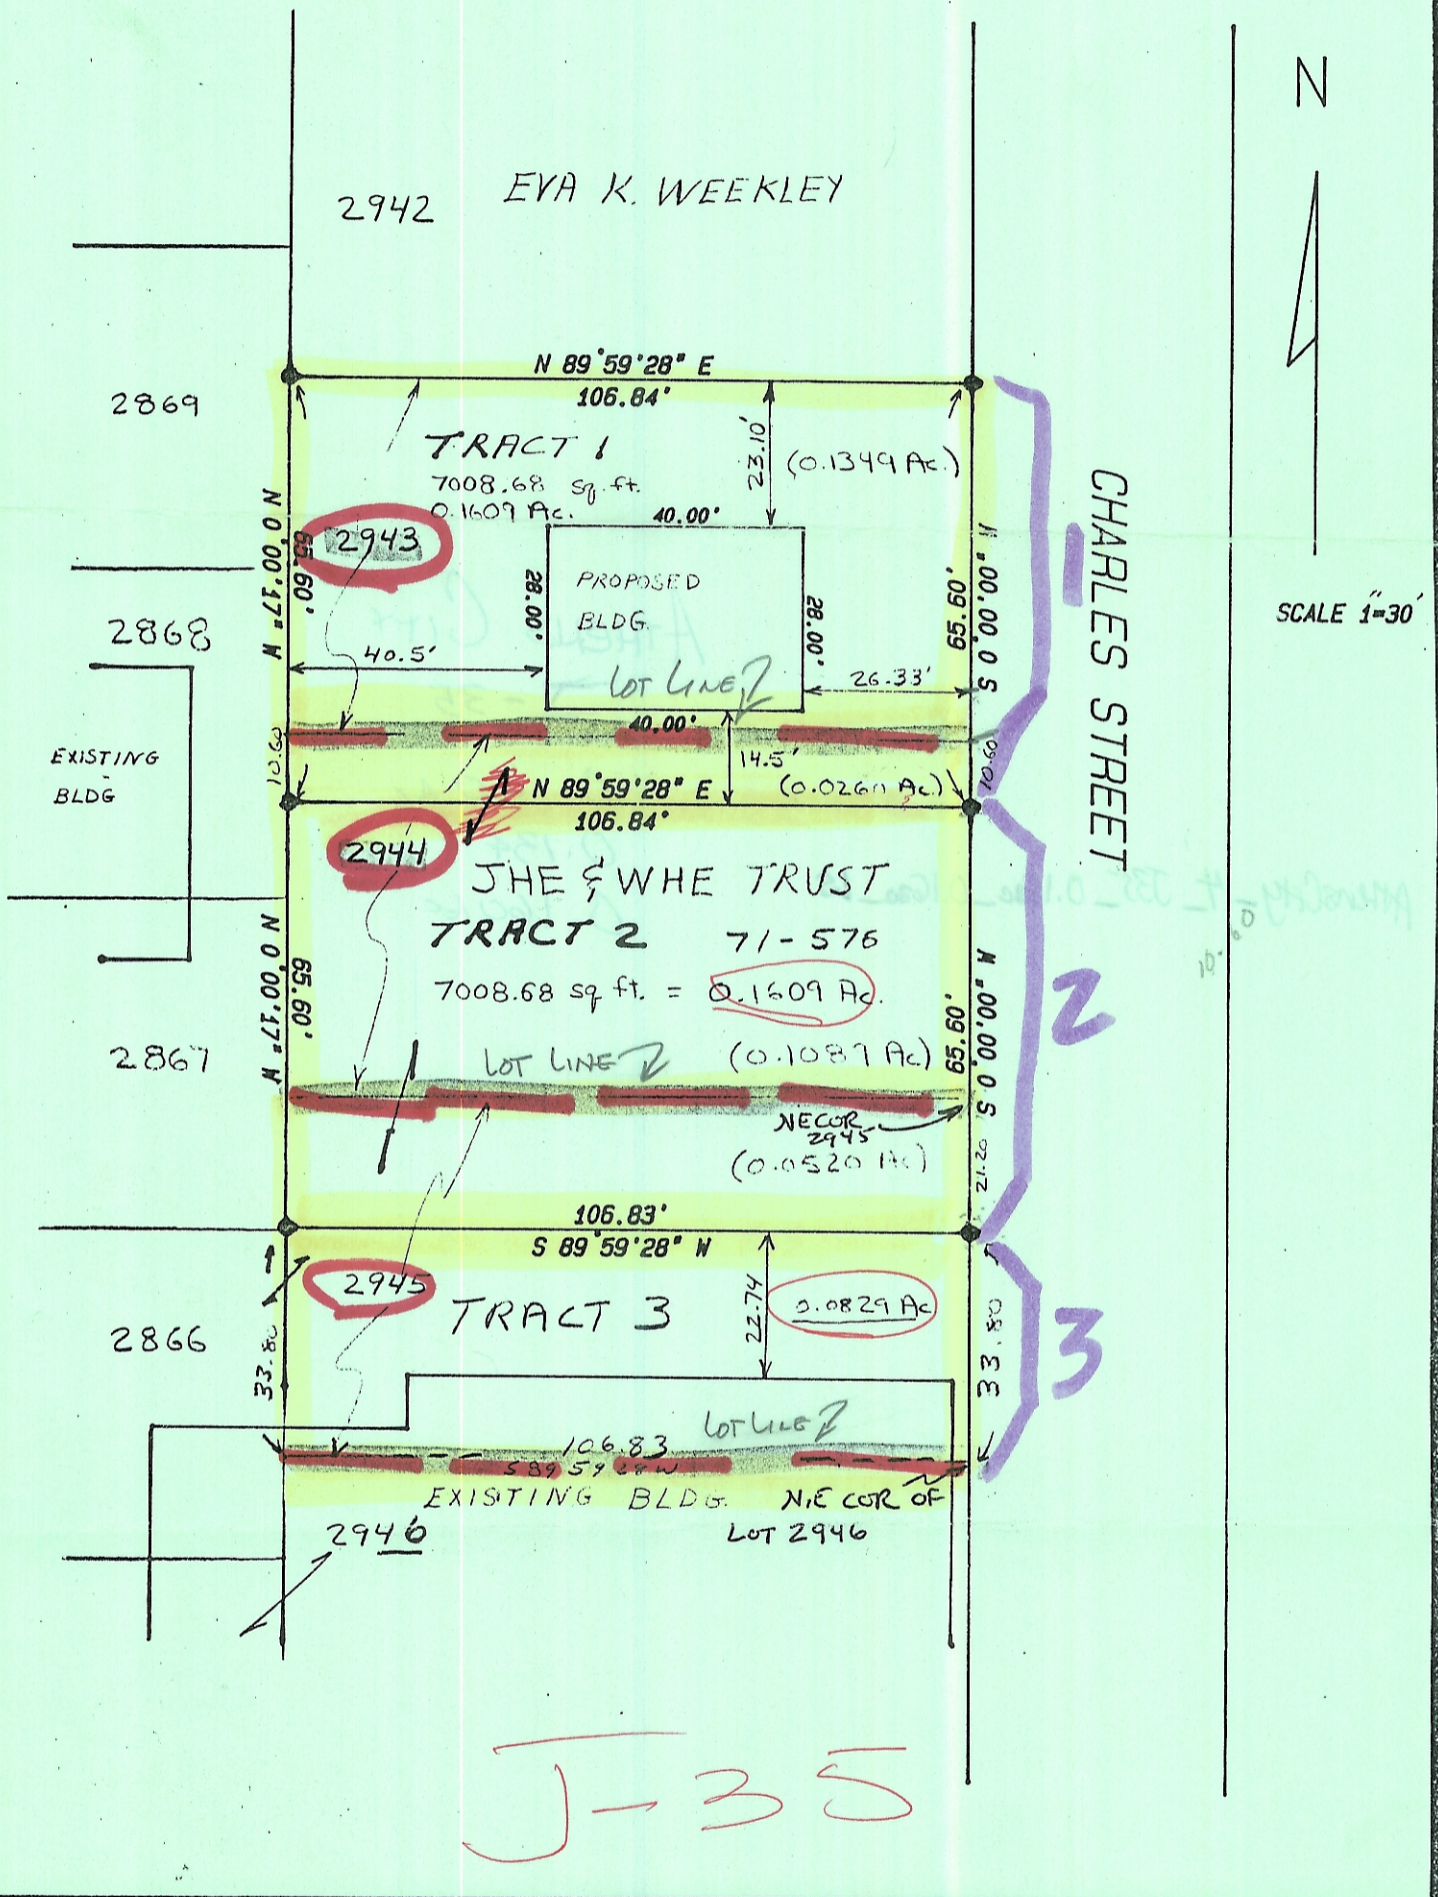

Plat of Two Tracts 0.16 acres each Scale 1"= 30'

Surveyed for John Edwards Date August 27, 1991

Subdivision Kennedy's Subdivision part of Lots 2943, 2944, 2945

Township Athens Section ----- Town --- Range ---

Corporation Athens County Athens State Ohio

Leonard F. Swoyer Jr. Revised 9/3/91

Leonard F. Swoyer Jr. Reg. Prof. Land Surveyor No. 6765 to include tract 3