


SOUTHEASTERN LAND SURVEYS

LEONARD F. SWOYER
REGISTERED PROFESSIONAL LAND SURVEYOR

3428 Pleasant Hill Road
Athens, Ohio 45701
614/593-8701

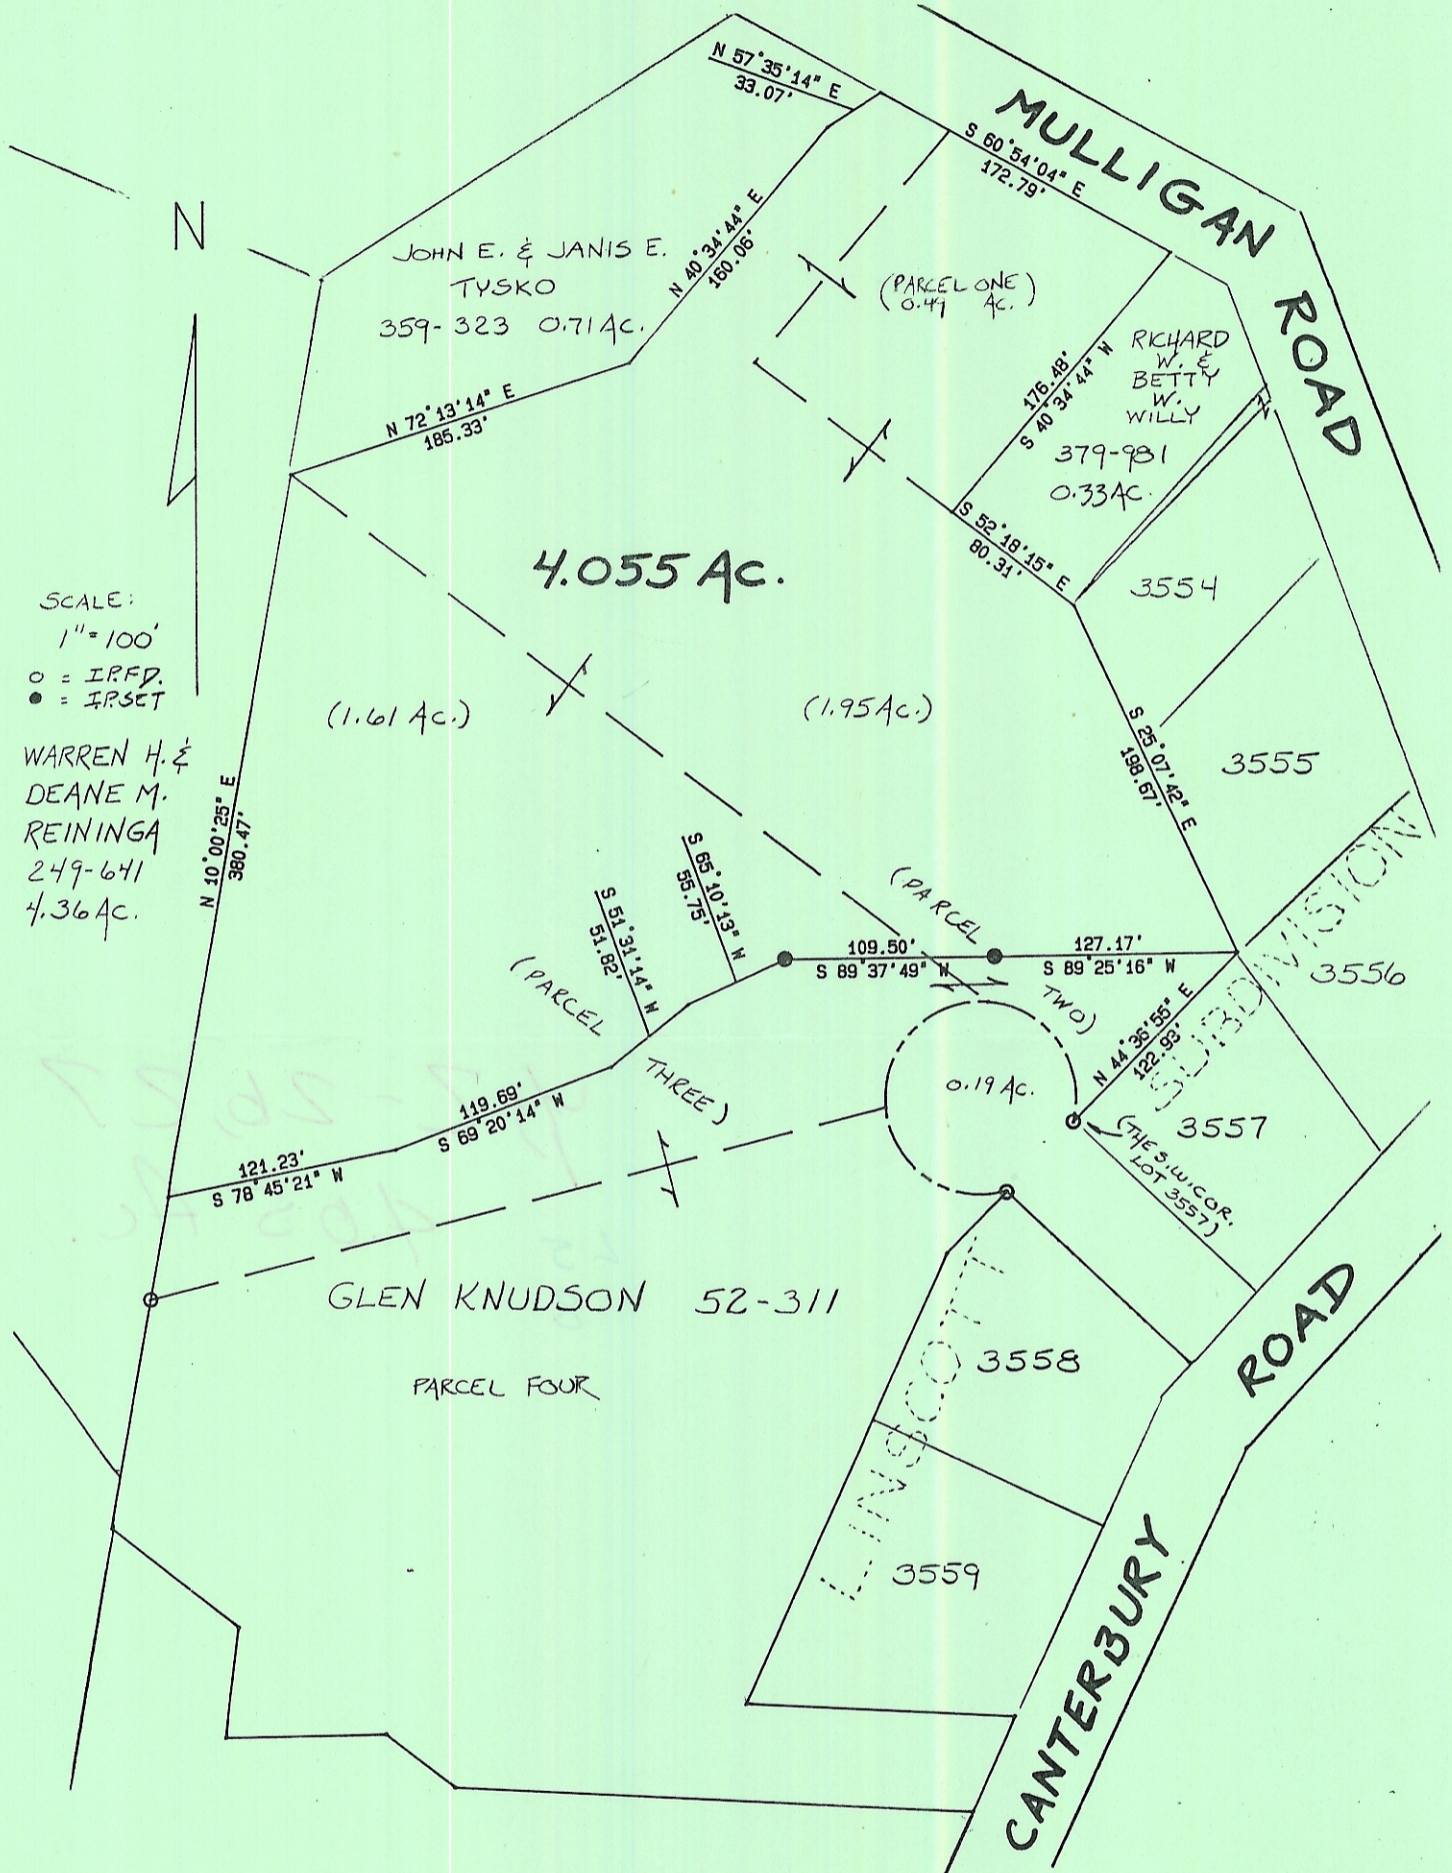

Plat of Survey of a 4.055 Acre Tract Scale 1" = 100'
 Surveyed for Glen Knudson Date 6/23/92
 Subdivision Lease Lot 40
 Township Athens Section 8 Town 9 Range 14
 Corporation Athens City County Athens State Ohio

1-26, 27
2-26, 27

Leonard F. Swoyer Jr.
 Leonard F. Swoyer Jr. Reg. Prof. Land Surveyor No. 6765