


SOUTHEASTERN LAND SURVEYS

LEONARD F. SWOYER
REGISTERED PROFESSIONAL LAND SURVEYOR

3428 Pleasant Hill Road
Athens, Ohio 45701
614/593-8701

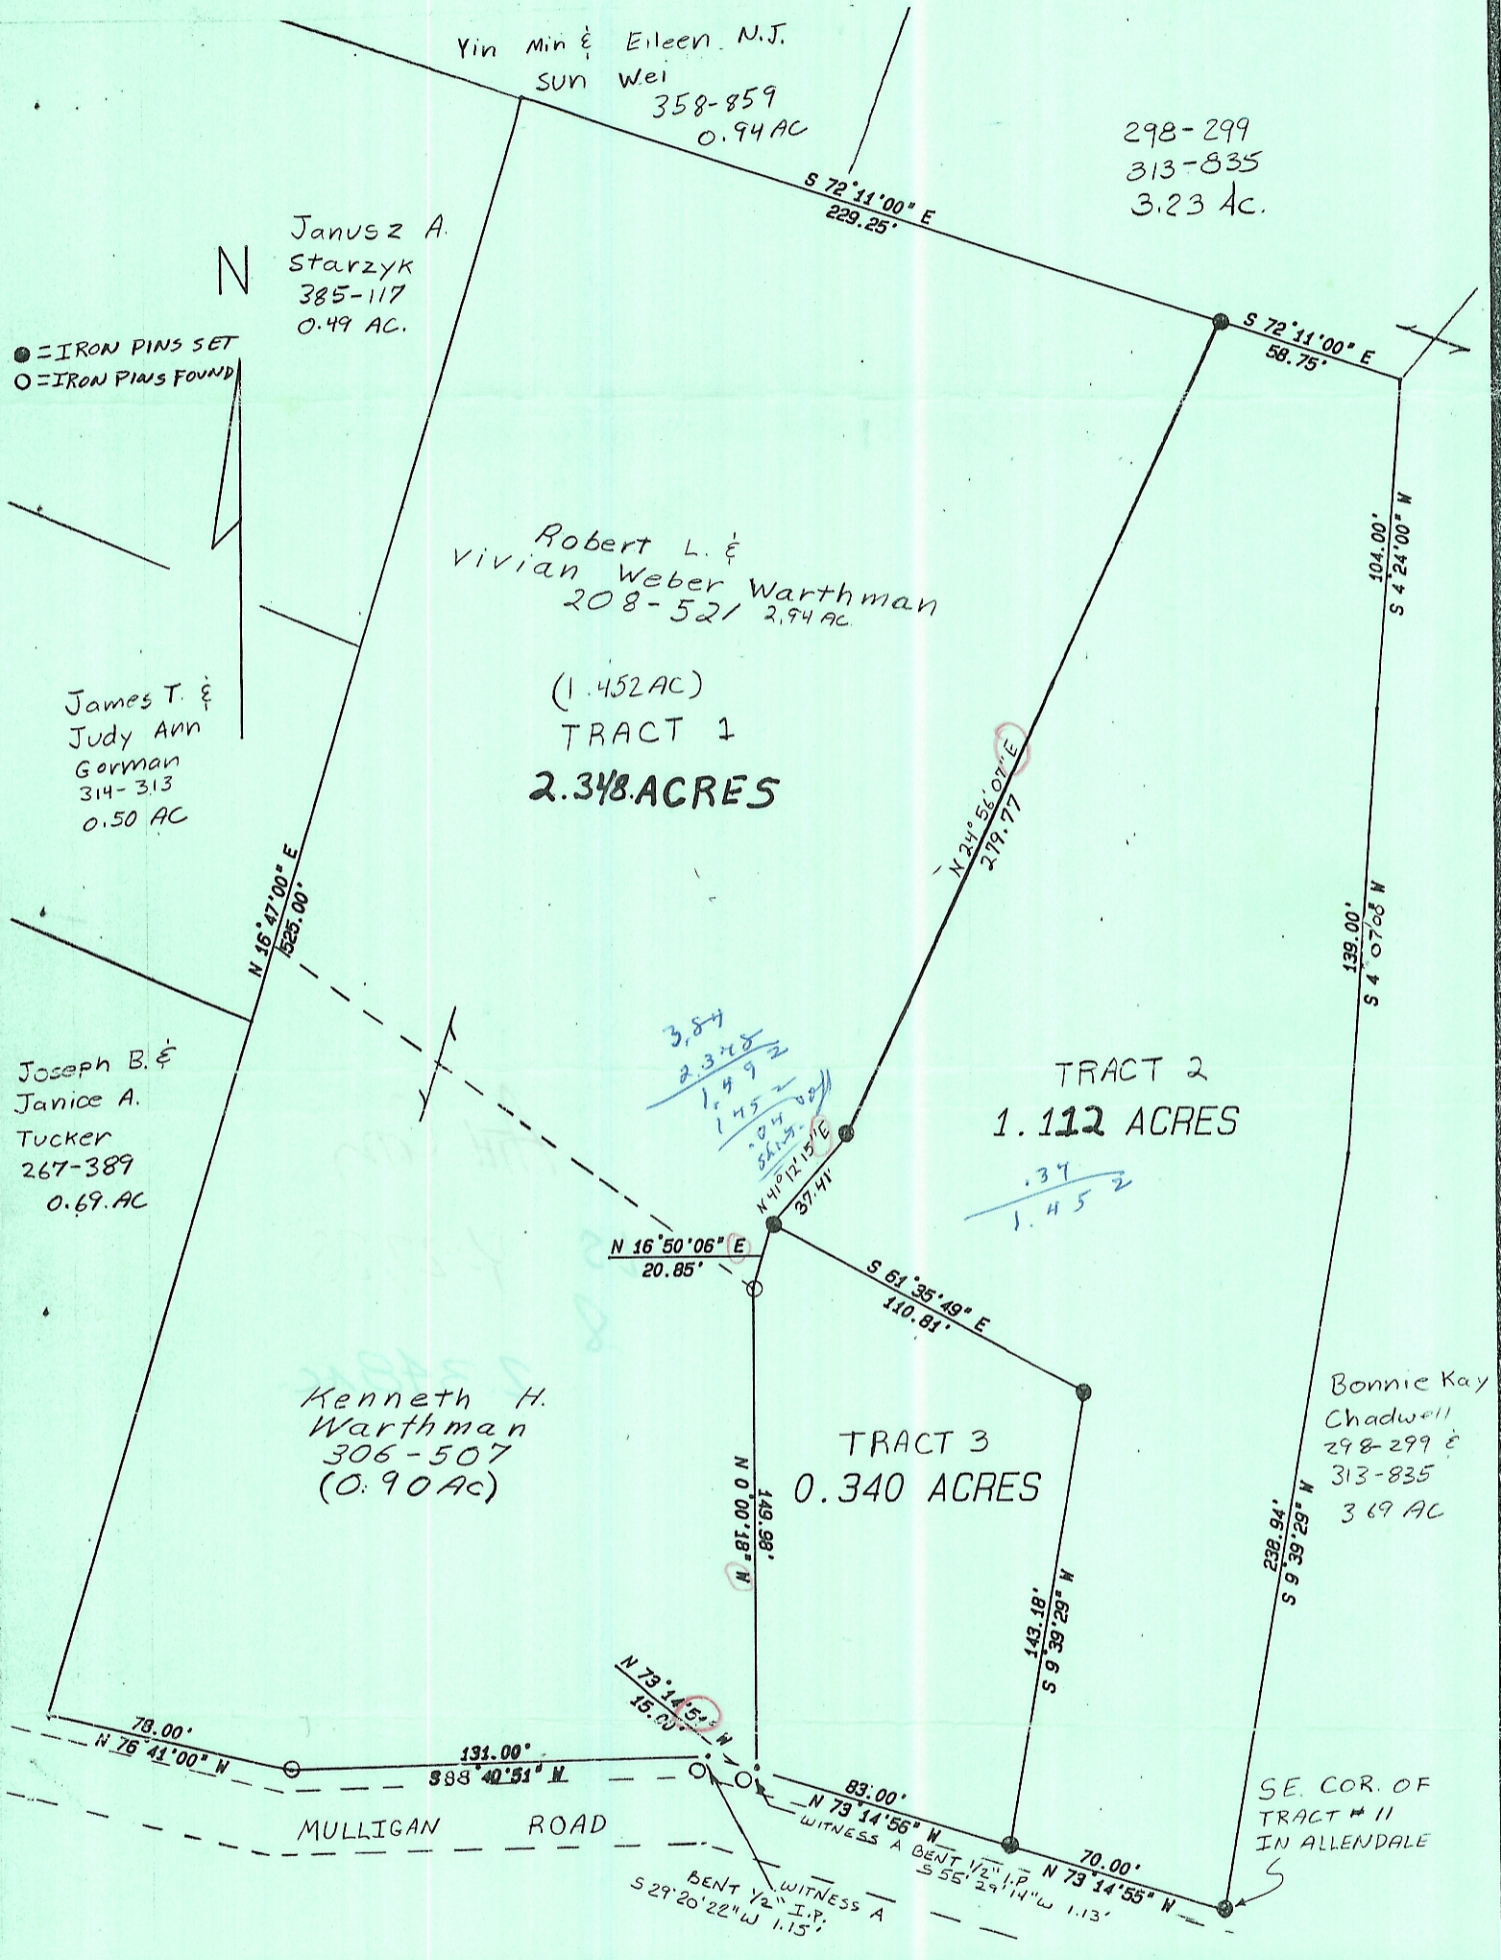

Plat of Tracts 1-3 inclusive Scale 1" = 60
 Surveyed for Vivian Warthman Date 7/29/93
 Subdivision Tract #11 Allens Bungalow Addition
 Township Athens Section 8 Town 9 Range 14
 Corporation Athens County Athens State Ohio

Leonard F. Swoyer Jr.
 Leonard F. Swoyer Jr. Reg. Prof. Land Surveyor No. 6765