...-175-P-574 & Vol-195-P-440

...EY OF .35128 ACRE TRACT SOLD
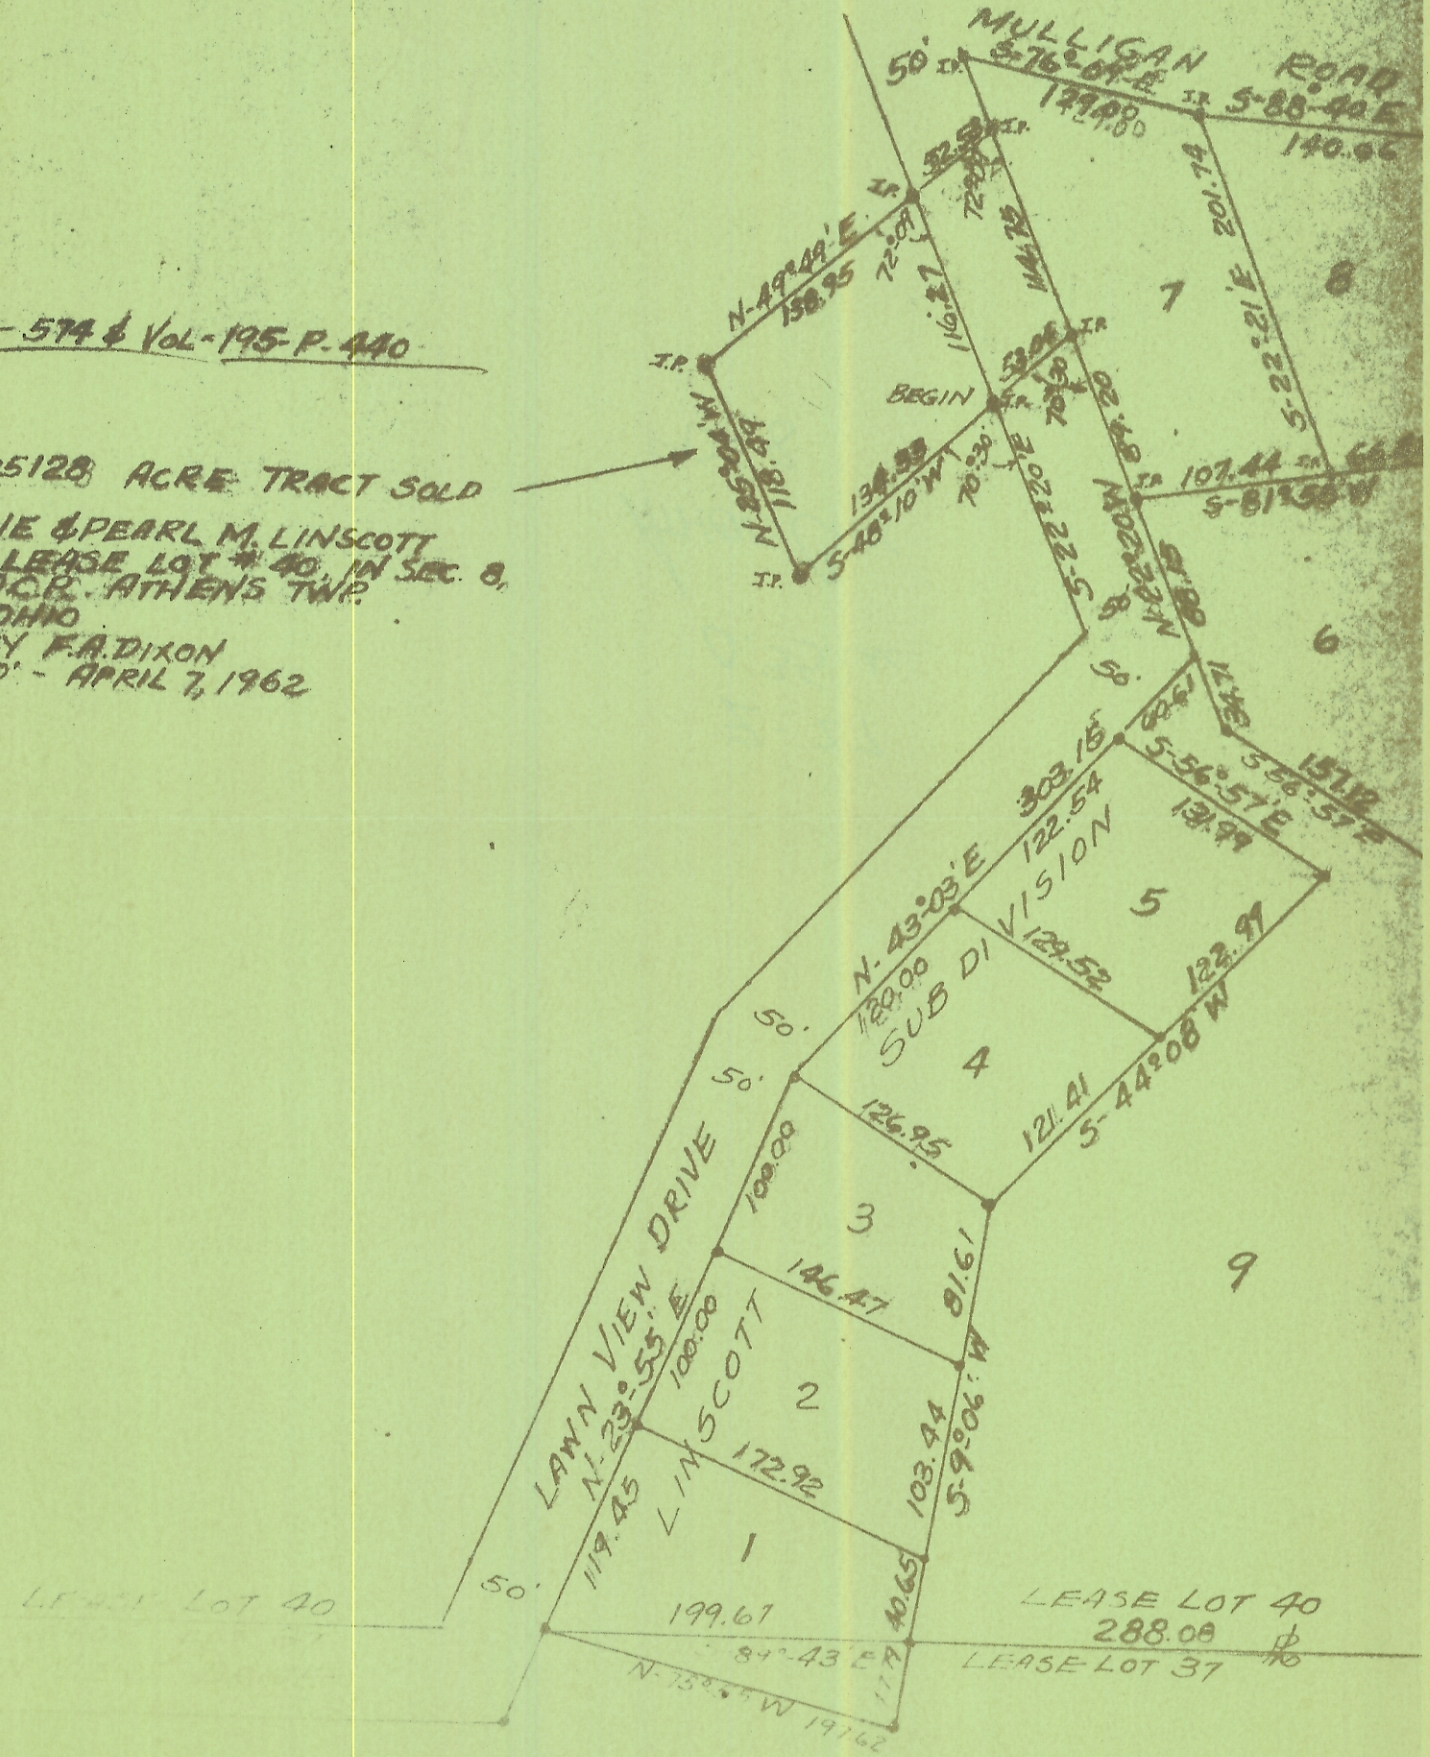
...ER LANE & PEARL M. LINSCOTT
...ED IN LEASE LOT # 40 IN SEC. 8,
...R-14 O.C.R. ATHENS TWP.
...NS CO., OHIO
...YED BY F.A. DIXON
... 1" = 100' - APRIL 7, 1962