


Scale 1/8" = 1'-0"

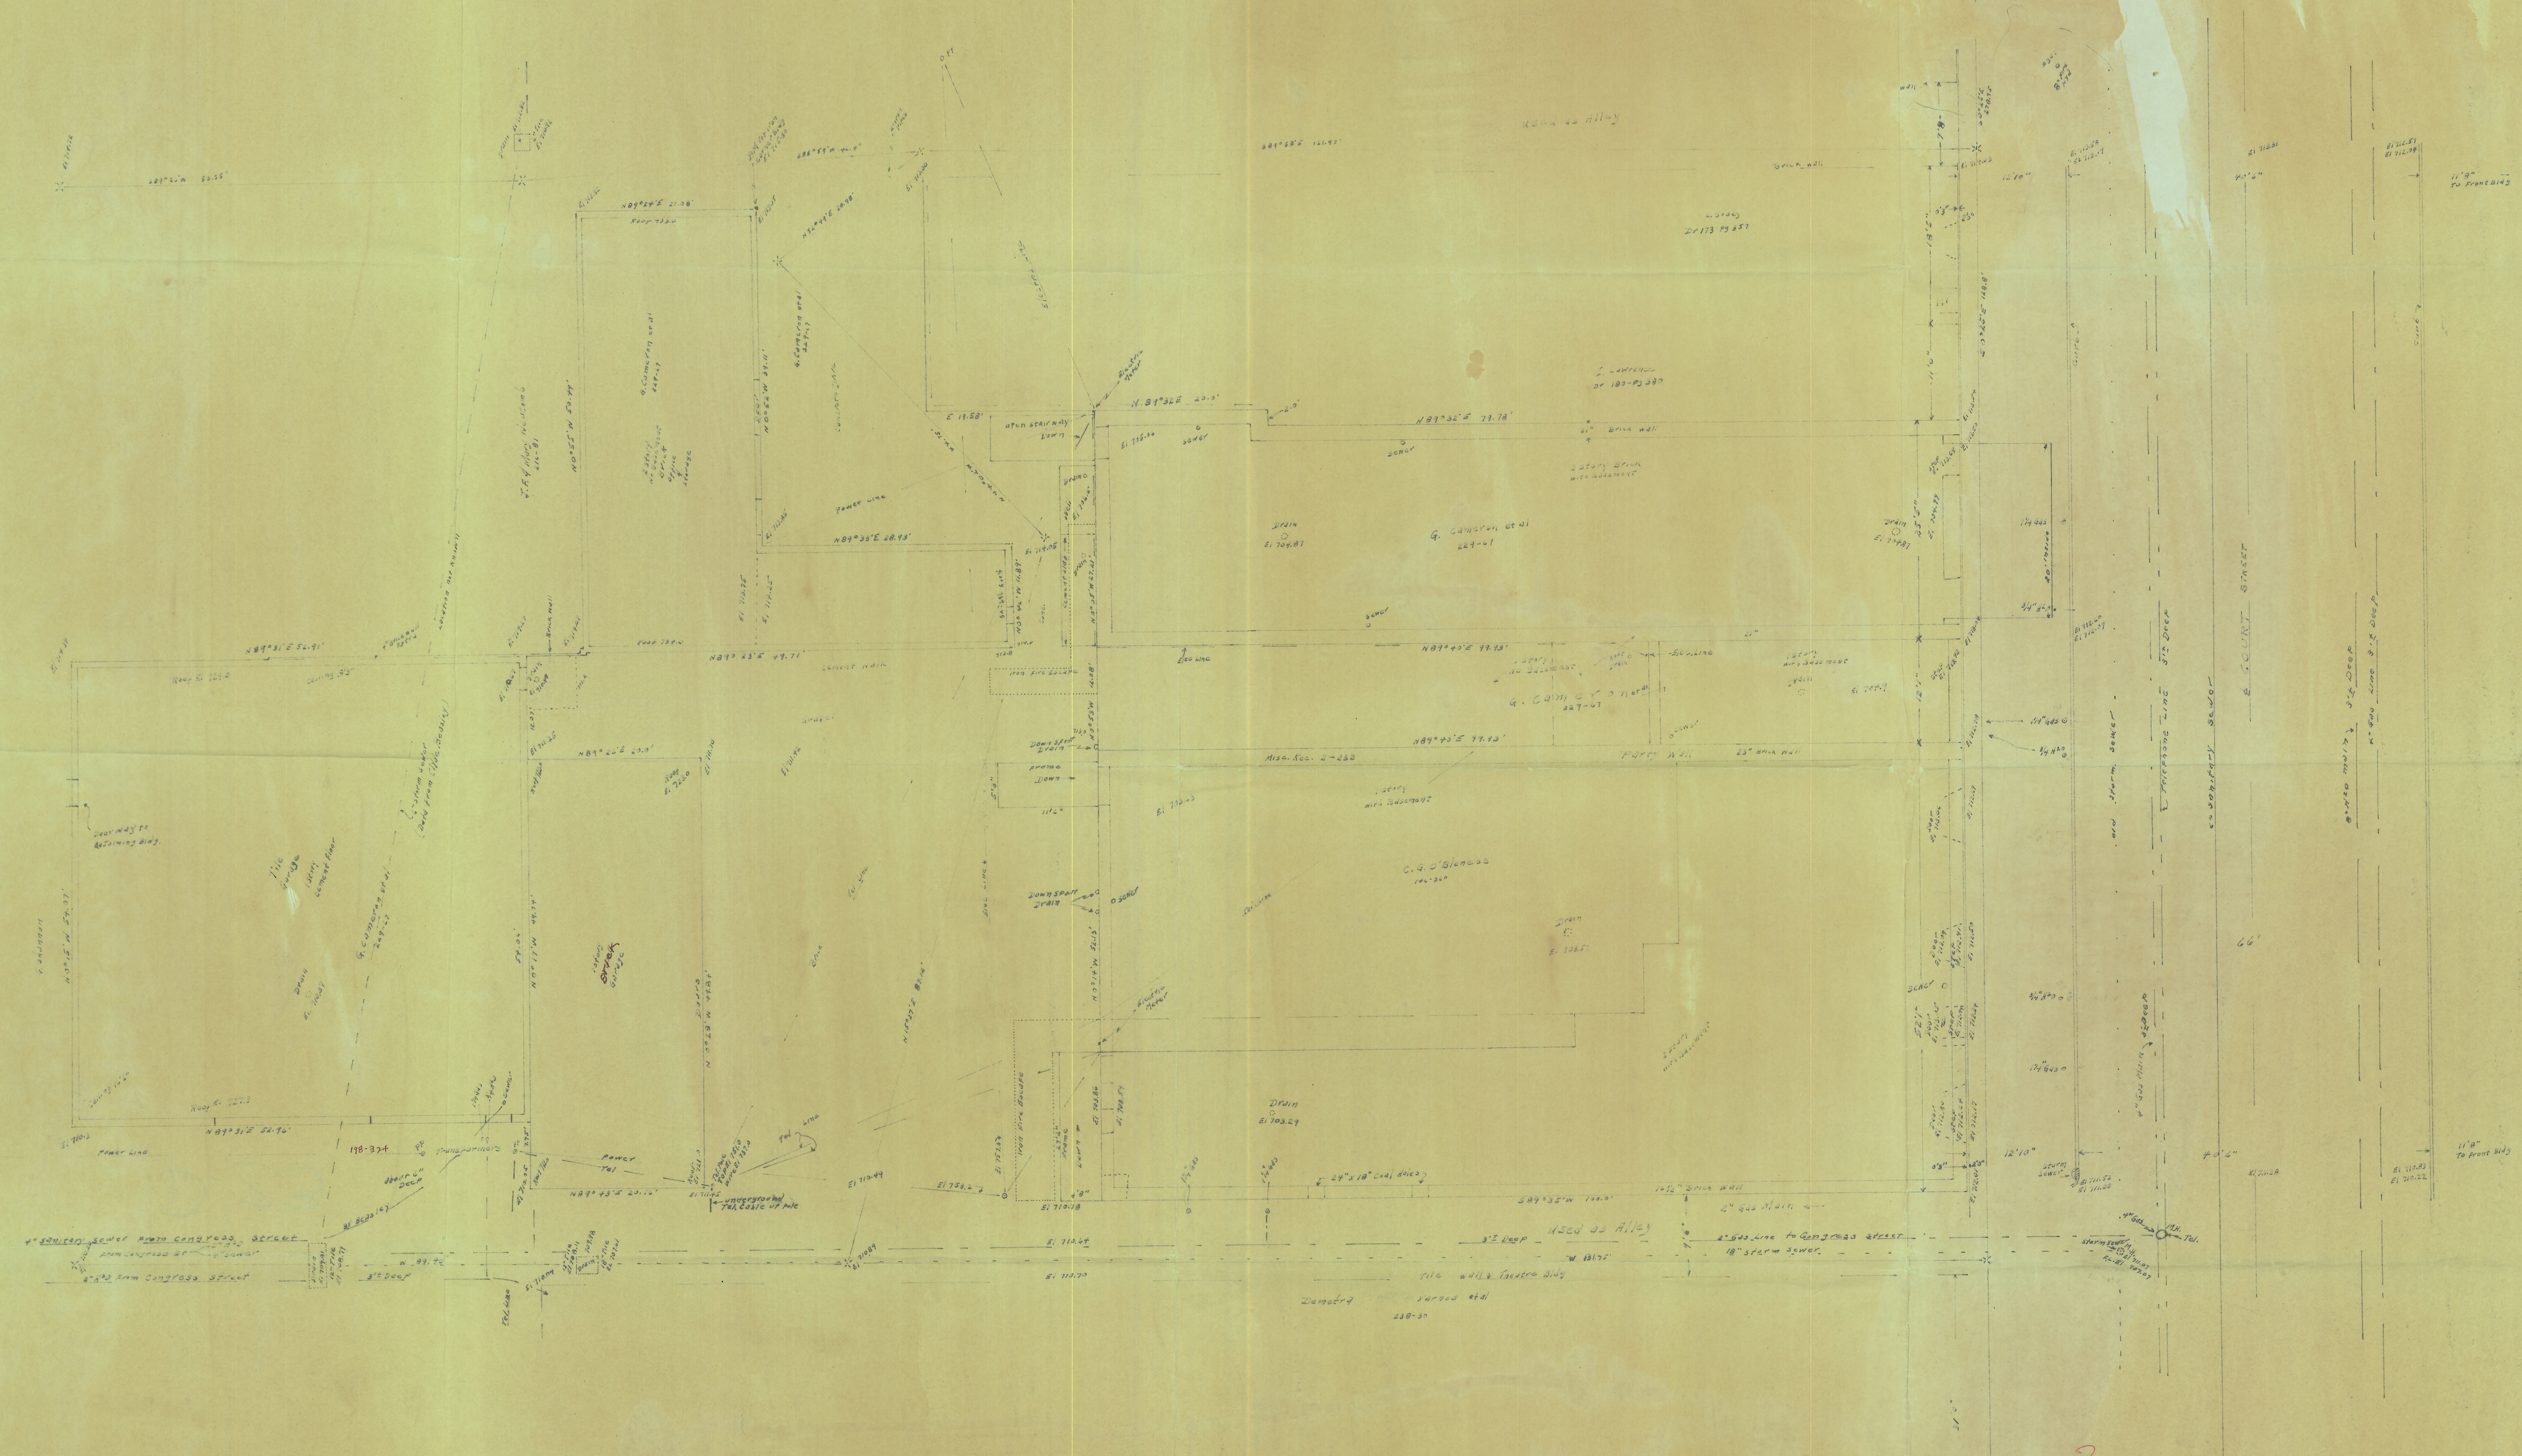

P23
 76
 9
 11/15/51


Court Report