


# SOUTHEASTERN LAND SURVEYS

LEONARD F. SWOYER  
REGISTERED PROFESSIONAL LAND SURVEYOR

3428 Pleasant Hill Road  
Athens, Ohio 45701  
614/593-8701

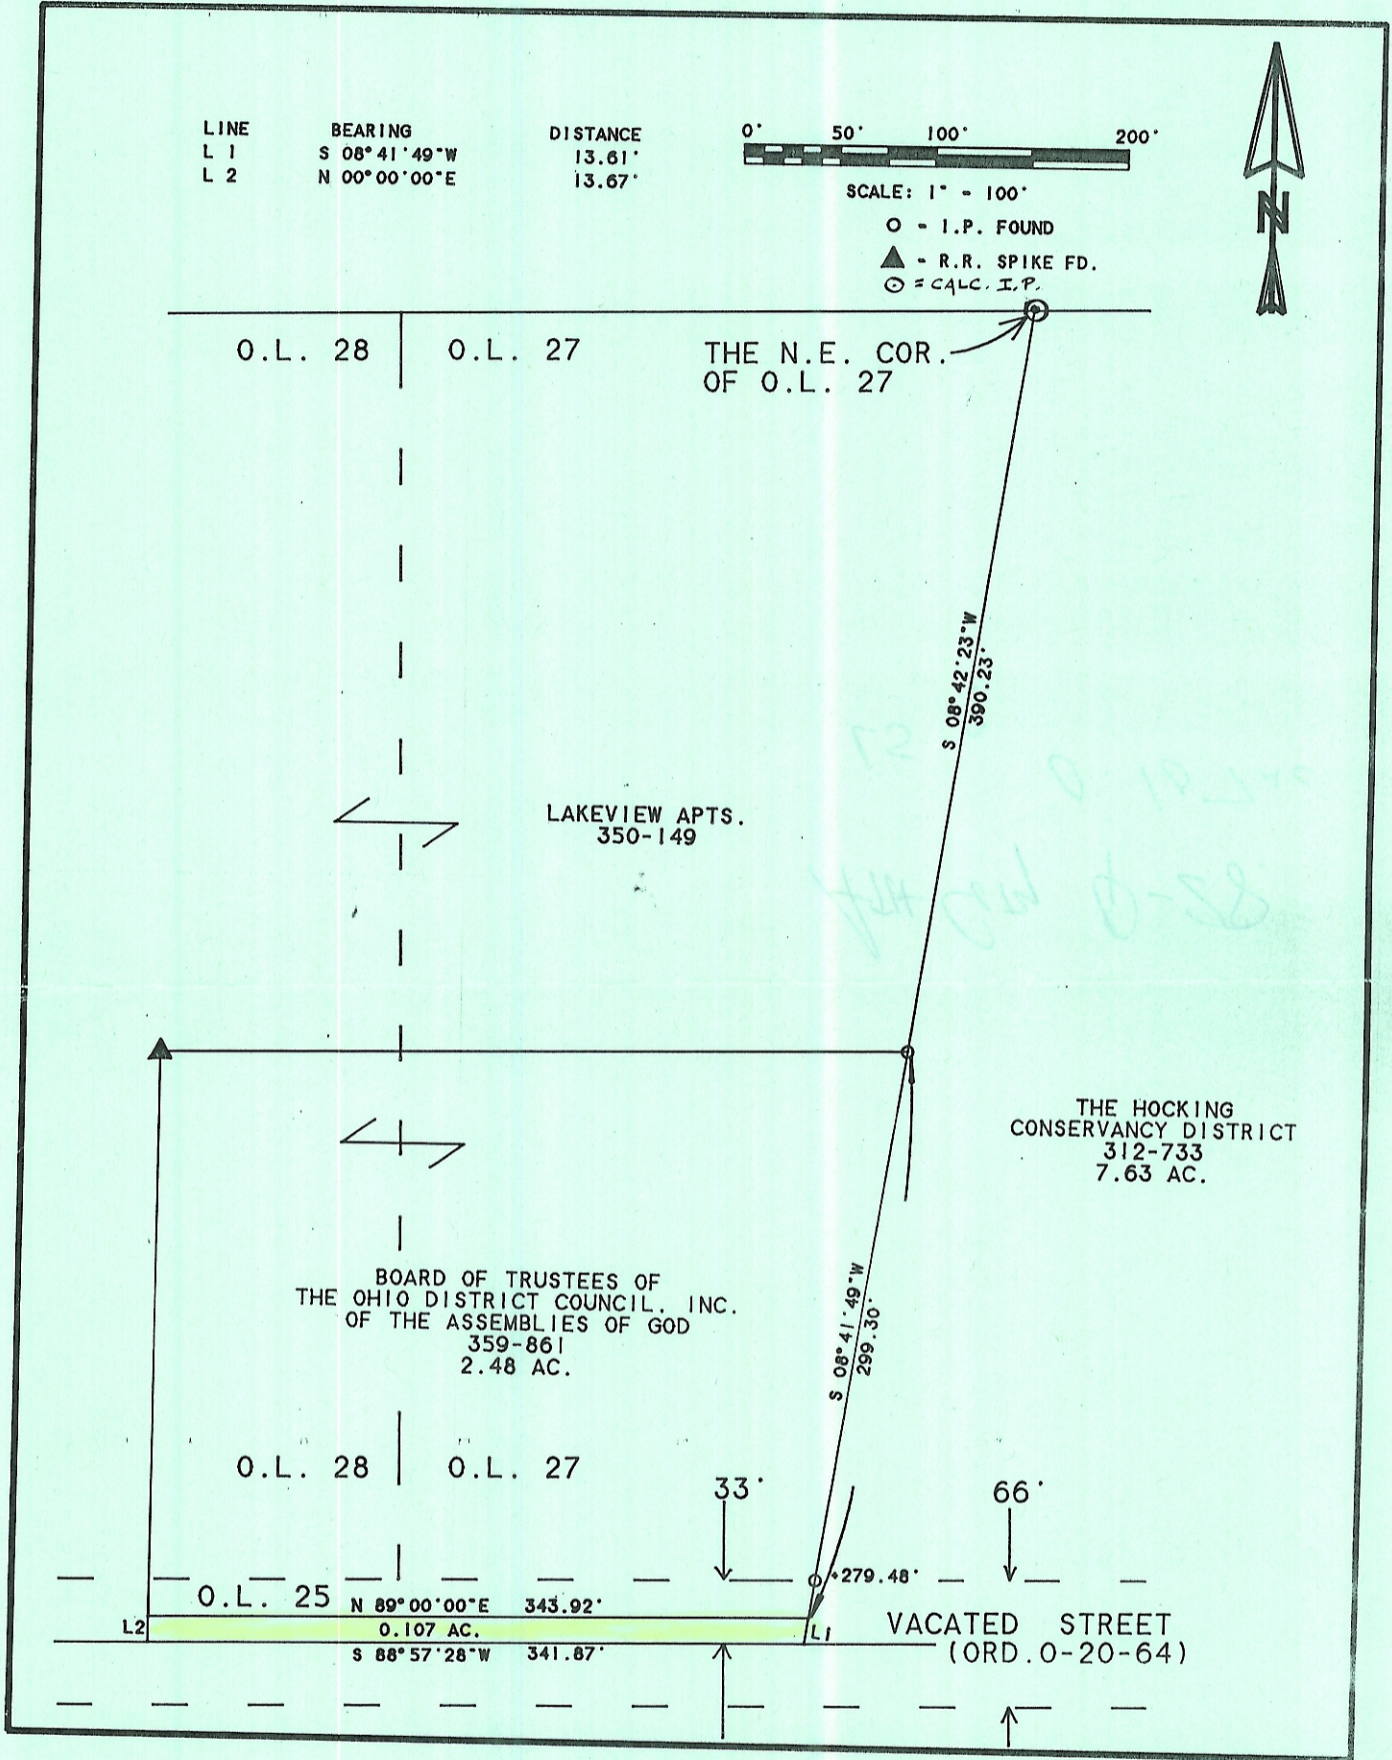

Plat of A 0.107 ACRE TRACT Scale 1" = 100'

Surveyed for Trustees, Ohio Dist., A.O.G., INCORP. Date 12/19/94

Subdivision O.L. 25

Township Athens Section 9 Town 9 Range 14

Corporation Athens City County Athens State Oh.

Leonard F. Swoyer Jr. Reg. Prof. Land Surveyor No. 6765