Sec 8
Athens City
FL40
W-24
JG 9

PLAT
of a part of C.H. Williams &
D.H. Edward Additions to Mechanicksburg
in F.L. 40 Section 8 T9 R 14 Athens Twp
Now in the City of Athens Athens Co. O
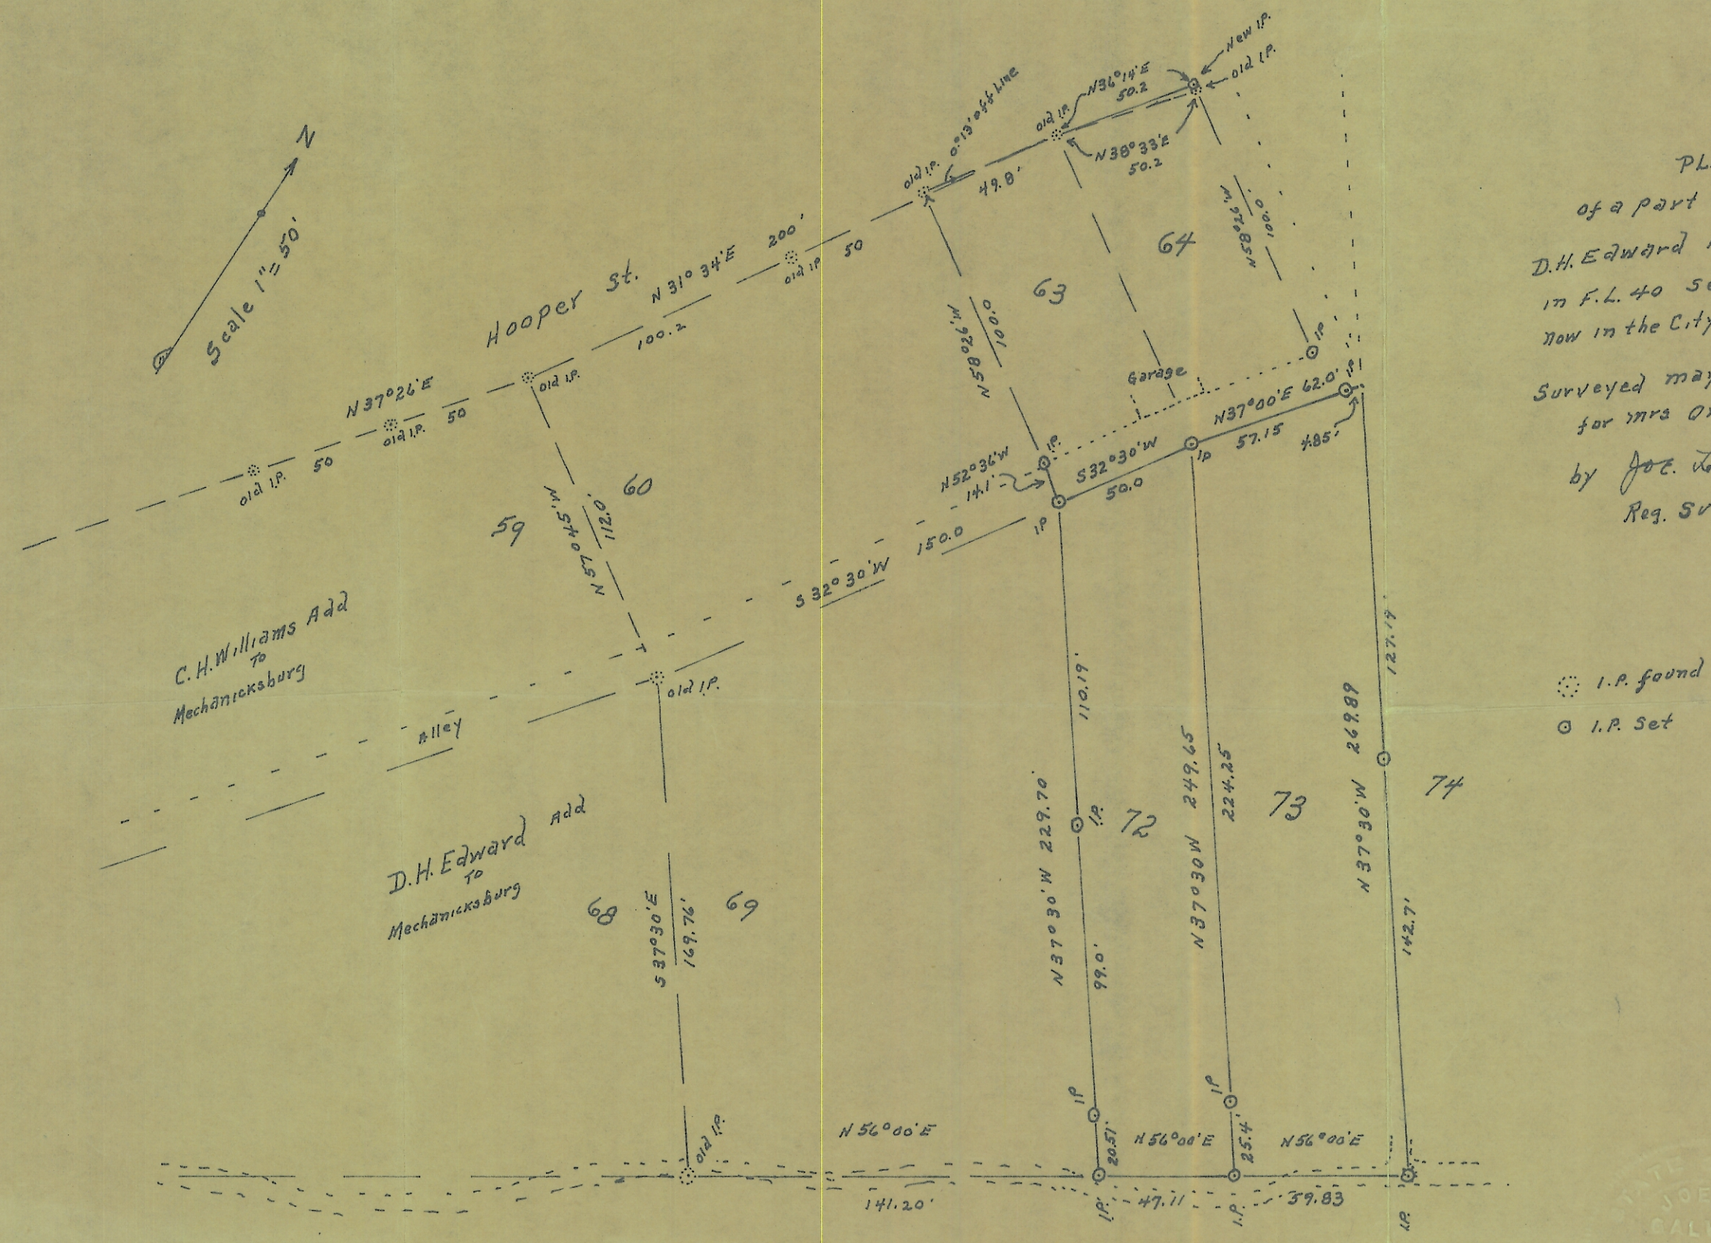
Surveyed may 1962
for mrs Orpha M. Martin
by Joe L. Galvin
Reg. Sur. 1684