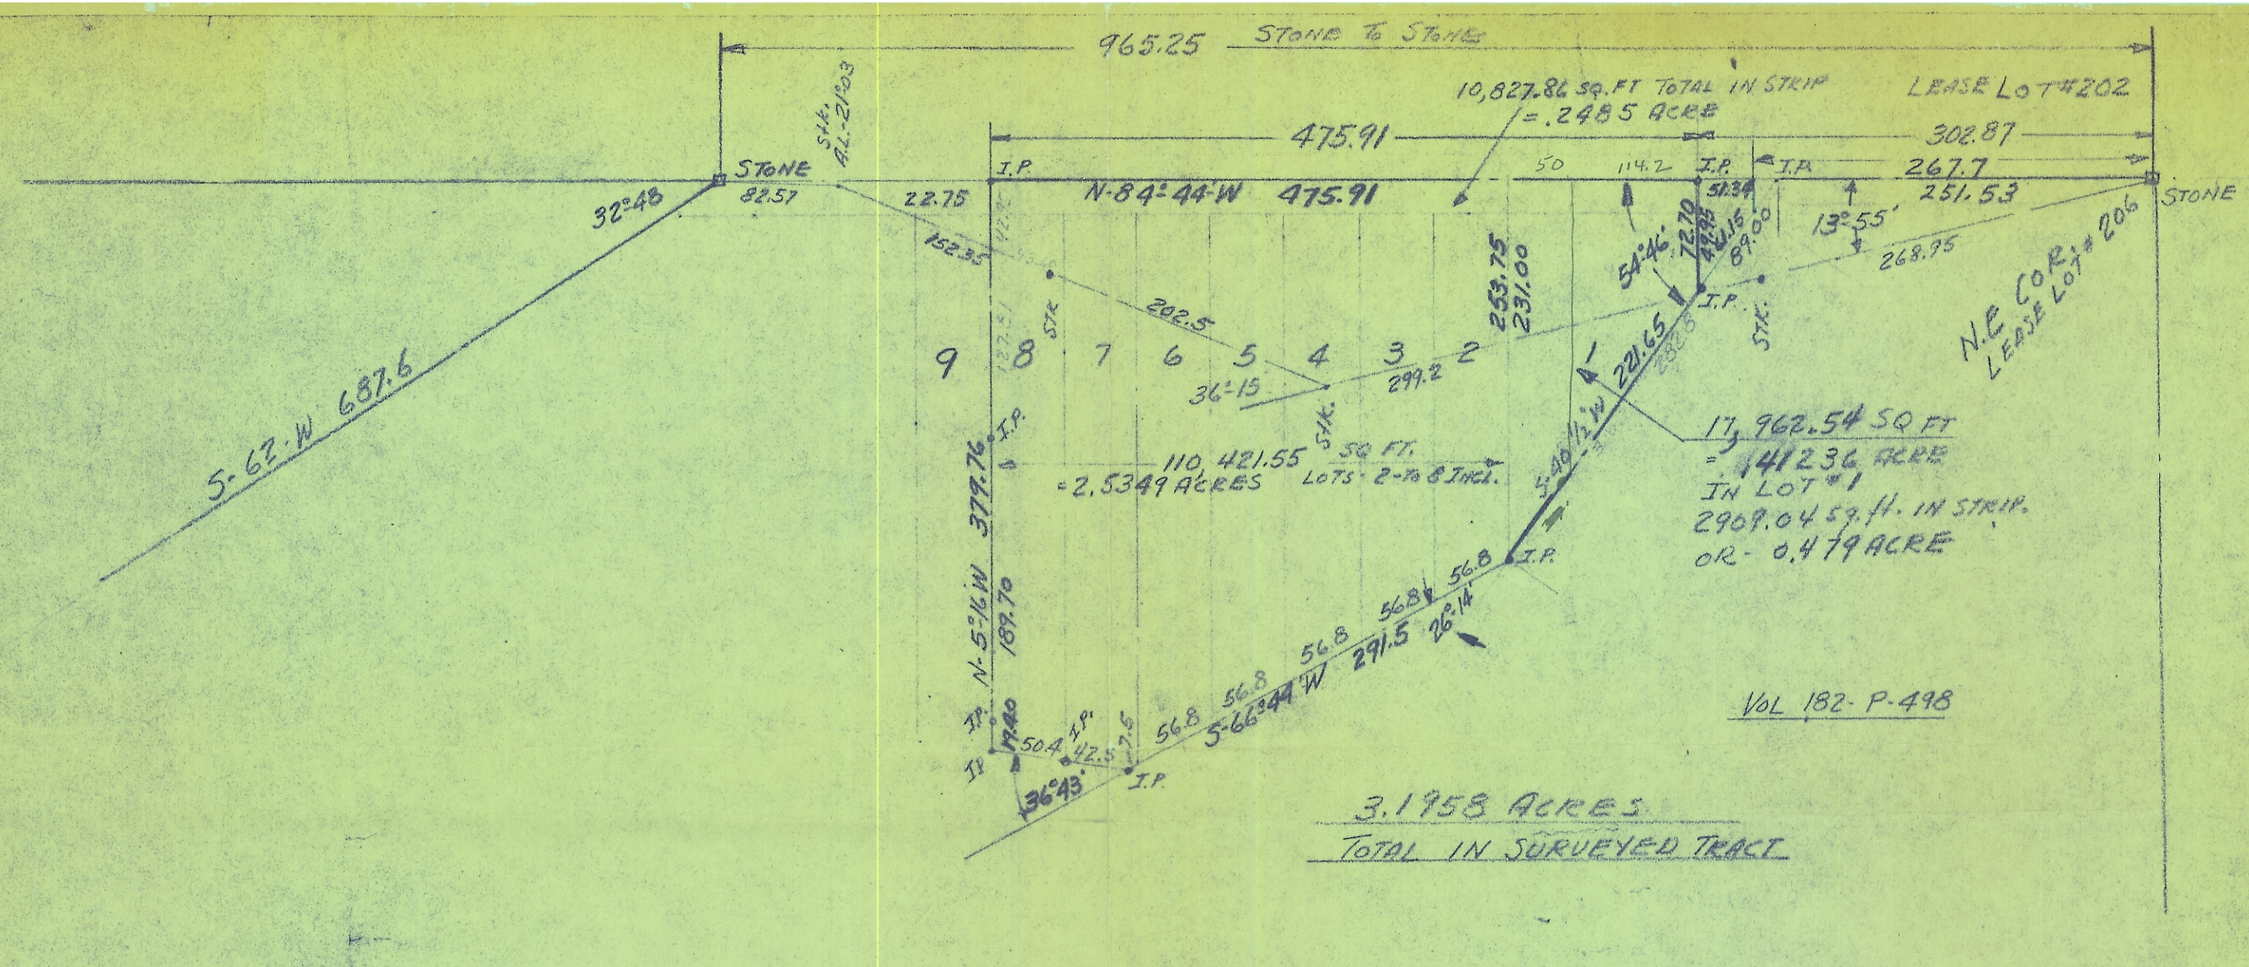

SURVEY OF TRACT
CONSISTING OF PART OF LOT #1,
LOTS- 2, 3, 4, 5, 6, 7, & 8 & STRIP
LOCATED IN SUMMIT HEIGHTS IN
SUB DIVISION OF NORTH PART OF
LEASE LOT No. 206 SECTIONS No. 11 & 12
ATHENS TWP, ATHENS Co. O.
FOR ROY & ANNA NOLAND
SOLD To
WILLIAM COOPER &

SURVEYED BY F. A DIXON
SCALE 1" = 100' DATE JAN. 1956

Sec. 11 & 12

Sec 11 & 12
A Elkins